


BEAM 10 DEAD LOAD DEFLECTION DIAGRAM
NOT TO SCALE

NOTES:
CAMBER AND DEFLECTION MEASUREMENTS ARE GIVEN @ TENTH POINTS. DEAD LOAD DEFLECTIONS INCLUDE GIRDER SELFWEIGHT.

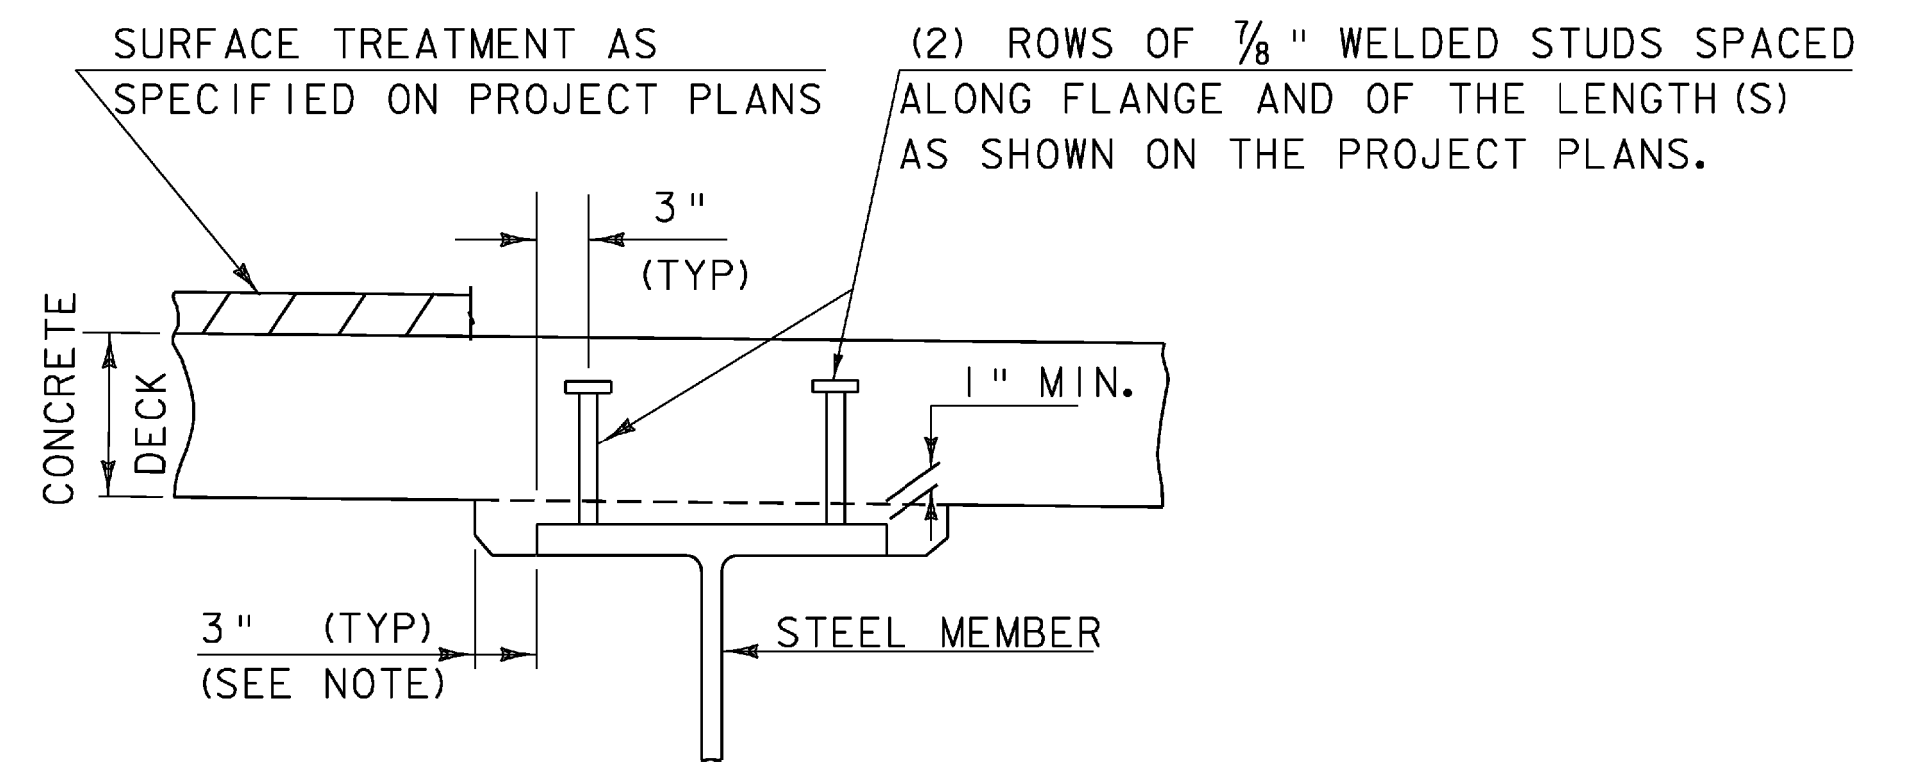

NOTE: THE 3" HORIZONTAL SECTION MAY BE ELIMINATED FOR FORMING SYSTEMS DESIGNED FOR THE CONSTRUCTION OF VERTICAL HAUNCHES. SYSTEMS SHALL BE SUBMITTED FOR APPROVAL TO THE STRUCTURES ENGINEER. ALL VOIDS SHALL BE FILLED WITH POLYURETHANE JOINT SEALER OR AN EQUIVALENT PRODUCT FROM THE APPROVED PRODUCTS LIST. COST SHALL BE INCIDENTAL TO ADJACENT CONCRETE ITEM

HAUNCH AND SHEAR CONNECTOR DETAIL
(NOT TO SCALE)



FRAMING PLAN
SCALE 1/8" = 1'-0"
10 2 4 6 8

NOTE
THE EXISTING BEAM 2 IS A W36x230 ADD NEW COVER PLATE 1/4"x19"x20'-0" (SEE "BEAM ELEVATION - BEAM 2" DETAIL ON SHEET 27 FOR MORE INFORMATION)

SEE REVISED SHEET 25A

PROJECT NAME:	SPRINGFIELD	FILE NAME:	s06j004sup.dgn	PLOT DATE:	24-MAR-2009
PROJECT NUMBER:	BHF 016-2(14)	PROJECT LEADER:	R. WHITCOMB	DRAWN BY:	C. MOONEY
		DESIGNED BY:	C. CARLSON	CHECKED BY:	D. PETERSON
		FRAMING PLAN		SHEET 26	OF 72