



ABUTMENT NO. 1 PLAN

SCALE $\frac{3}{8}$ " = 1'-0"

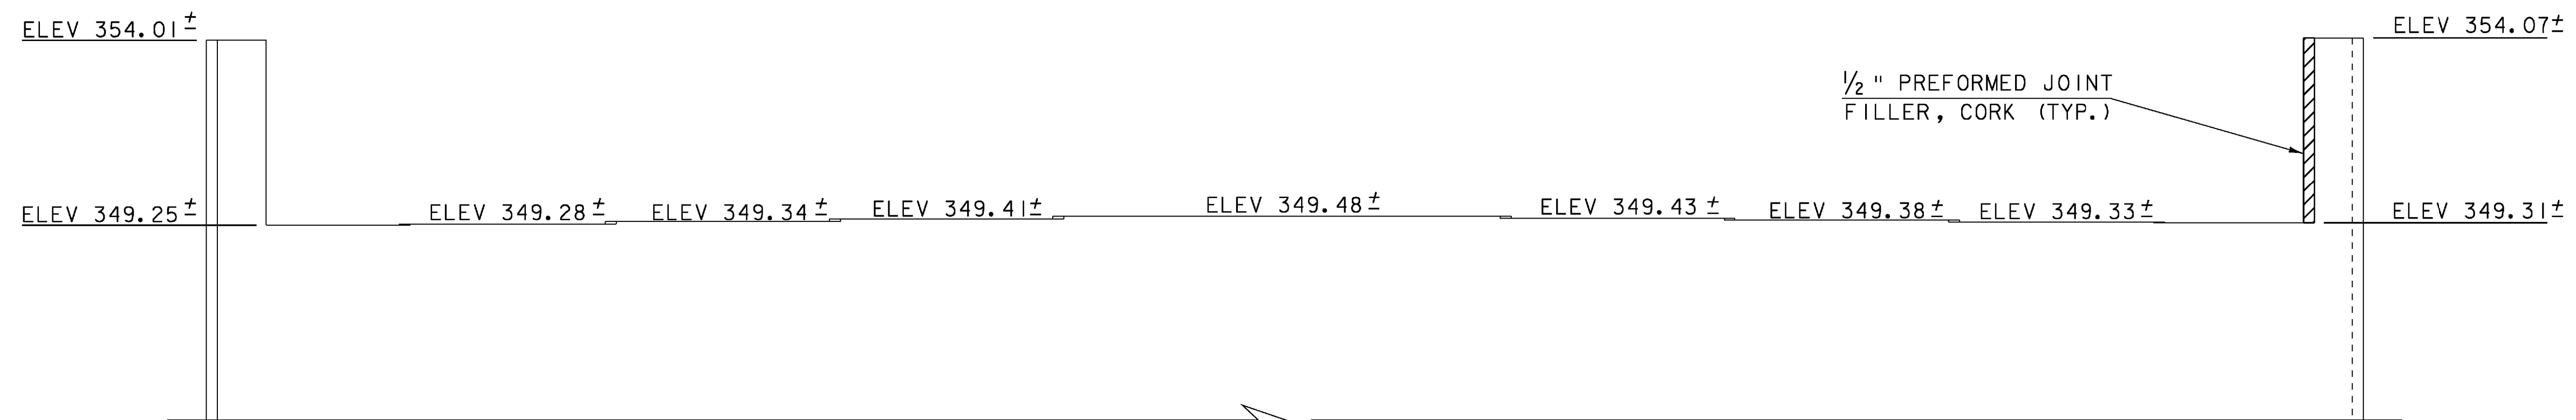

ABUTMENT NO. 1 ELEVATION

SCALE $\frac{3}{8}$ " = 1'-0"

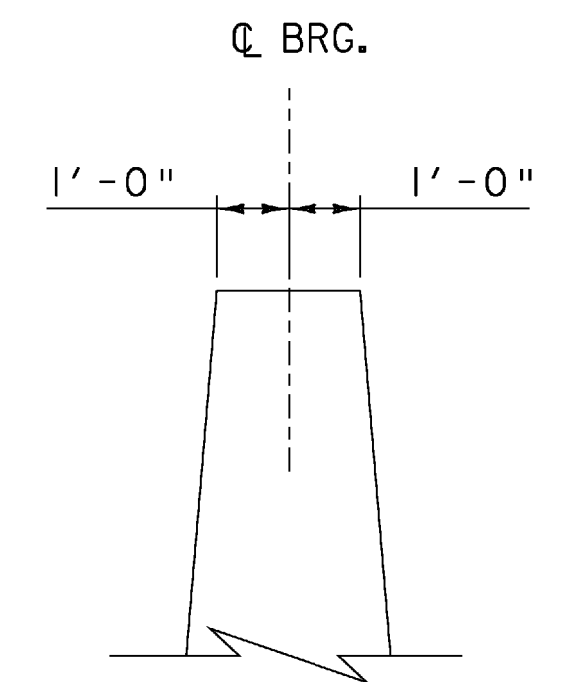

ABUTMENT NO. 1 TYPICAL SECTION

SCALE $\frac{3}{8}$ " = 1'-0"

VOID
SEE REVISED
SHEET

PROJECT NAME:	SPRINGFIELD	FILE NAME:	s06J004sub.dgn	PLOT DATE:	04-MAR-2009
PROJECT NUMBER:	BHF 016-2(14)	PROJECT LEADER:	R. WHITCOMB	DRAWN BY:	D. PETERSON
		DESIGNED BY:	D. PETERSON	CHECKED BY:	C. CARLSON
		ABUTMENT NO. 1 DETAILS		SHEET	35 OF 72