


ABUTMENT NO. 2 PLAN

SCALE 3/8" = 1'-0"

FLOW ←

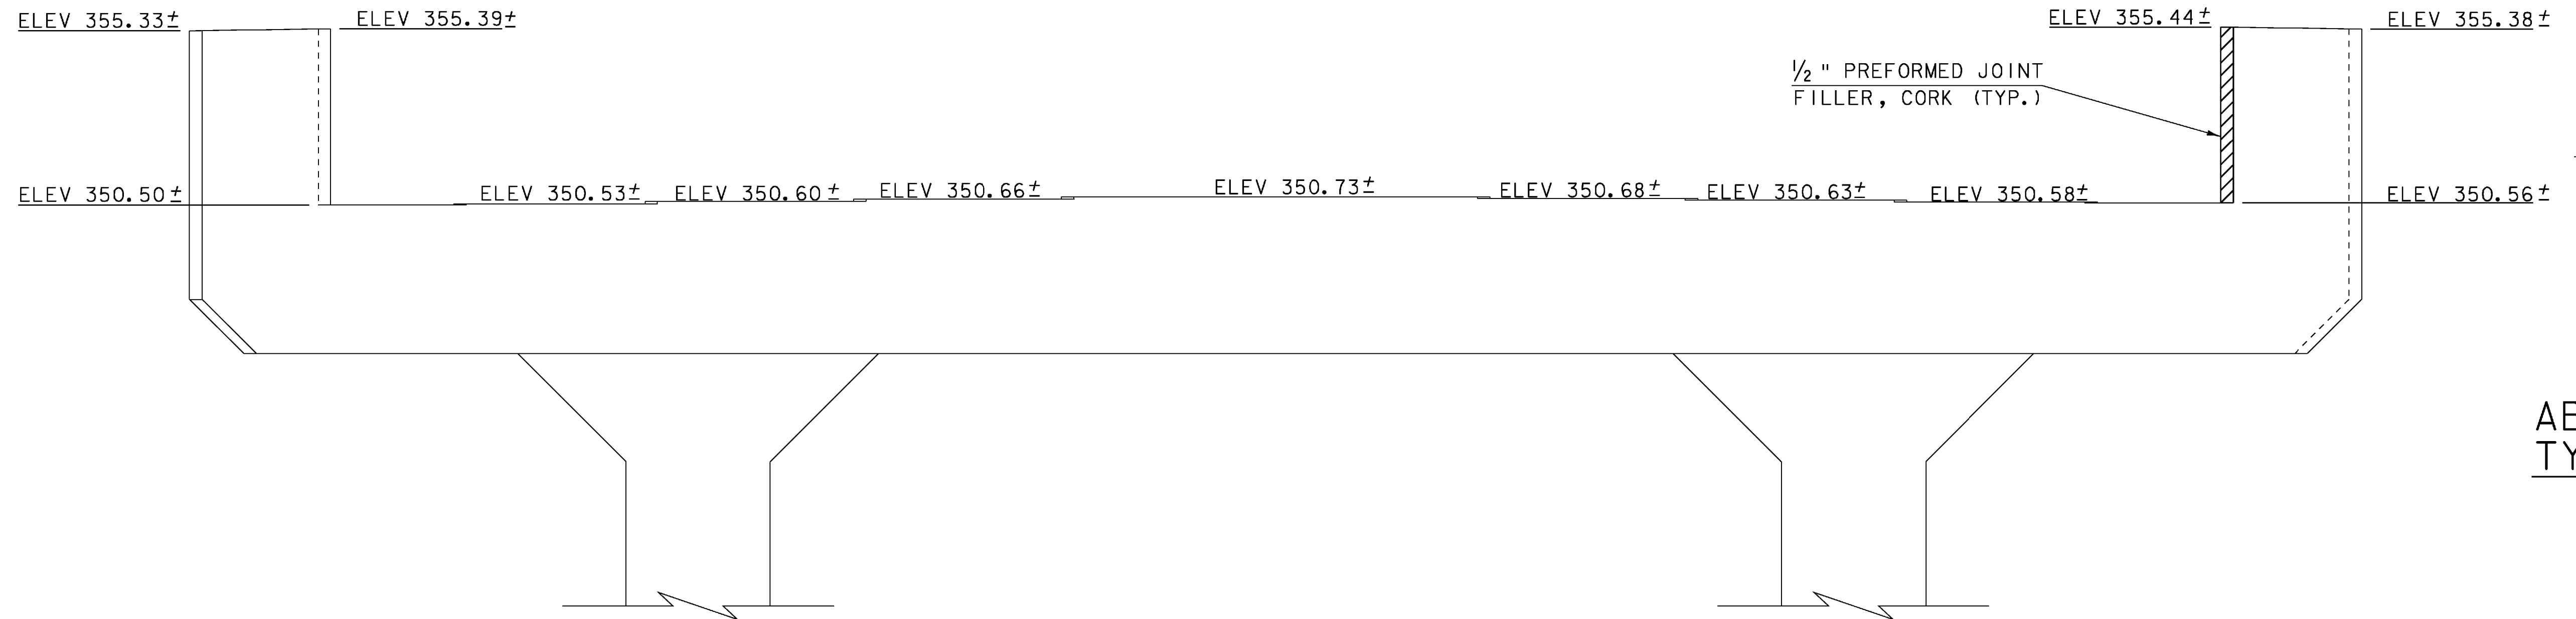

ABUTMENT NO. 2 TYPICAL SECTION

SCALE 3/8" = 1'-0"

ABUTMENT NO. 2 ELEVATION

SCALE 3/8" = 1'-0"

VOID
SEE REVISED
SHEET

PROJECT NAME:	SPRINGFIELD	FILE NAME:	06J004/Str/s06J004sub.dgn	PLOT DATE:	04-MAR-2009
PROJECT NUMBER:	BHF 016-2(14)	PROJECT LEADER:	R. WHITCOMB	DRAWN BY:	D. PETERSON
		DESIGNED BY:	D. PETERSON	CHECKED BY:	C. CARLSON
		ABUTMENT NO. 2 DETAILS		SHEET	36 OF 72