



**ABUTMENT
BRIDGE END DETAIL**
SCALE: 1" = 1'-0"

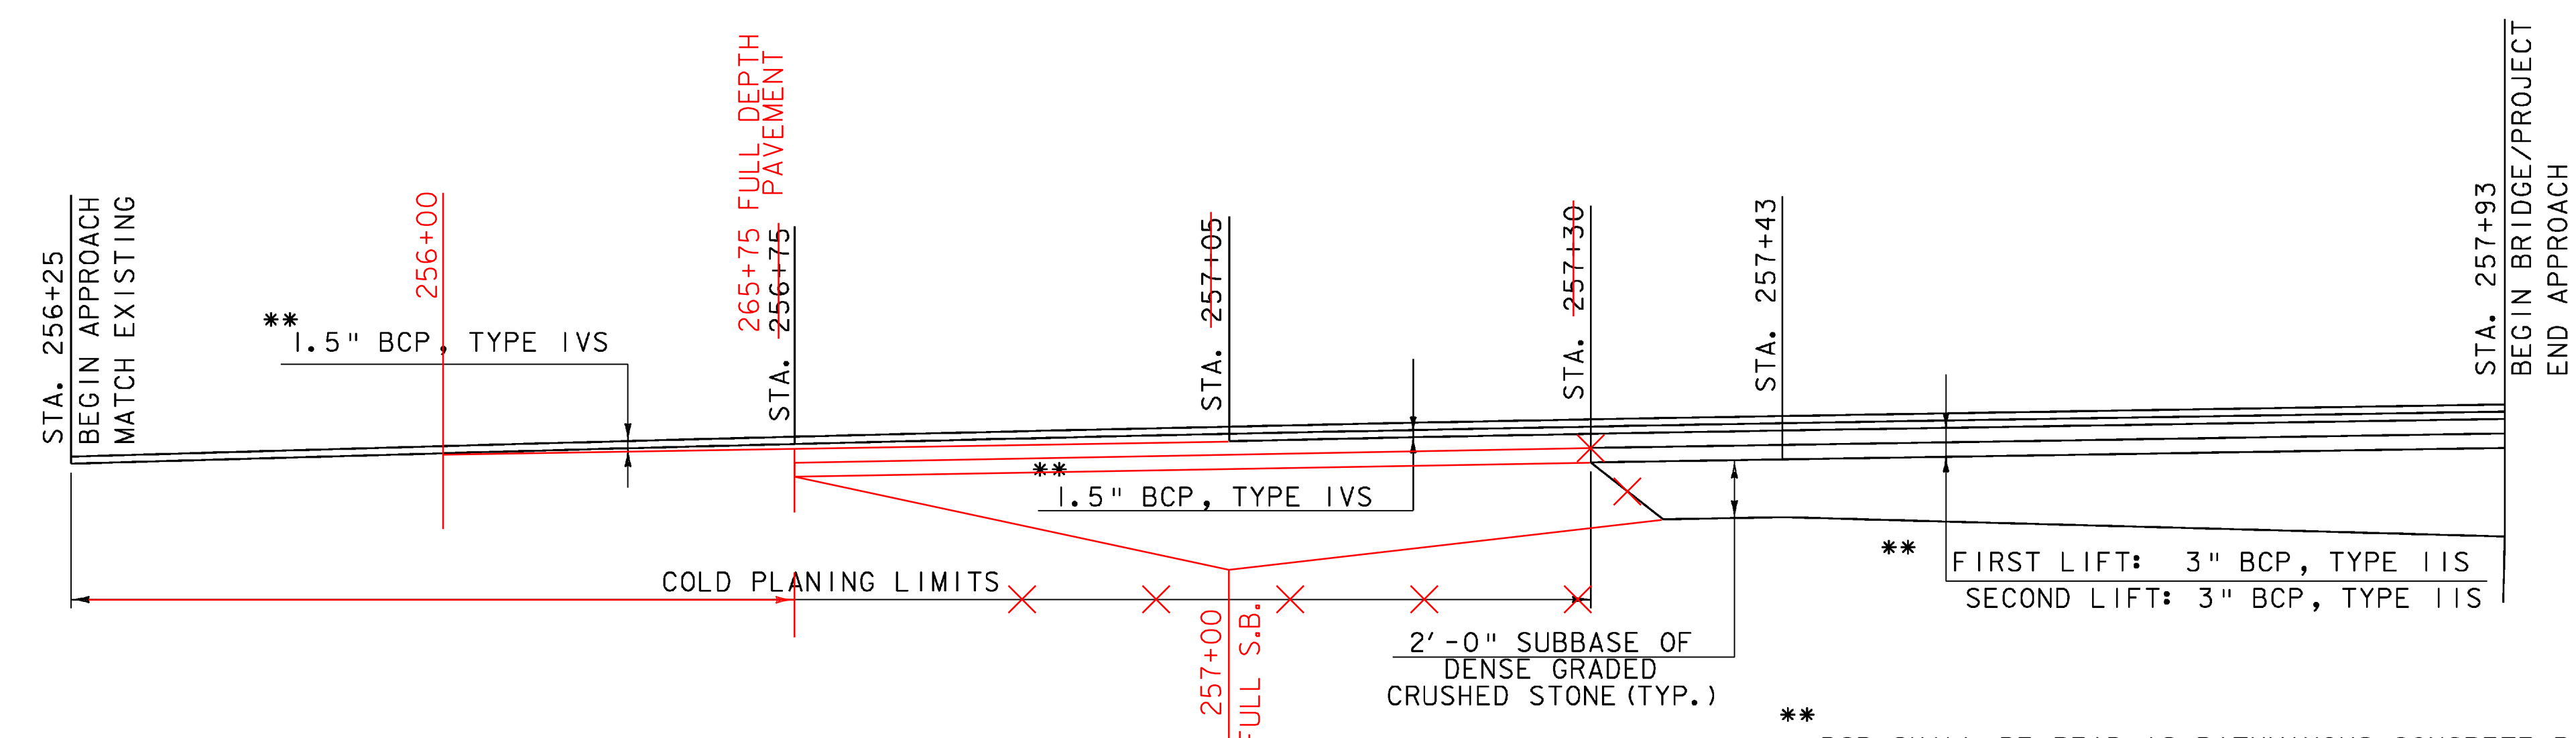

** BCP SHALL BE READ AS BITUMINOUS CONCRETE PAVEMENT AND SHALL BE PAID FOR UNDER SPECIAL PROVISION (BITUMINOUS CONCRETE PAVEMENT, SMALL QUANTITY)

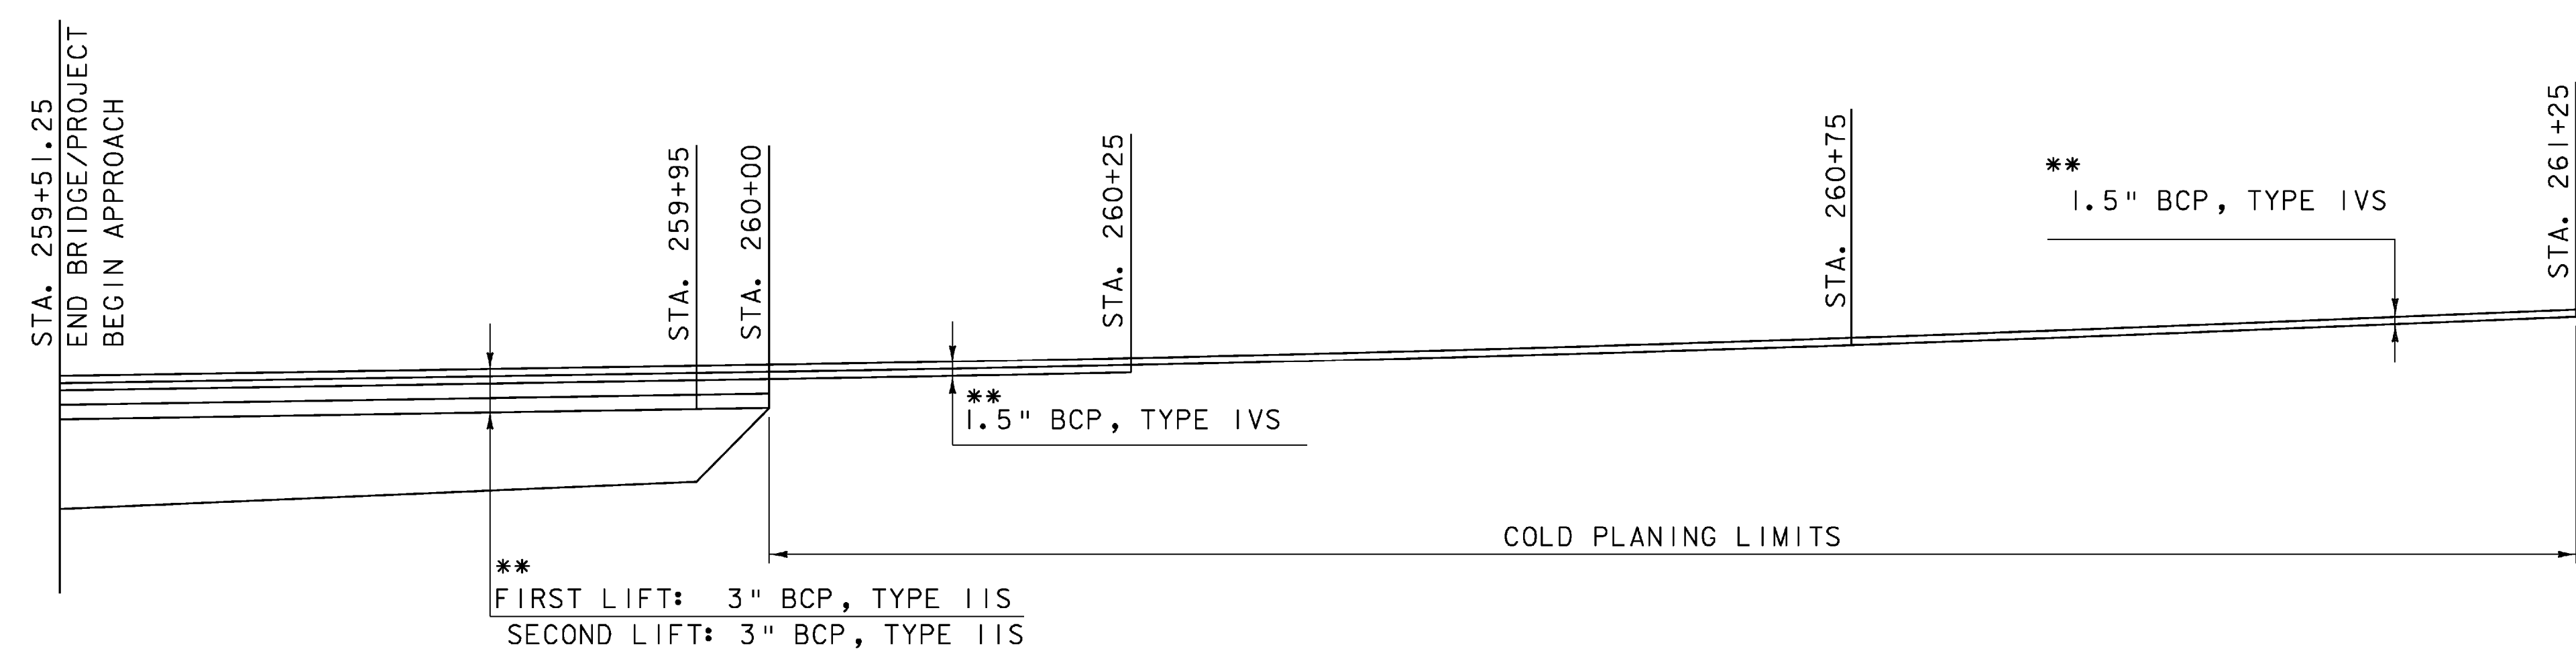

**MATERIAL TRANSITION
AND COLD PLANING LIMITS**
NOT TO SCALE

PROJECT NAME: SPRINGFIELD	PLOT DATE: 24-MAR-2009
PROJECT NUMBER: BHF 016-2(14)	DRAWN BY: D. PETERSON
FILE NAME: 06J004/str/s06J004xsl.dgn	CHECKED BY: C. CARLSON
PROJECT LEADER: R. WHITCOMB	SHEET 44 OF 72
DESIGNED BY: D. PETERSON	
MATERIAL TRANSITION DETAILS	