




256+50

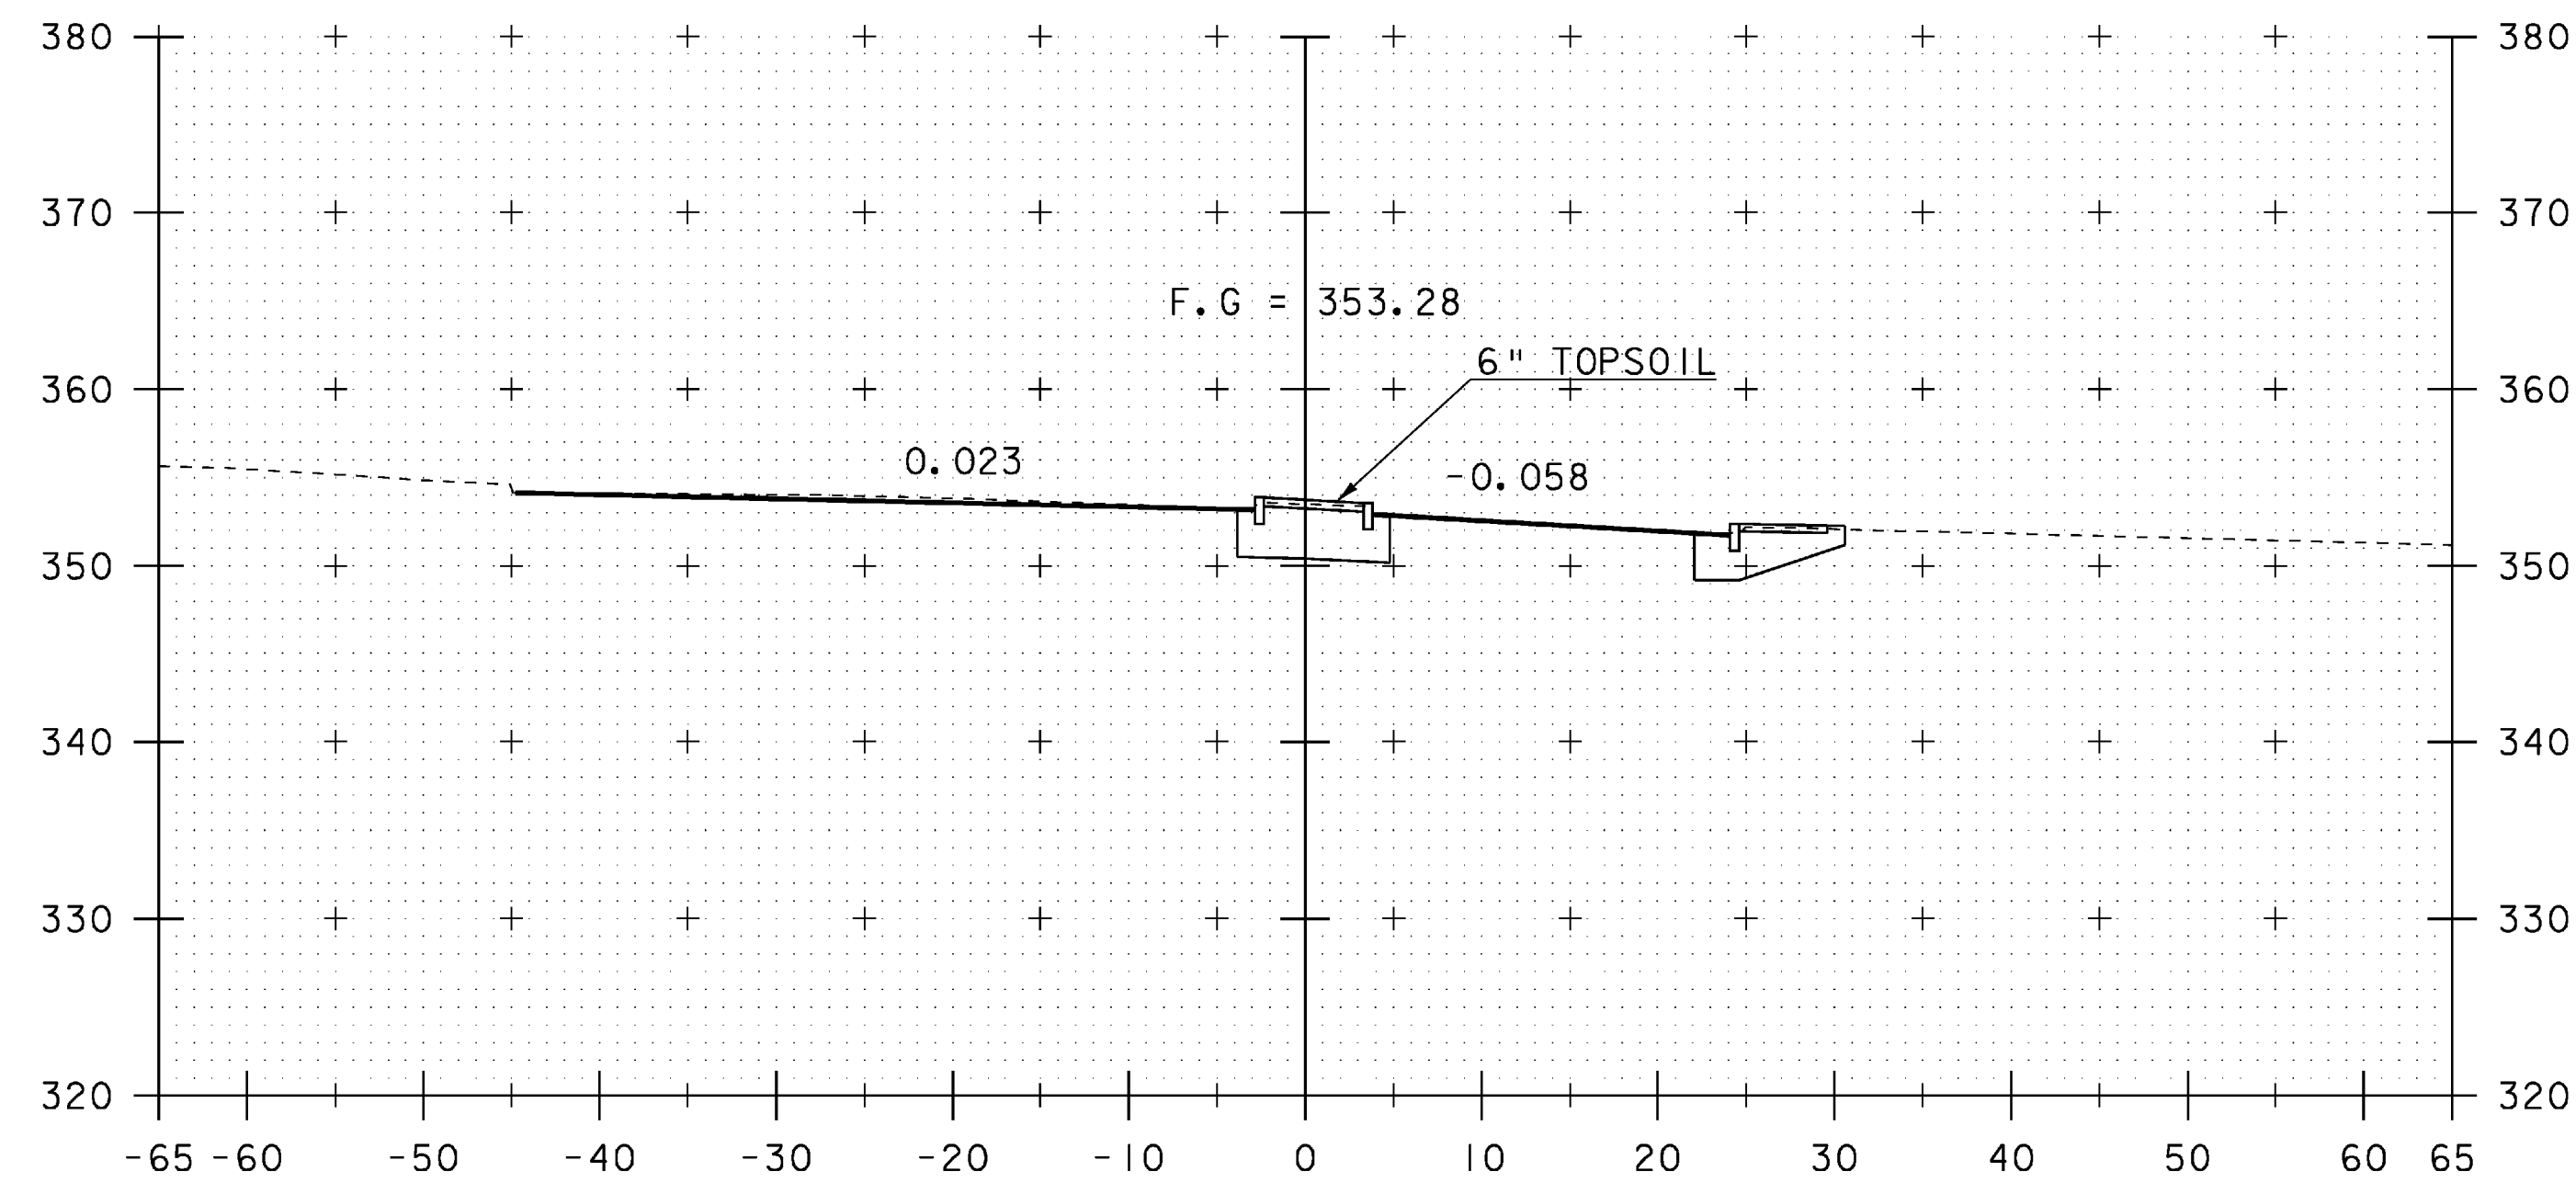

257+00

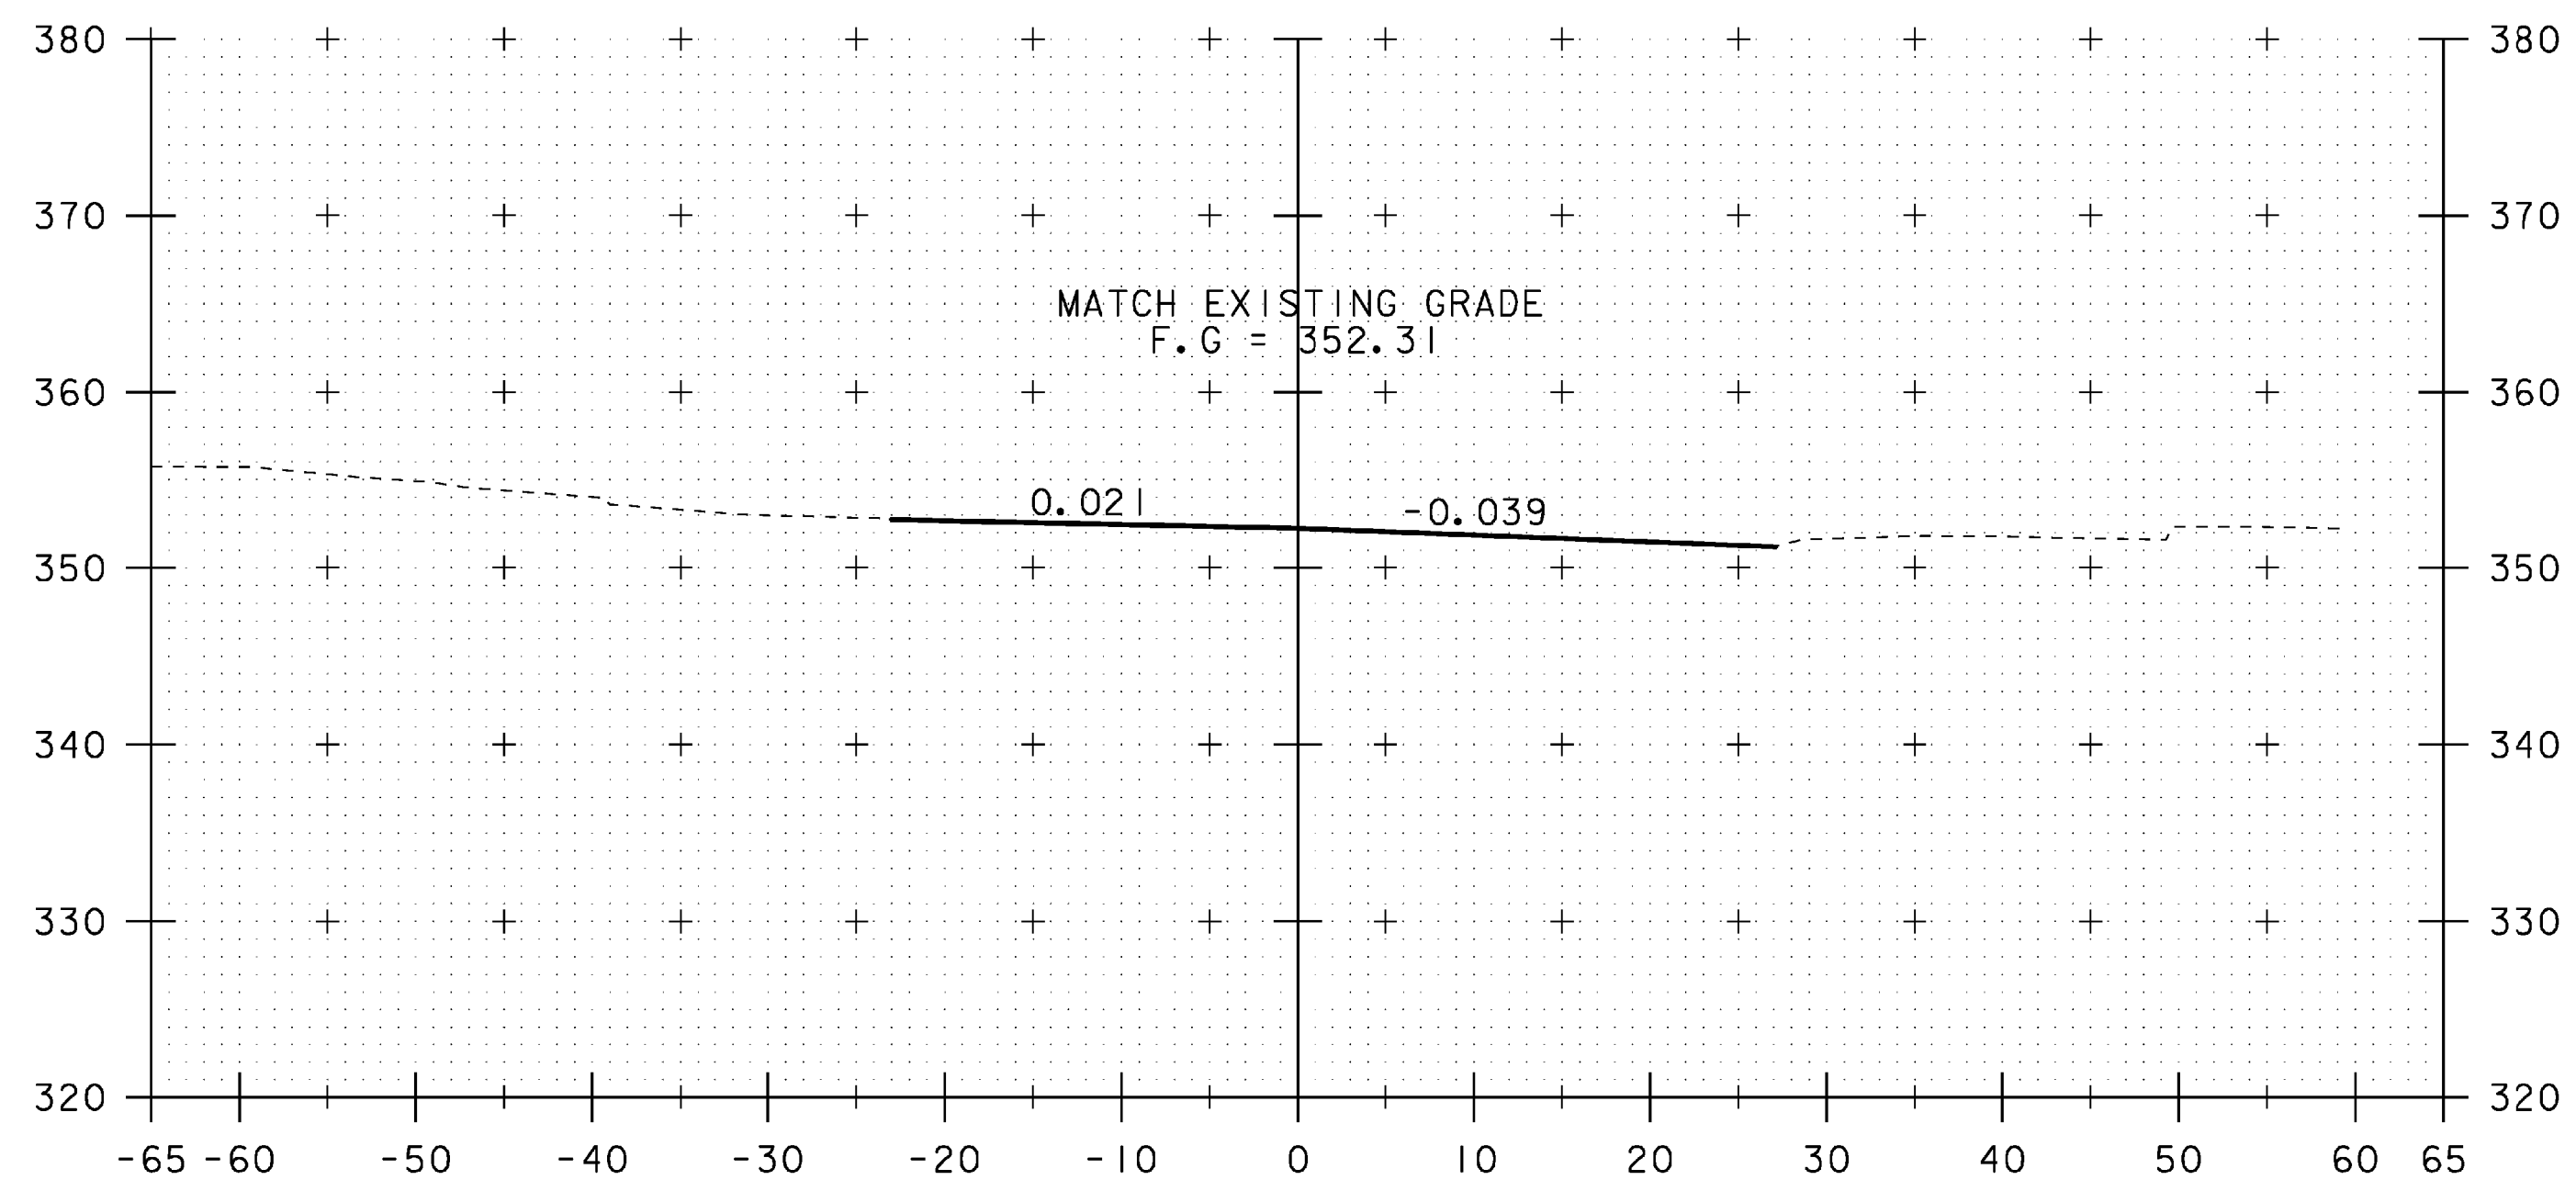

256+25

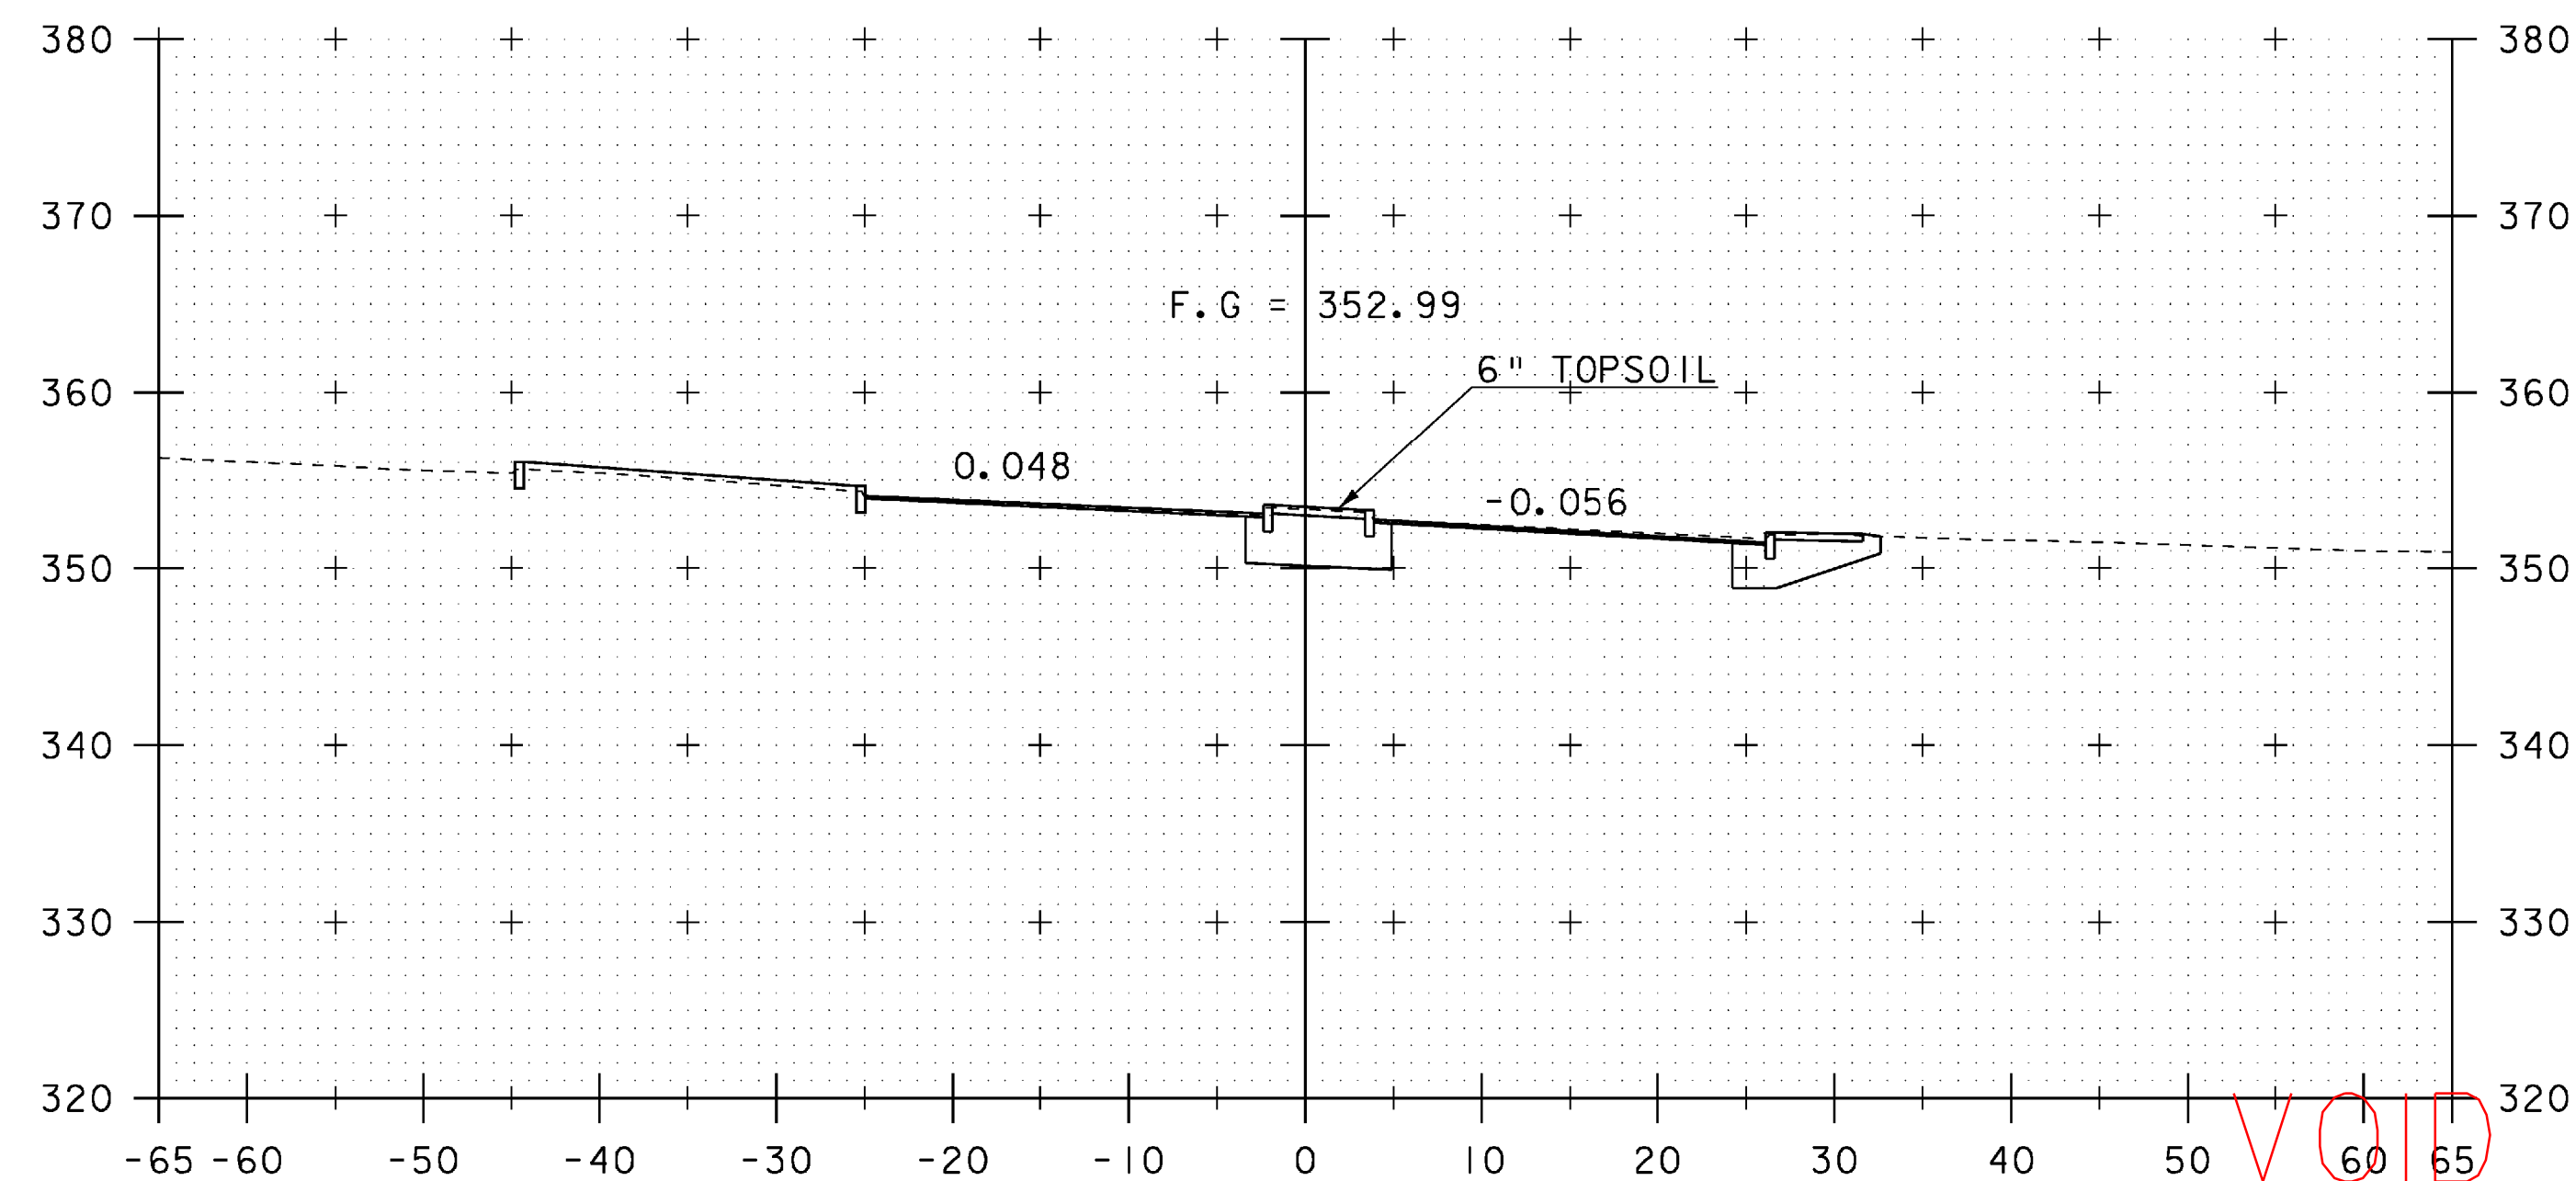

256+75

VOID
SEE REVISED
SHEET

ML STA 256+25
BEGIN APPROACH
MATCH EXISTING

STA. 256+25 TO STA. 257+00

PROJECT NAME: SPRINGFIELD	PLOT DATE: 04-MAR-2009
PROJECT NUMBER: BHF 016-2(14)	DRAWN BY: D. PETERSON
FILE NAME: 06J004/str/s06J004xsl.dgn	CHECKED BY: C. CARLSON
PROJECT LEADER: R. WHITCOMB	SHEET 45 OF 72
DESIGNED BY: D. PETERSON	
MAINLINE CROSS SECTIONS (I)	