



256+50

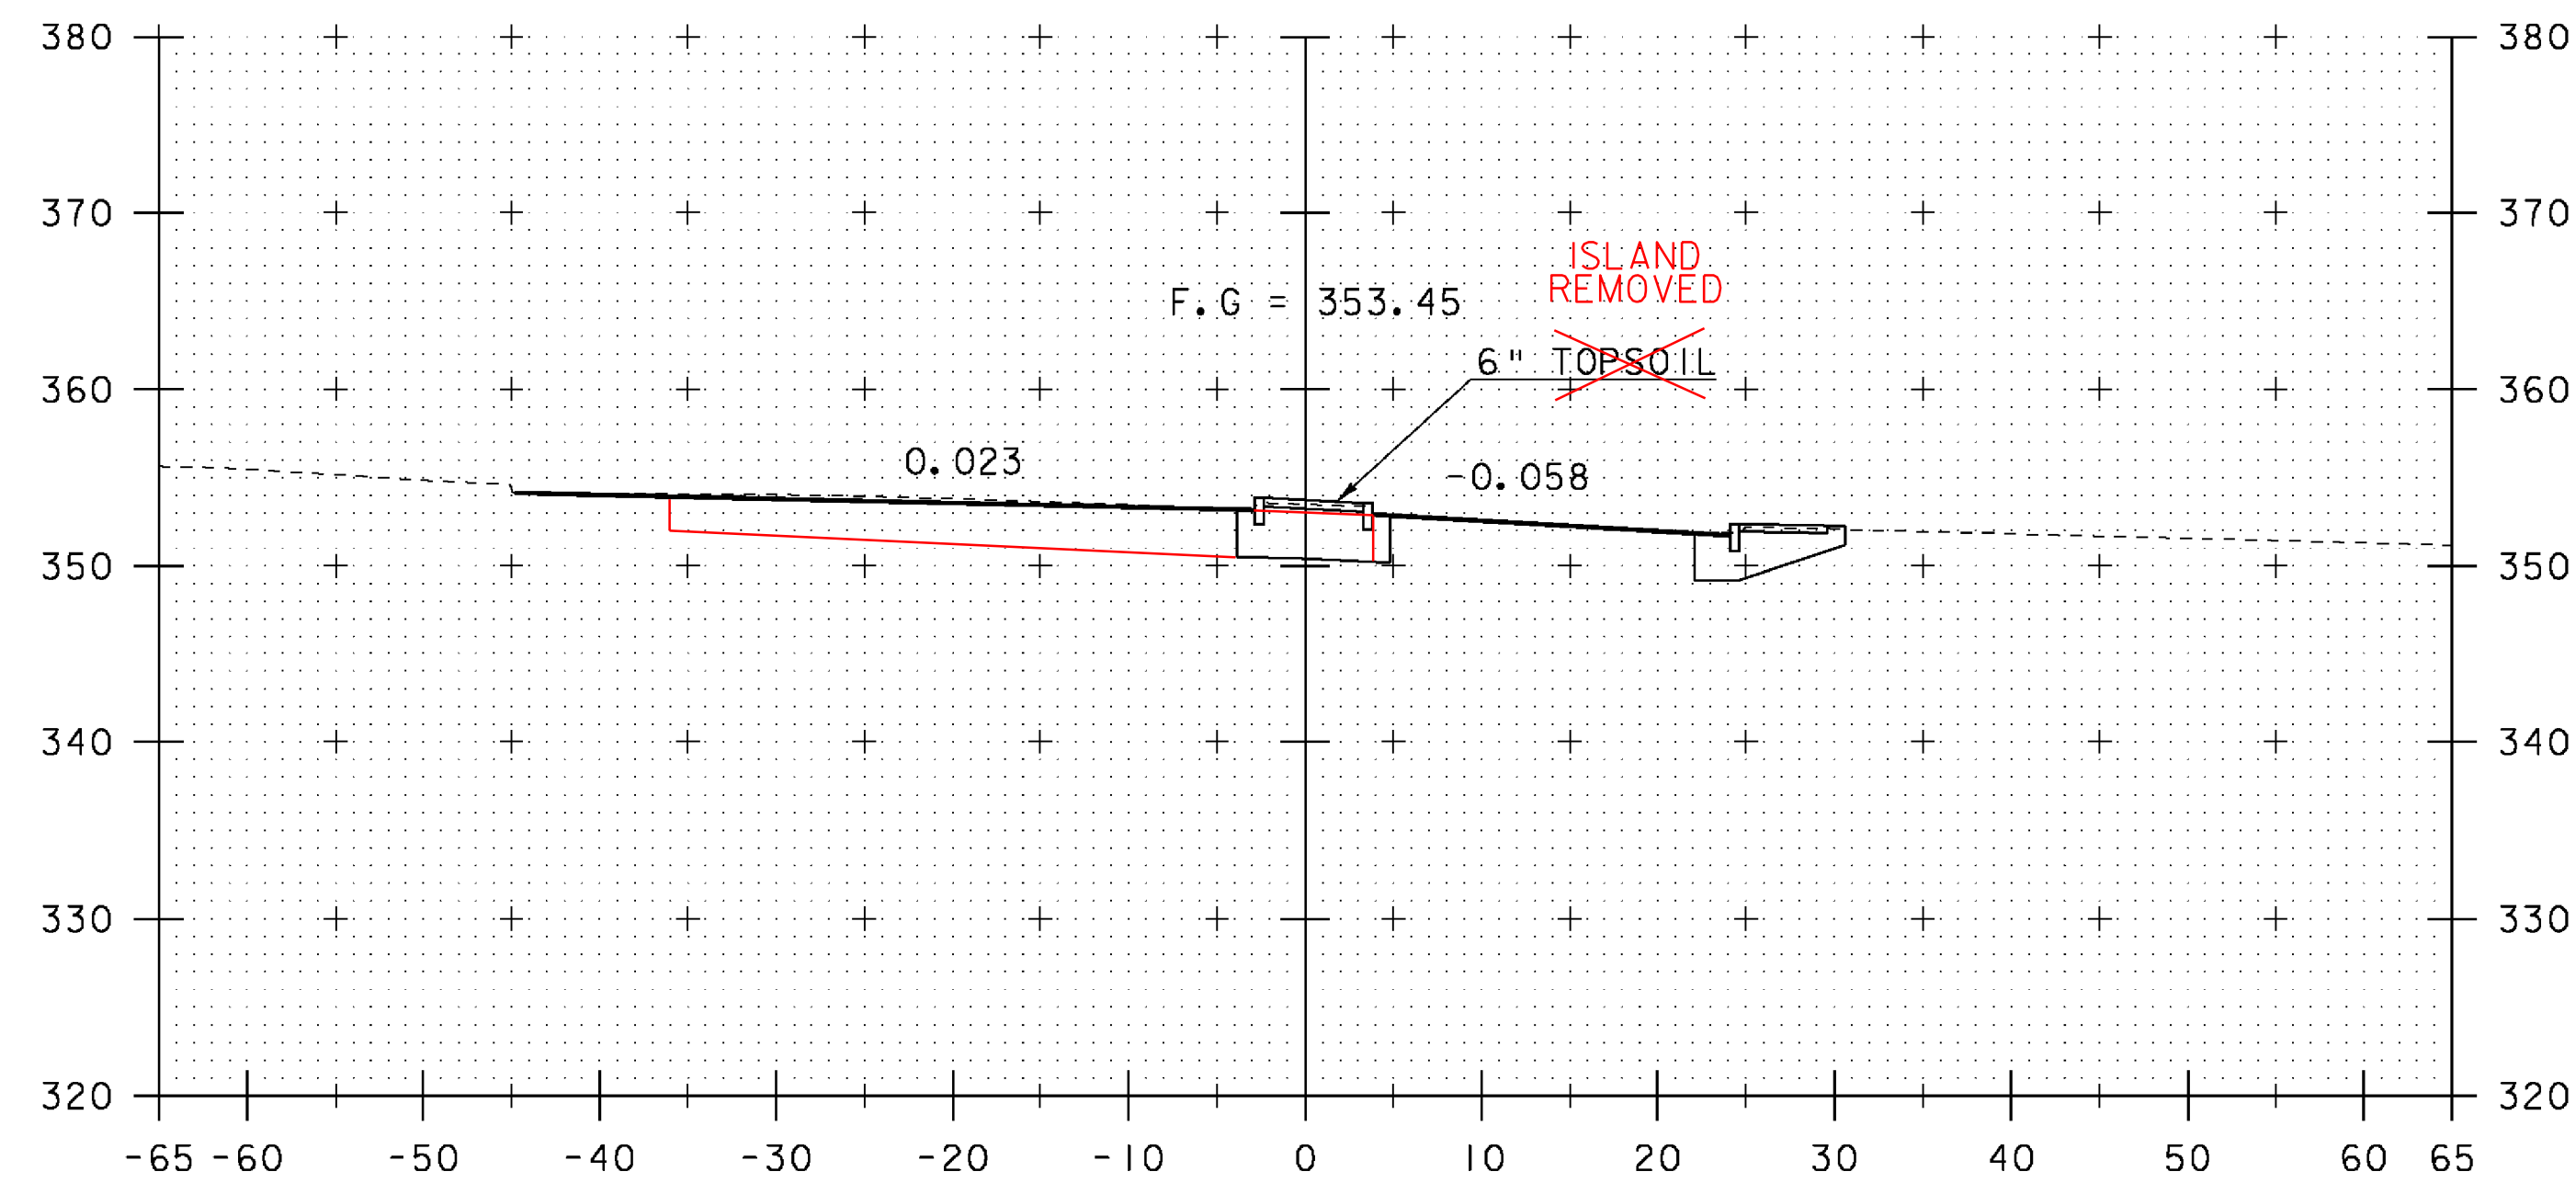


257+00

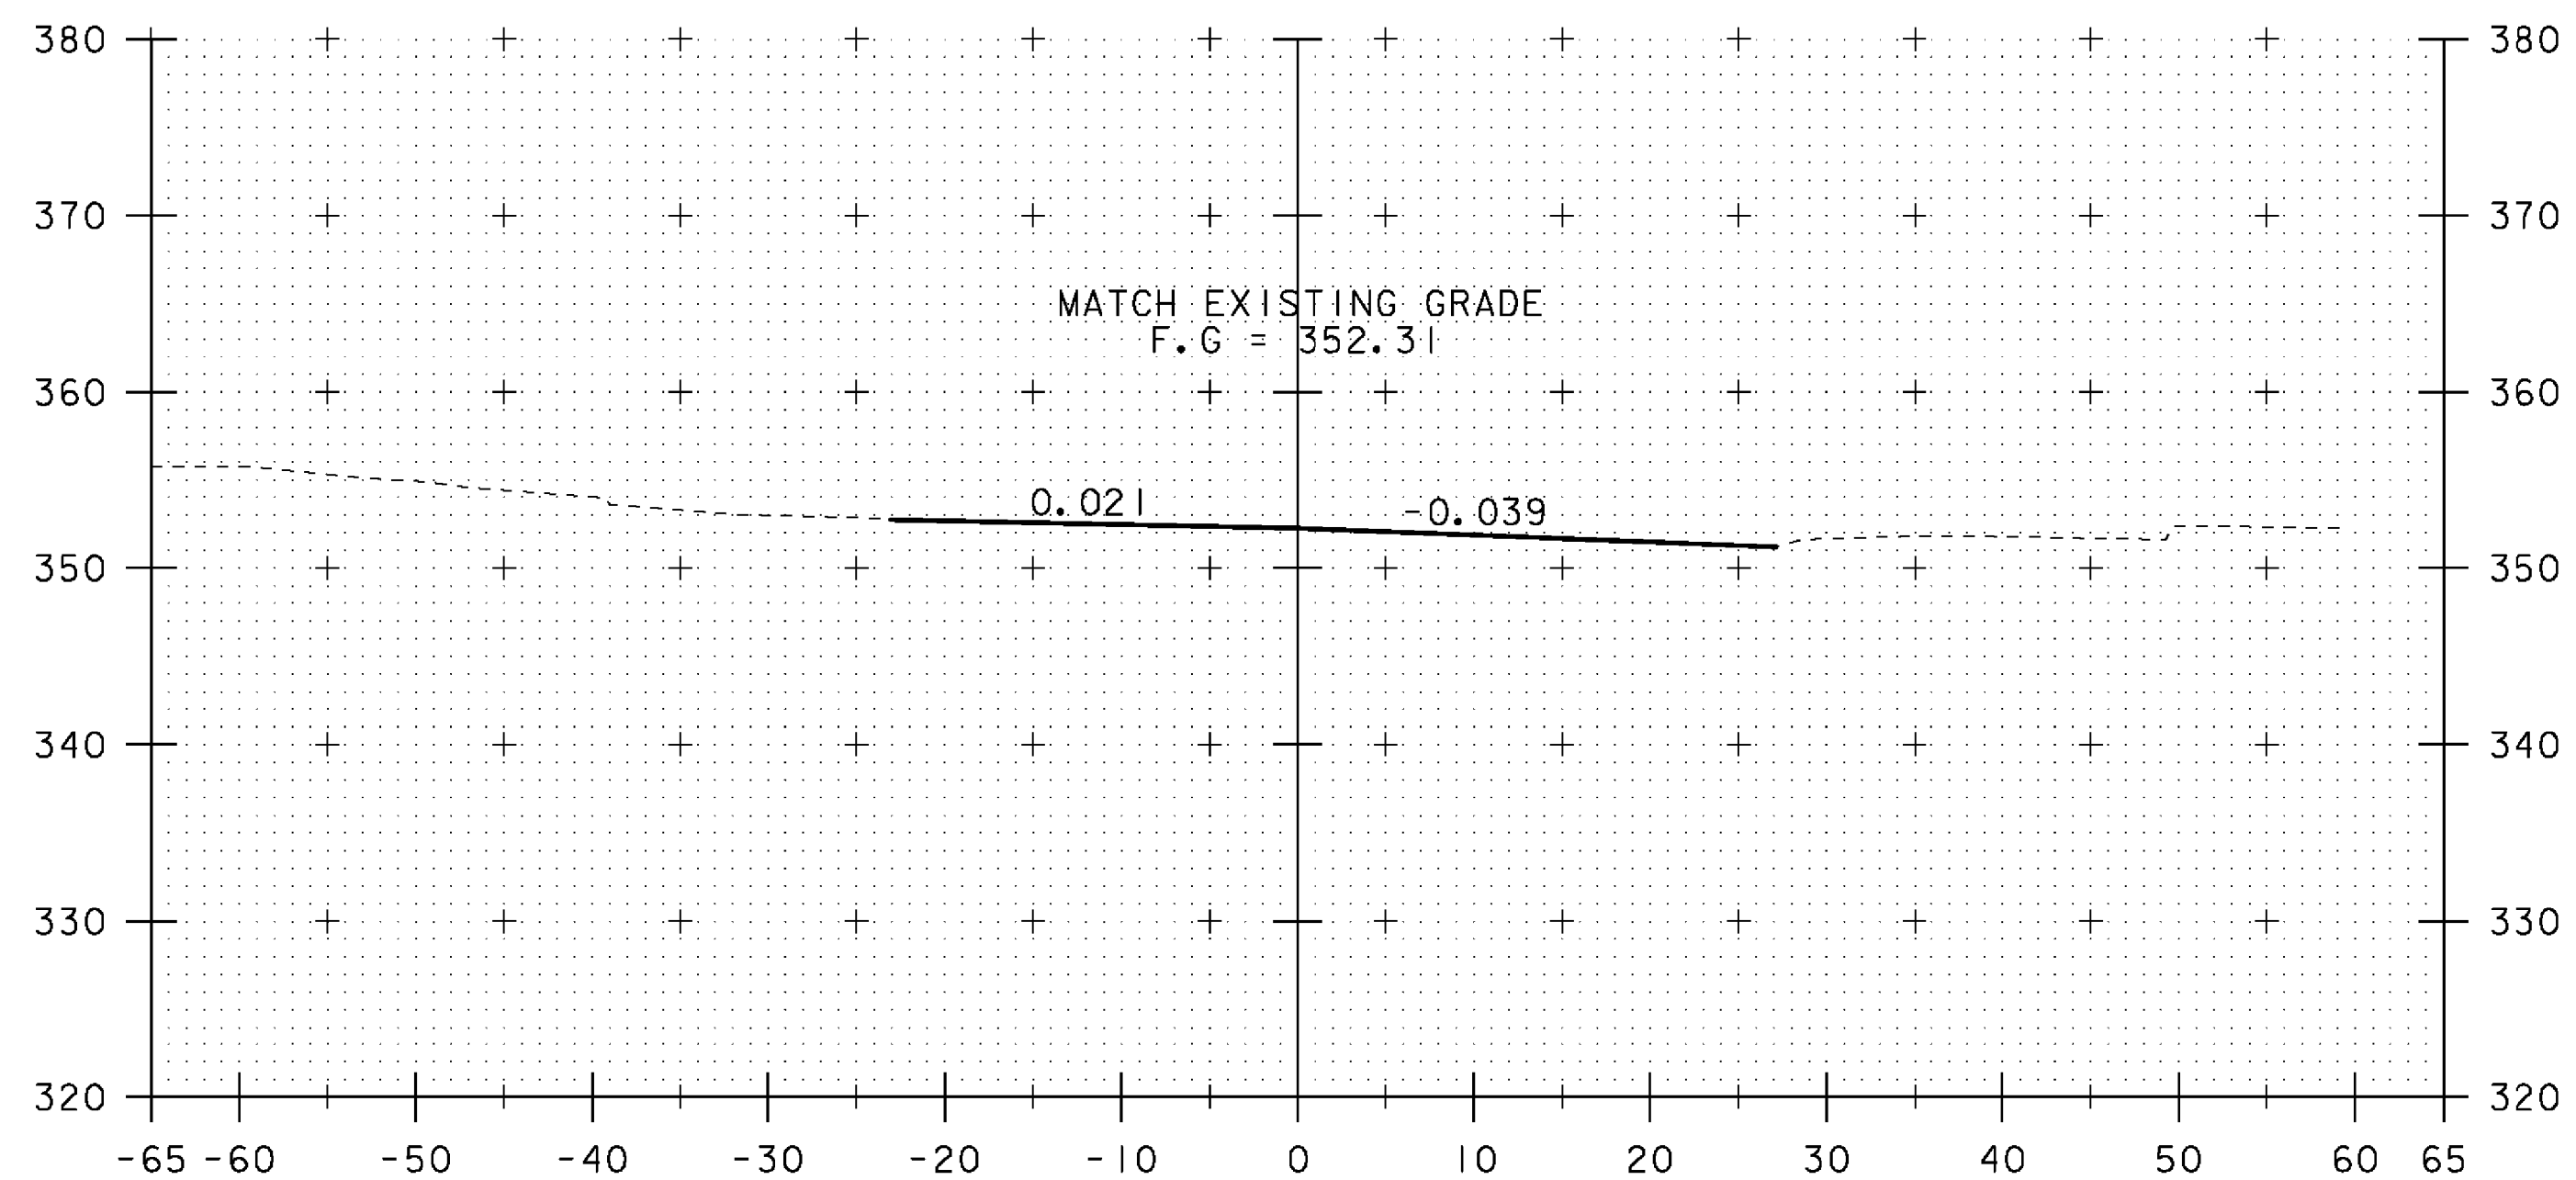

256+25

ML STA 256+25
BEGIN APPROACH
MATCH EXISTING

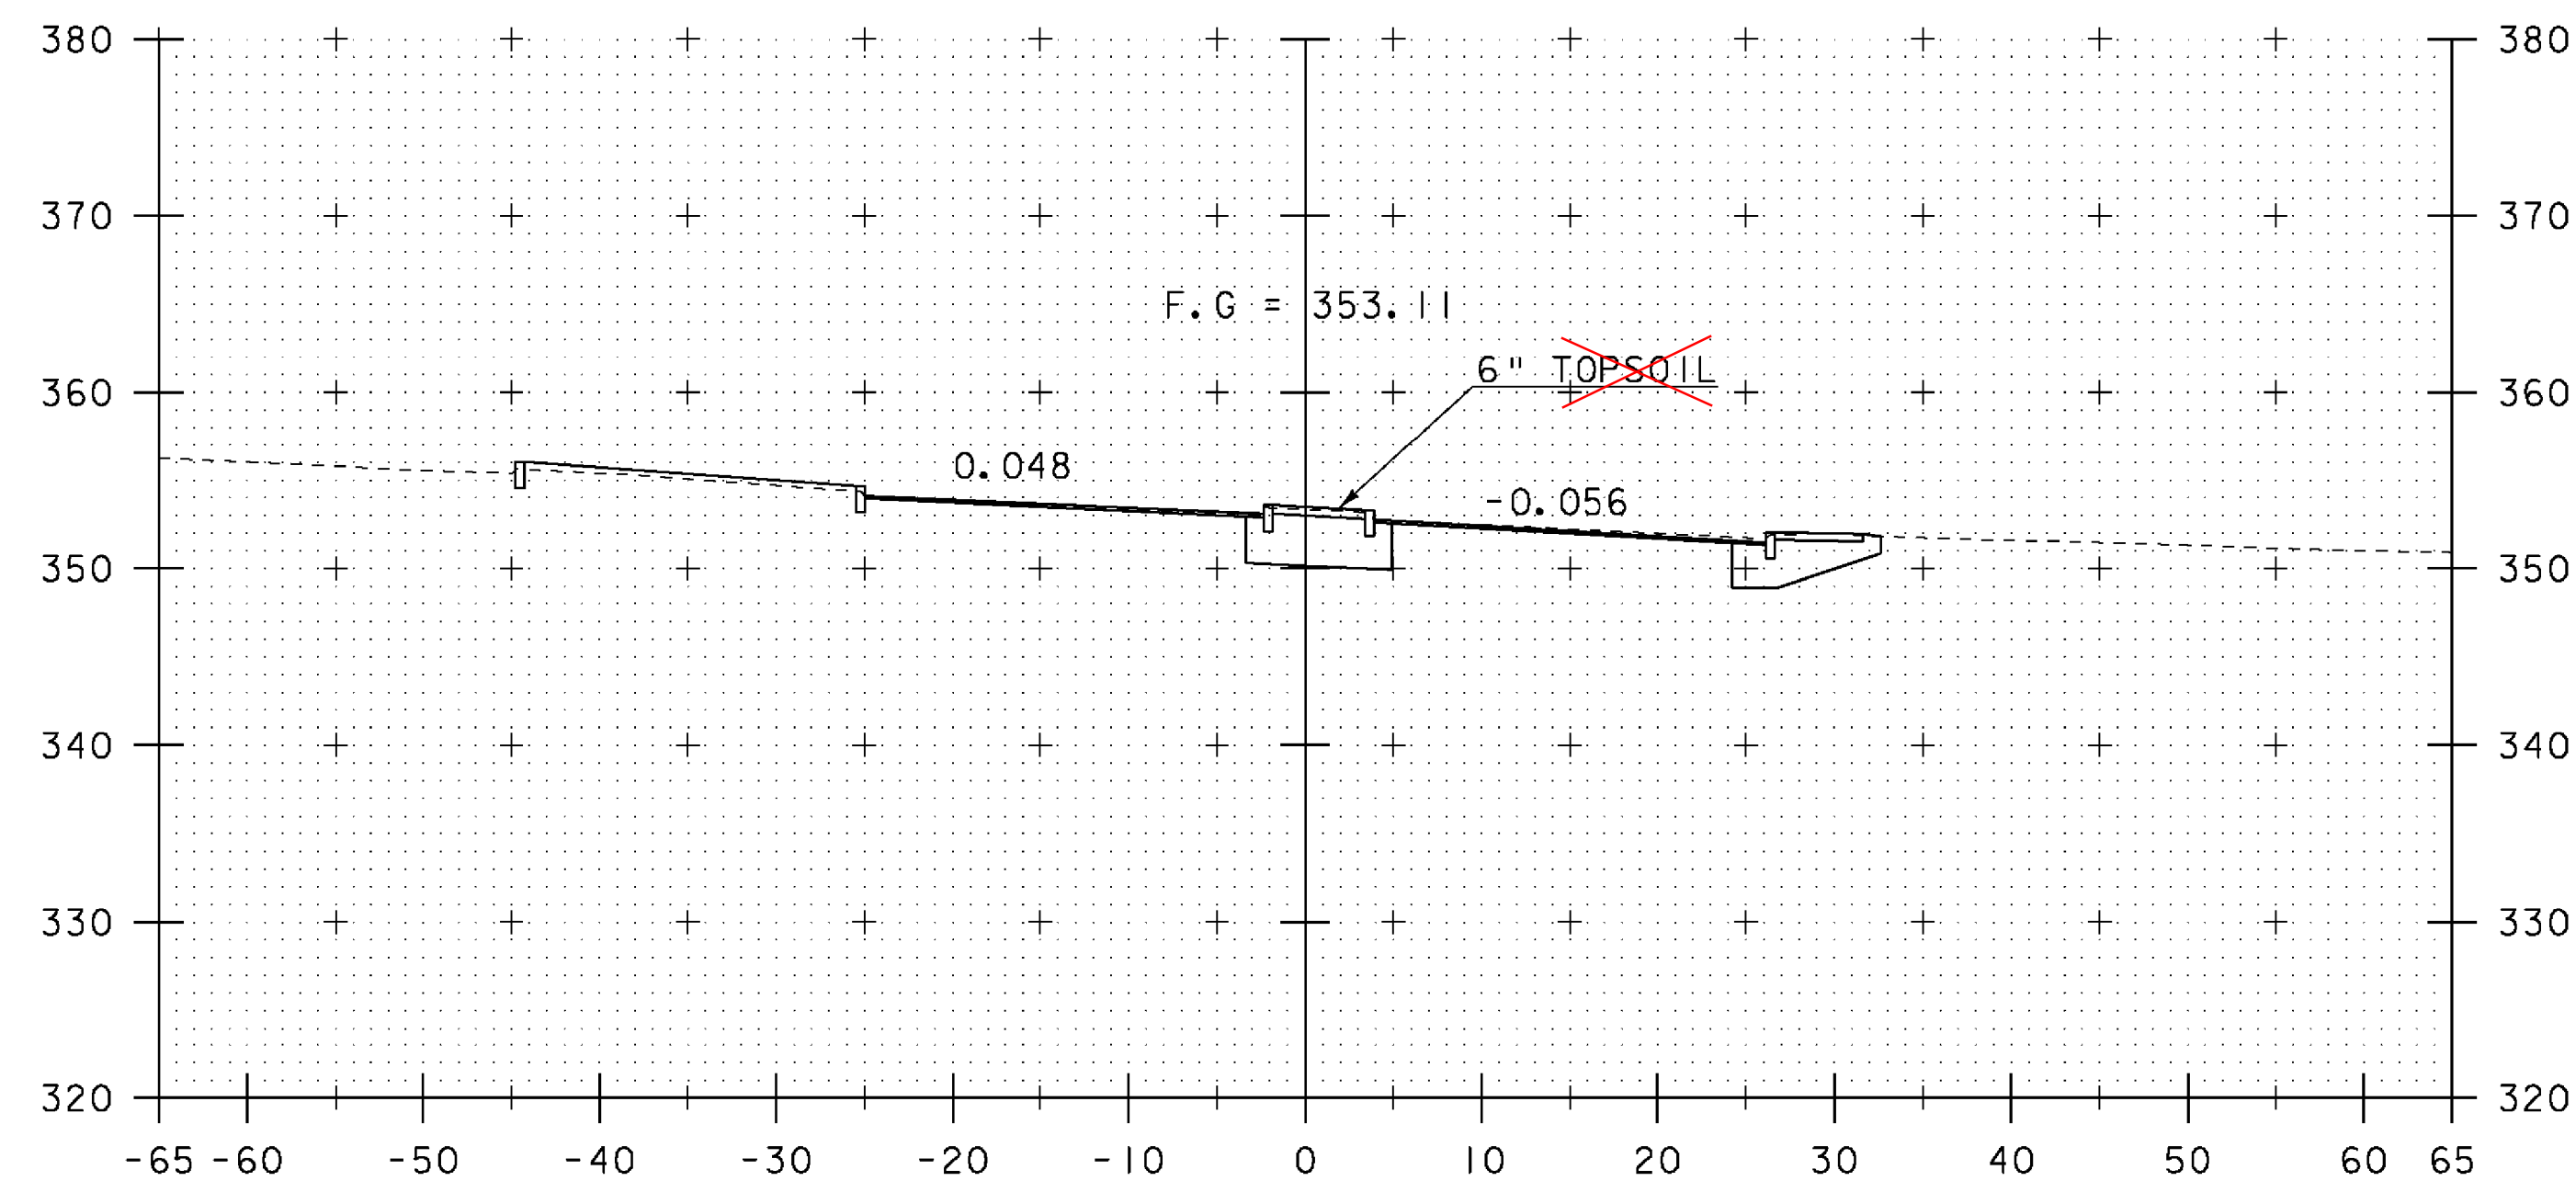

256+75

REV.	BY	DATE	REVISION
3	LBB	5/26/09	REVISED FINISH GRADE AND BANKING

PROJECT NAME:	SPRINGFIELD	PLOT DATE:	29-MAY-2009
PROJECT NUMBER:	BHF 016-2(14)	DRAWN BY:	D. PETERSON
FILE NAME:	06J004/str/s06J004xsl.dgn	DESIGNED BY:	D. PETERSON
PROJECT LEADER:	R. WHITCOMB	CHECKED BY:	C. CARLSON
MAINLINE CROSS SECTIONS (I)		SHEET	45 OF 72

STA. 256+25 TO STA. 257+00