



257+50

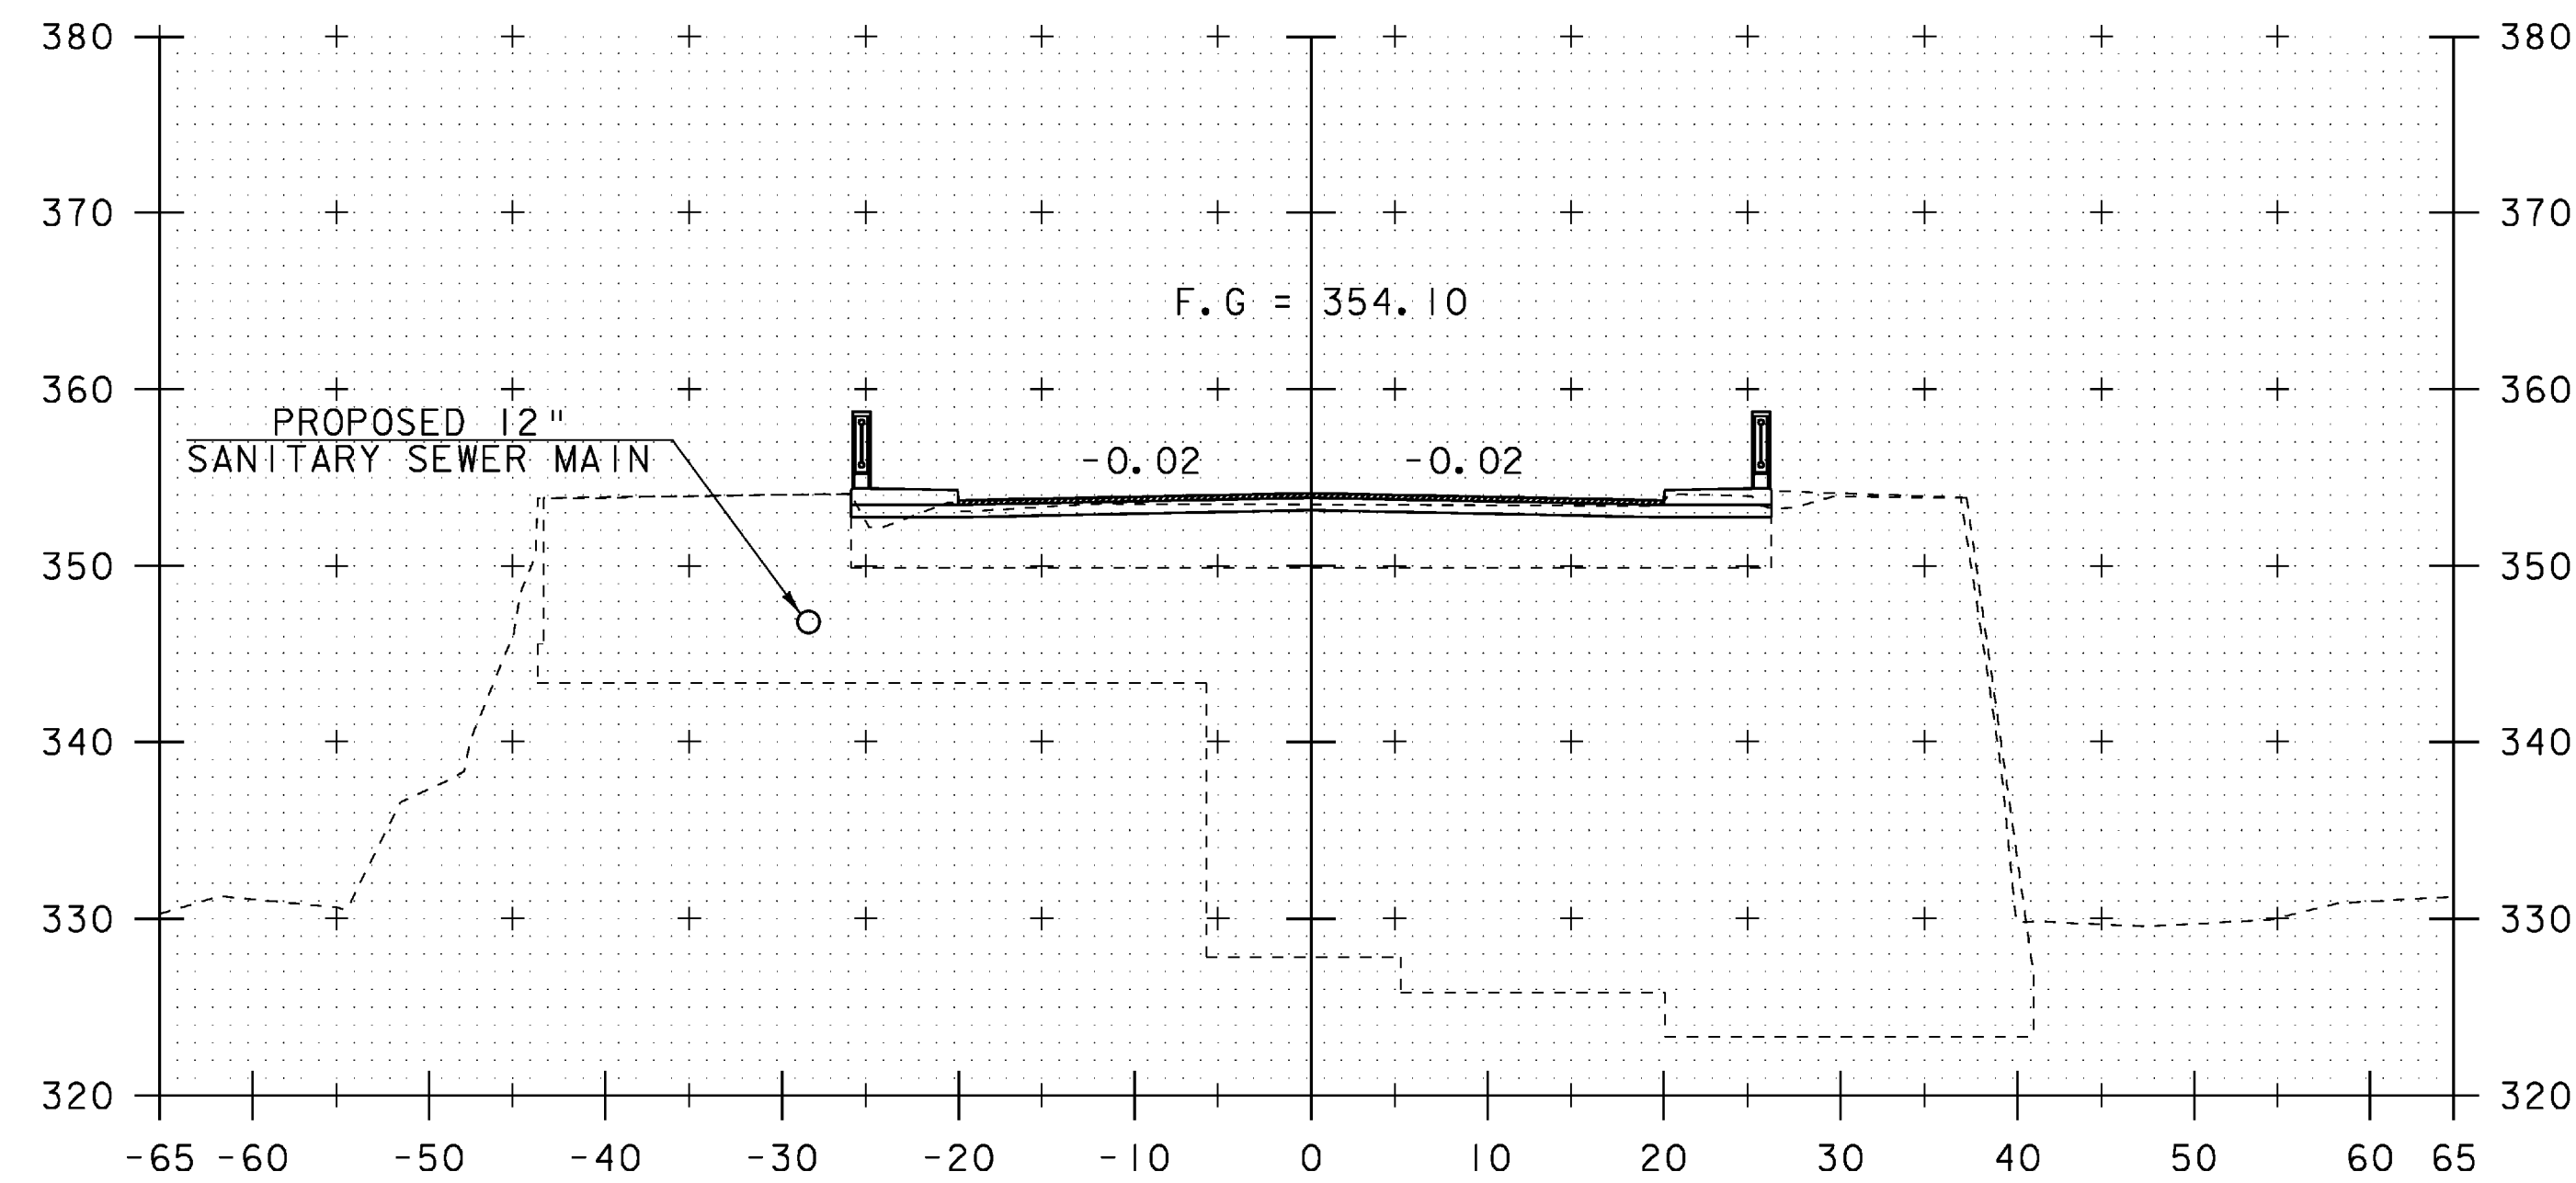


ML STA 257+93
 END APPROACH
 BEGIN PROJECT/BRIDGE
 SKEWED 8°

257+93

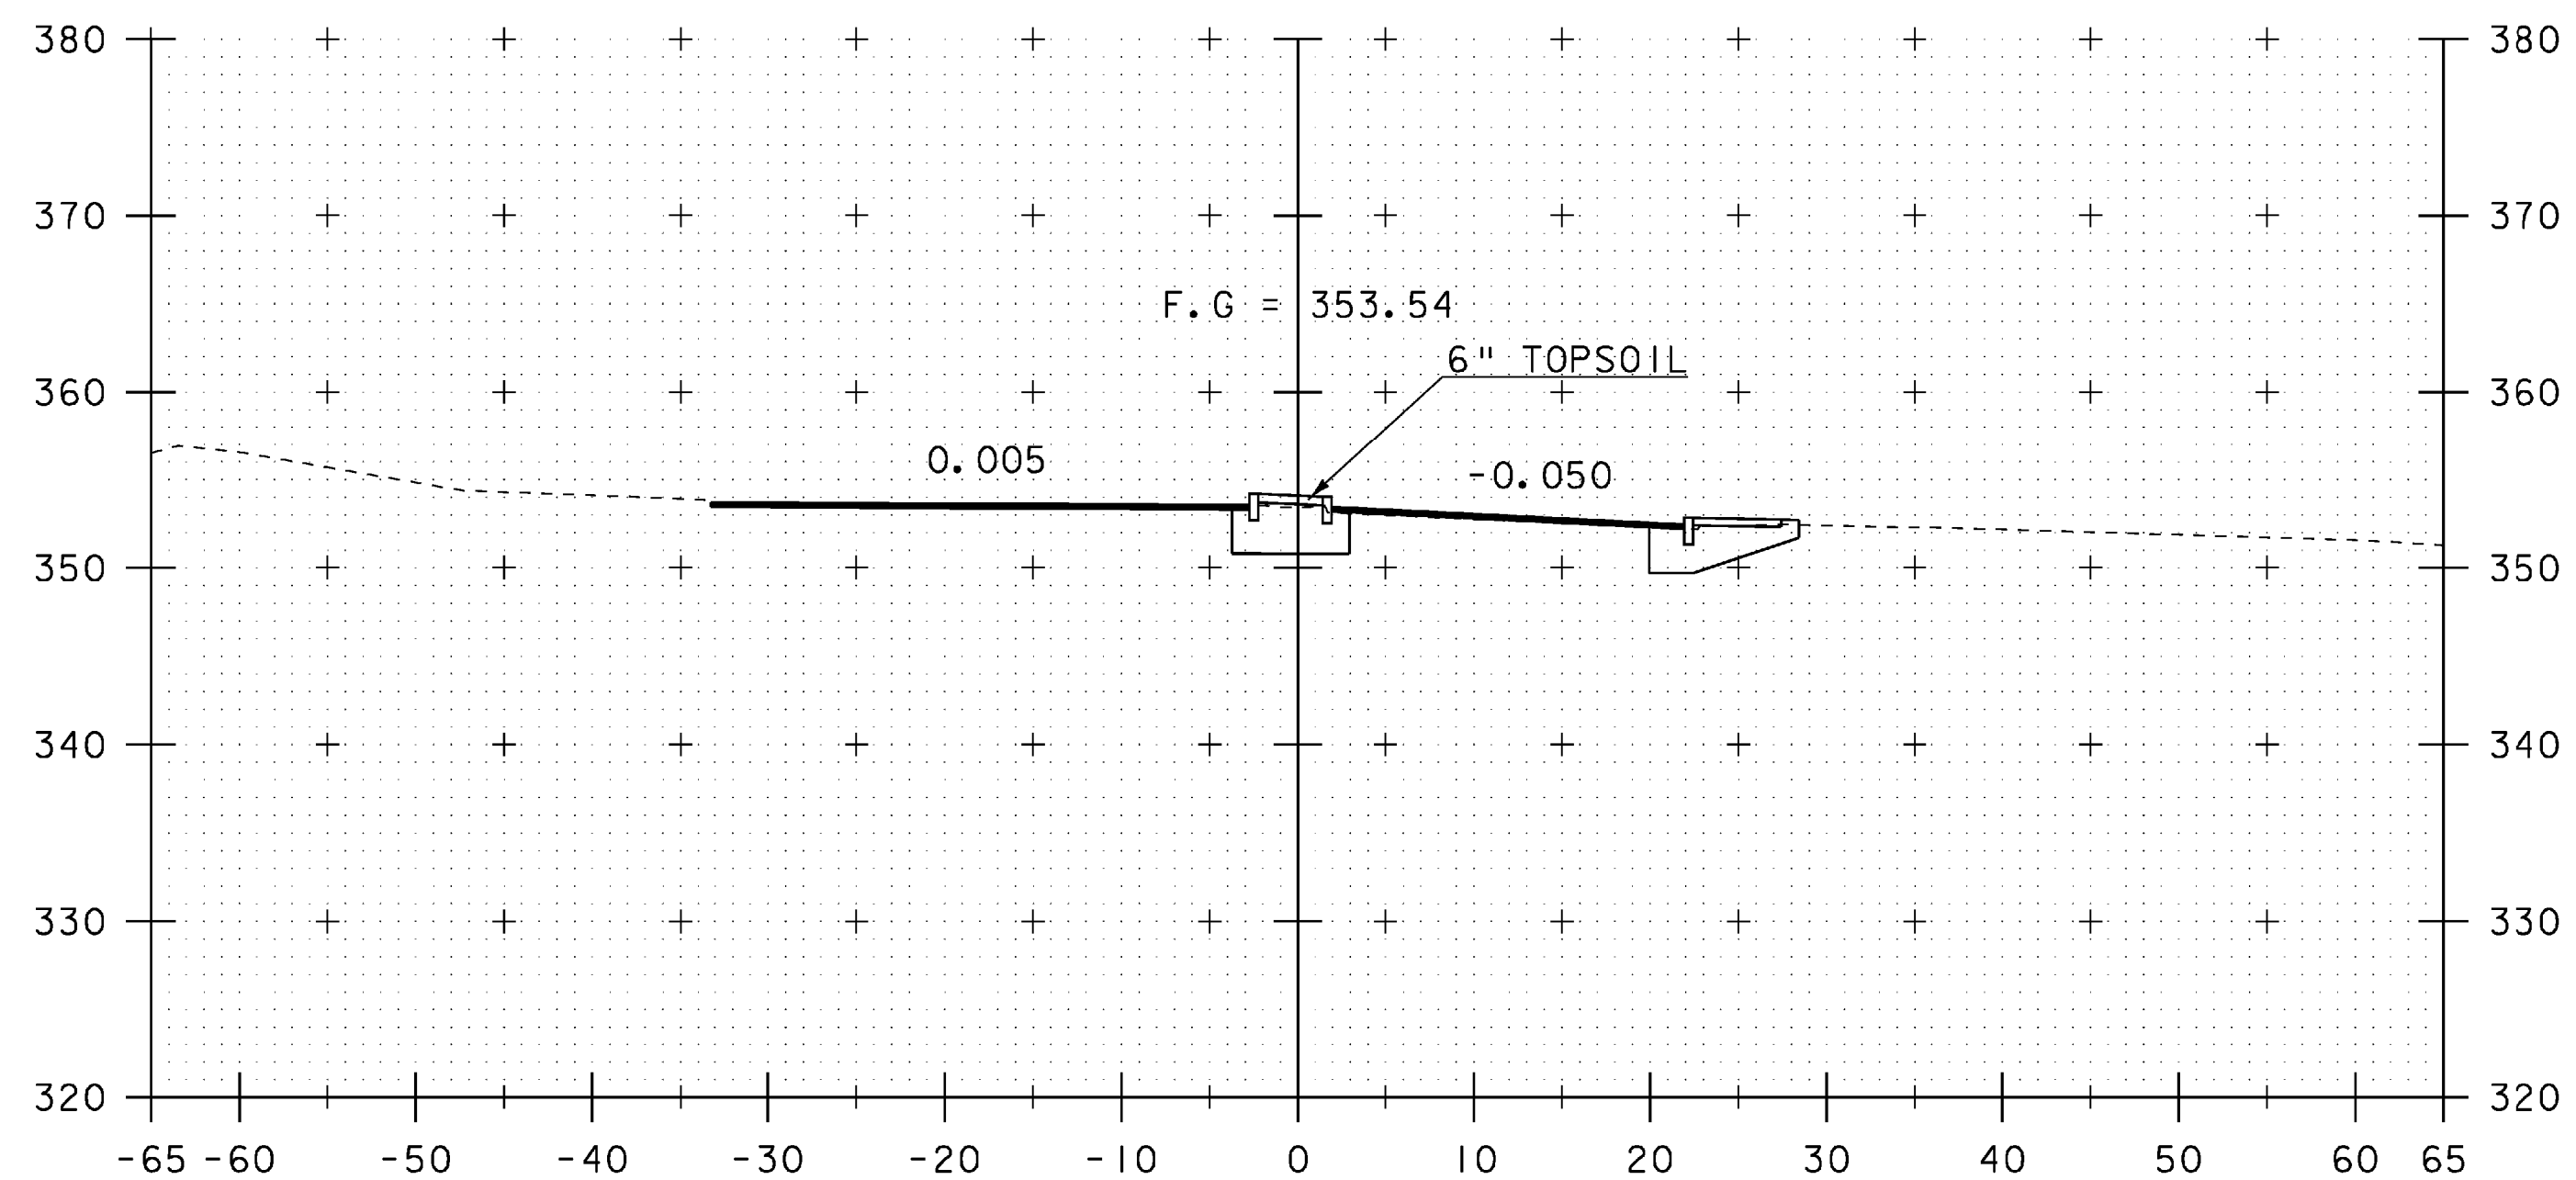

257+25

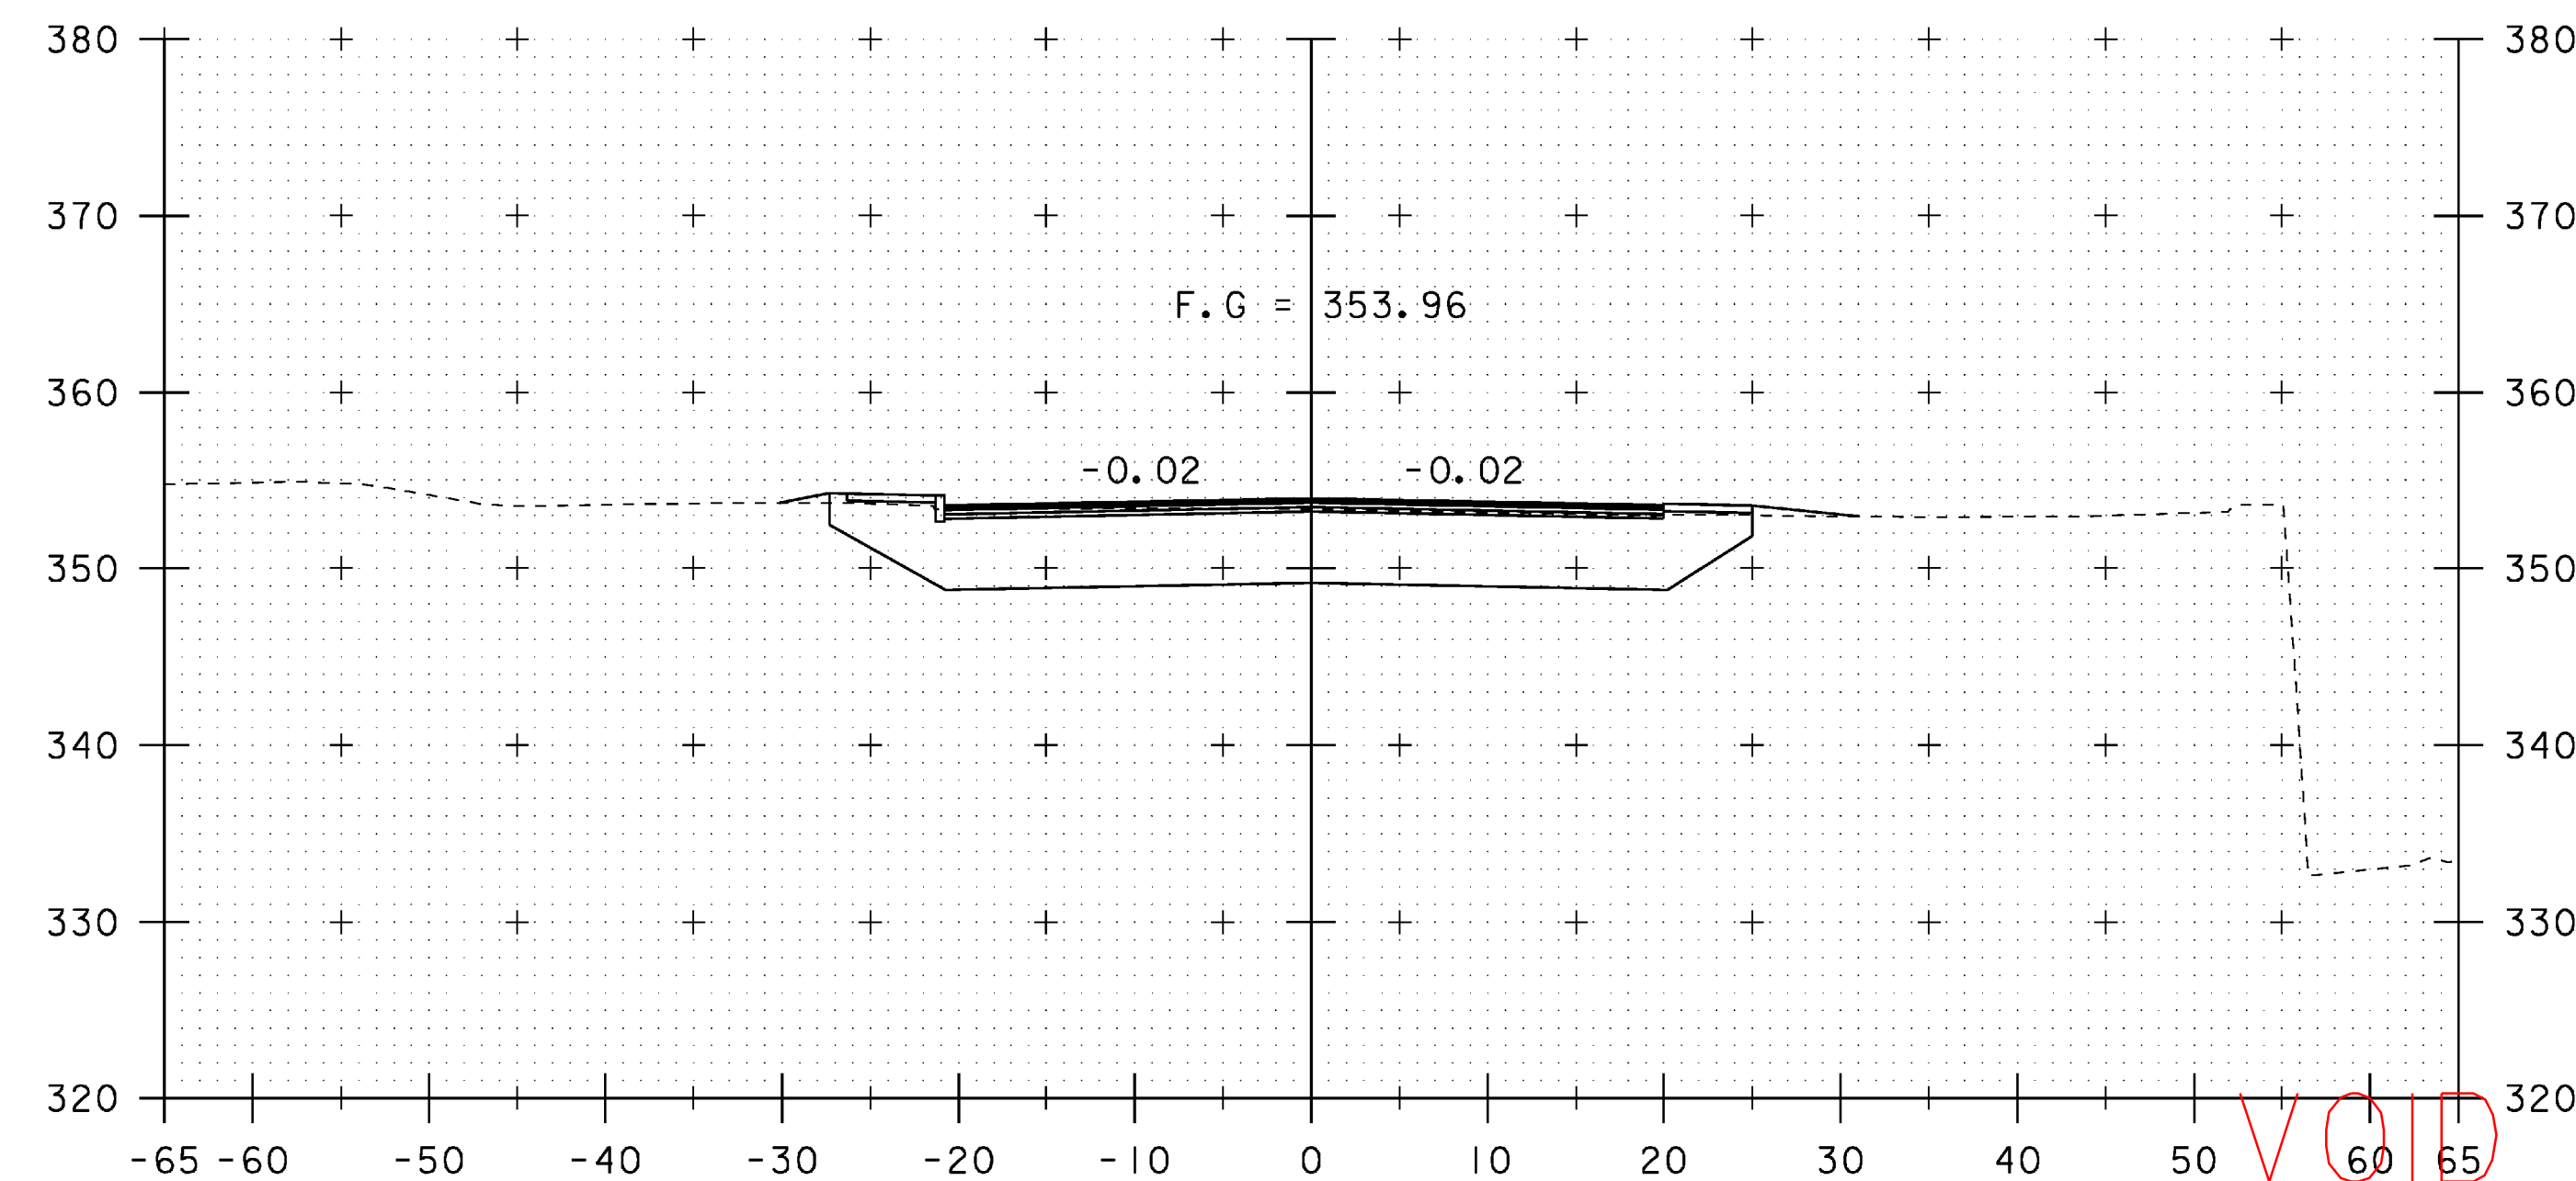

257+75

VOID
 SEE REVISED
 SHEET

STA. 257+25 TO STA. 257+93

PROJECT NAME:	SPRINGFIELD	FILE NAME:	06J004/str/s06J004xsl.dgn	PLOT DATE:	04-MAR-2009
PROJECT NUMBER:	BHF 016-2(14)	PROJECT LEADER:	R. WHITCOMB	DRAWN BY:	D. PETERSON
		DESIGNED BY:	D. PETERSON	CHECKED BY:	C. CARLSON
		MAINLINE CROSS SECTIONS (2)		SHEET	46 OF 72