




258+25

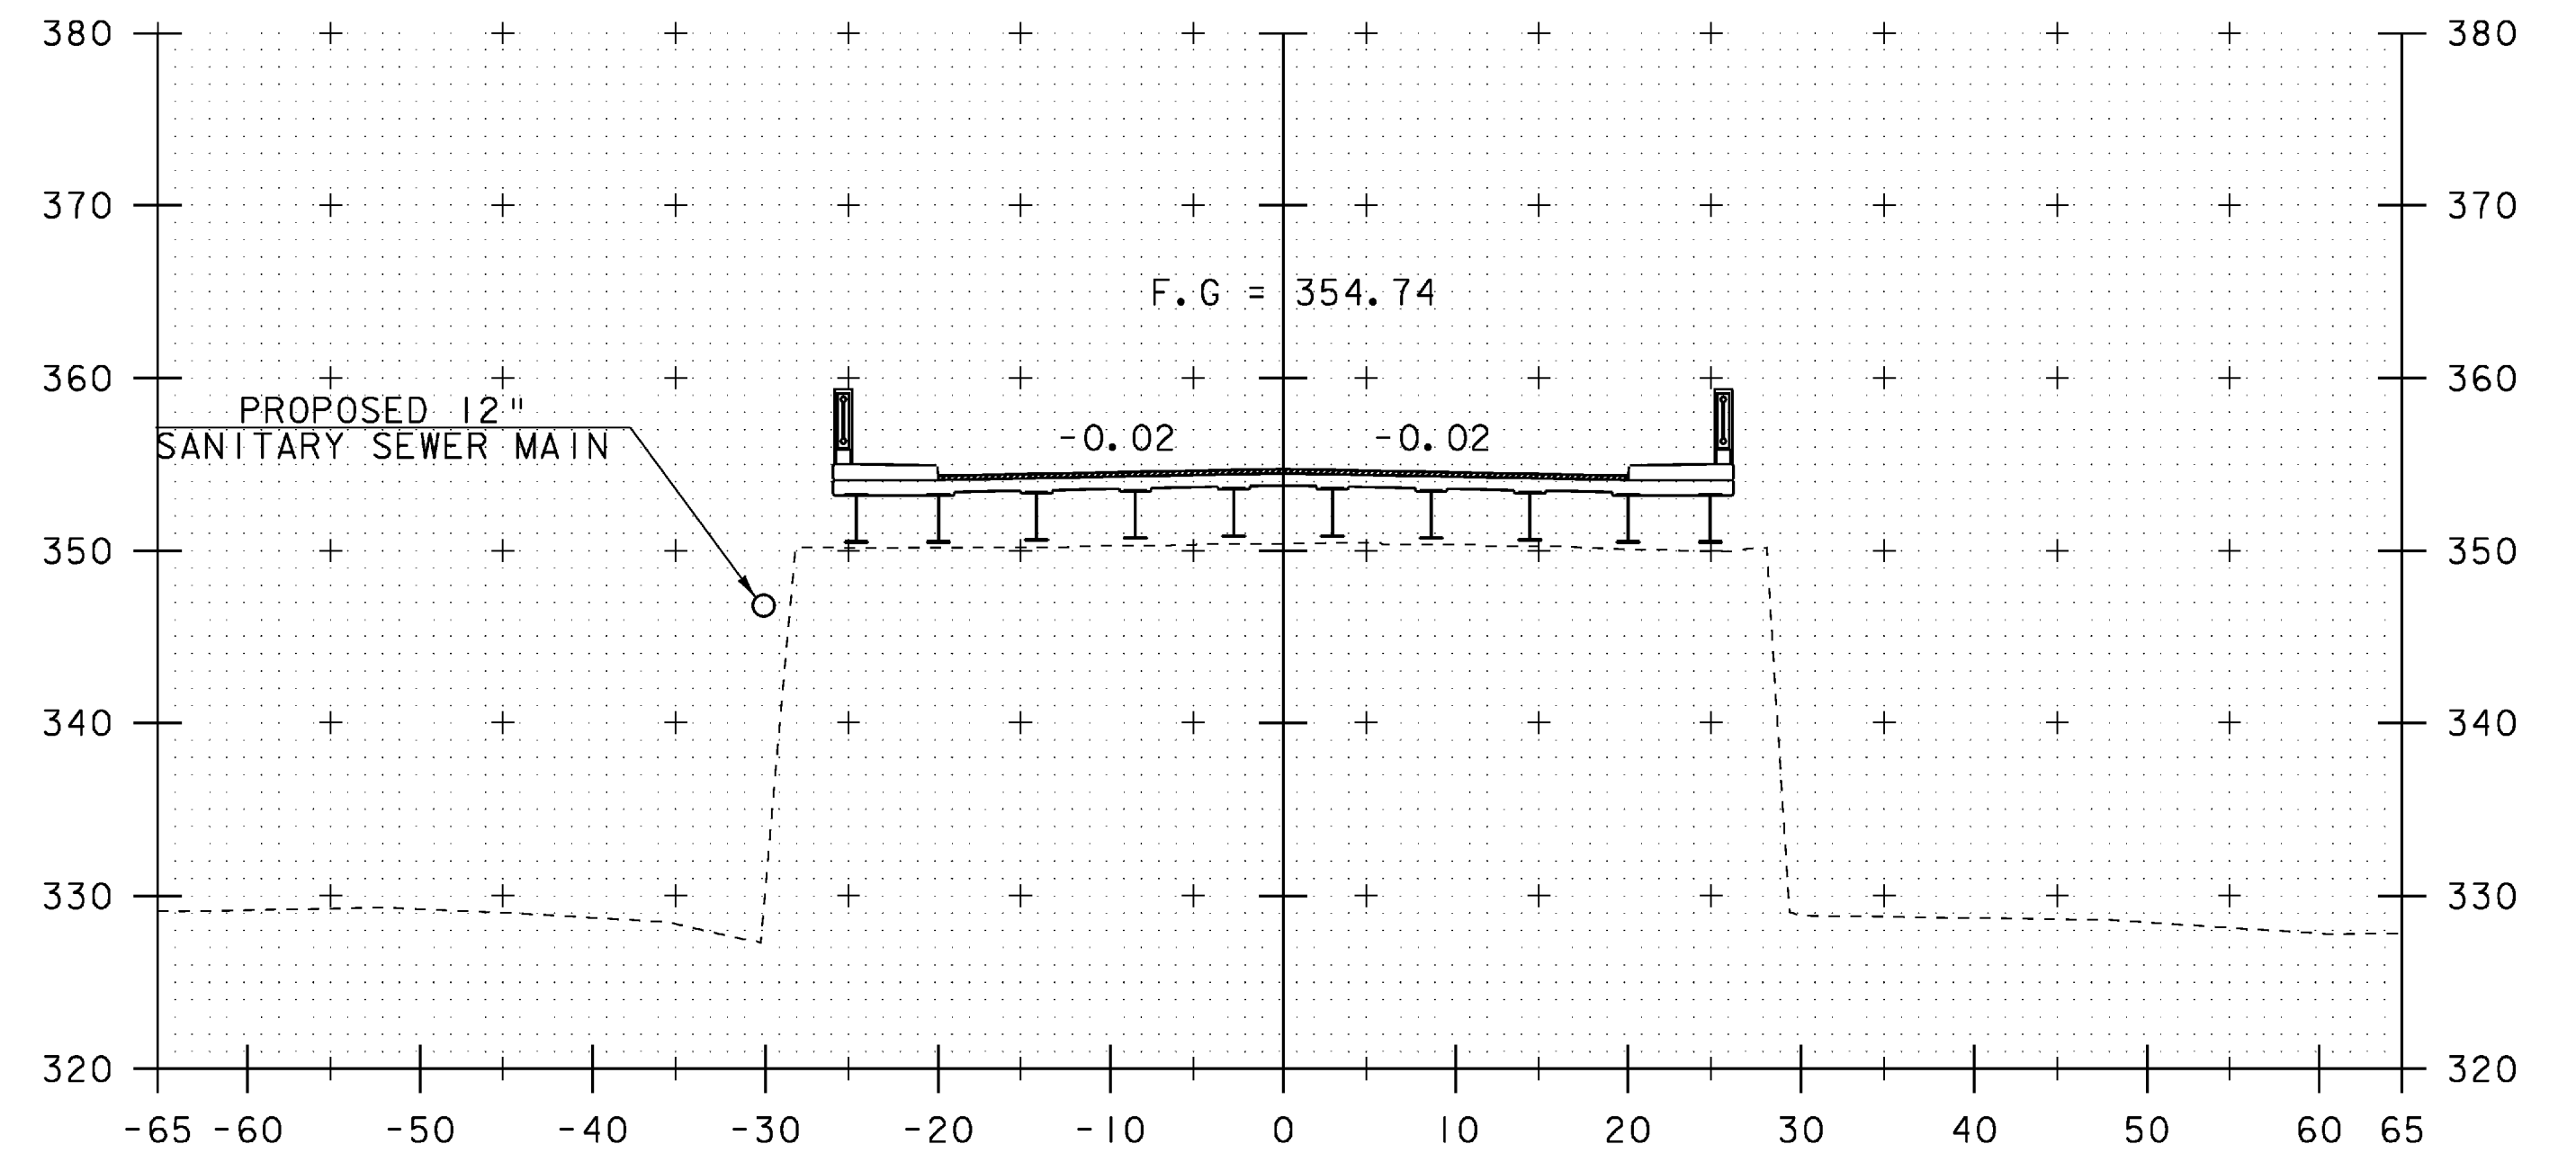

258+72

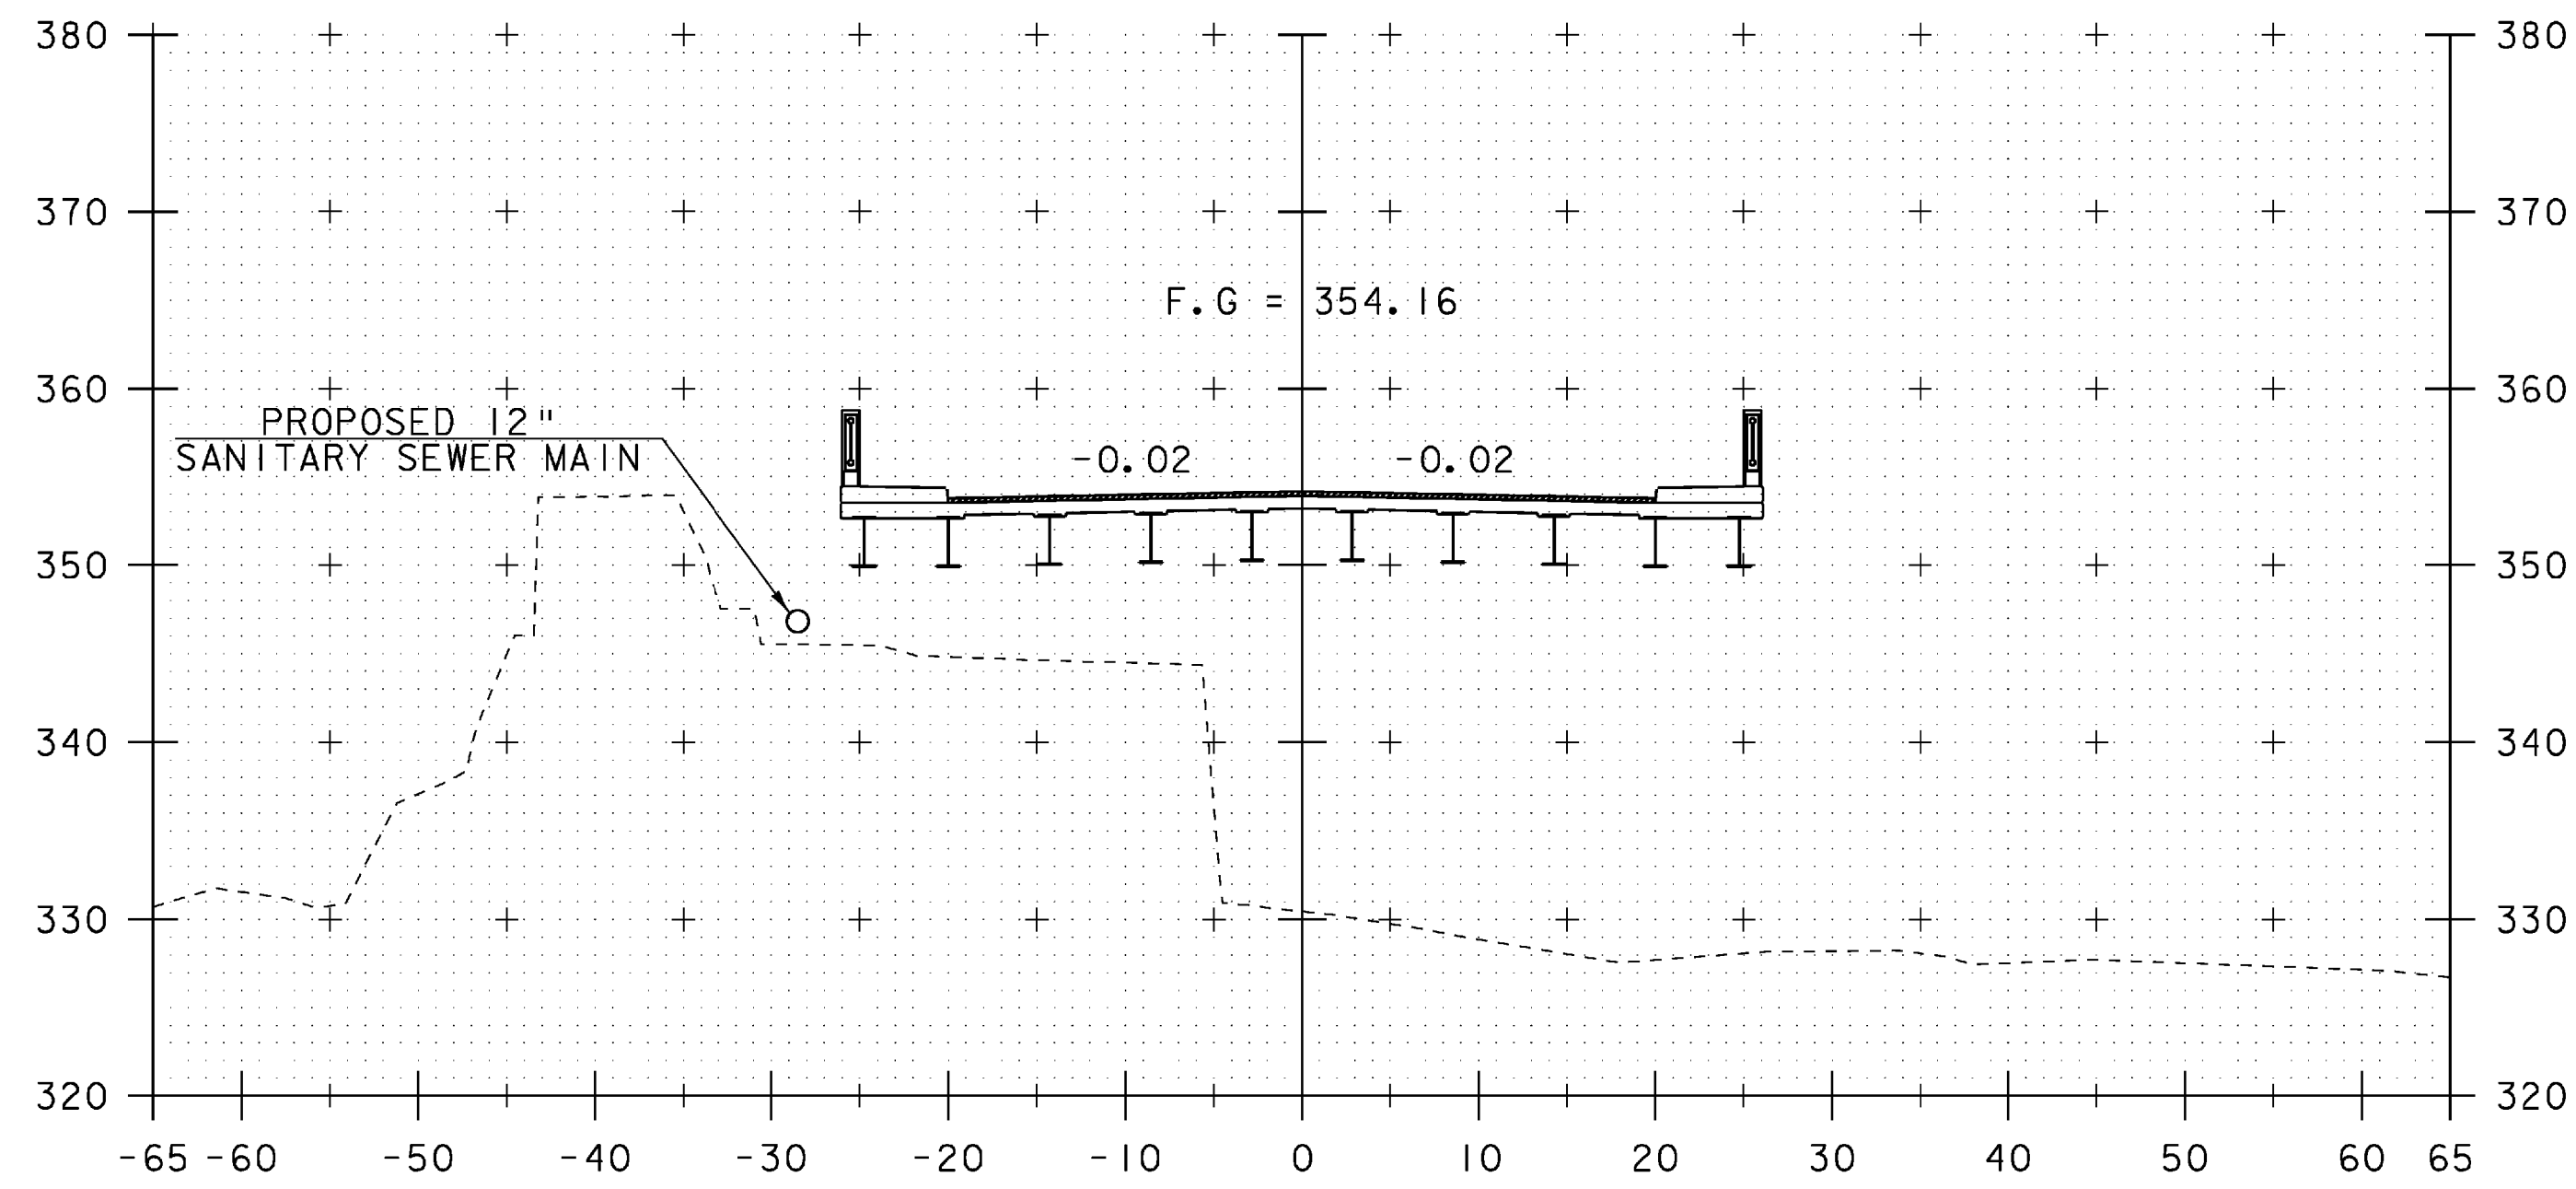

258+00

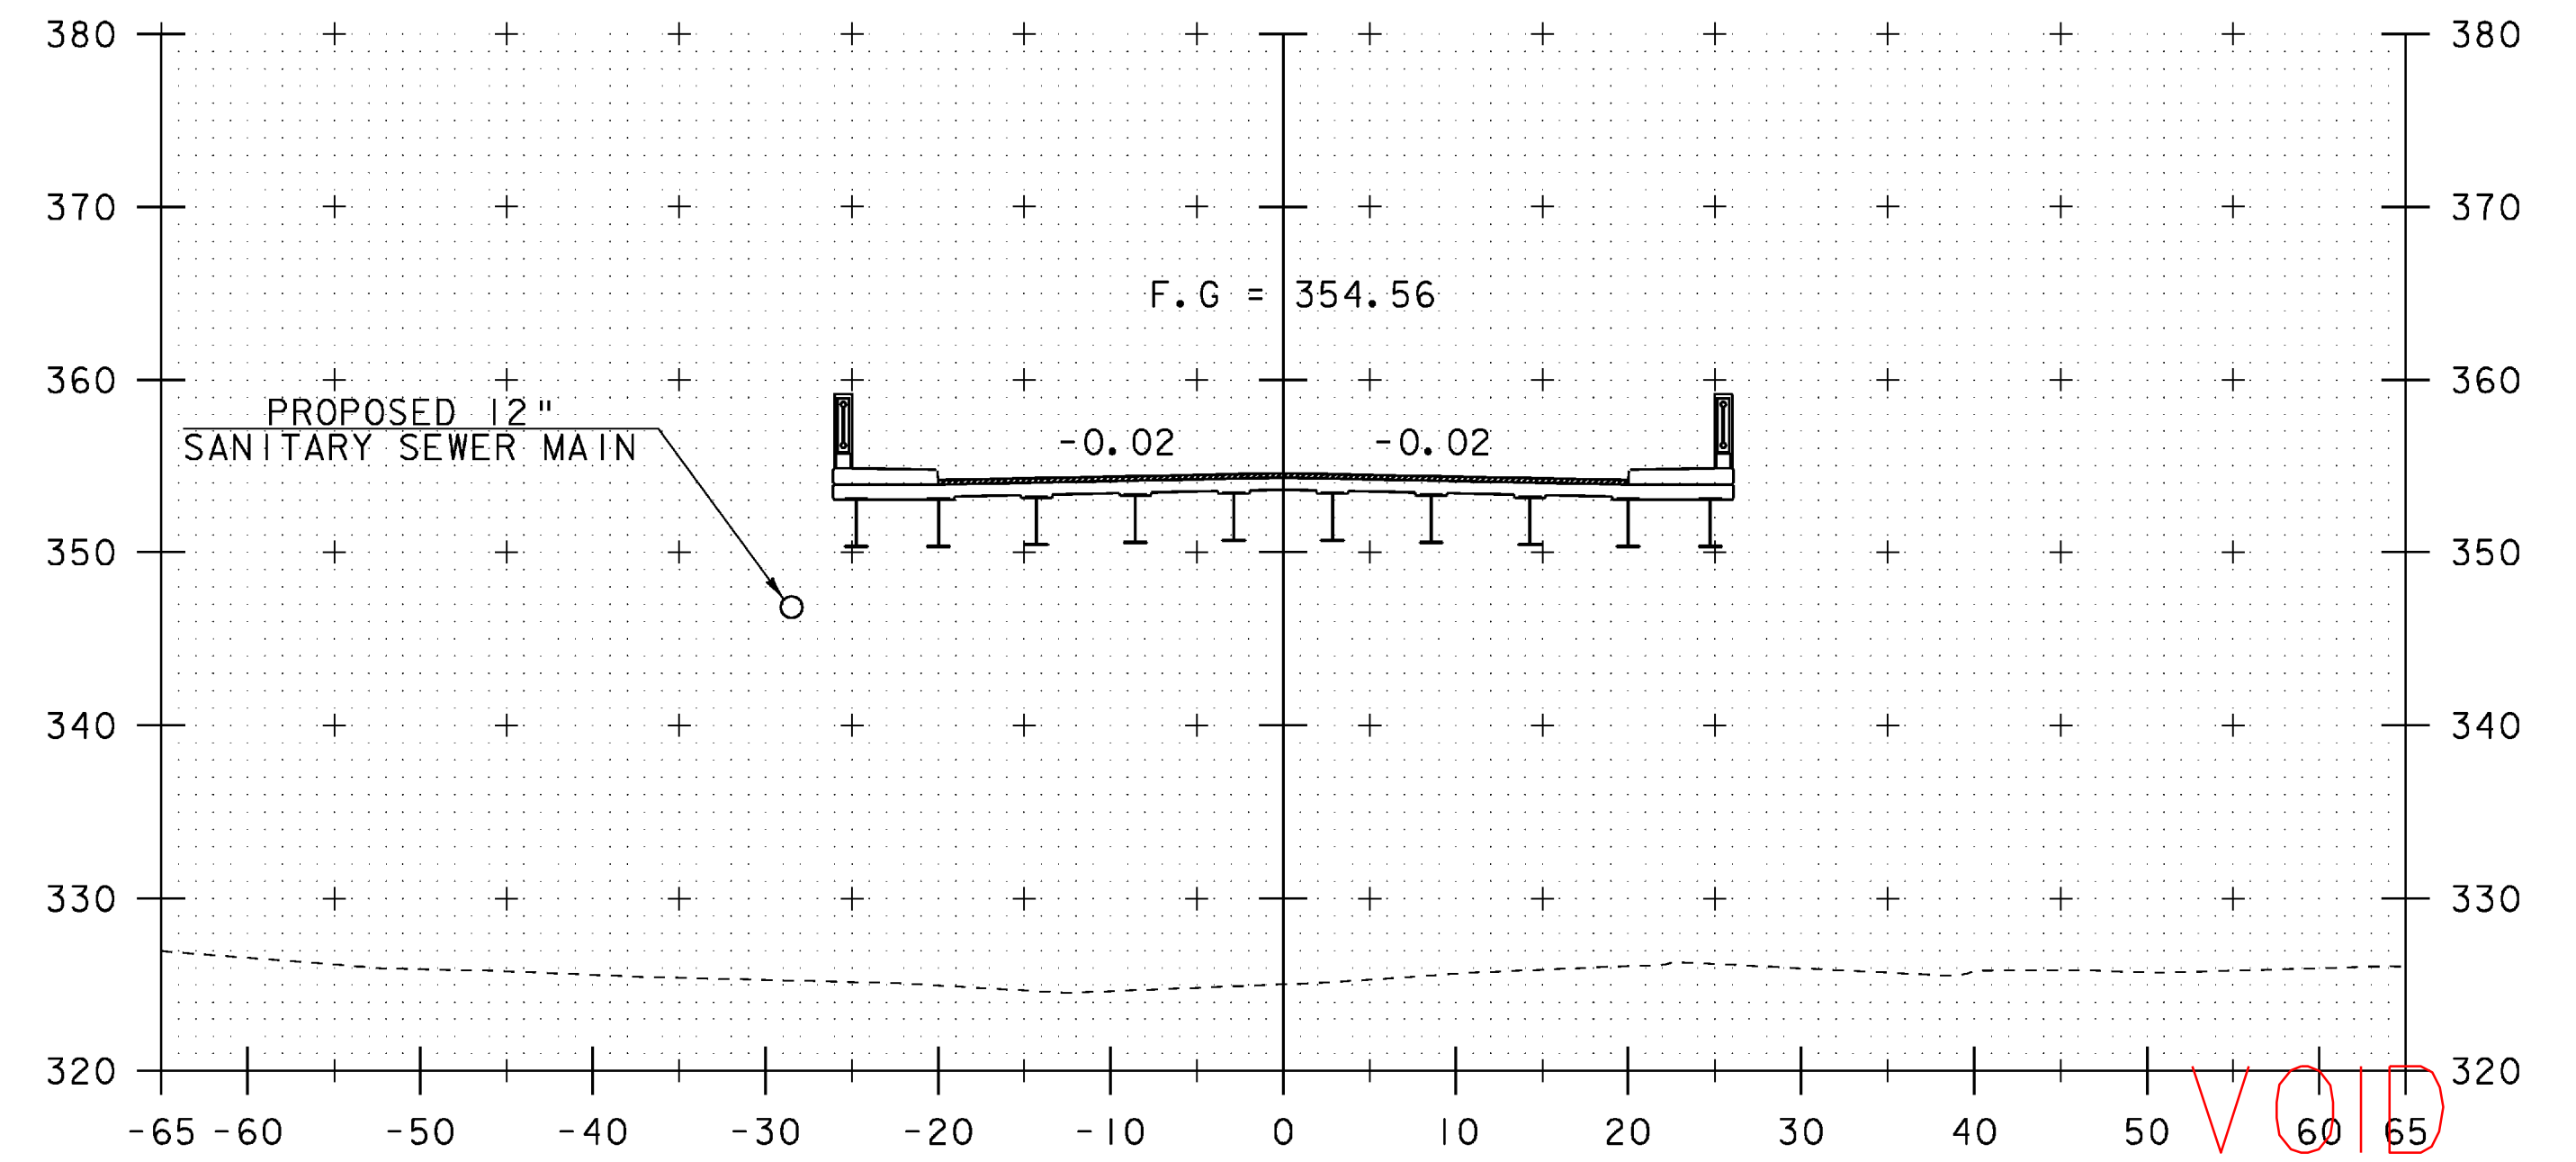

258+50

VOID
SEE REVISED
SHEET

STA. 258+00 TO STA. 258+72

PROJECT NAME:	SPRINGFIELD	FILE NAME:	06J004/str/s06J004xsl.dgn	PLOT DATE:	04-MAR-2009
PROJECT NUMBER:	BHF 016-2(14)	PROJECT LEADER:	R. WHITCOMB	DRAWN BY:	D. PETERSON
		DESIGNED BY:	D. PETERSON	CHECKED BY:	C. CARLSON
		MAINLINE CROSS SECTIONS (3)		SHEET	47 OF 72