



259+00

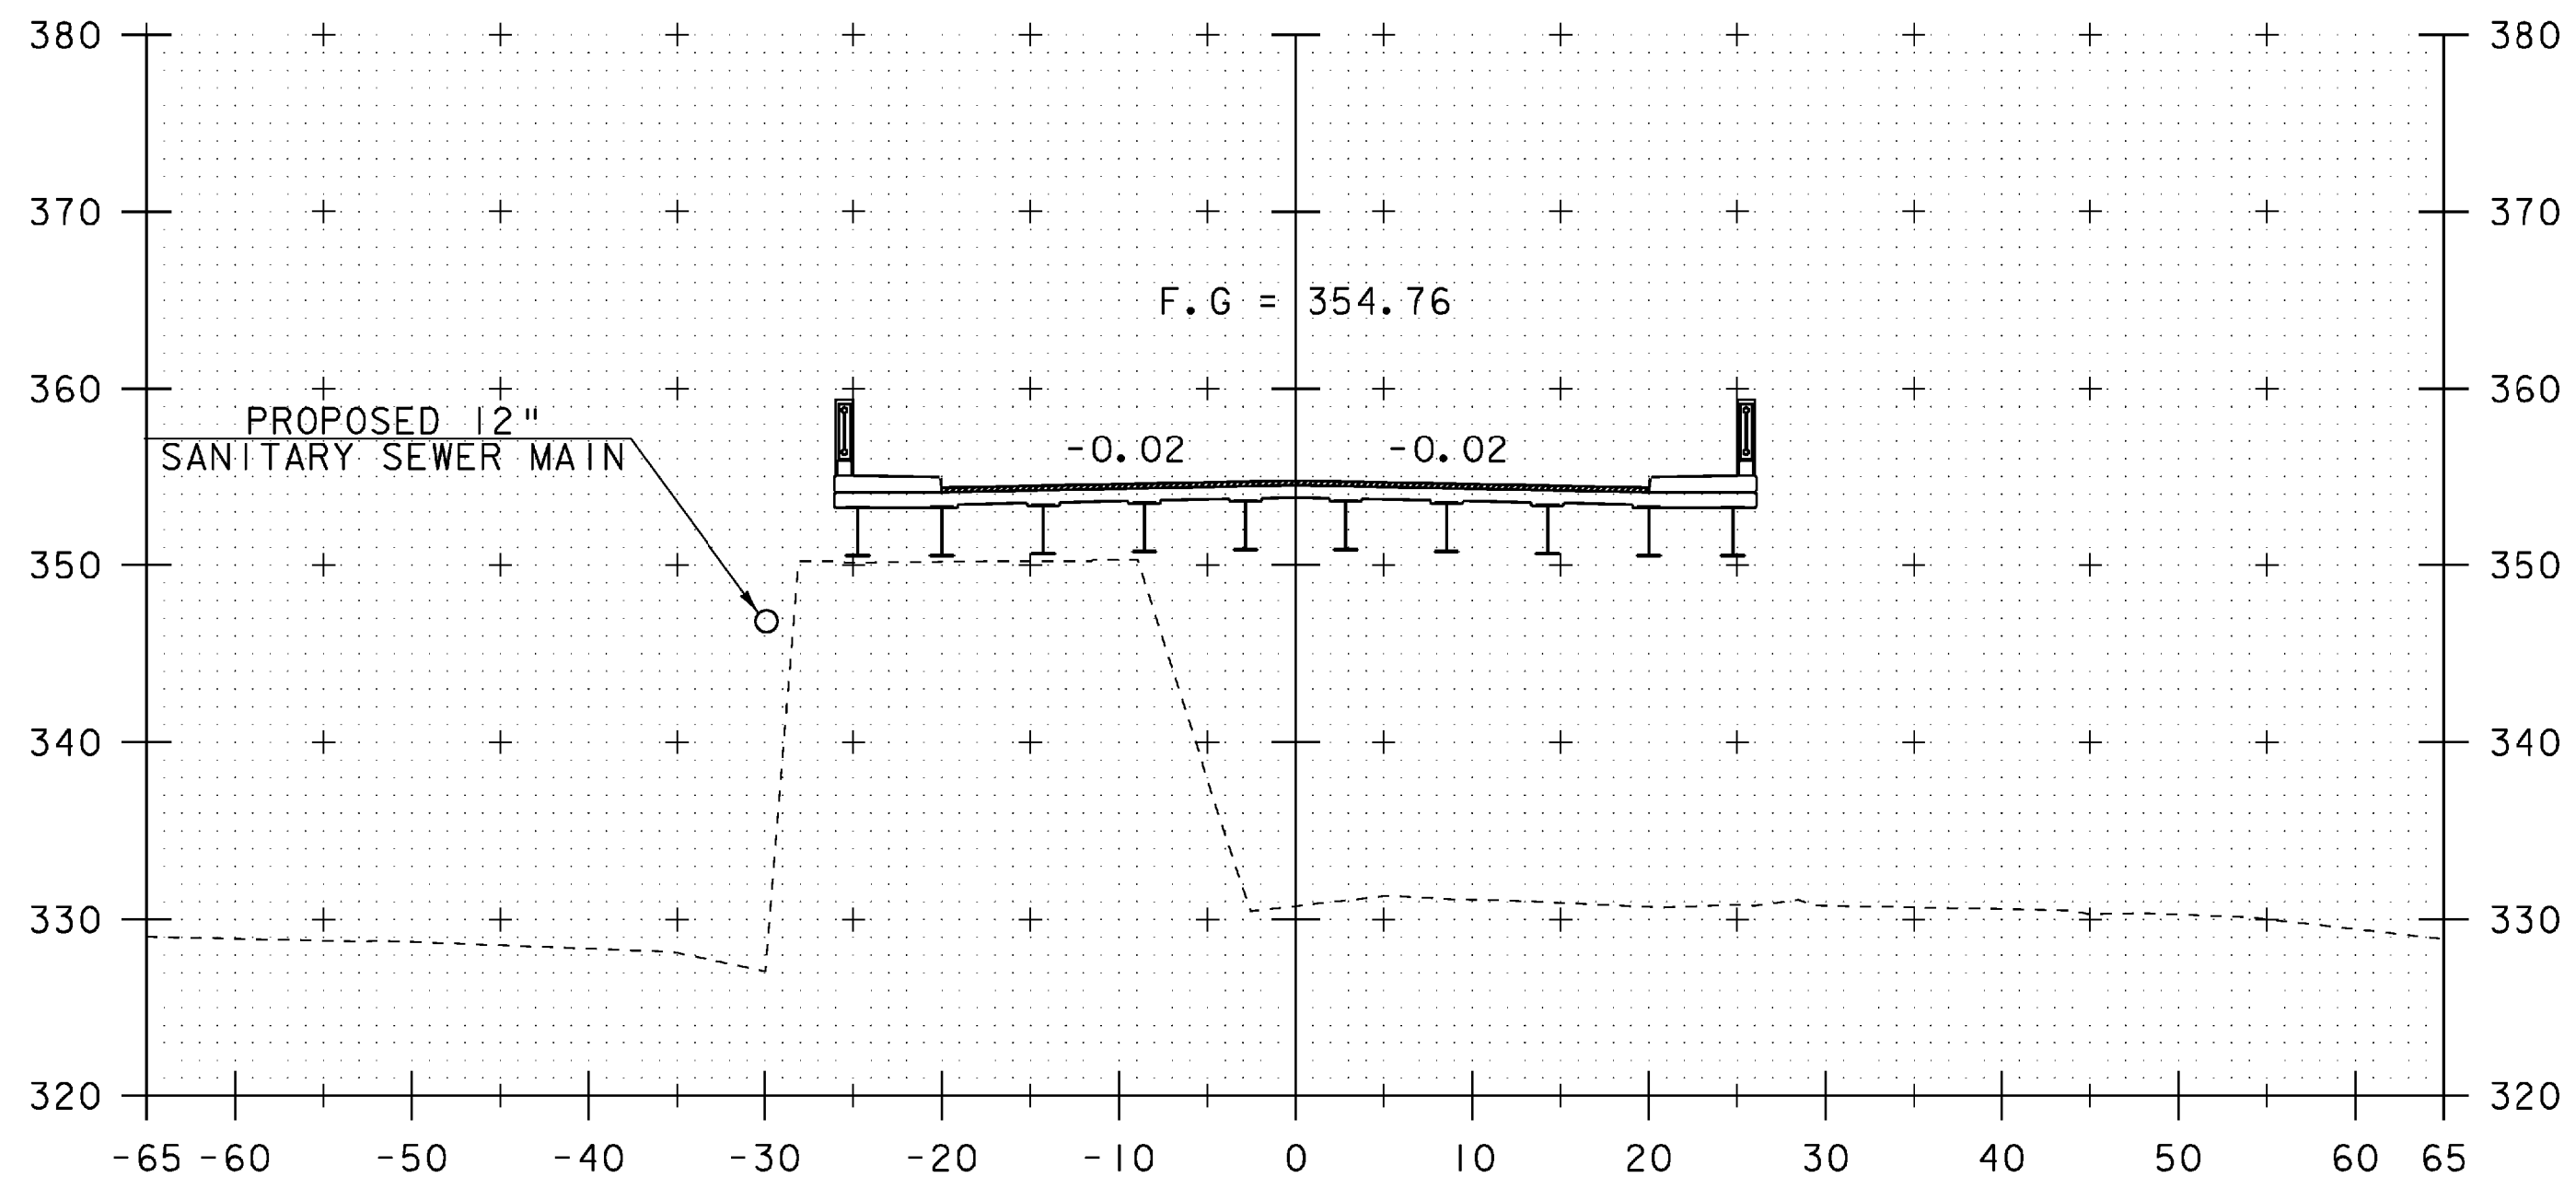


258+75

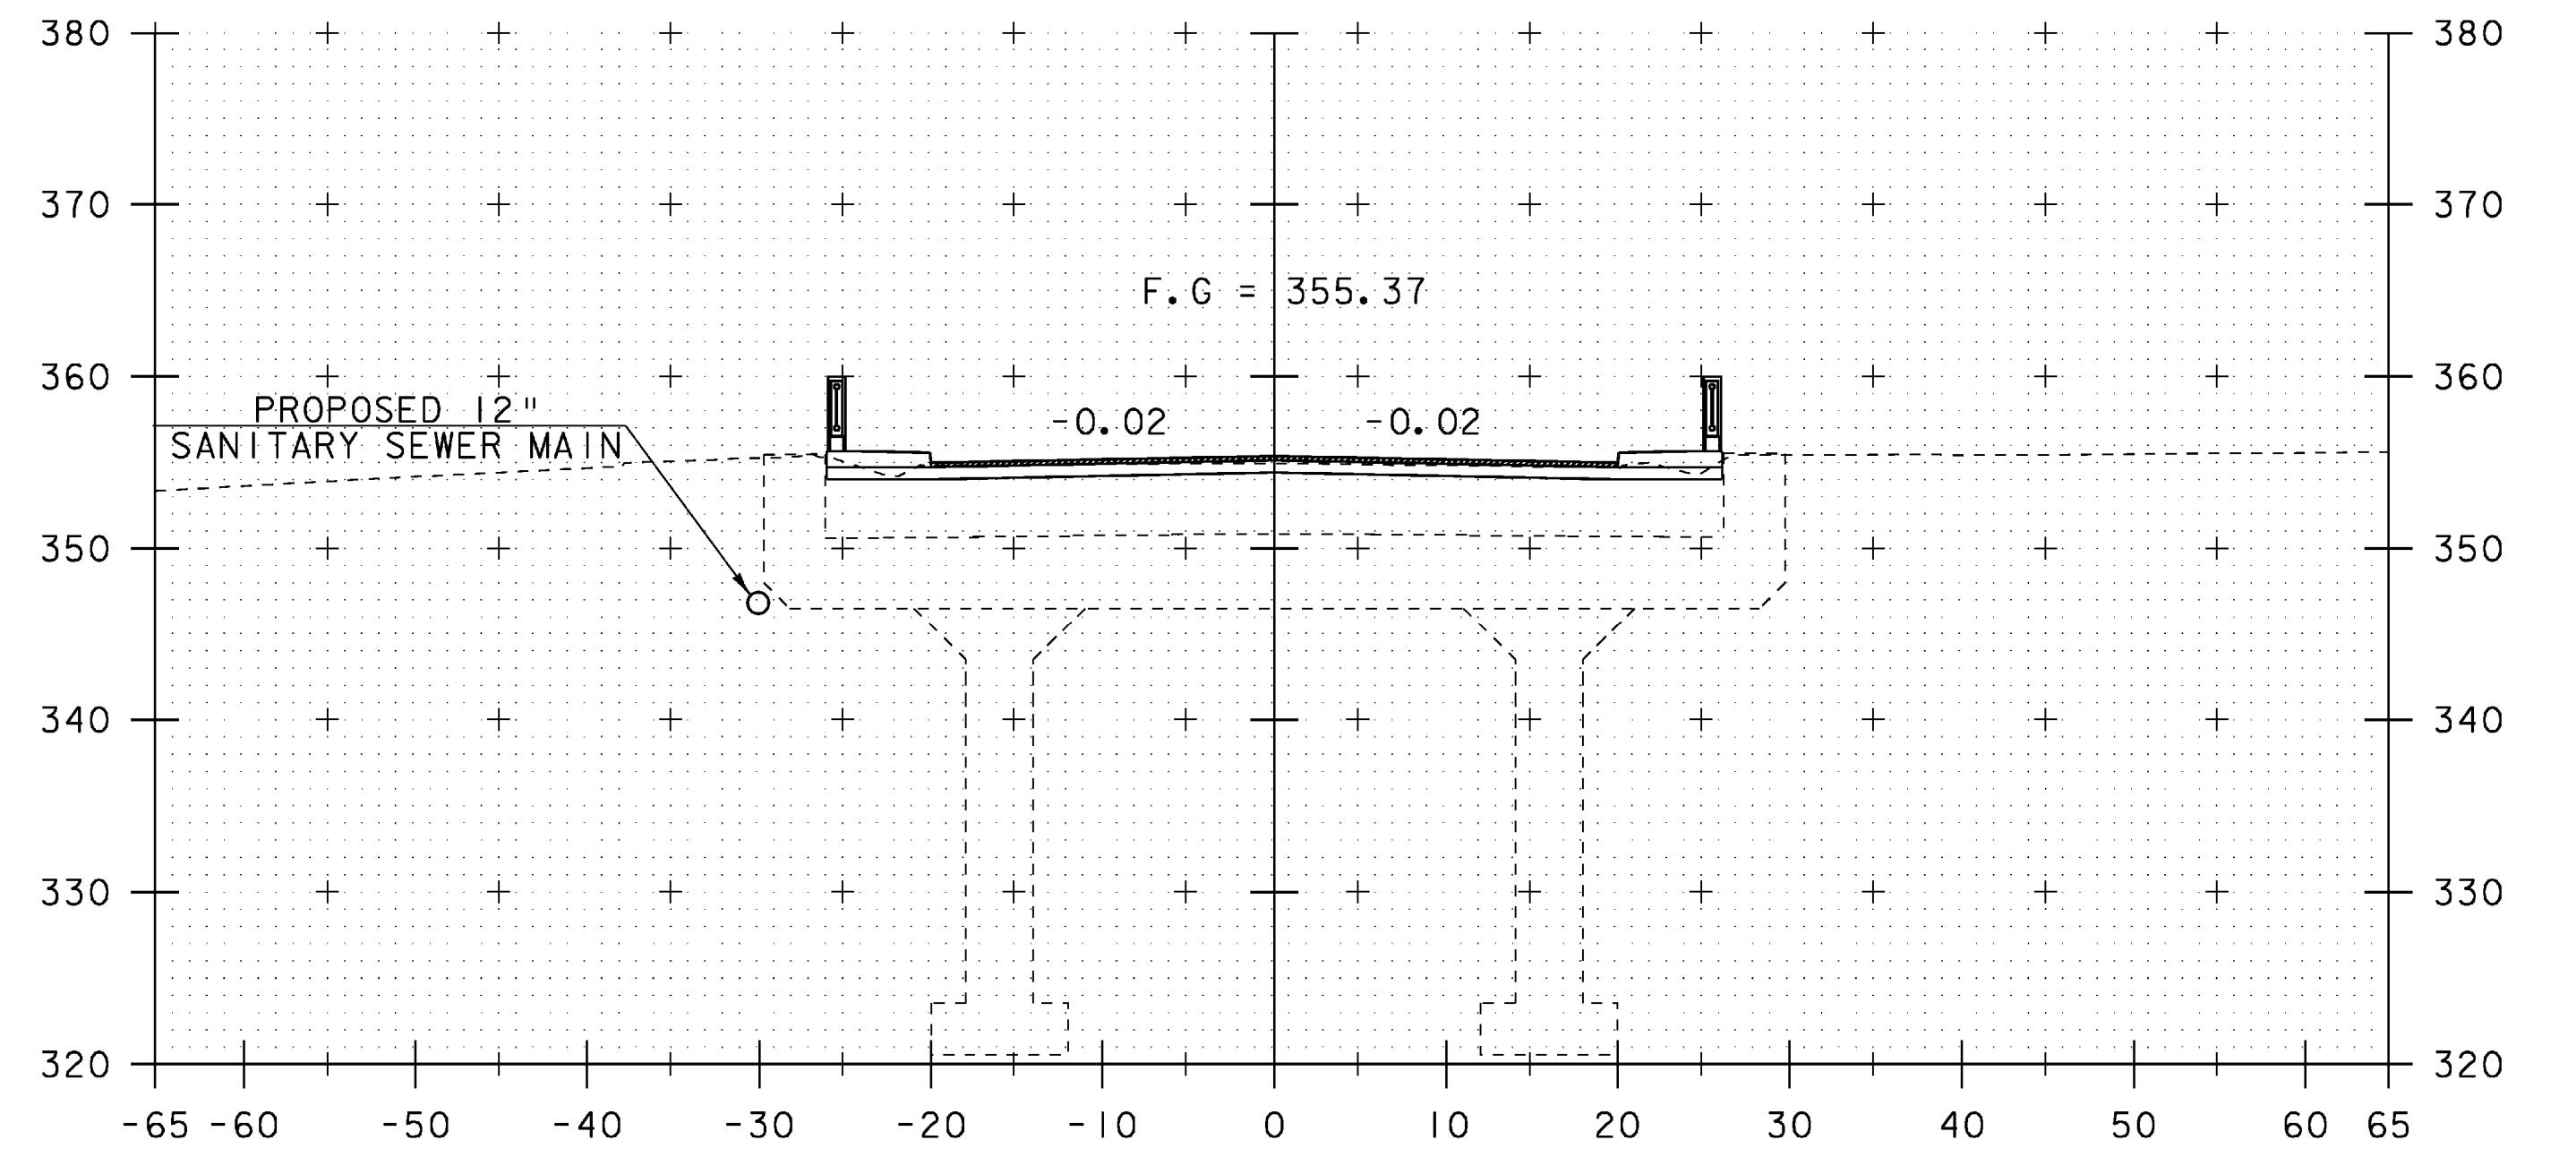

ML STA 259+51.25
END BRIDGE/PROJECT
BEGIN APPROACH
SKEWED 8°

259+51.25

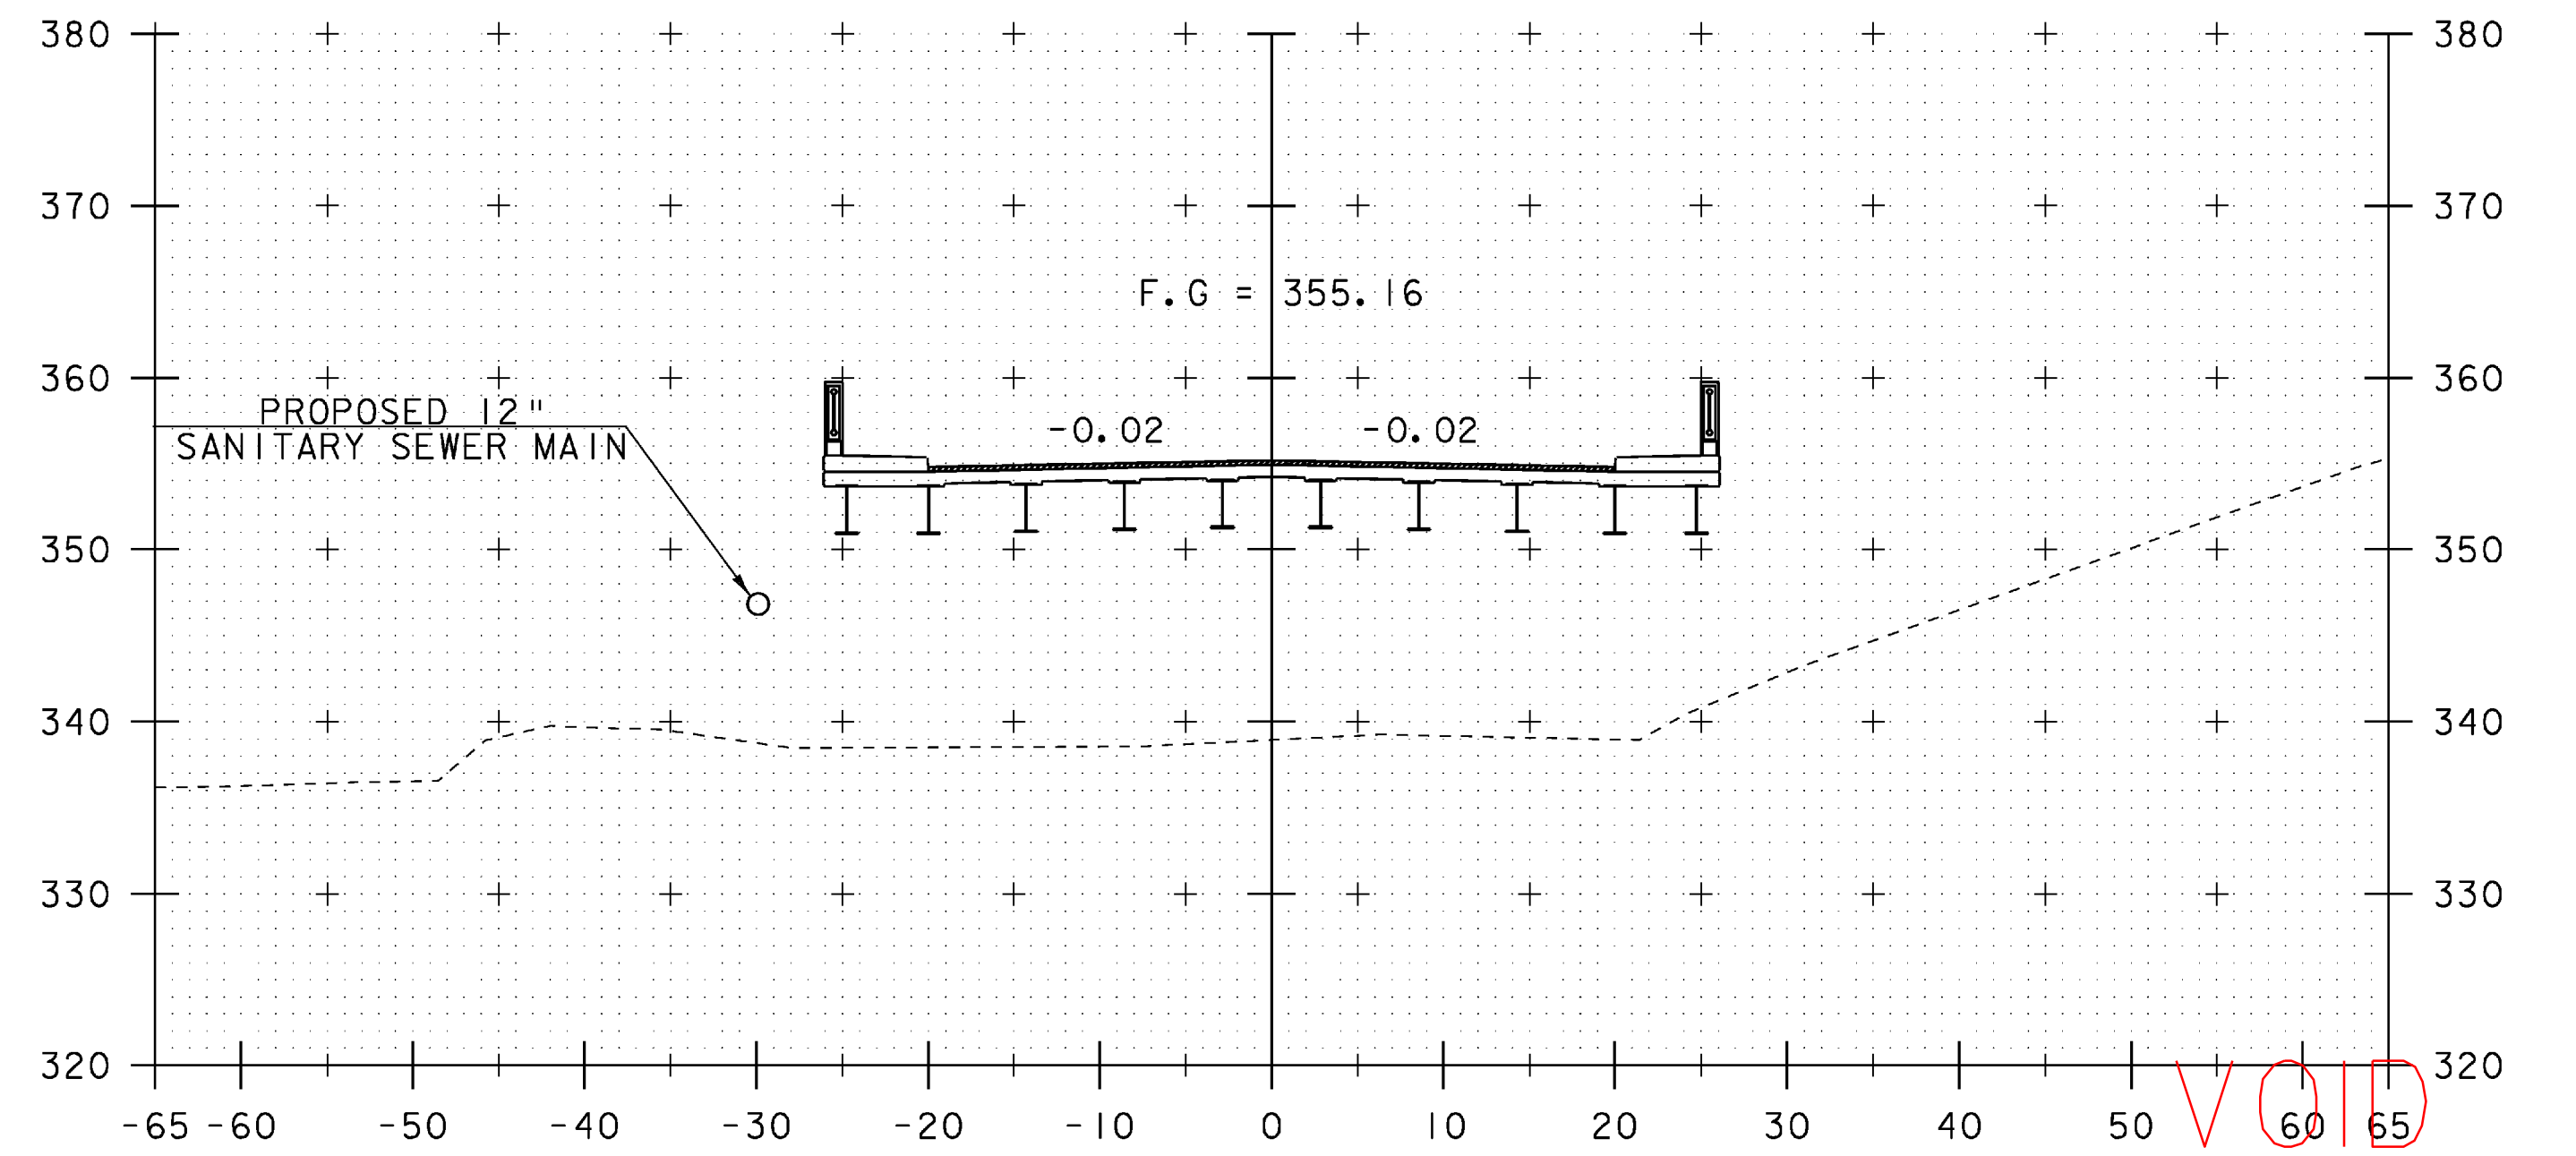

259+25

VOID
SEE REVISED
SHEET

STA. 258+75 TO STA. 259+51.25

PROJECT NAME:	SPRINGFIELD	FILE NAME:	06J004/str/s06J004xsl.dgn	PLOT DATE:	04-MAR-2009
PROJECT NUMBER:	BHF 016-2(14)	PROJECT LEADER:	R. WHITCOMB	DRAWN BY:	D. PETERSON
		DESIGNED BY:	D. PETERSON	CHECKED BY:	C. CARLSON
		MAINLINE CROSS SECTIONS (4)		SHEET	48 OF 72