



259+00

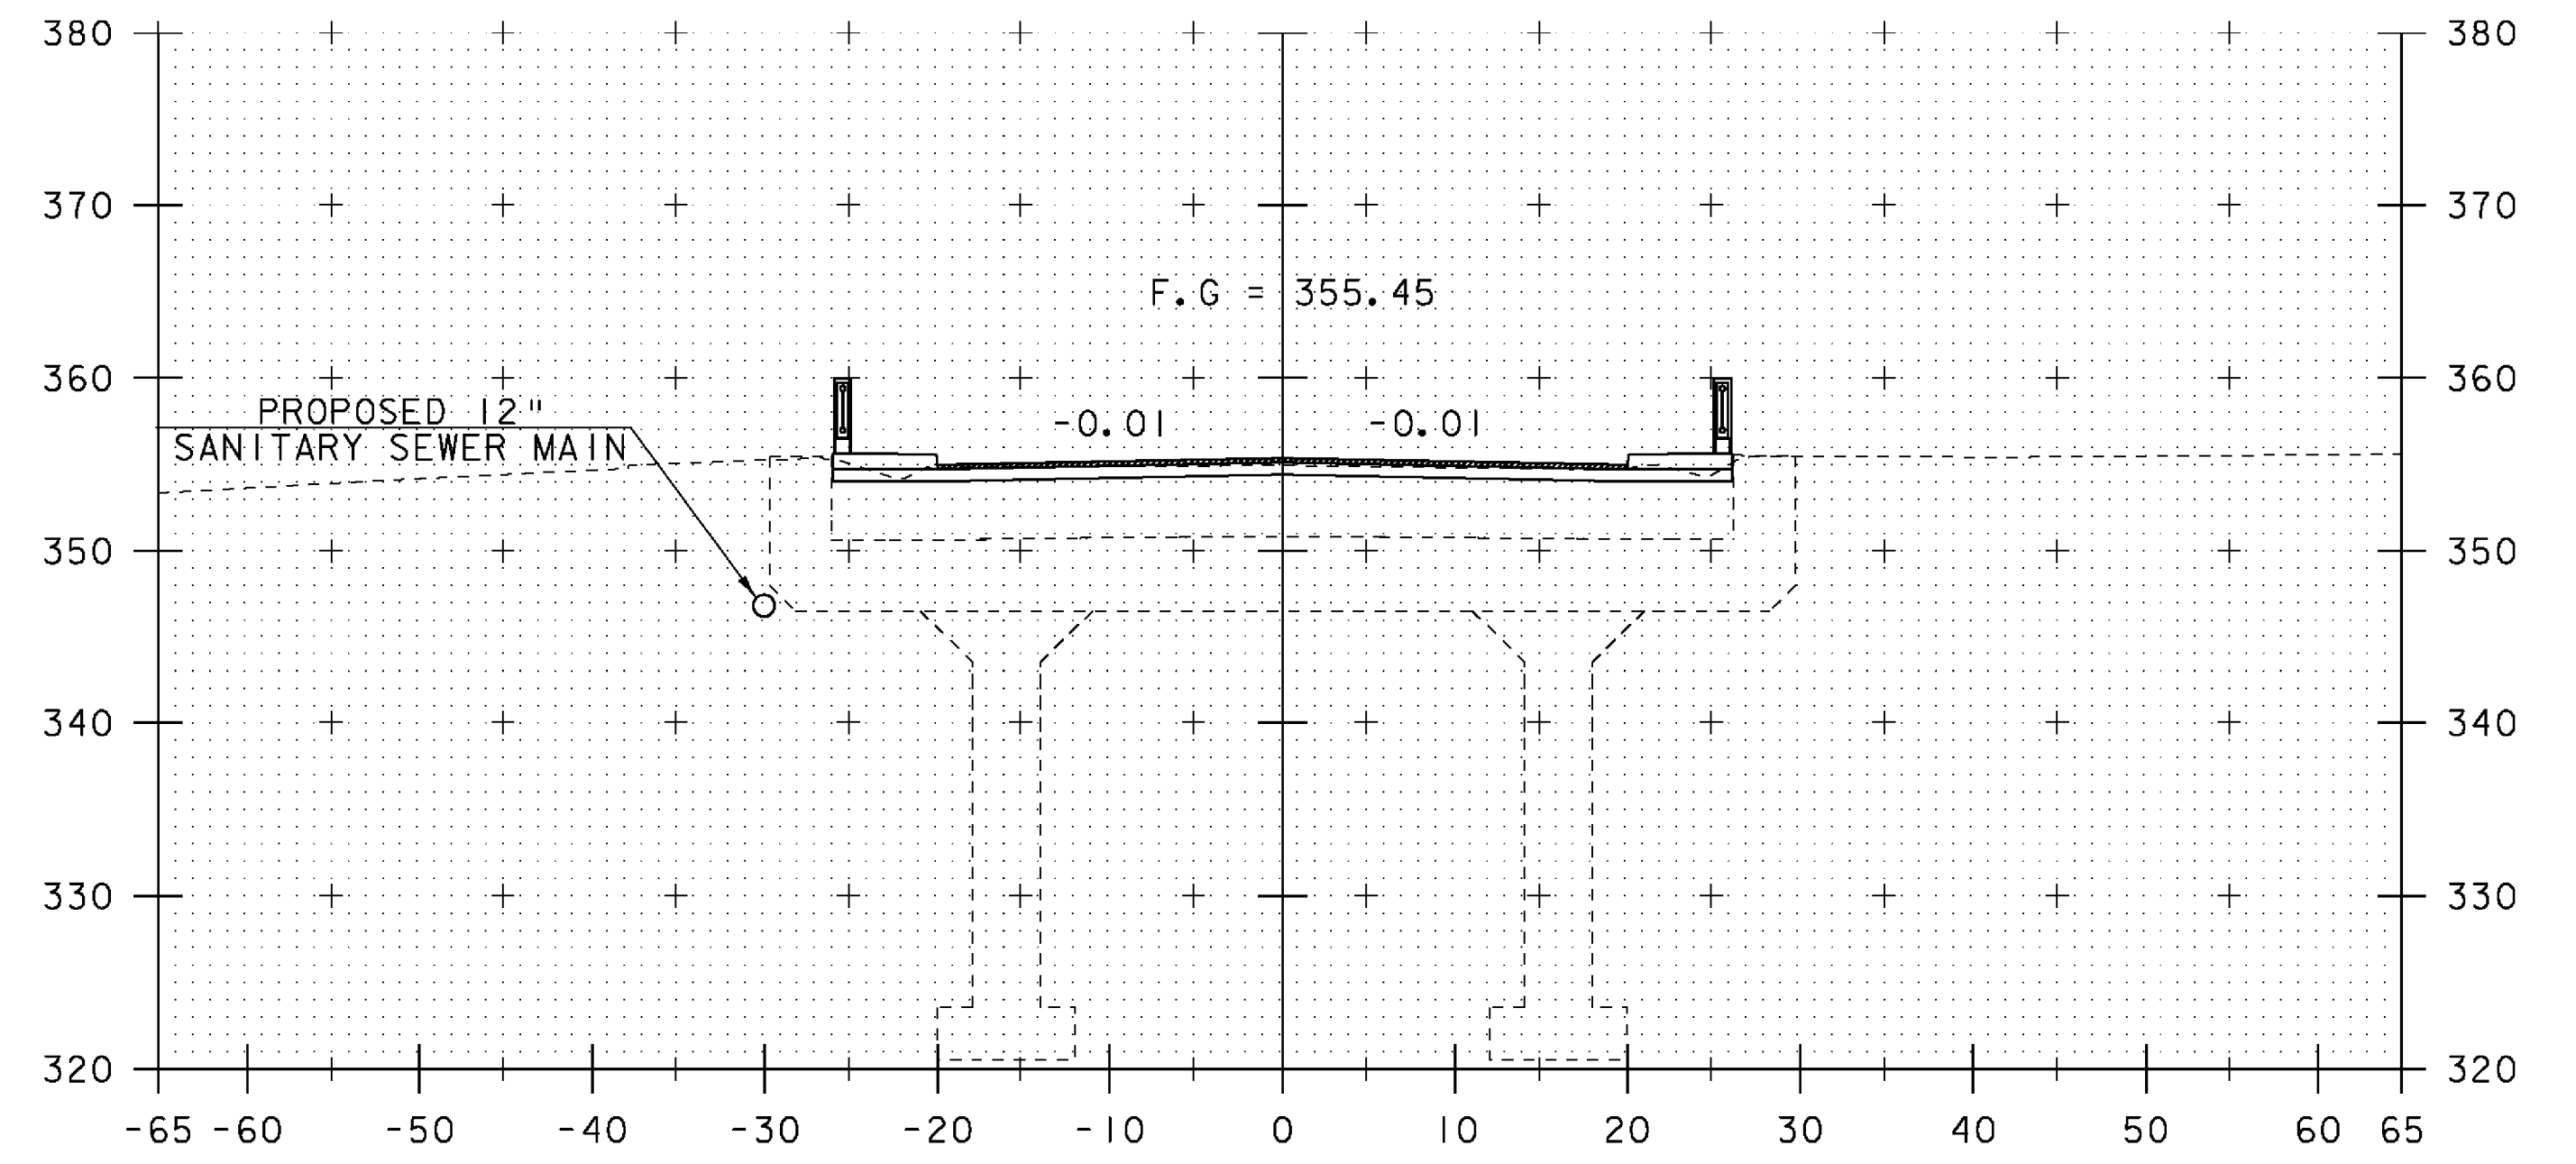


ML STA 259+51.25
 END BRIDGE/PROJECT
 BEGIN APPROACH
 SKEWED 8°

259+51.25

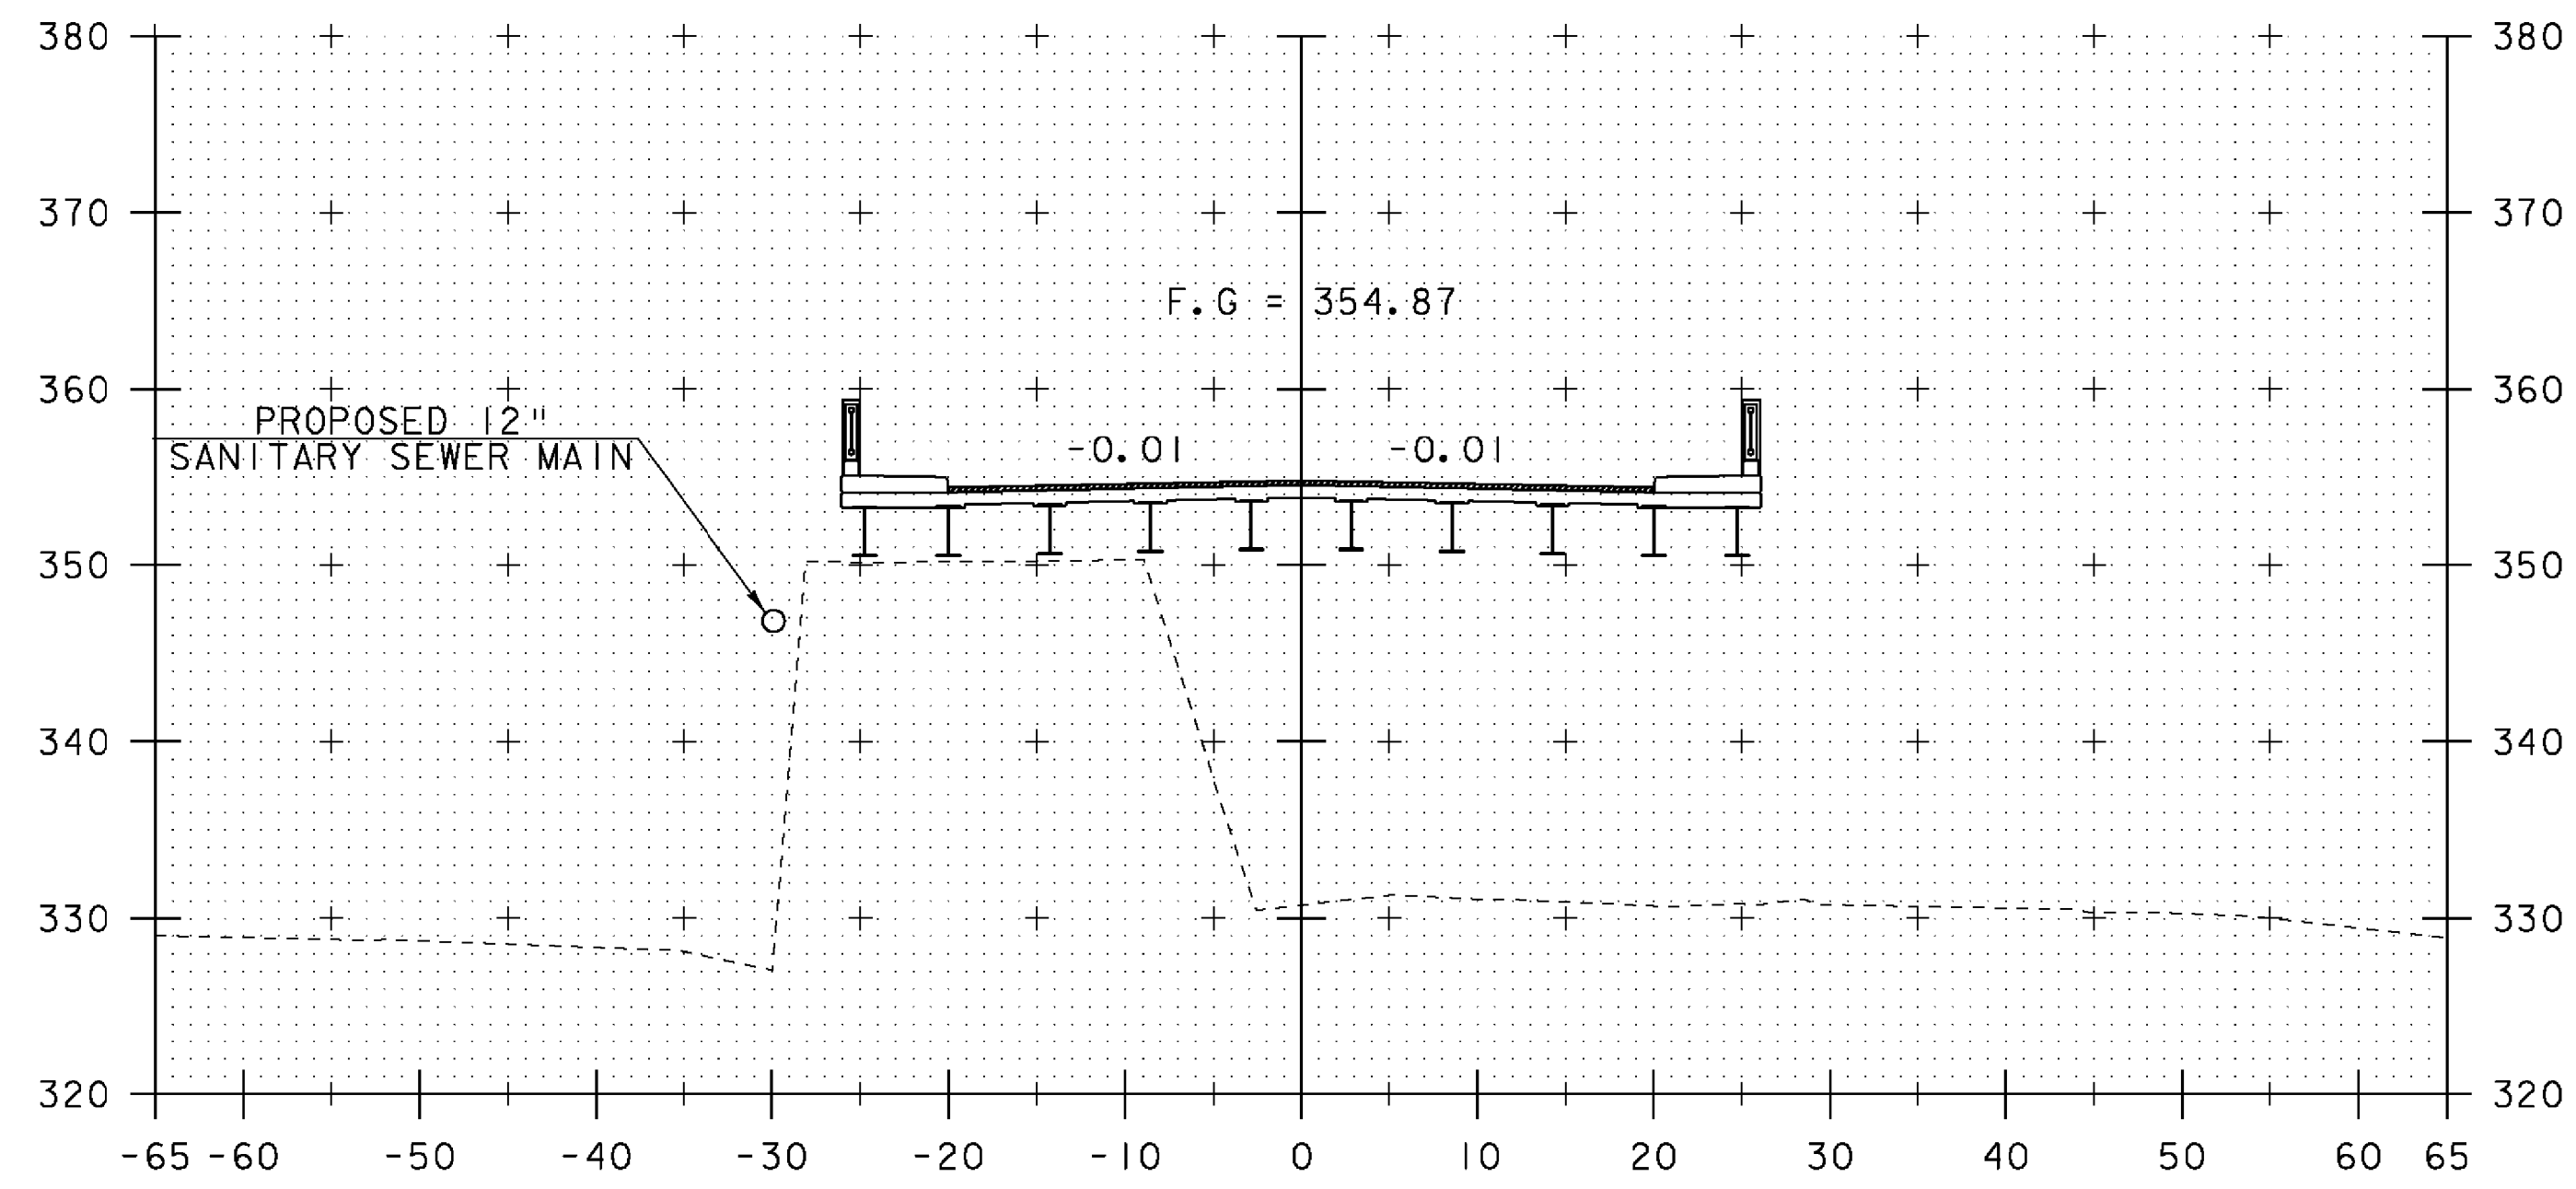

258+75

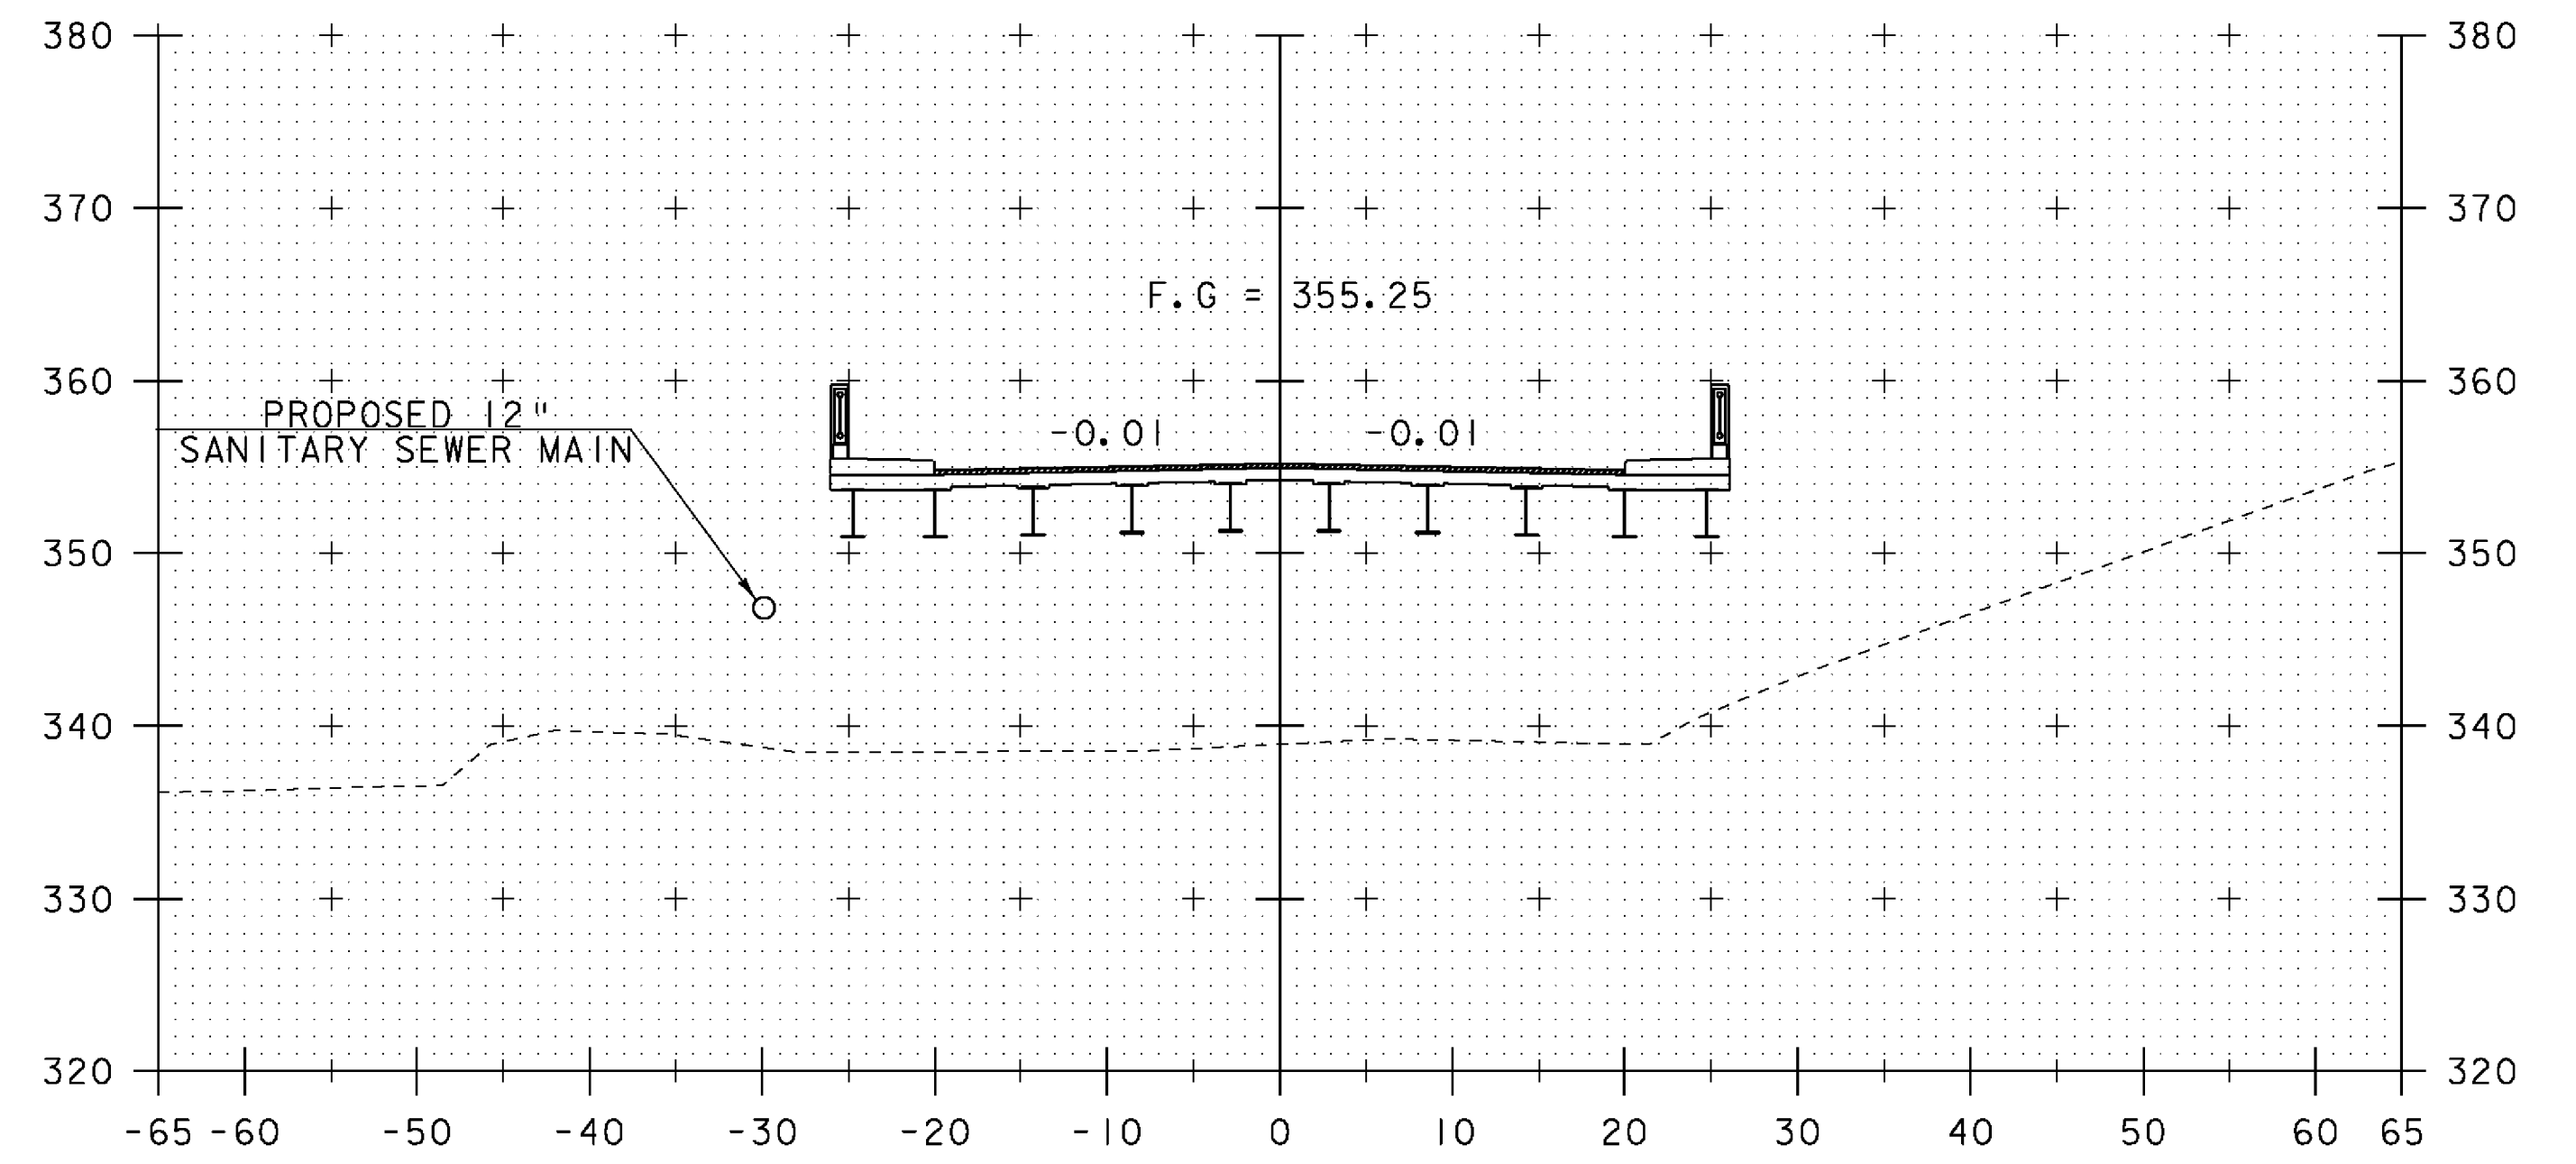

259+25

REV.	BY	DATE	REVISION
3	LBB	5/26/09	REVISED FINISH GRADE AND BANKING

PROJECT NAME:	SPRINGFIELD	PLOT DATE:	29-MAY-2009
PROJECT NUMBER:	BHF 016-2(14)	DRAWN BY:	D. PETERSON
FILE NAME:	06J004/str/s06j004xsl.dgn	CHECKED BY:	C. CARLSON
PROJECT LEADER:	R. WHITCOMB	SHEET	48 OF 72
DESIGNED BY:	D. PETERSON		

STA. 258+75 TO STA. 259+51.25