




260+00

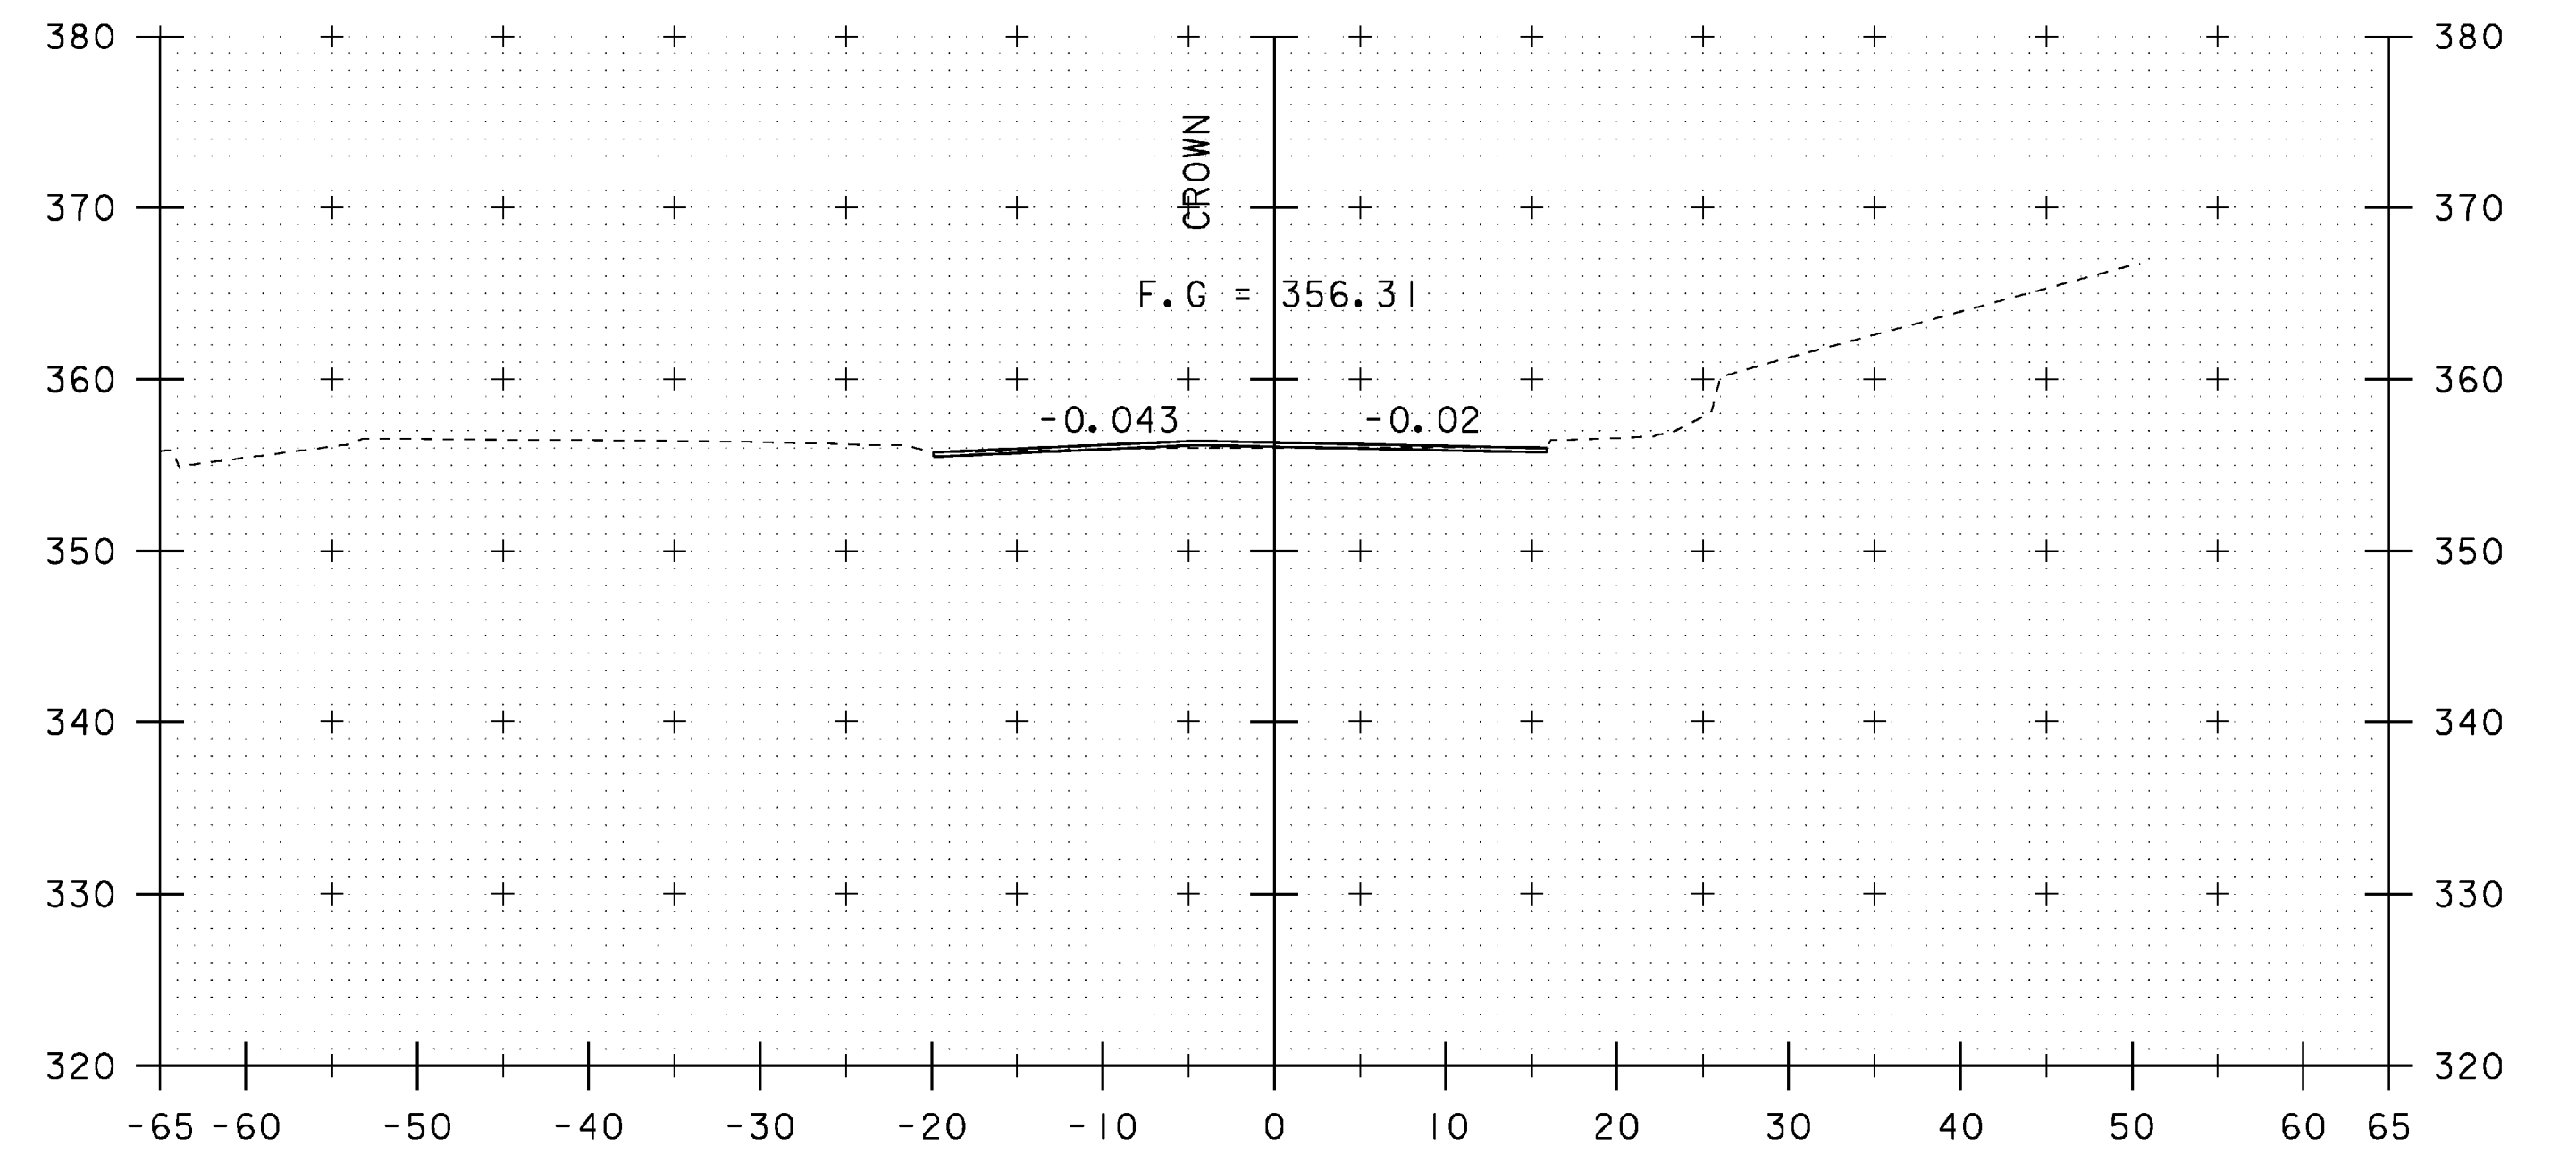

260+50

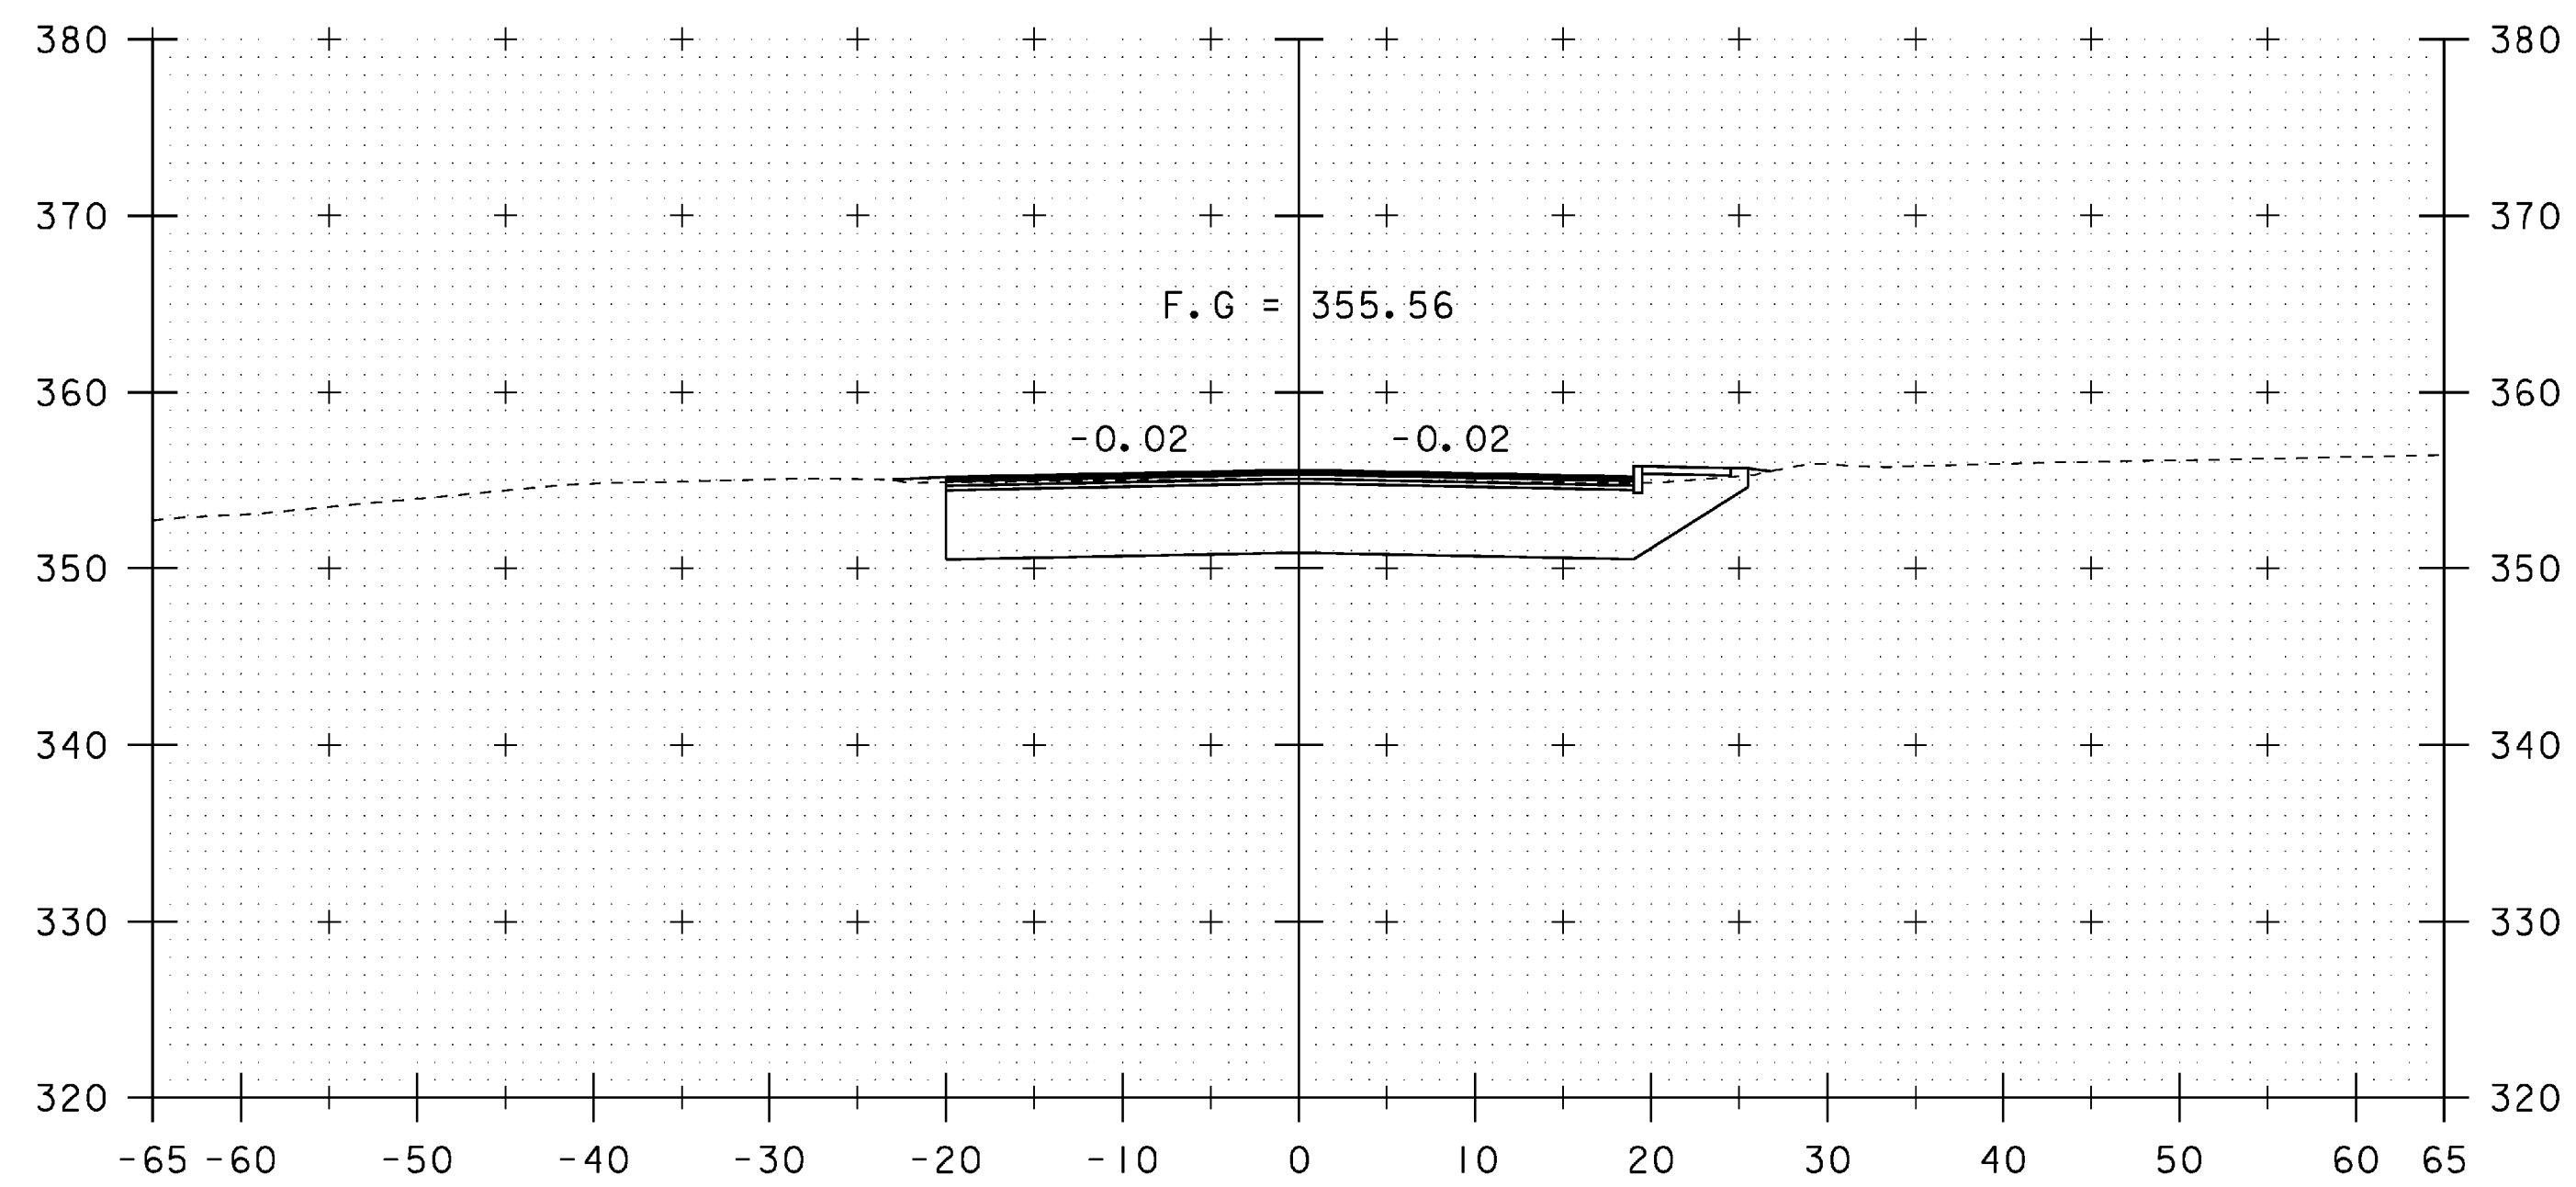

259+75

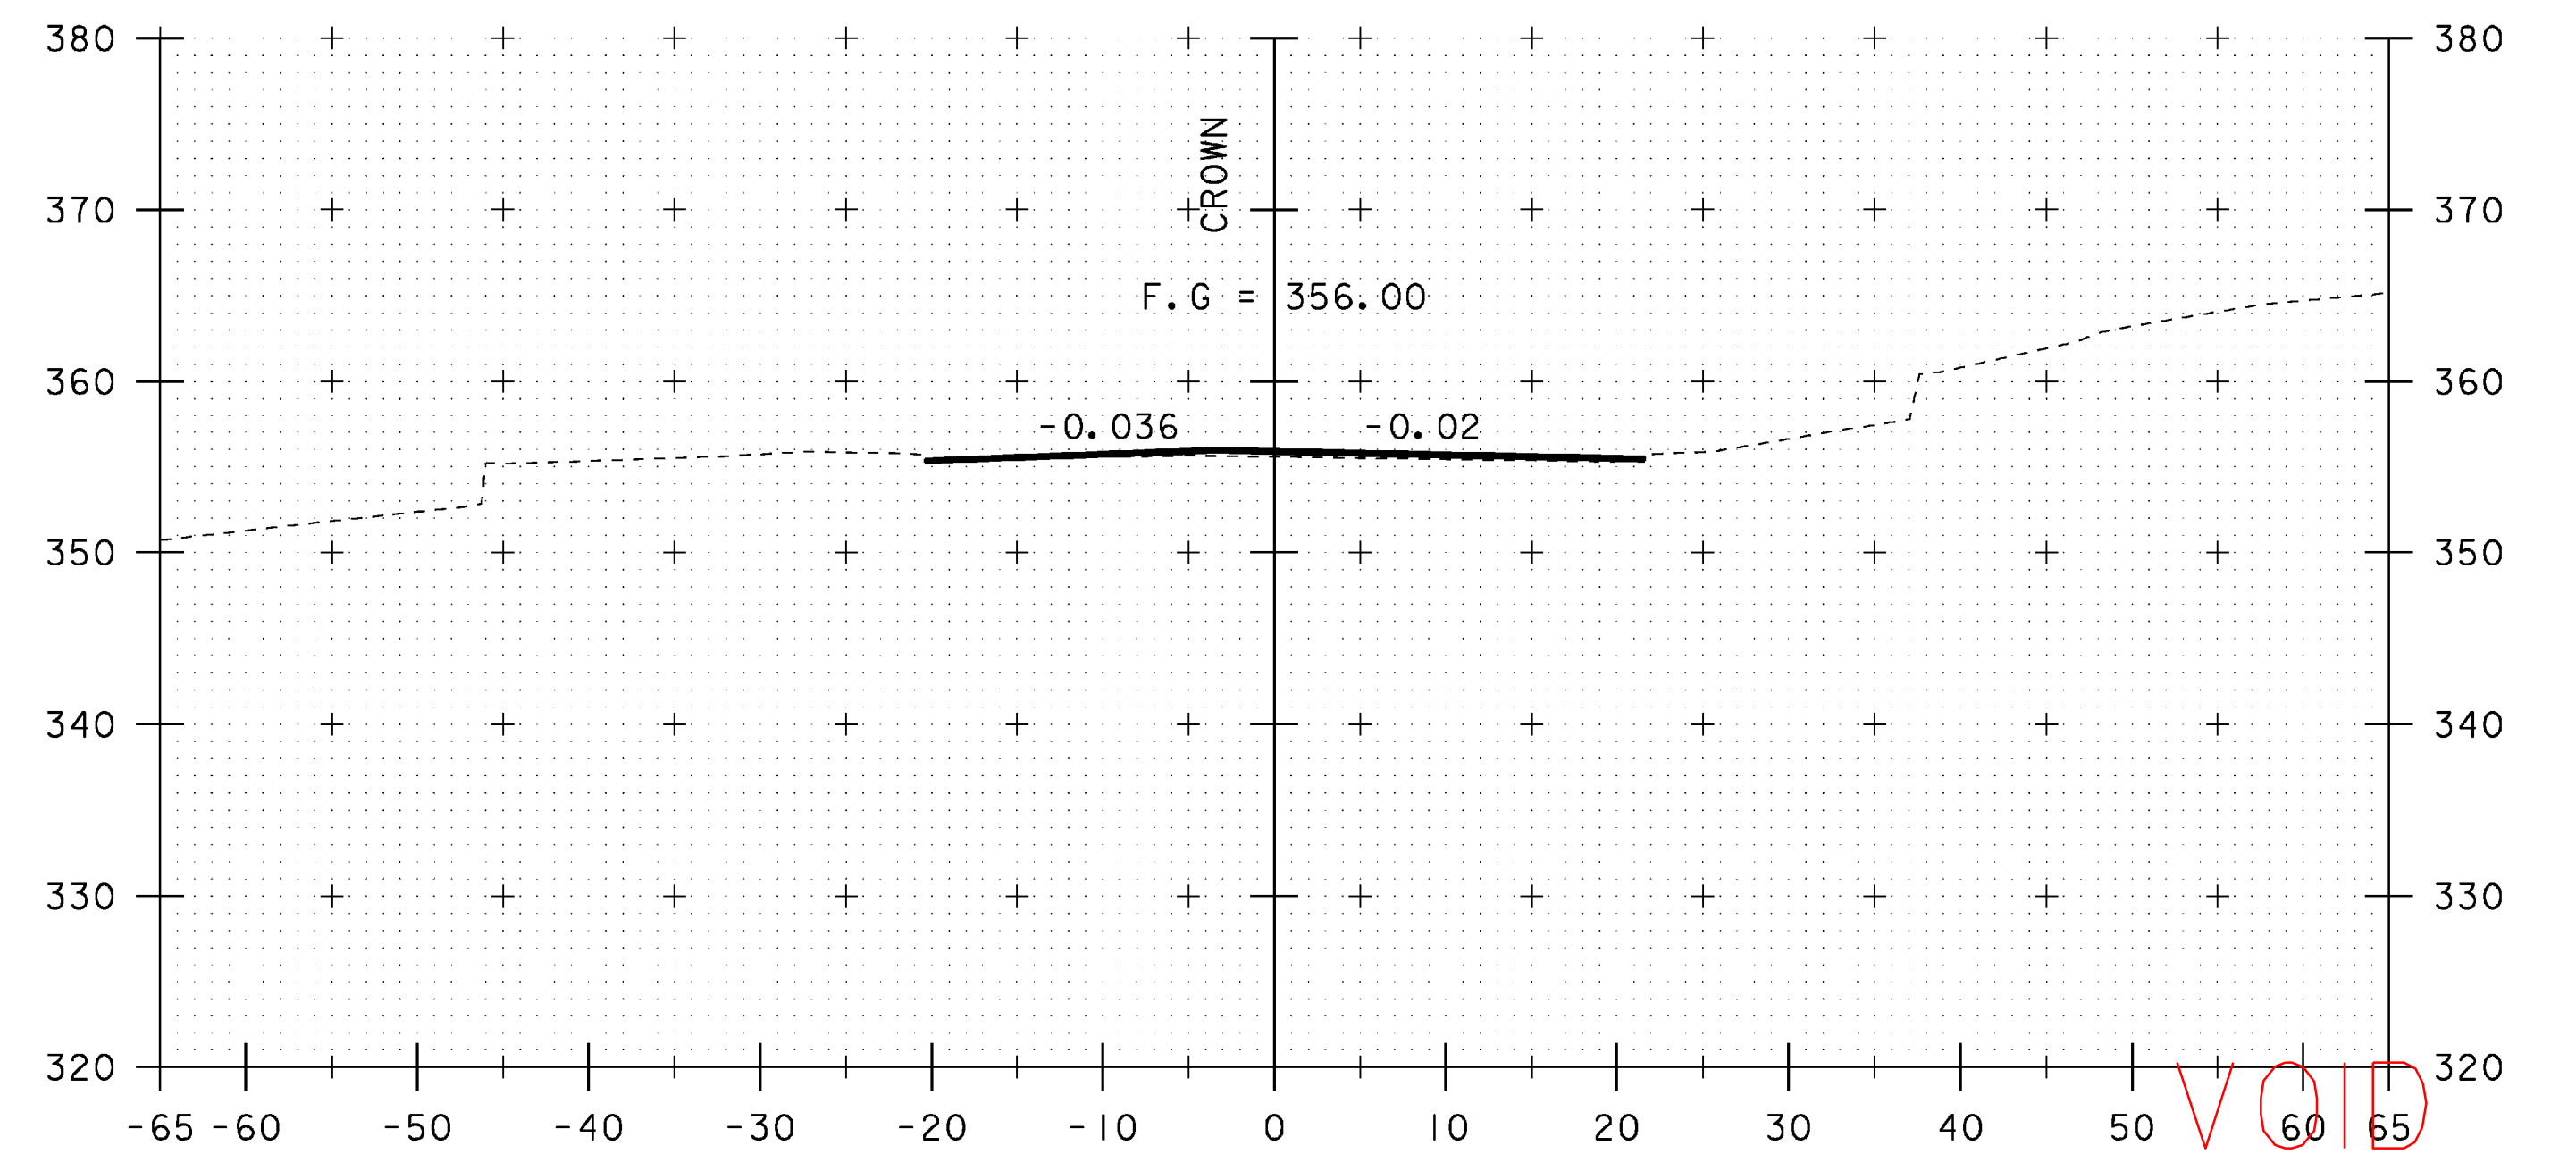

260+25

VOID
SEE REVISED
SHEET

STA. 259+75 TO STA. 260+50

| | | | | | |
|-----------------|---------------|-----------------------------|---------------------------|-------------|-------------|
| PROJECT NAME: | SPRINGFIELD | FILE NAME: | 06J004/str/s06J004xsl.dgn | PLOT DATE: | 04-MAR-2009 |
| PROJECT NUMBER: | BHF 016-2(14) | PROJECT LEADER: | R. WHITCOMB | DRAWN BY: | D. PETERSON |
| | | DESIGNED BY: | D. PETERSON | CHECKED BY: | C. CARLSON |
| | | MAINLINE CROSS SECTIONS (5) | | SHEET | 49 OF 72 |