




260+00

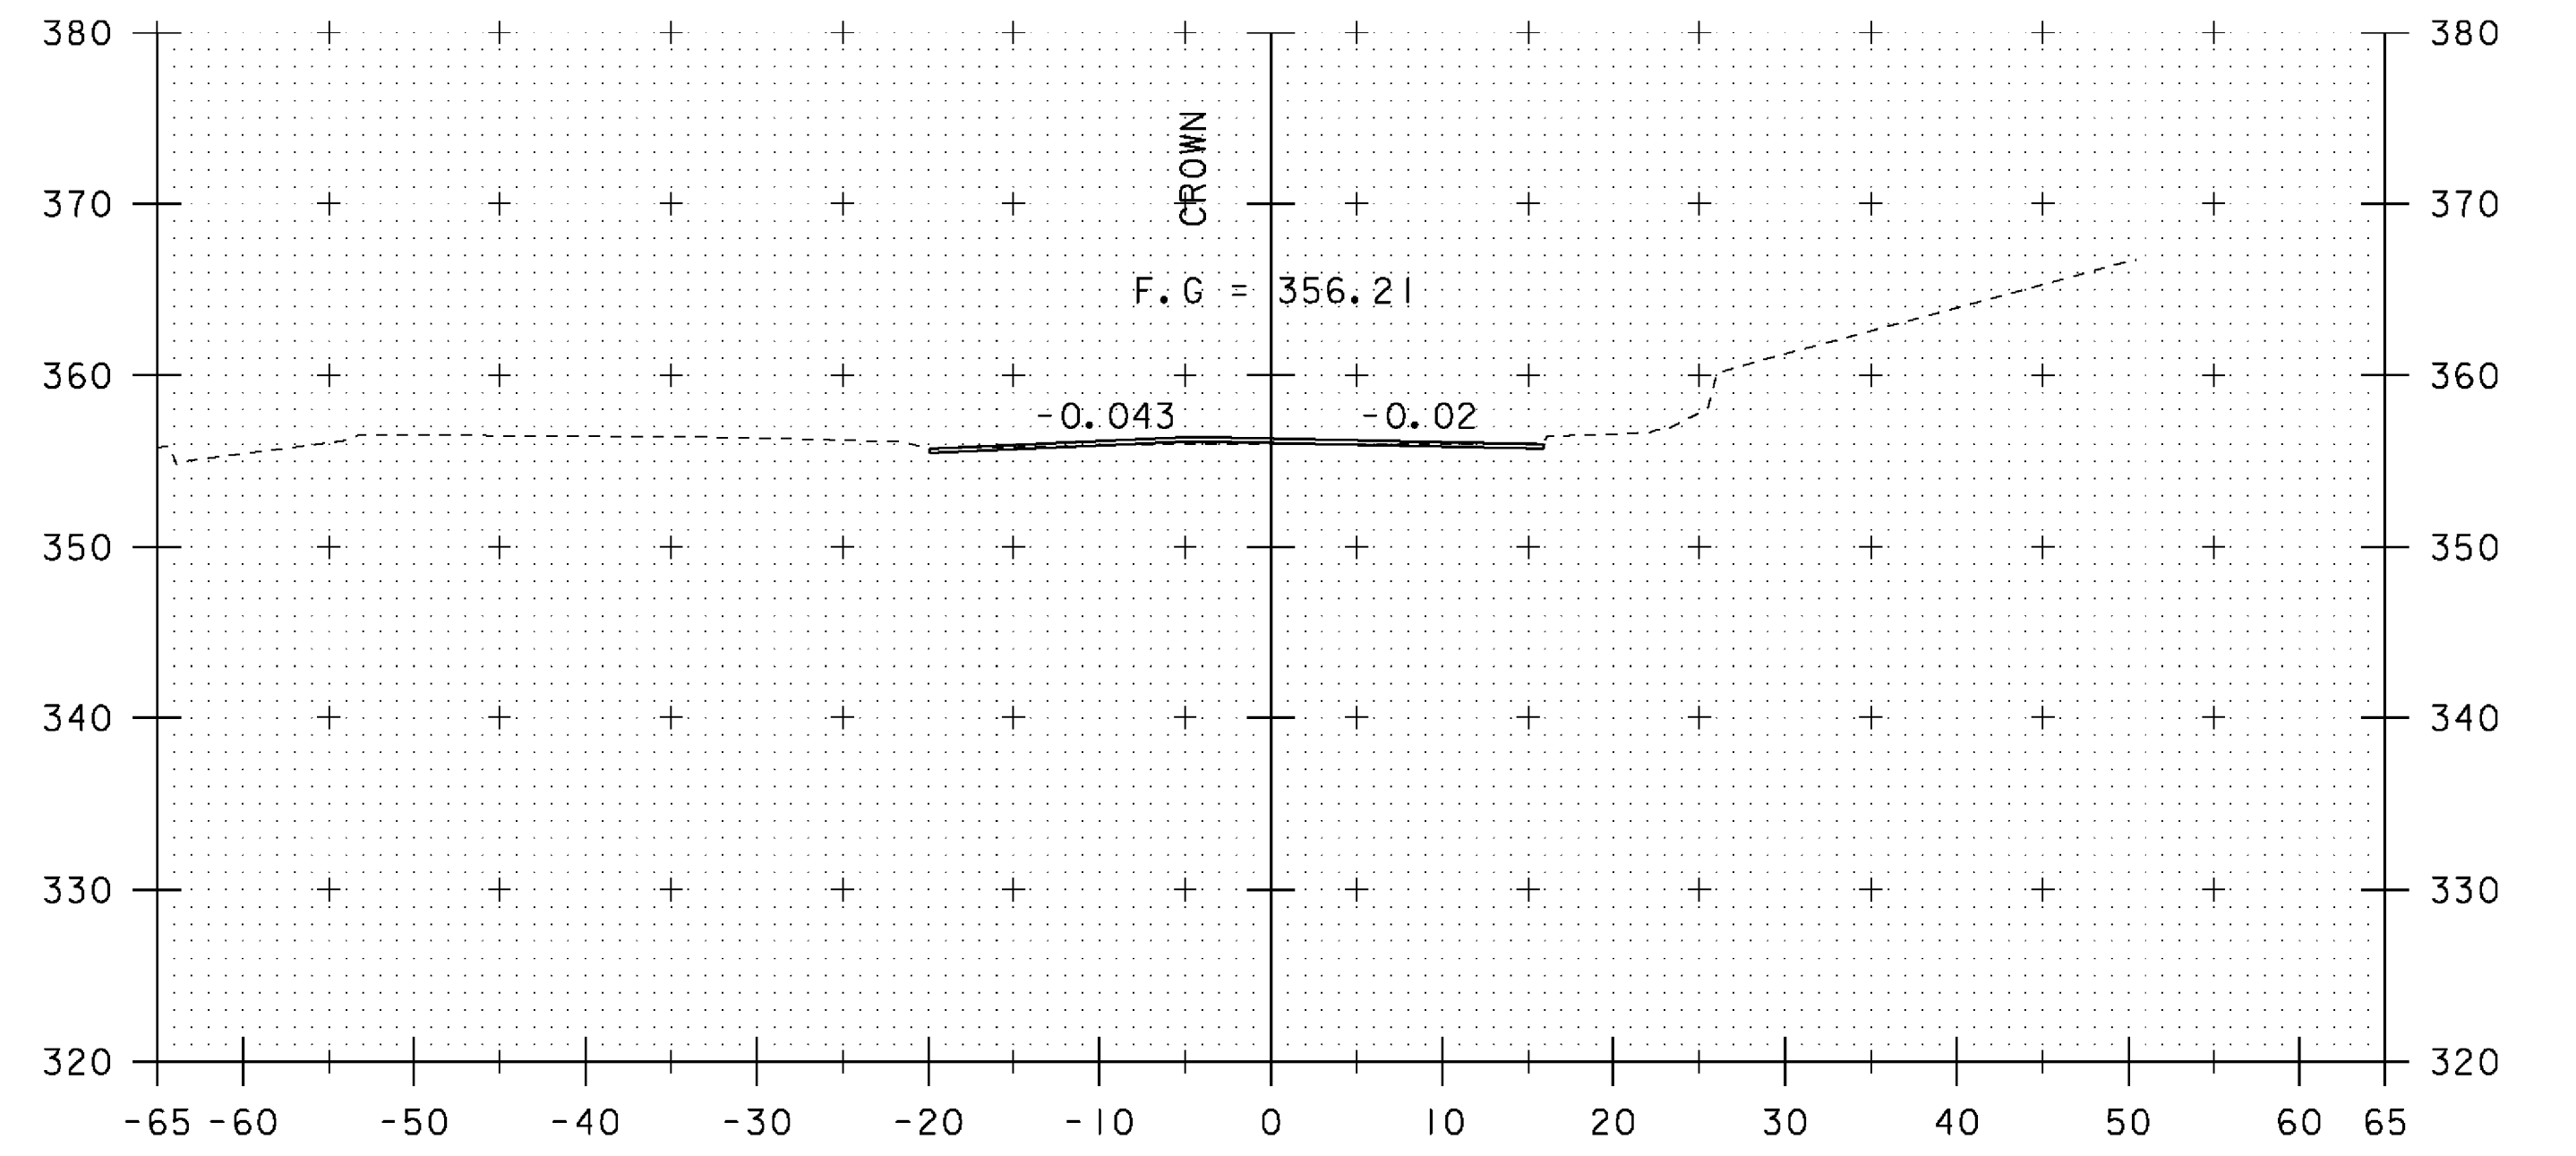

260+50

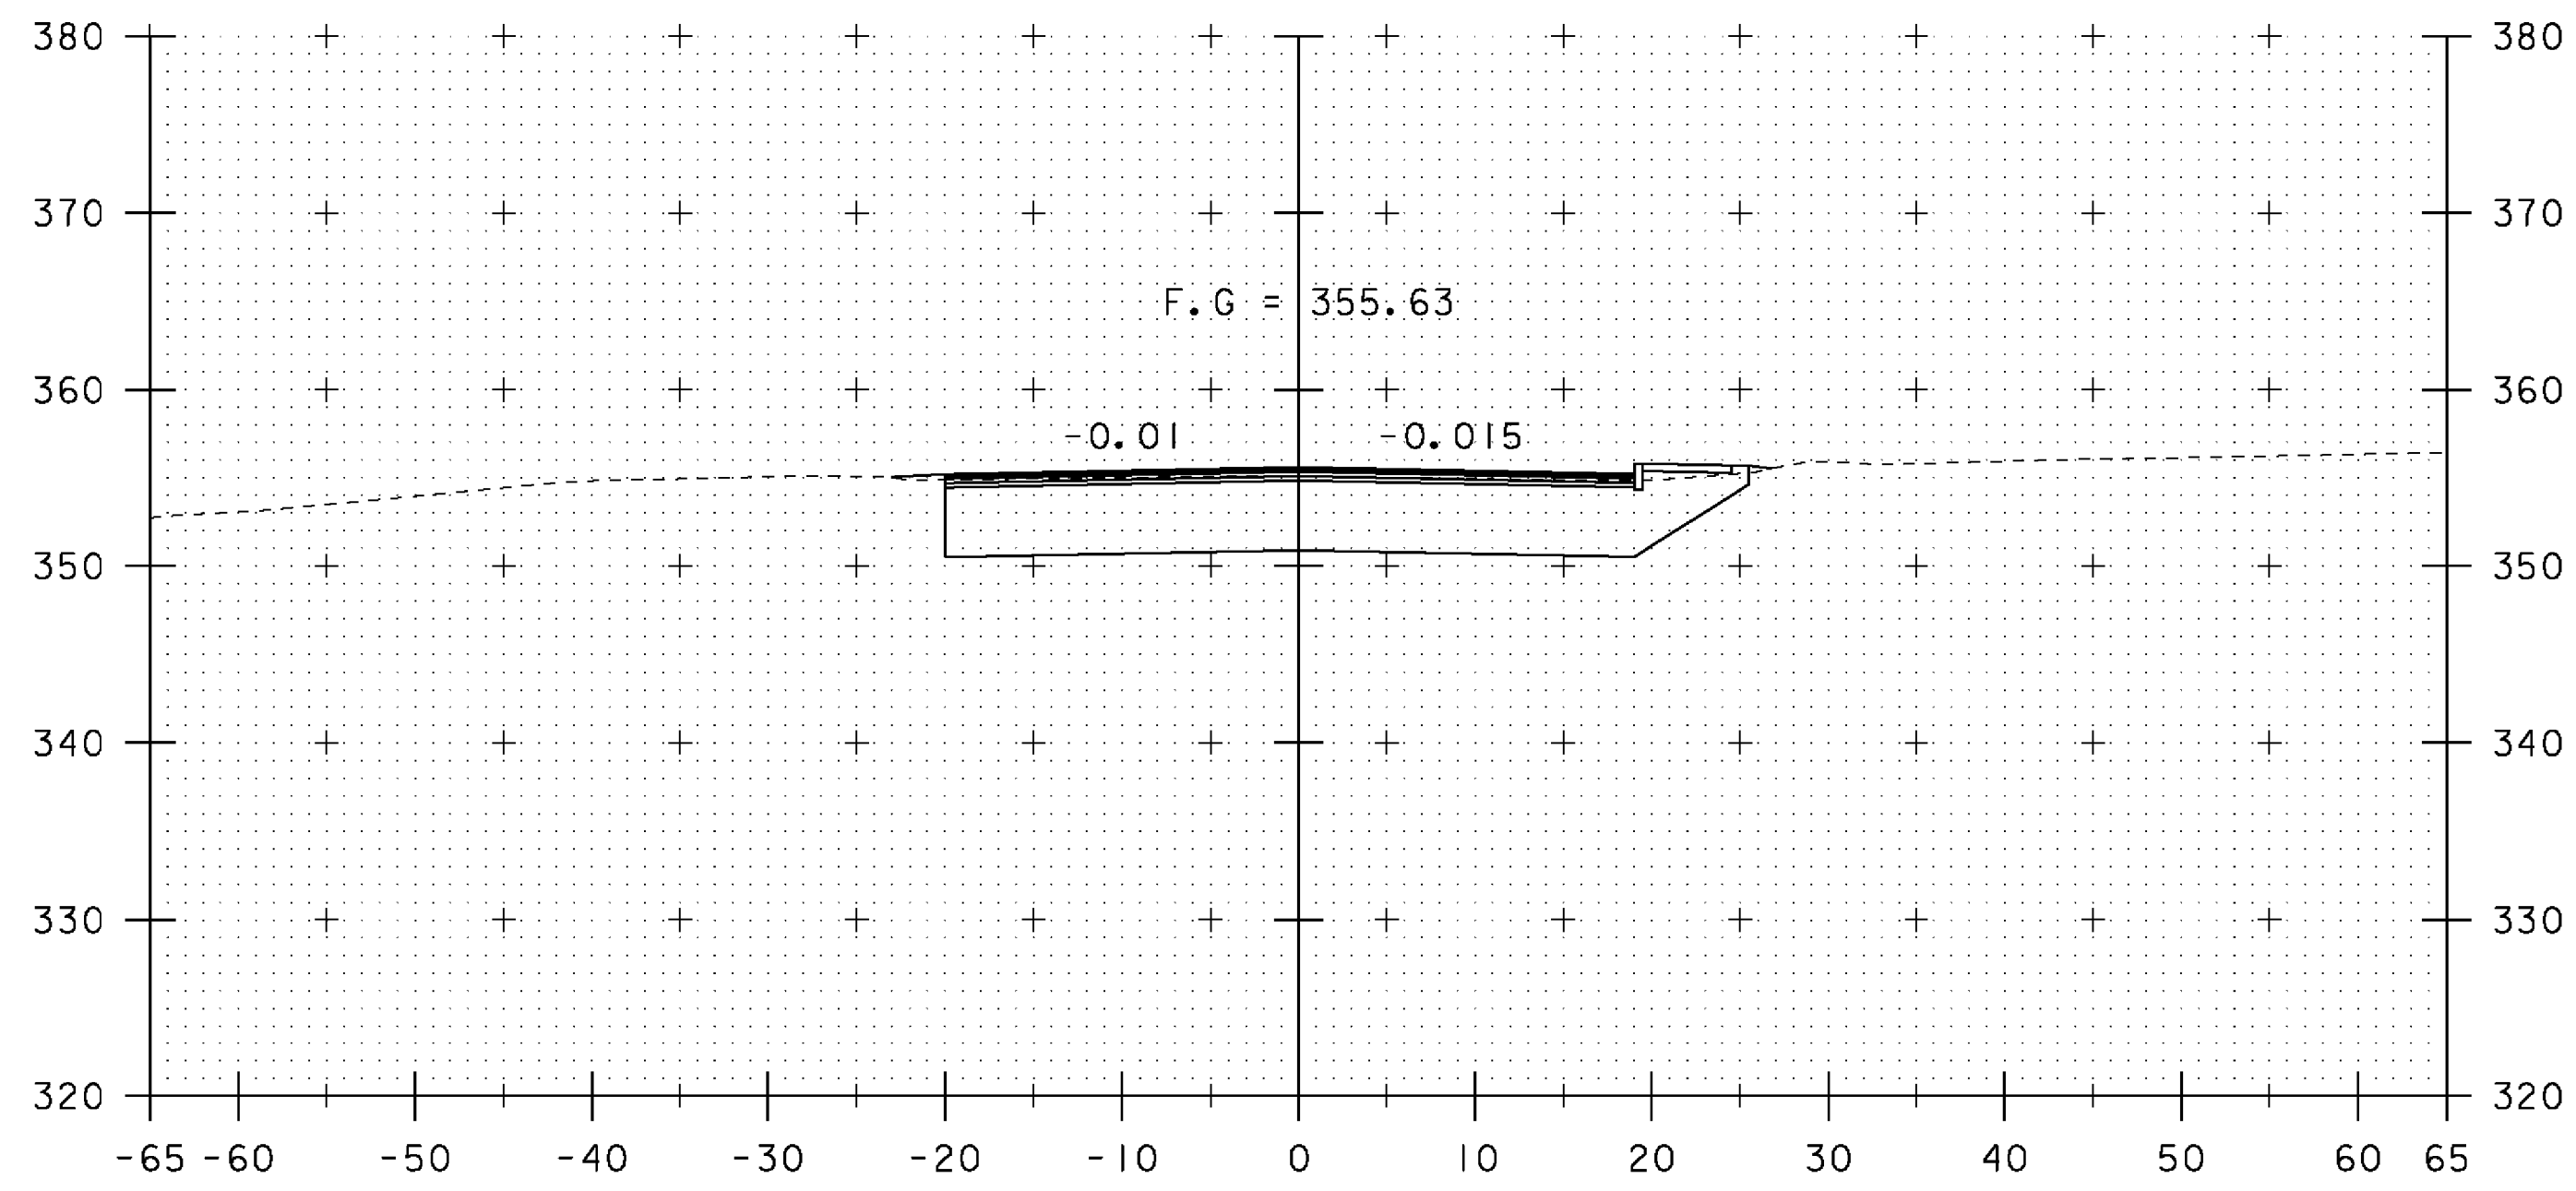

259+75

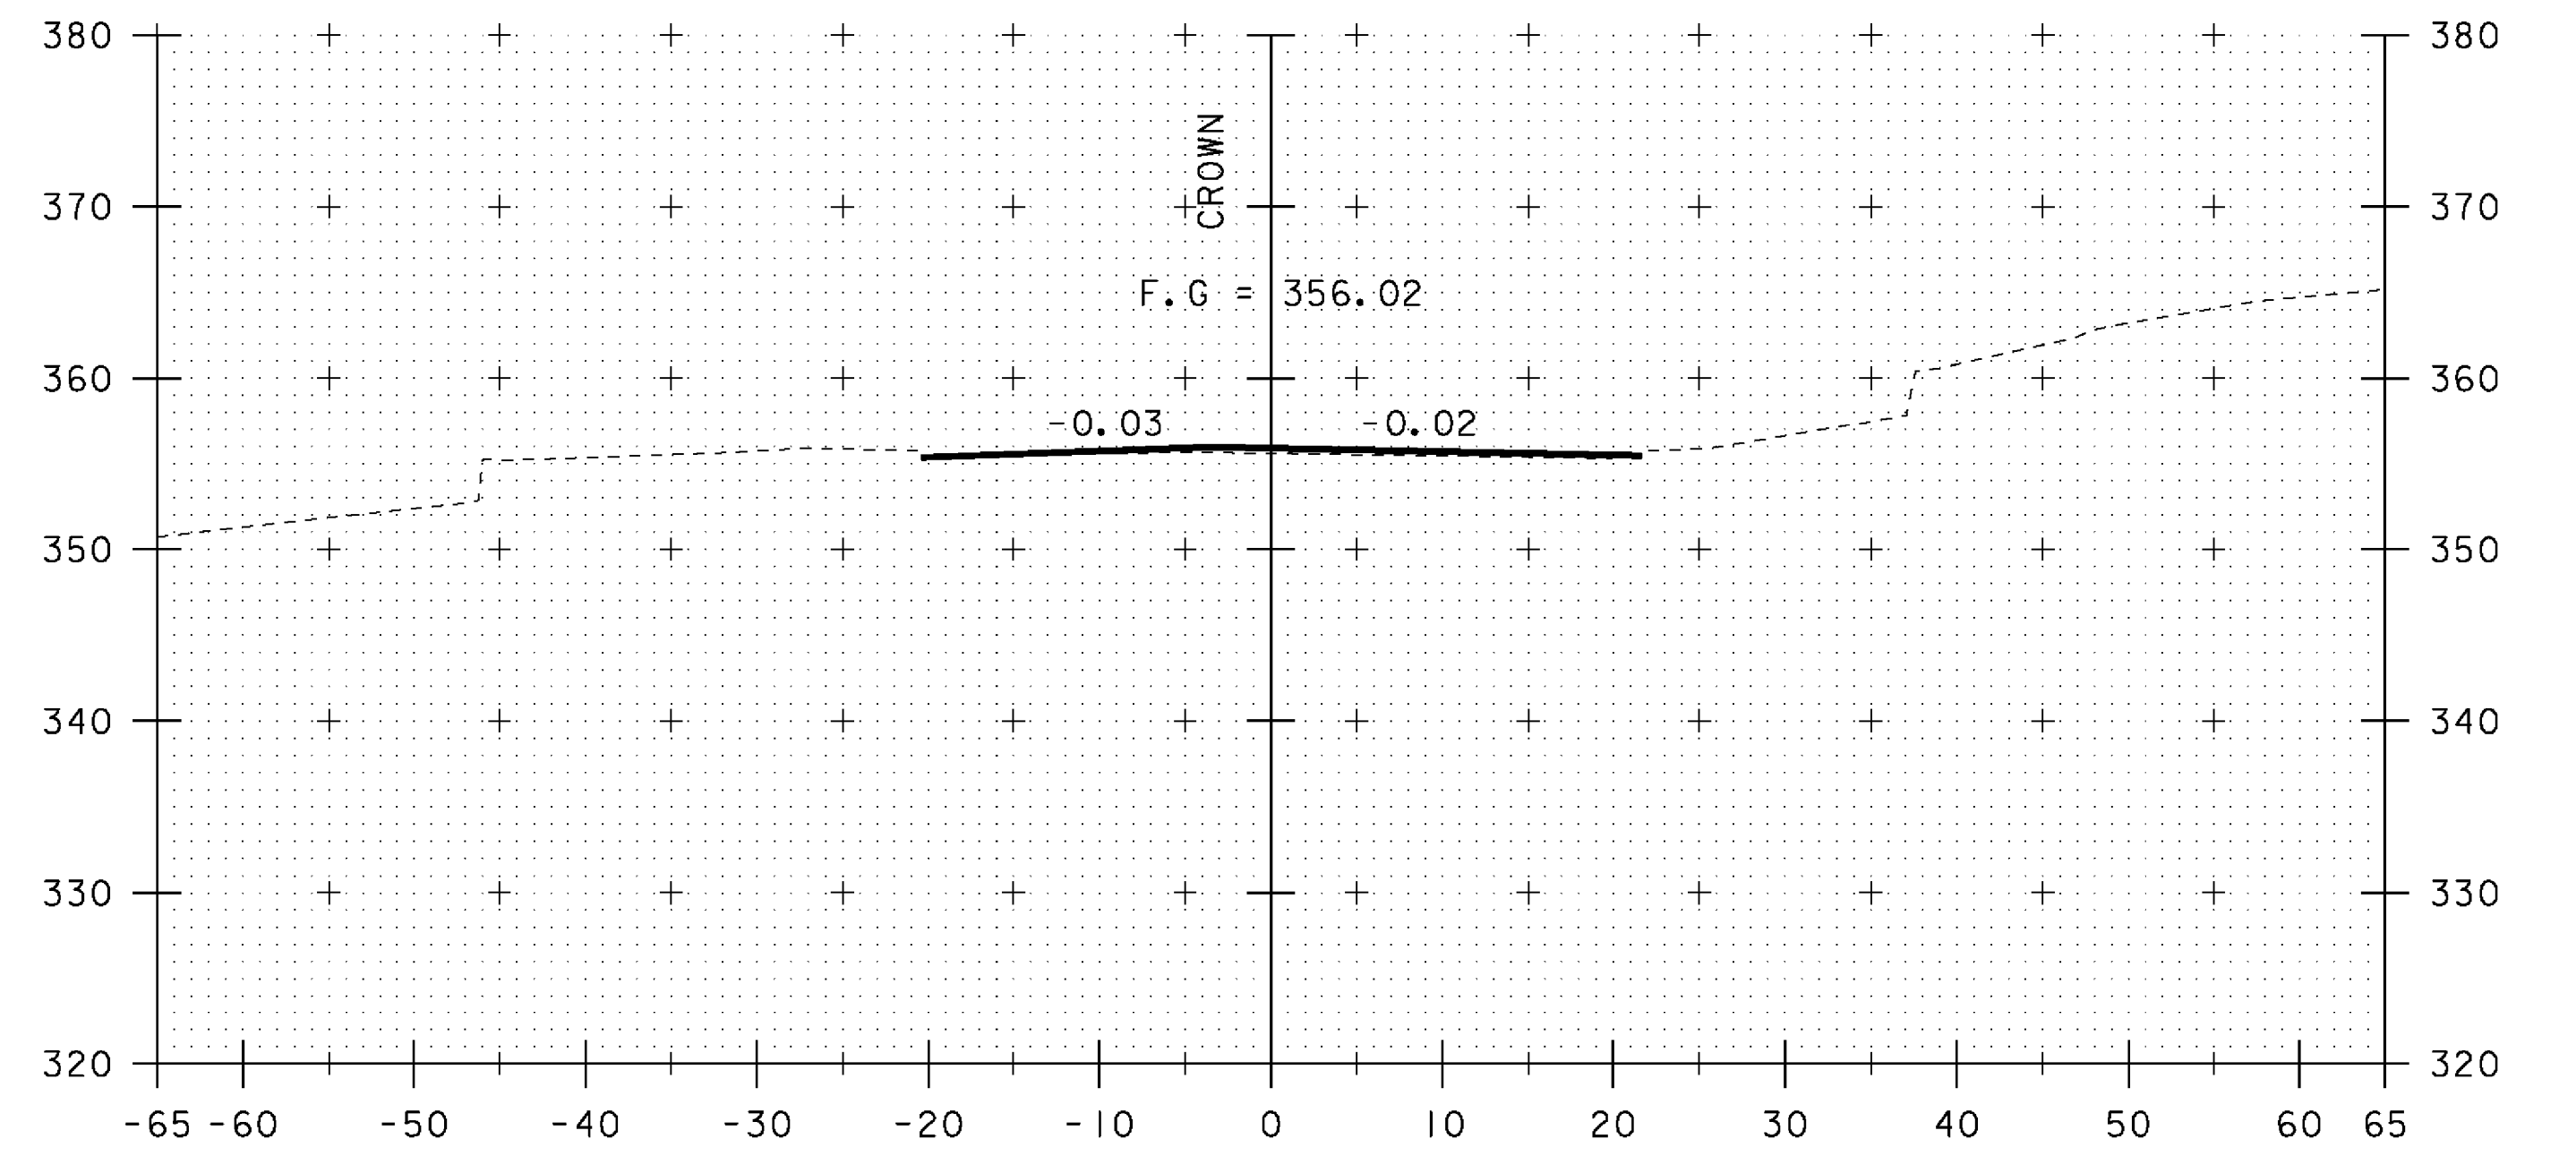

260+25

REV.	BY	DATE	REVISION
3	LBB	5/26/09	REVISED FINISH GRADE AND BANKING

PROJECT NAME: SPRINGFIELD
PROJECT NUMBER: BHF 016-2(14)

FILE NAME: 06J004/str/s06j004xsl.dgn PLOT DATE: 29-MAY-2009
PROJECT LEADER: R. WHITCOMB DRAWN BY: D. PETERSON
DESIGNED BY: D. PETERSON CHECKED BY: C. CARLSON
MAINLINE CROSS SECTIONS (5) SHEET 49 OF 72

STA. 259+75 TO STA. 260+50