



261+00

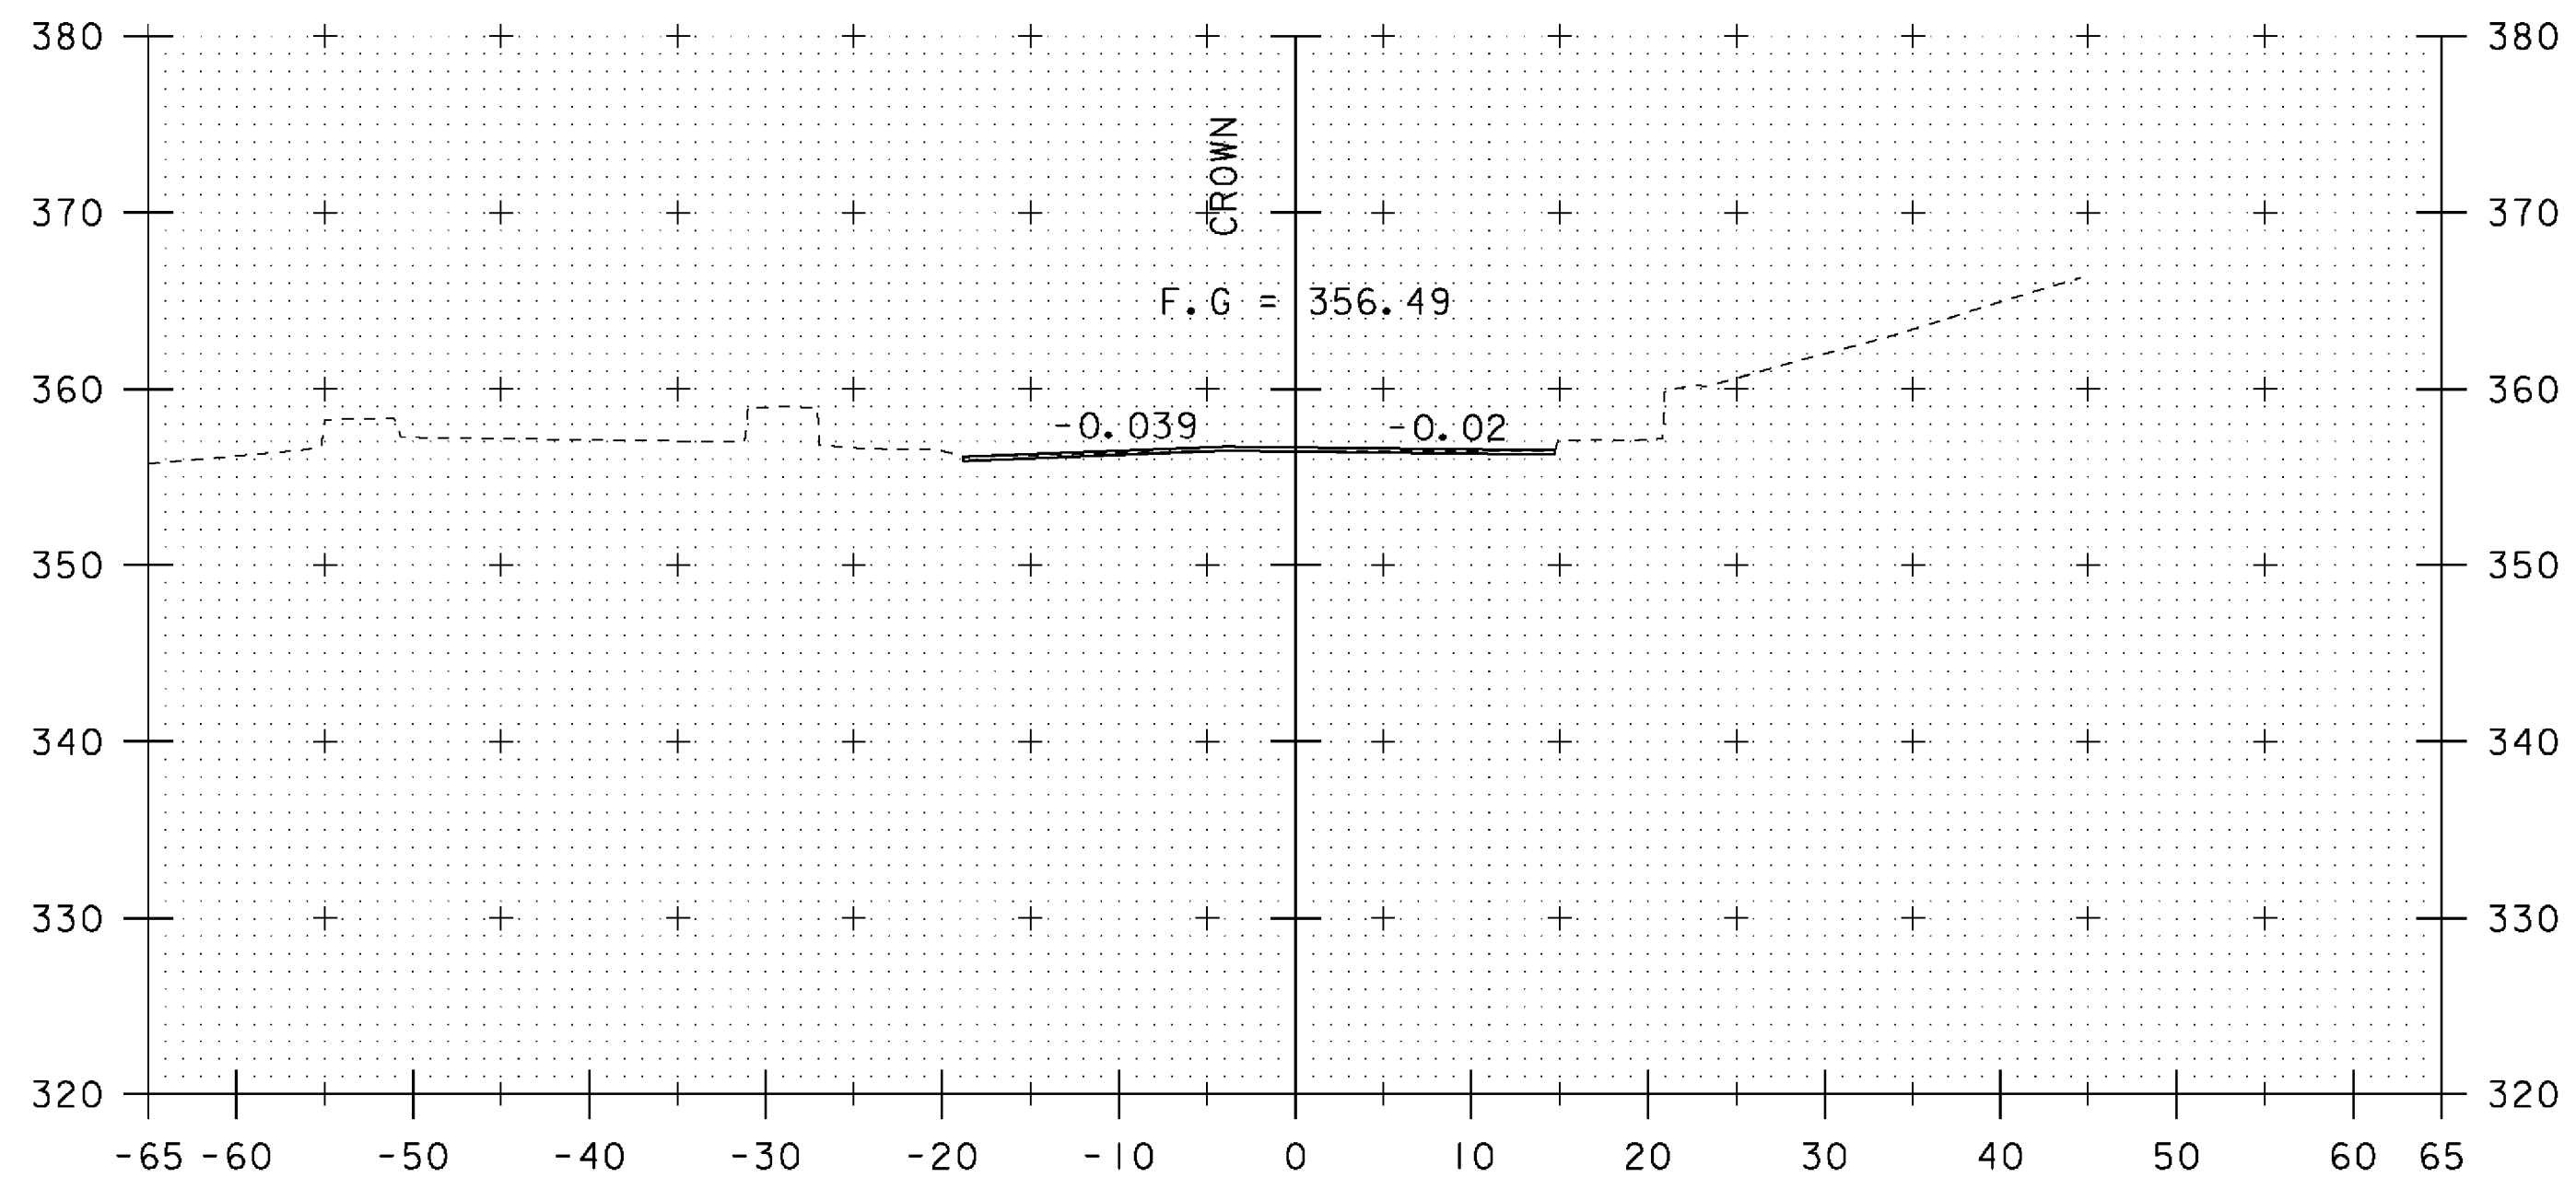

260+75

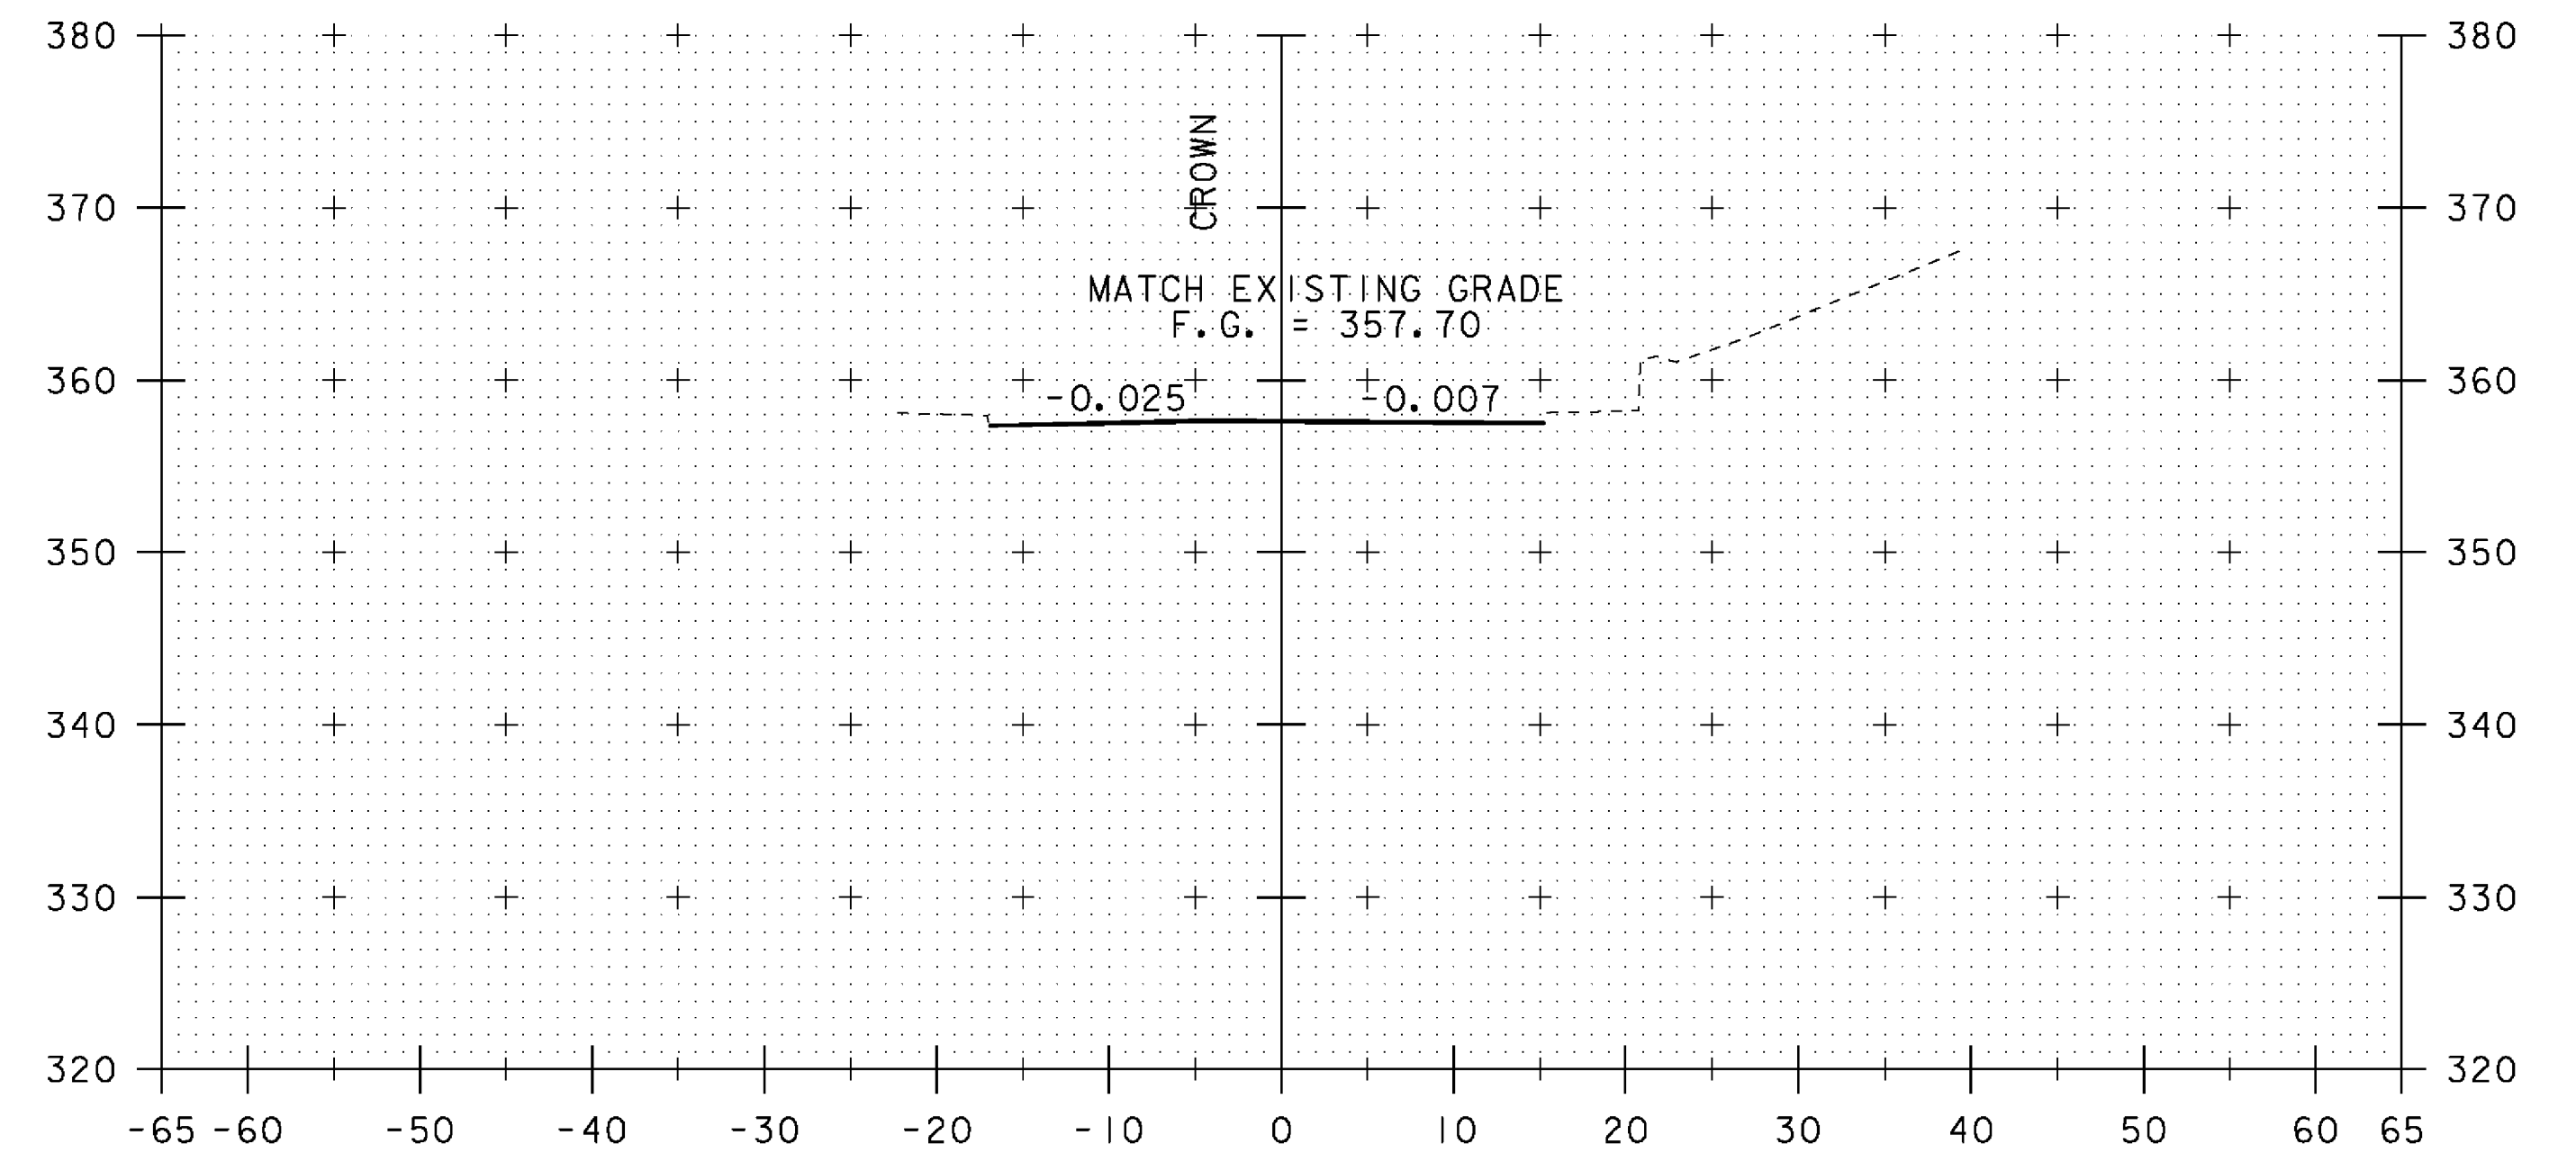

ML STA 261+25  
END APPROACH

261+25

REV.	BY	DATE	REVISION
△	LBB	5/26/09	REVISED FINISH GRADE AND BANKING

STA. 260+75 TO STA. 261+25

PROJECT NAME: SPRINGFIELD	PLOT DATE: 29-MAY-2009
PROJECT NUMBER: BHF 016-2(14)	DRAWN BY: D. PETERSON
FILE NAME: 06J004/str/s06j004xsl.dgn	CHECKED BY: C. CARLSON
PROJECT LEADER: R. WHITCOMB	SHEET 50 OF 72
DESIGNED BY: D. PETERSON	
MAINLINE CROSS SECTIONS (6)	