


4+90

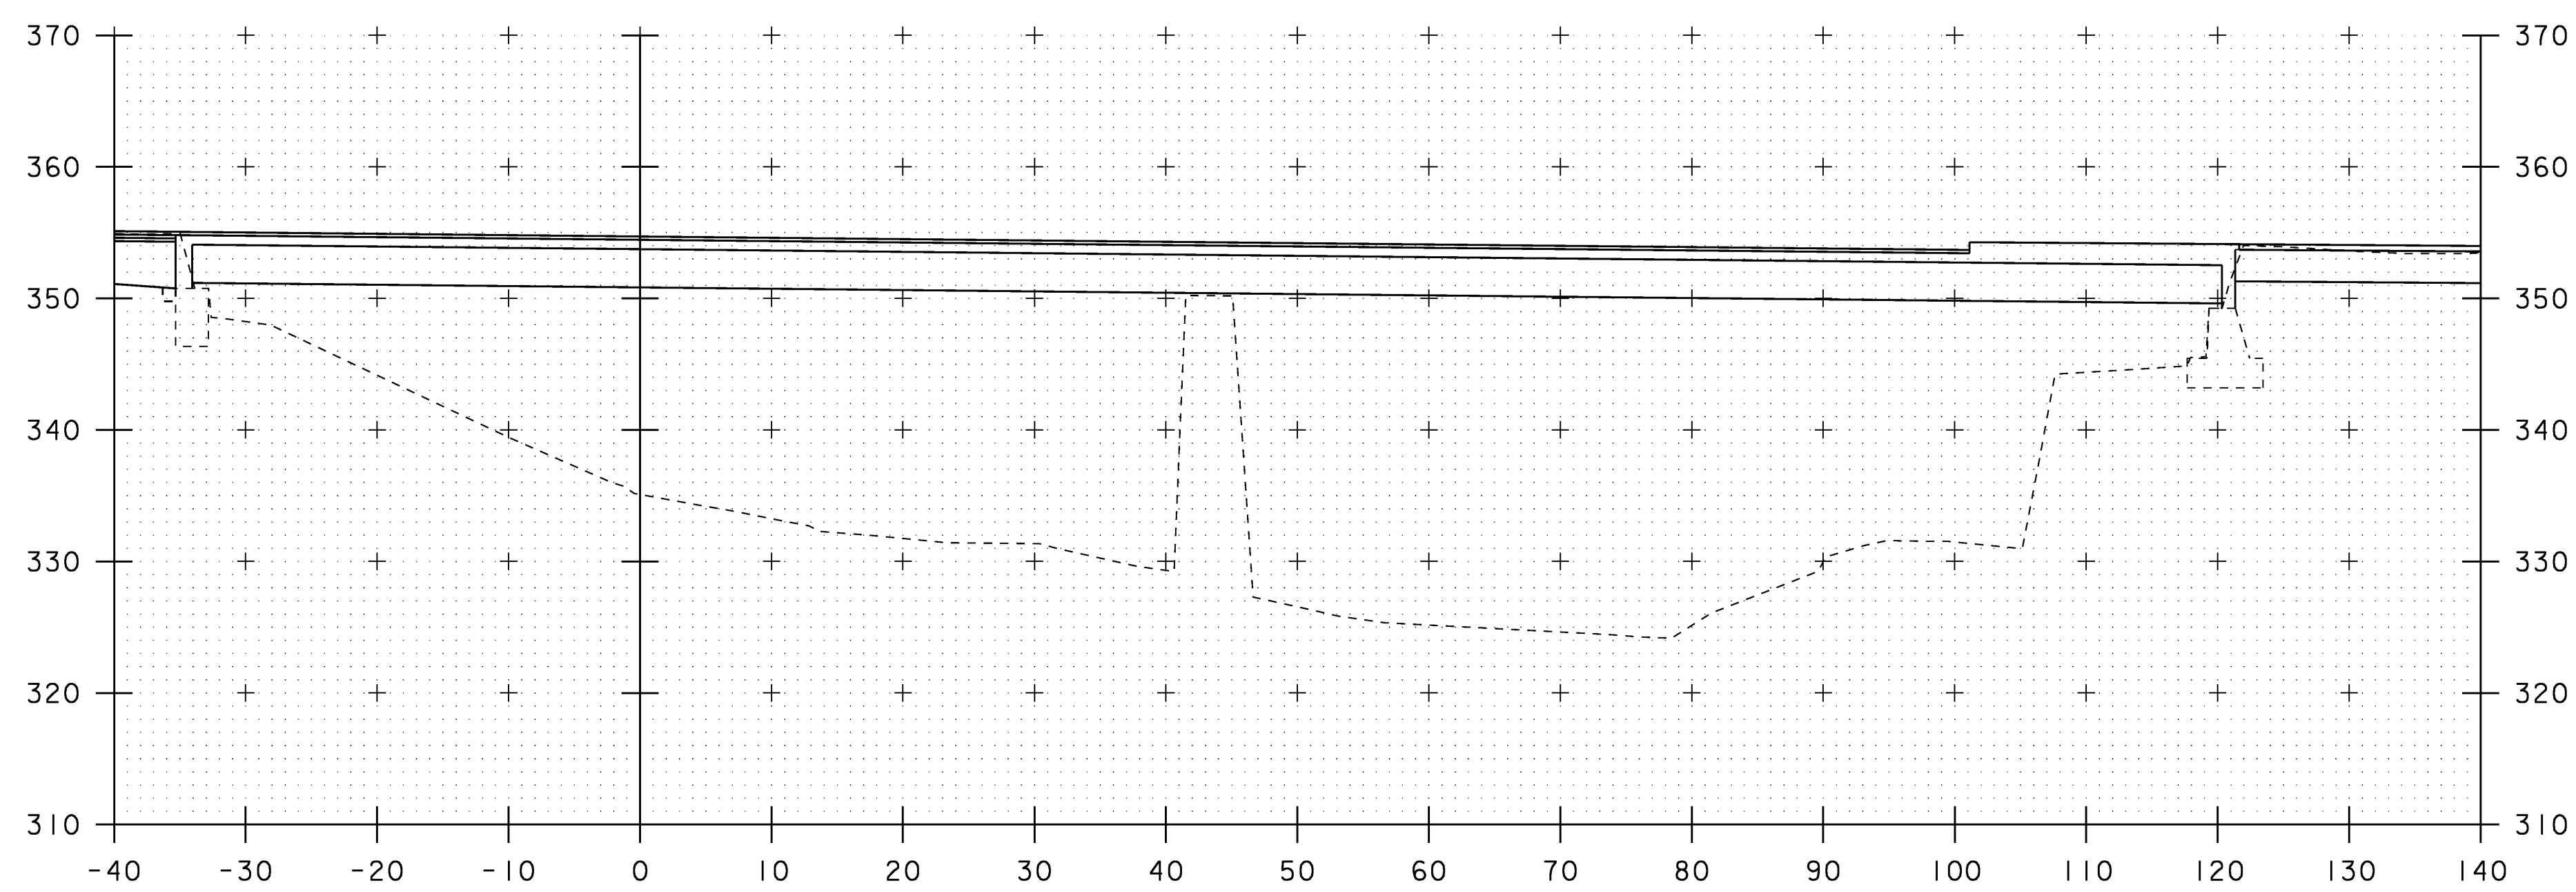

4+80

STA. 4+80 TO STA. 4+90

PROJECT NAME:	SPRINGFIELD	PLOT DATE:	04-MAR-2009
PROJECT NUMBER:	BHF 016-2(14)	DRAWN BY:	D. PETERSON
FILE NAME:	06J004/str/s06J004xsl.dgn	CHECKED BY:	C. CARLSON
PROJECT LEADER:	R. WHITCOMB	CHANNEL CROSS SECTIONS (3)	SHEET 53 OF 72
DESIGNED BY:	D. PETERSON		