


5+50

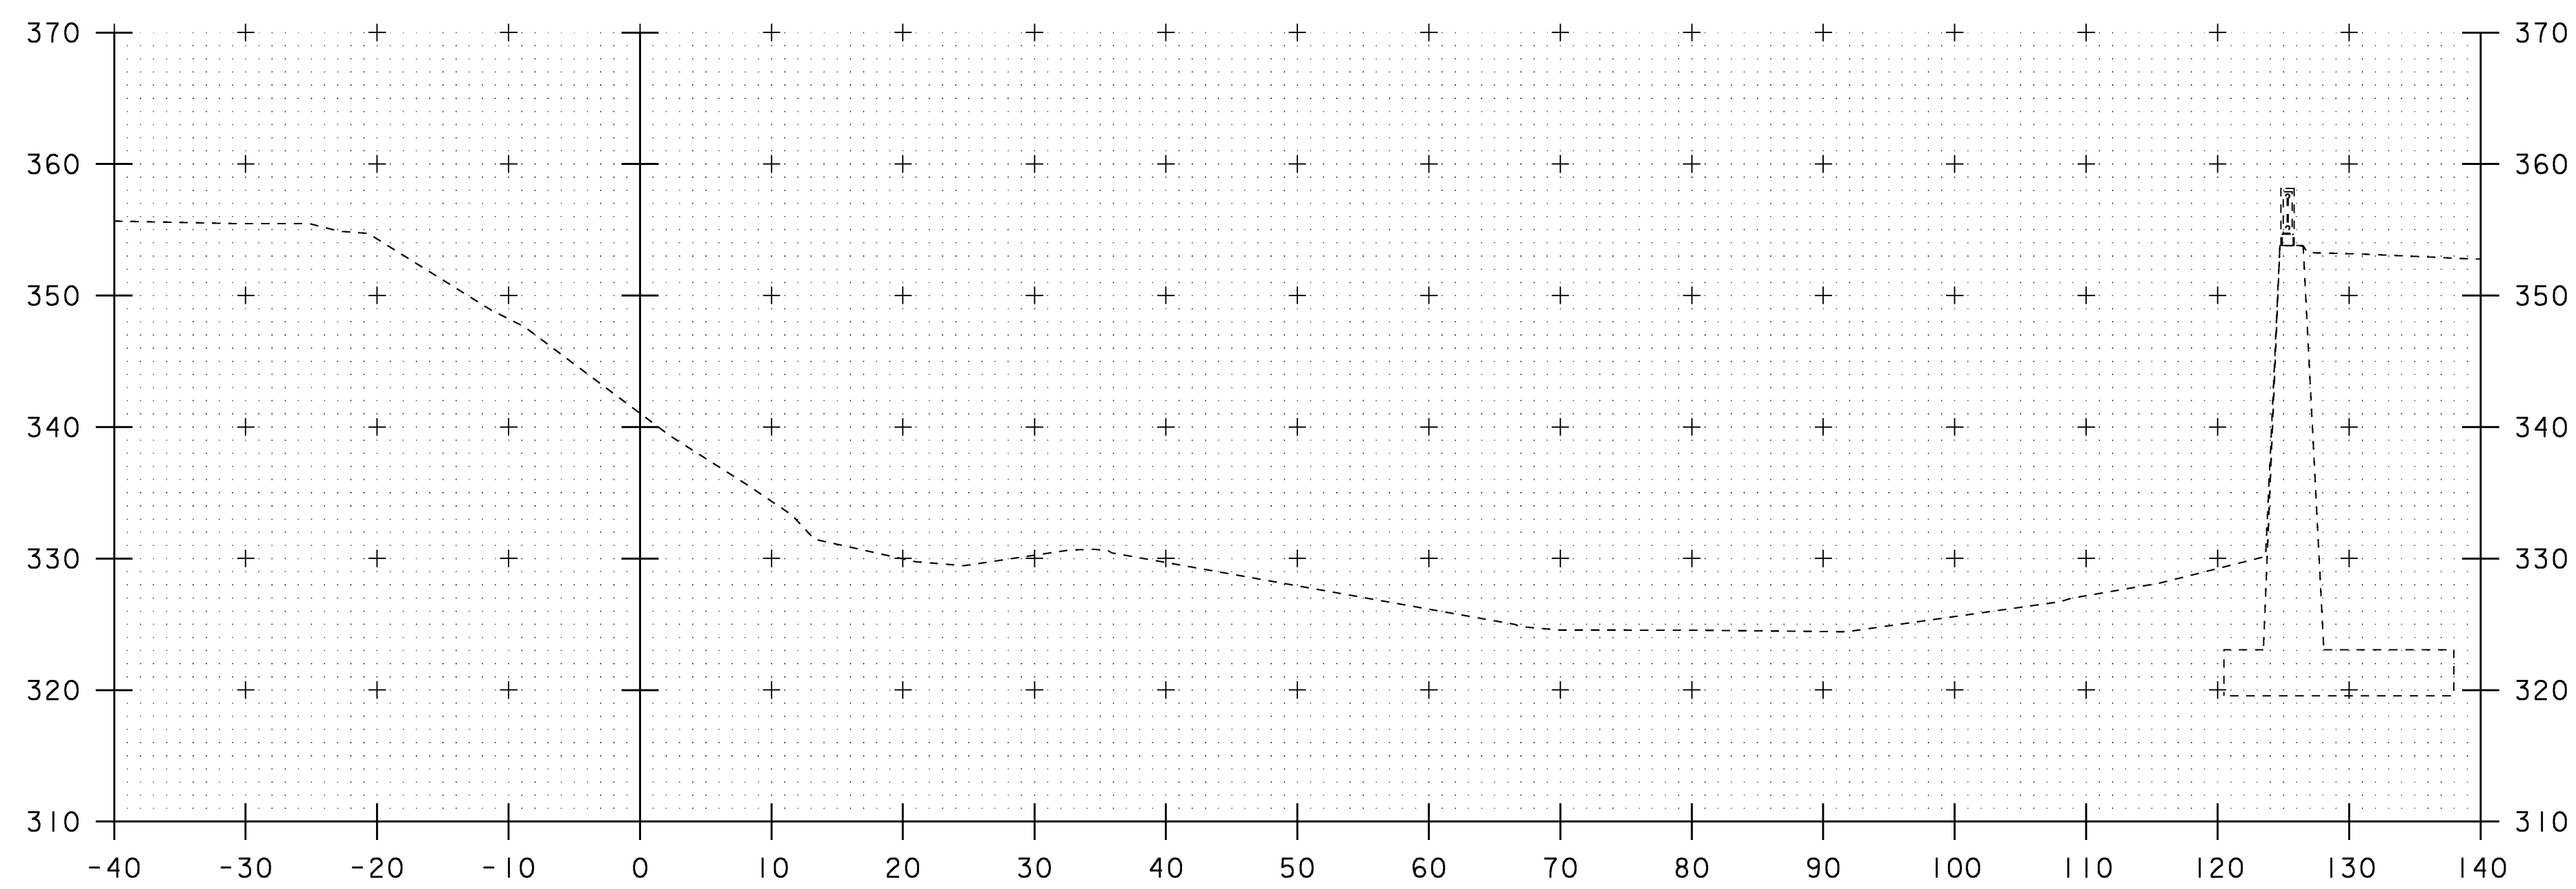

5+40

STA. 5+40 TO STA. 5+50

PROJECT NAME:	SPRINGFIELD	PLOT DATE:	04-MAR-2009
PROJECT NUMBER:	BHF 016-2(14)	DRAWN BY:	D. PETERSON
FILE NAME:	06J004/str/s06J004xsl.dgn	DESIGNED BY:	D. PETERSON
PROJECT LEADER:	R. WHITCOMB	CHECKED BY:	C. CARLSON
CHANNEL CROSS SECTIONS (6)		SHEET 56	OF 72