


5+70

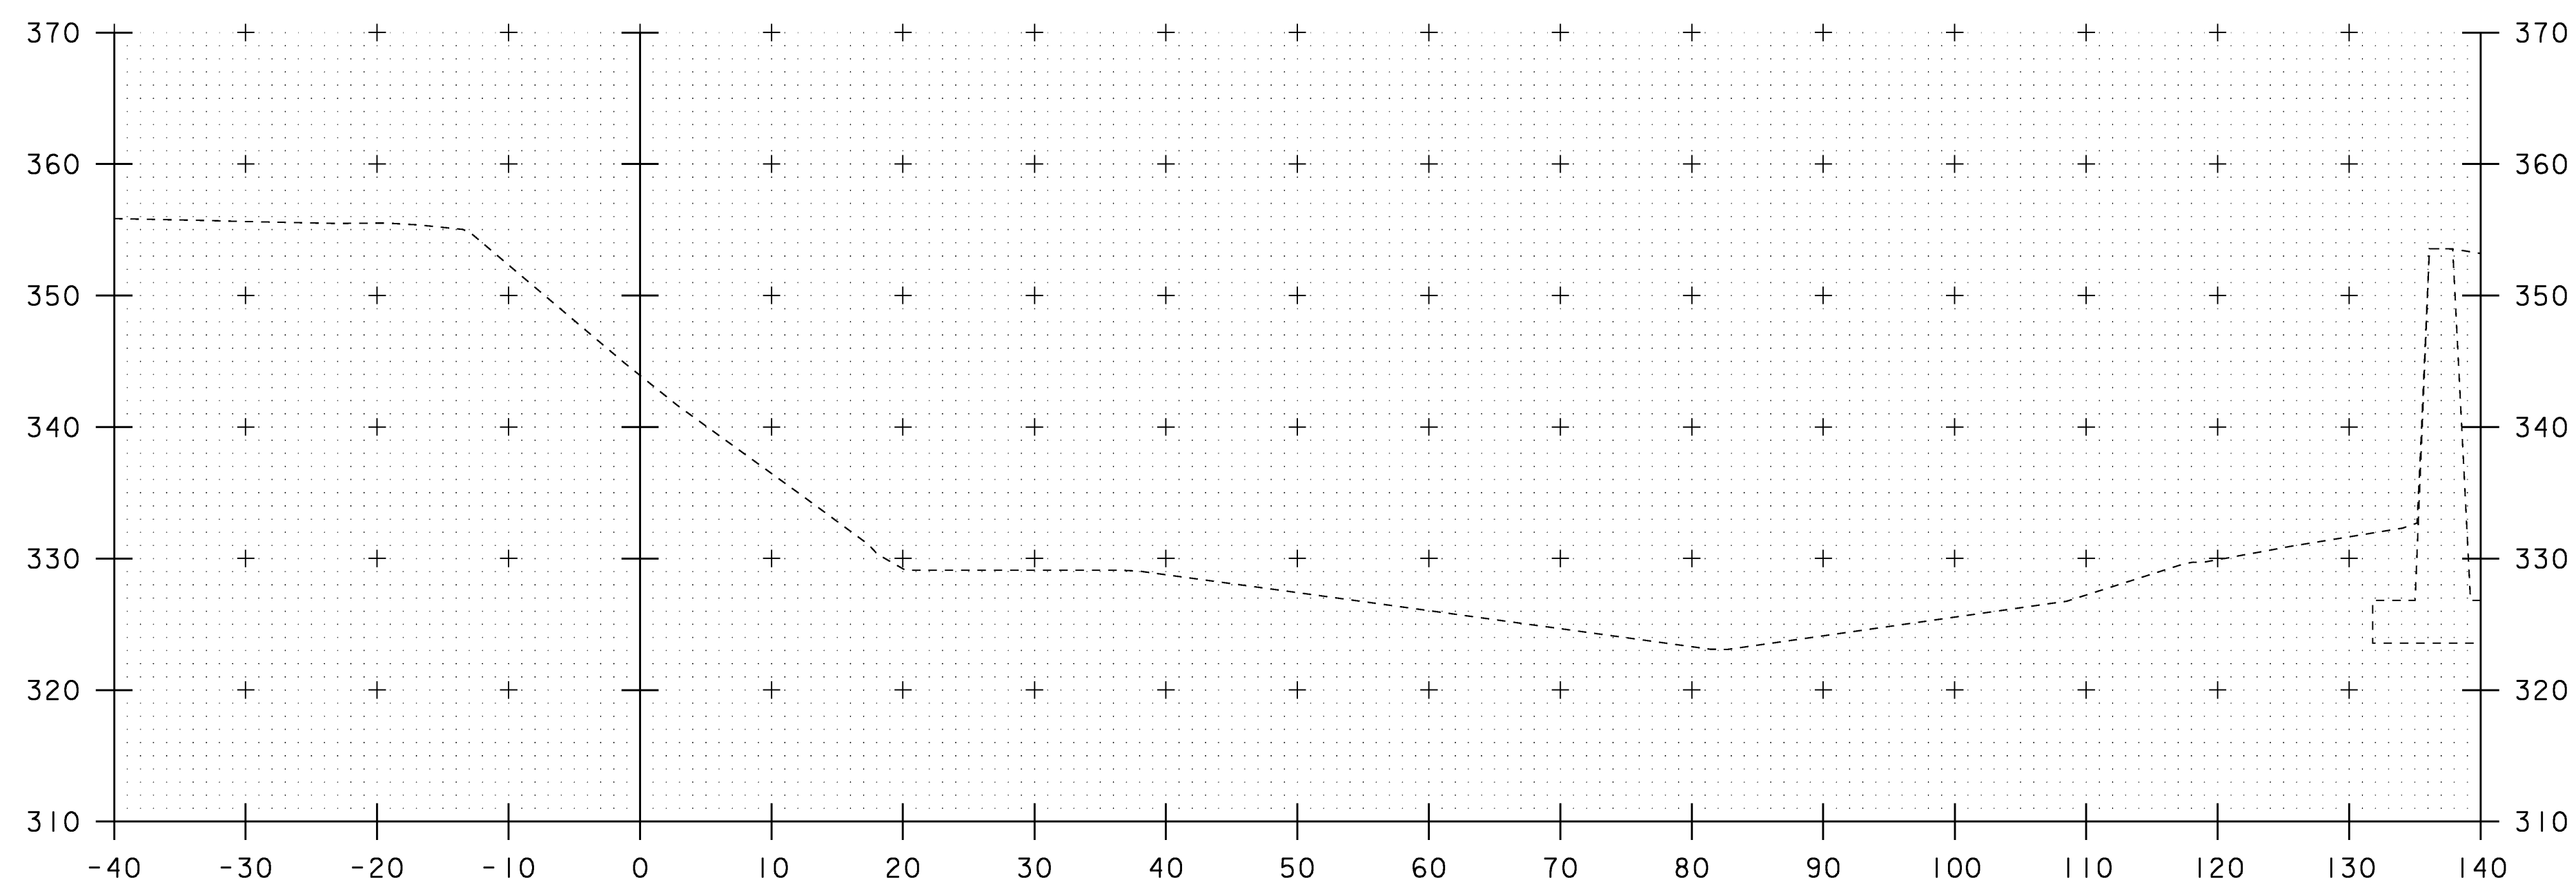

5+60

STA. 5+60 TO STA. 5+70

PROJECT NAME: SPRINGFIELD	PLOT DATE: 04-MAR-2009
PROJECT NUMBER: BHF 016-2(14)	DRAWN BY: D. PETERSON
FILE NAME: 06J004/str/s06J004xsl.dgn	CHECKED BY: C. CARLSON
PROJECT LEADER: R. WHITCOMB	SHEET 57 OF 72
DESIGNED BY: D. PETERSON	
CHANNEL CROSS SECTIONS (7)	