

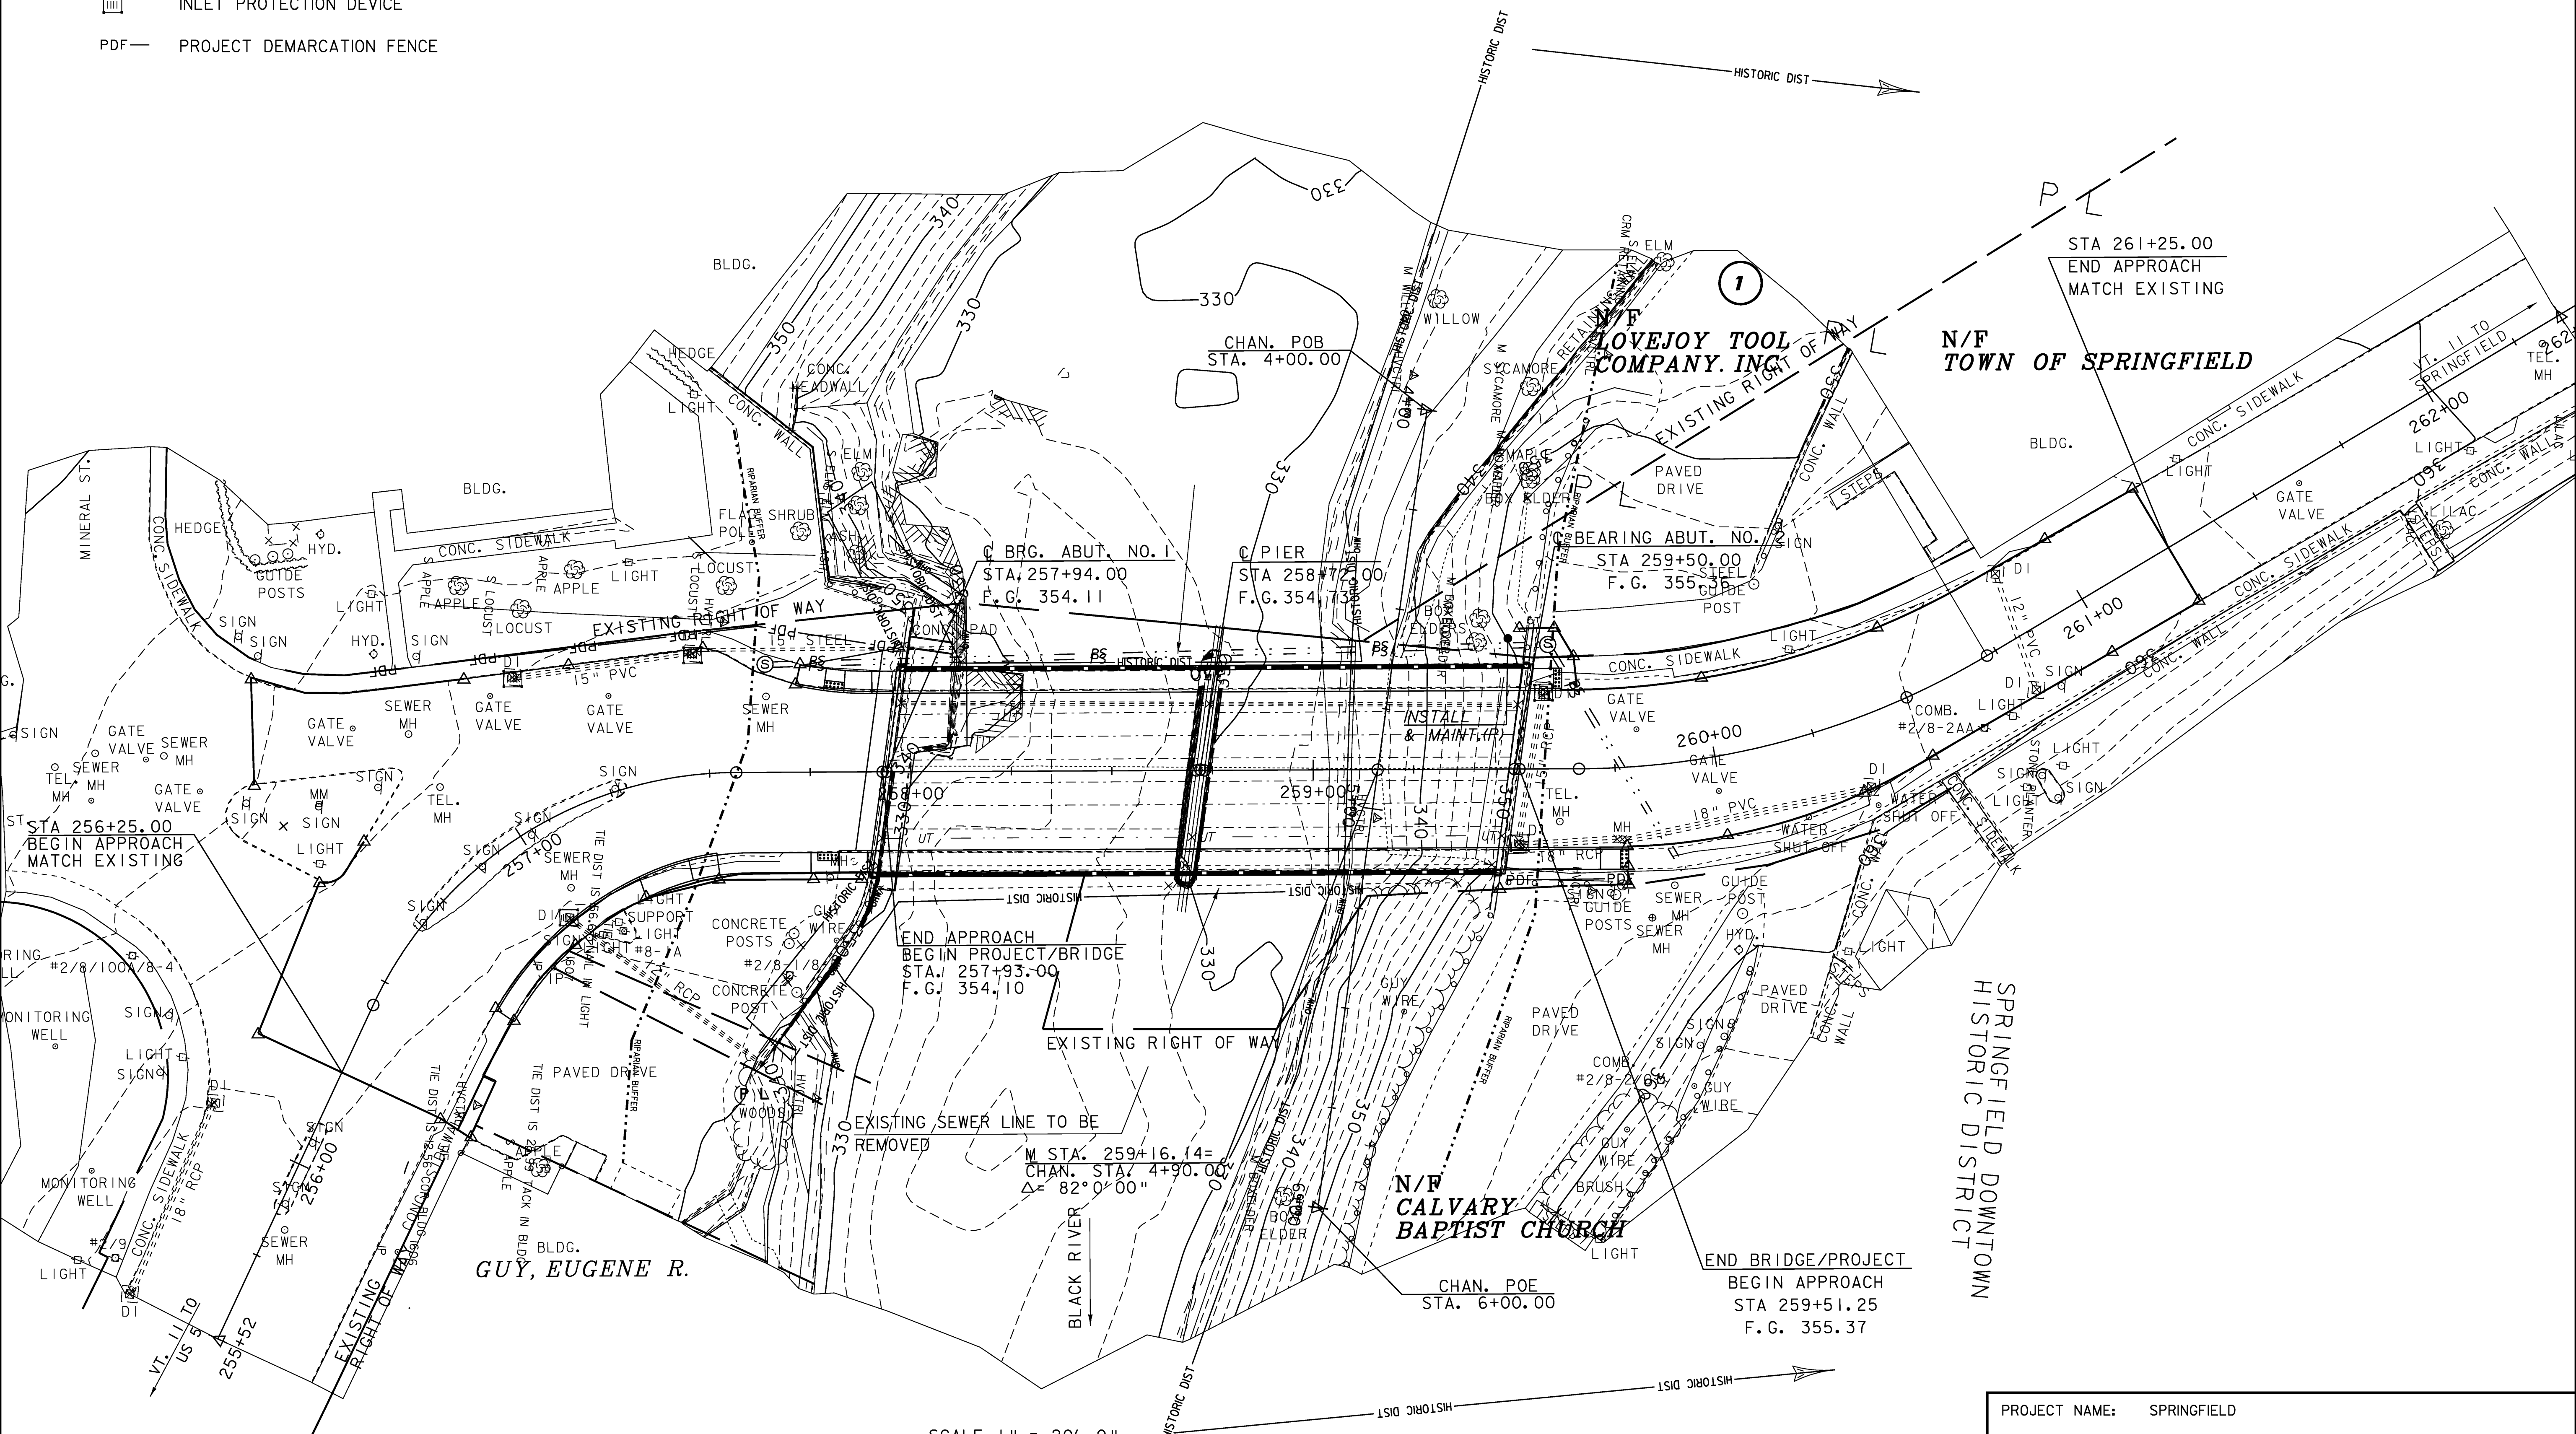


LEGEND

-  INLET PROTECTION DEVICE
-  PROJECT DEMARCATION FENCE



SCALE 1" = 20'-0"
 20 0 20

PROJECT NAME:	SPRINGFIELD
PROJECT NUMBER:	BHF 016-2(14)
FILE NAME:	06J004/str/s06J004ec.dgn
PROJECT LEADER:	R. WHITCOMB
DESIGNED BY:	C. CARLSON
EROSION CONTROL LAYOUT	
PLOT DATE:	01-APR-2009
DRAWN BY:	D. PETERSON
CHECKED BY:	D. PETERSON
SHEET	59 OF 72