



# SMH 1 - SMH 2

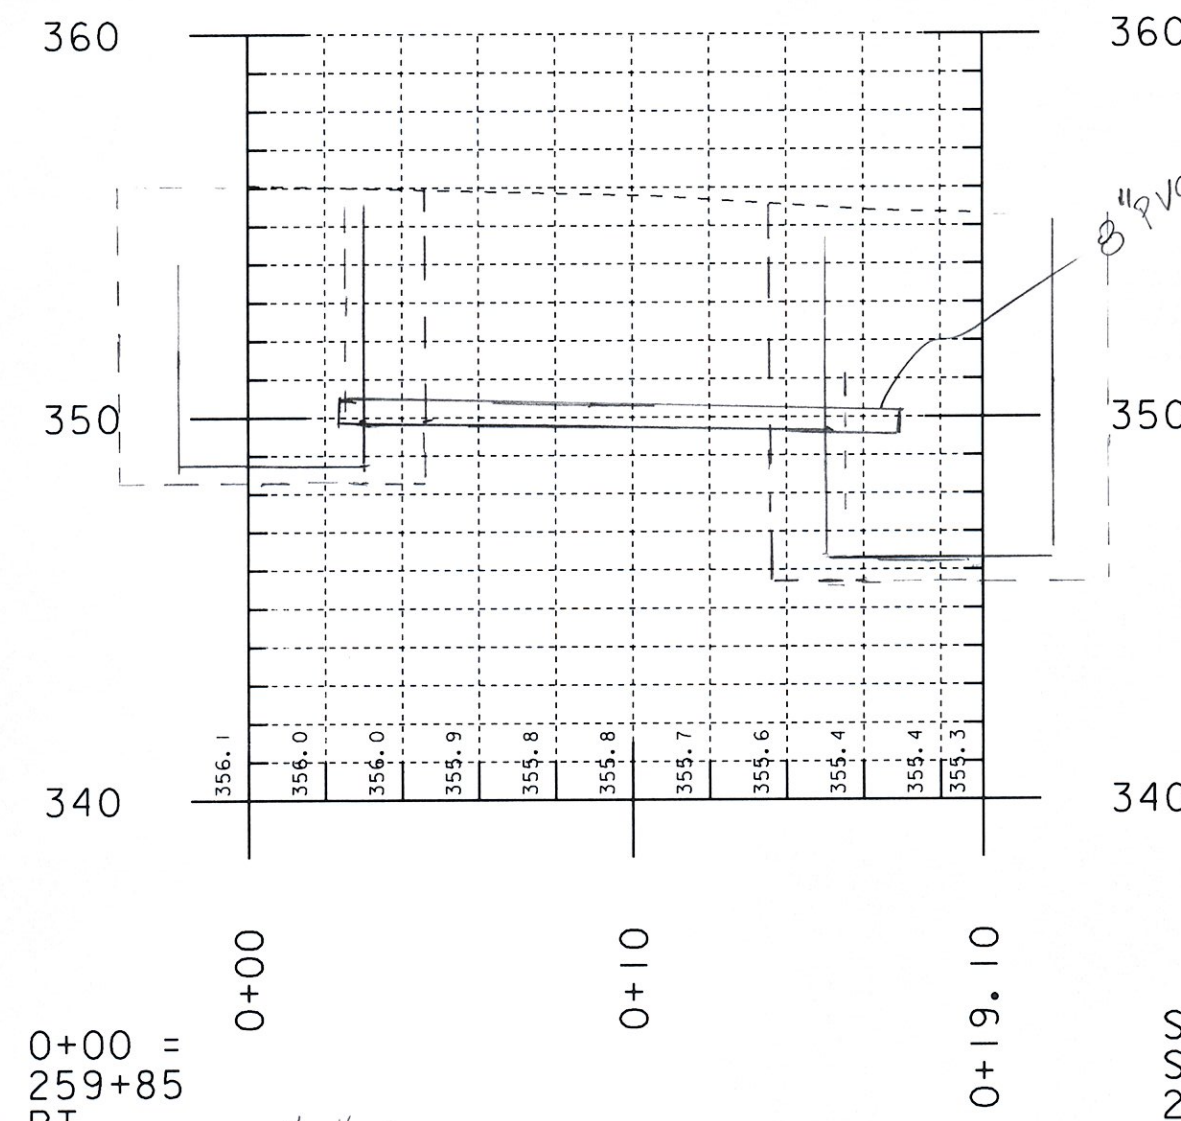

STA. 0+00 =  
 STA. 259+85  
 41.2 RT  
 SMH 1  
 4'-10" OD  
 Sump  
 Base  
 Undercut

STA. 0+19.10 =  
 STA. 259+92.5  
 24.2 RT  
 SMH 2  
 6'-0" ID 6' OD  
 Sump  
 Base  
 Undercut  
 Bot. SMH 346.31  
 Undercut 0.50


# SMH 2 - SMH 3

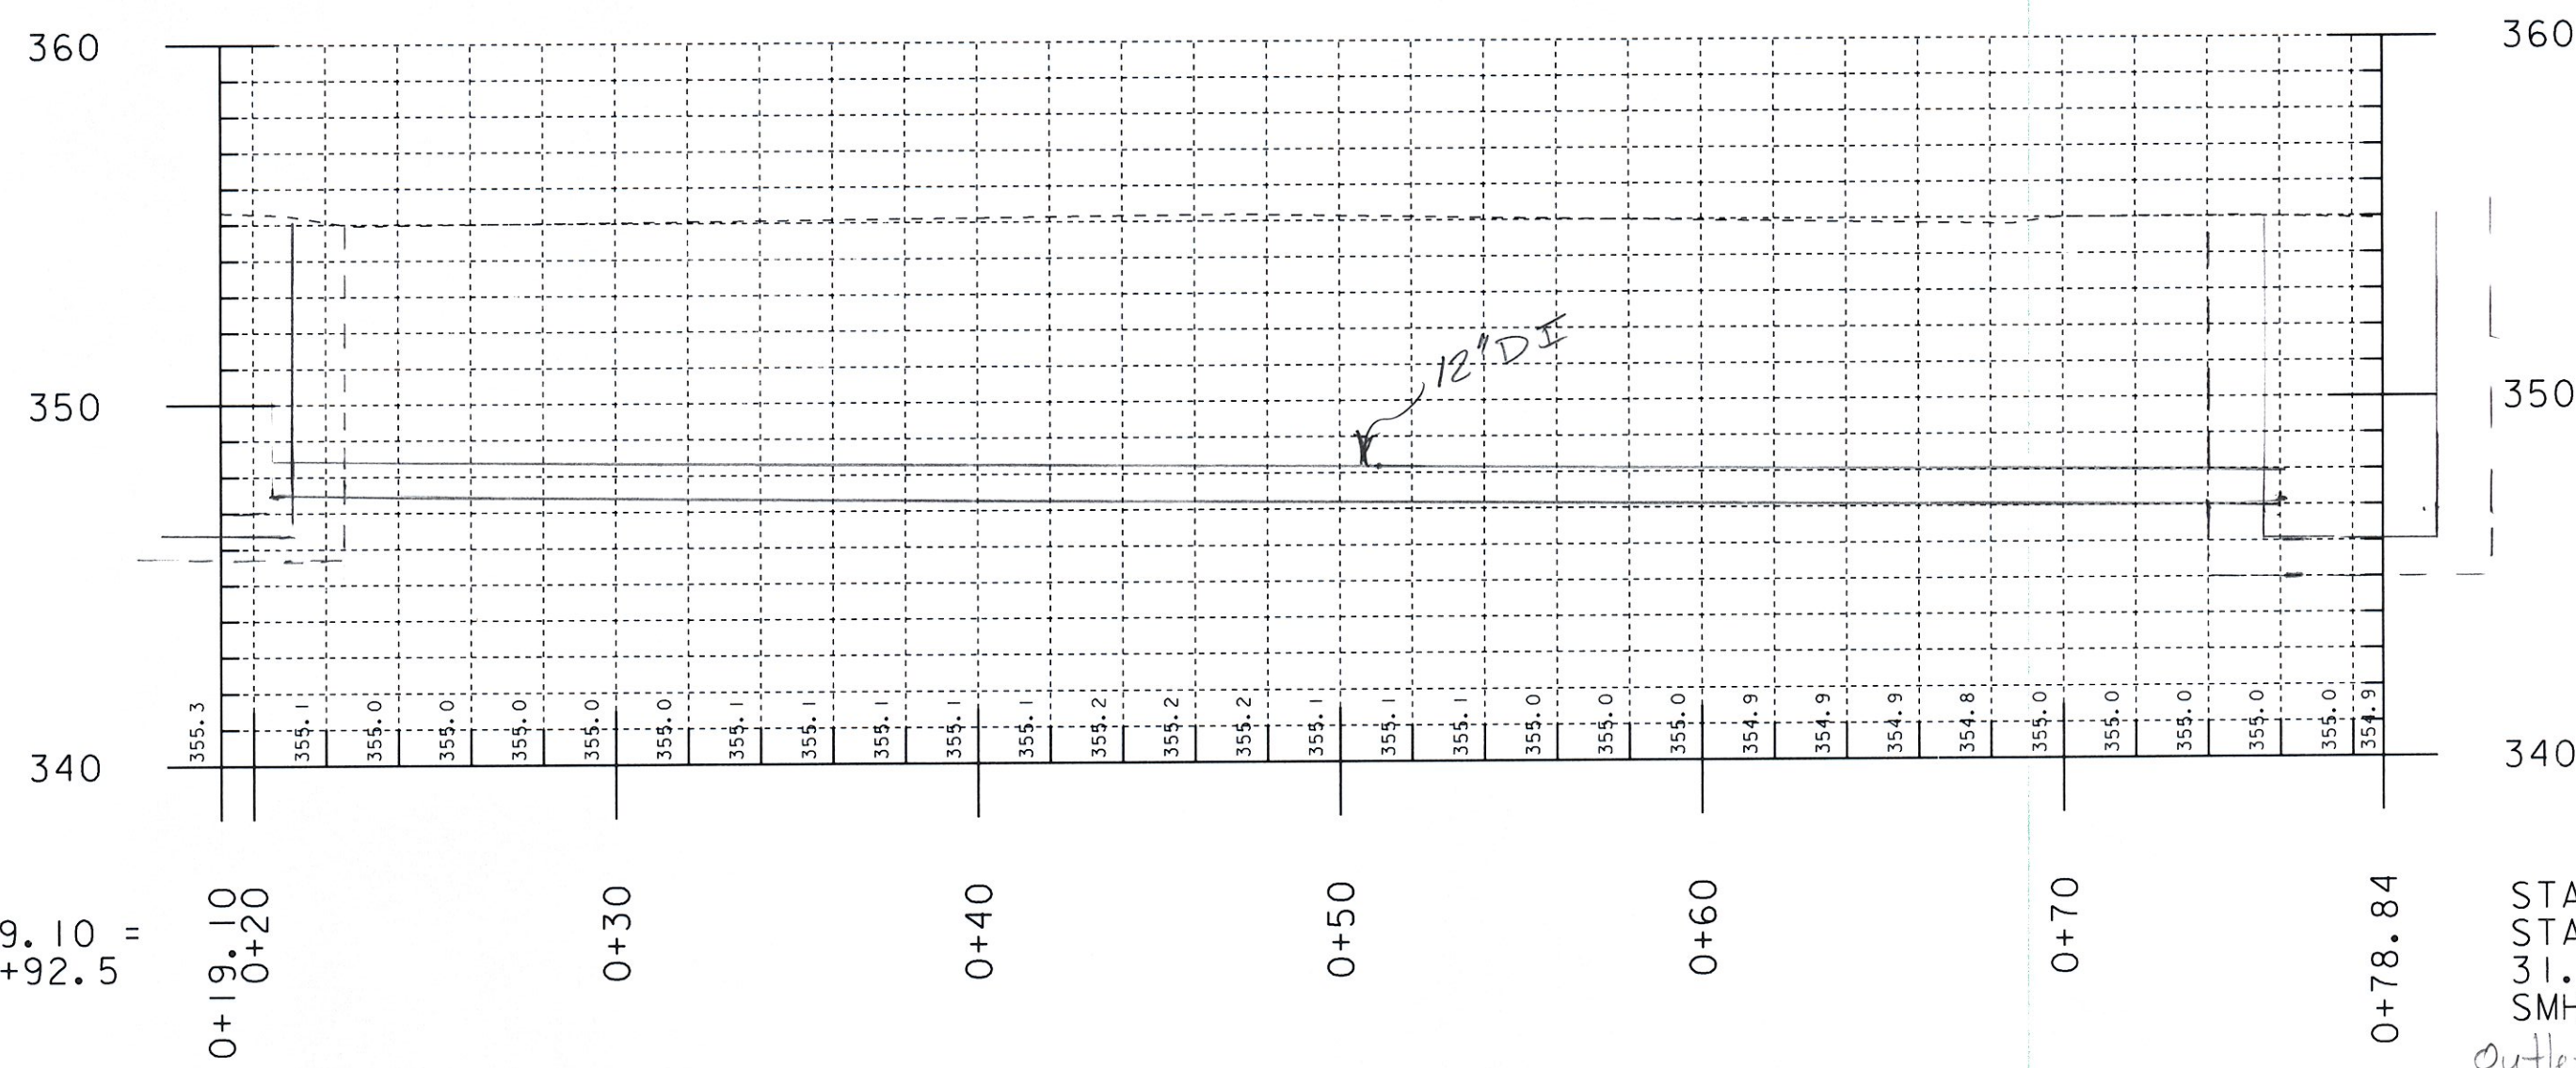

STA. 0+19.10 =  
 STA. 259+92.5  
 24.2 RT  
 SMH 2  
 Outlet Inv 347.48  
 Sump 0.50  
 Base 0.67  
 Undercut 346.31  
 0.50  
 345.8

STA. 0+78.84 =  
 STA. 259+70  
 31.4 LT  
 SMH 3 (4' Dia)  
 Outlet Inv 347.12  
 Sump 0.50  
 Base 0.67  
 Undercut 345.95  
 1.00  
 344.95  
 345.0

12" DI SMH 3 to SMH 2  
 1.5' stub in SMH 2 8/13/09  
 18.0 on 8/7/09  
 18.0 on 8/10/09  
 18.0 on 8/12/09  
 53.5 LF

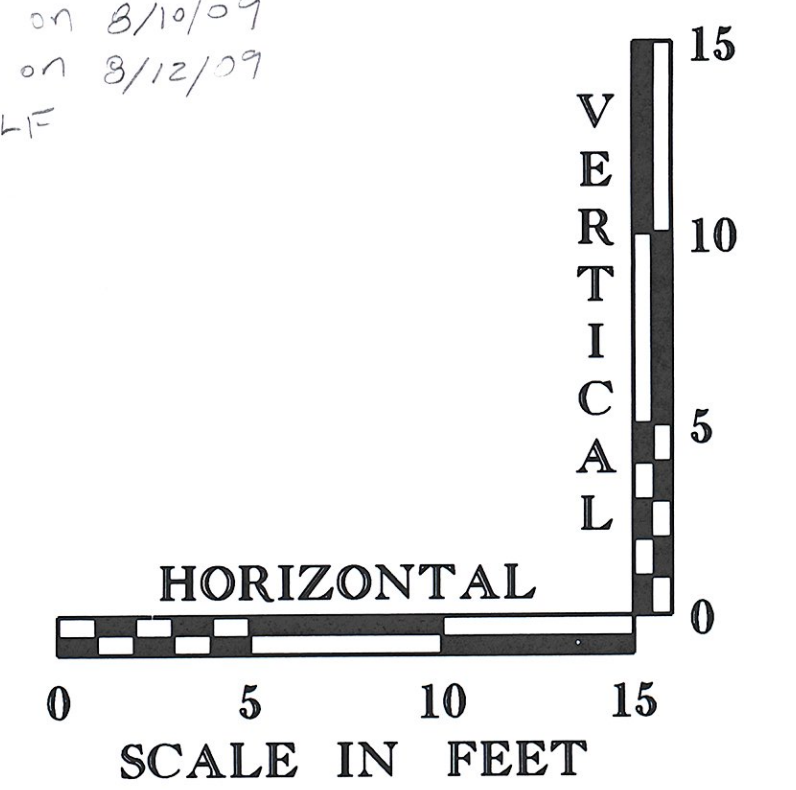

PROJECT NAME: SPRINGFIELD  
 PROJECT NUMBER: BHF 016-2(14)

FILE NAME: ppms\*/Section/-----dgn  
 PROJECT LEADER: -----  
 DESIGNED BY: -----

PLOT DATE: 26-APR-2010  
 DRAWN BY: -----  
 CHECKED BY: -----  
 SHEET 1 OF 3