


SMH4 - SMH5

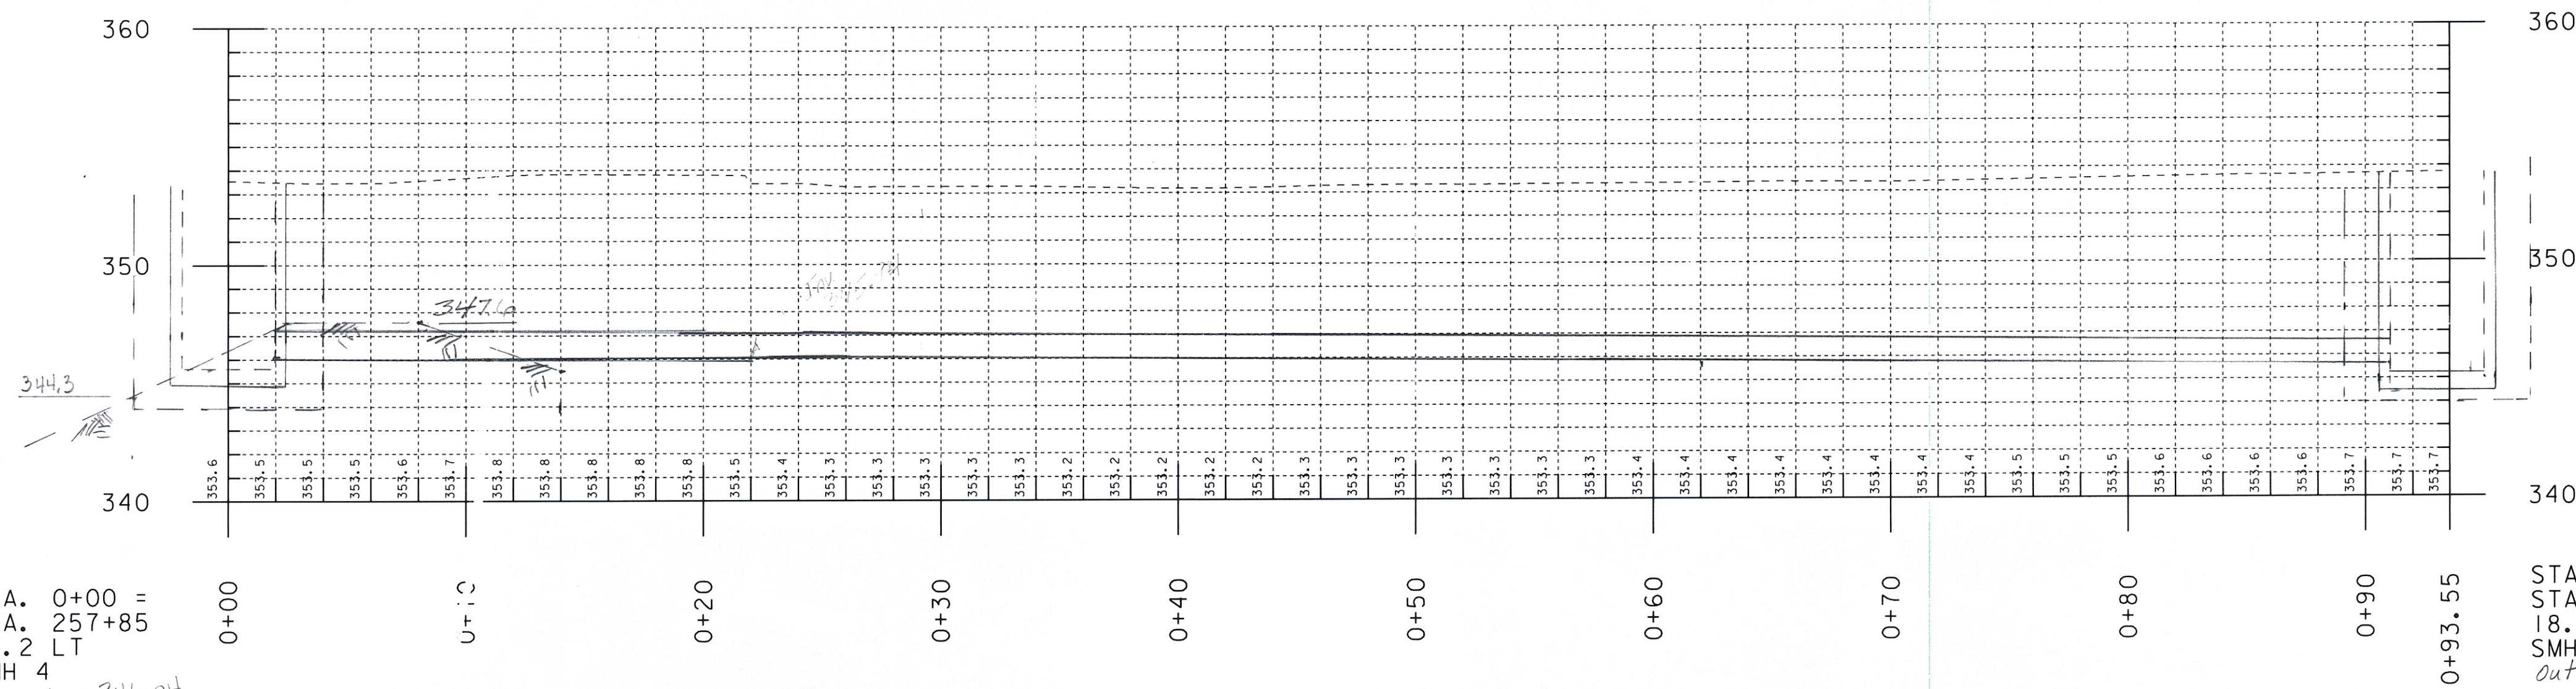


12" SDR PVC
 26' 7-28-09
 52' 7-29-09
 11' 8-5-09
 89'

STA. 0+00 =
 STA. 257+85
 31.2 LT
 SMH 4
 Inv. Out = 346.04
 Samp 0.50
 Base 0.67
 344.87
 Undercut 1.00 1.50 ✓
 343.87 343.3

STA. 0+93.55 =
 STA. 257+03
 18.1 LT
 SMH 5
 Outlet Inv. 345.44
 .5
 344.27
 Undercut 0.50
 343.77


SMH5 - SMH6

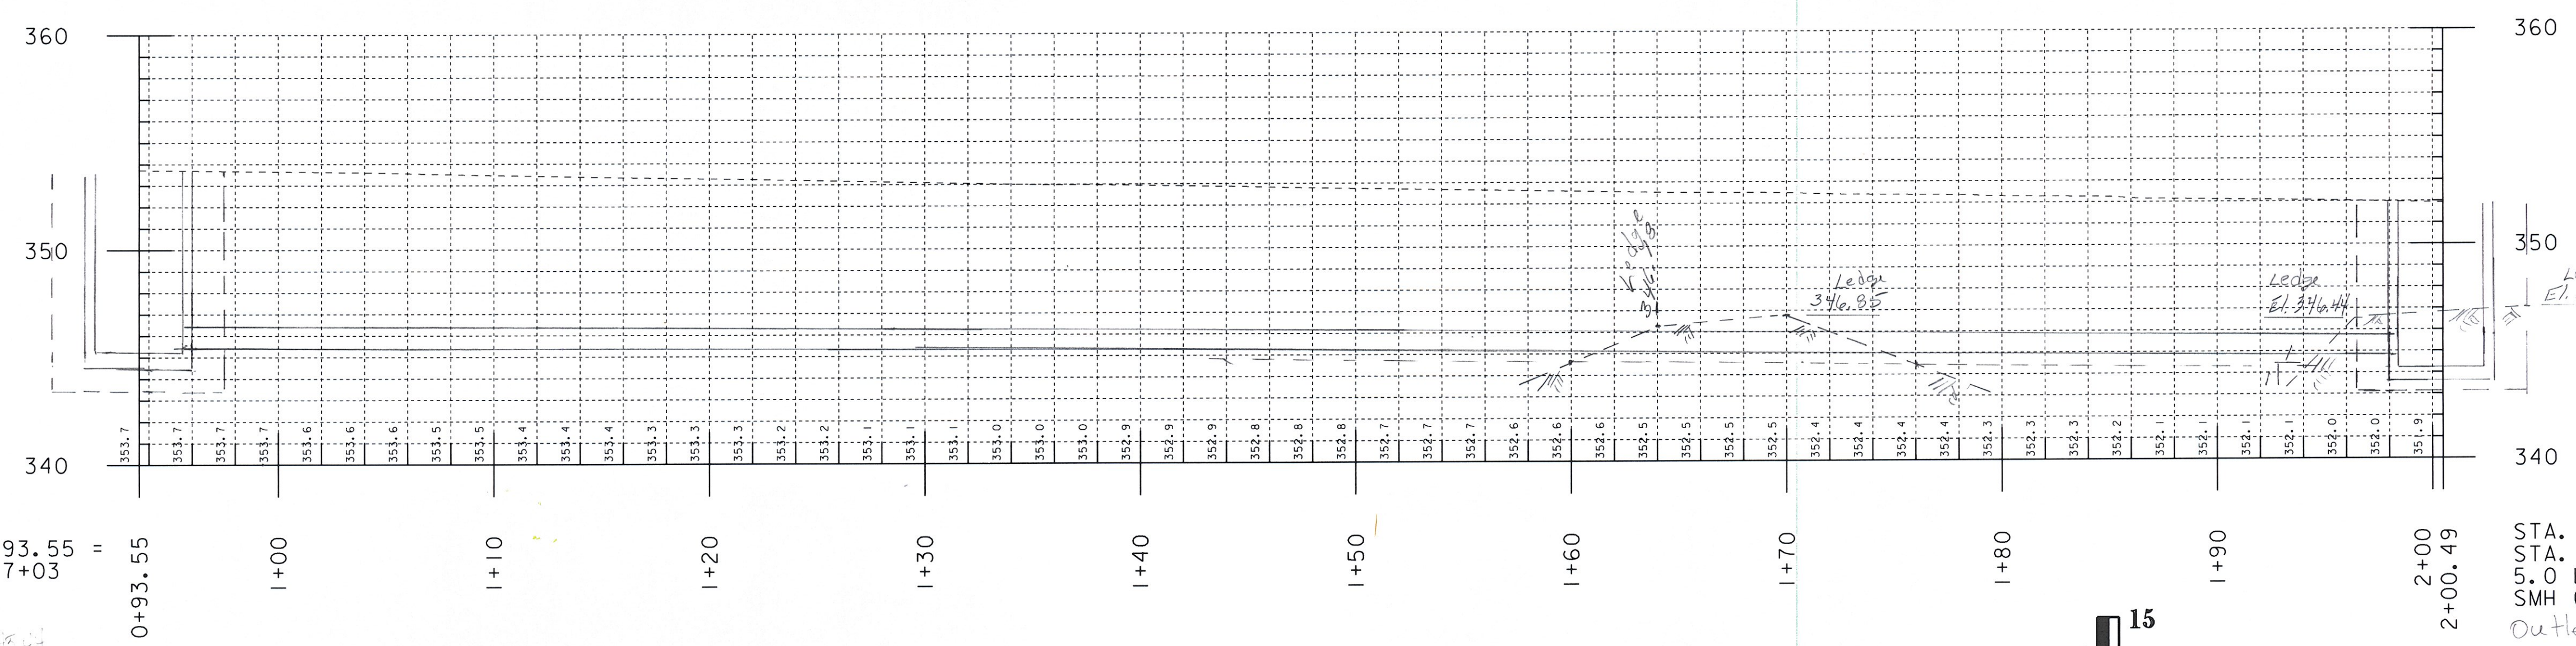

12" SDR PVC
 26' 7-28-09
 52' 7-28-09
 25' 7-27-09
 103

STA. 0+93.55 =
 STA. 257+03
 18.1 LT
 SMH 5
 Outlet 346.04

STA. 2+00.49 =
 STA. 256+03
 5.0 LT
 SMH 6
 Outlet Inv. 344.87
 Samp. 50
 Base 0.67
 Undercut 50
 343.27

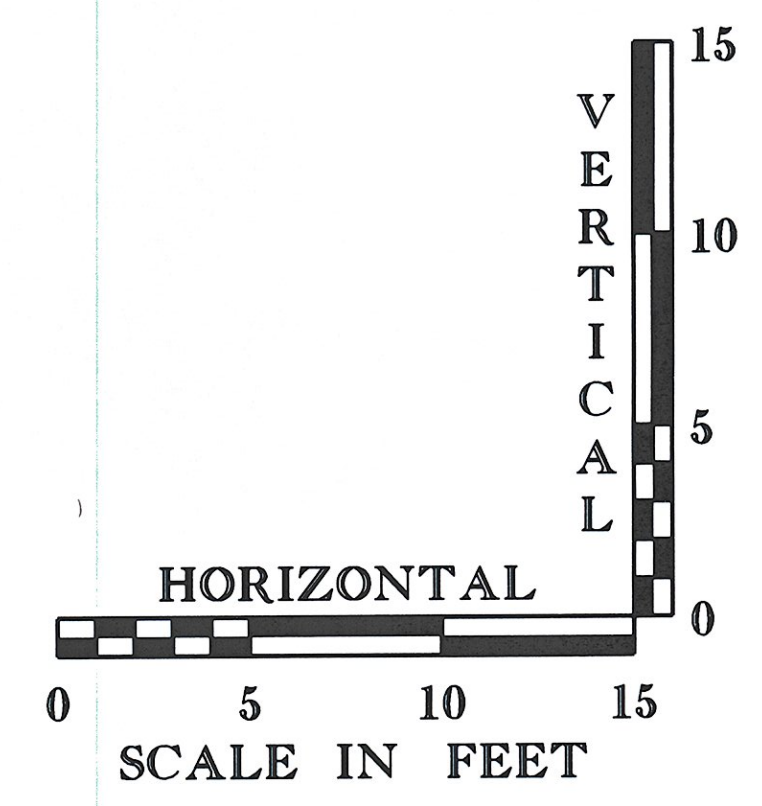

PROJECT NAME: SPRINGFIELD	PLOT DATE: 26-APR-2010
PROJECT NUMBER: BHF 016-2(14)	DRAWN BY: -----
FILE NAME: ppms*/Section/-----.dgn	CHECKED BY: -----
DESIGNED BY: -----	SHEET 2 OF 3