

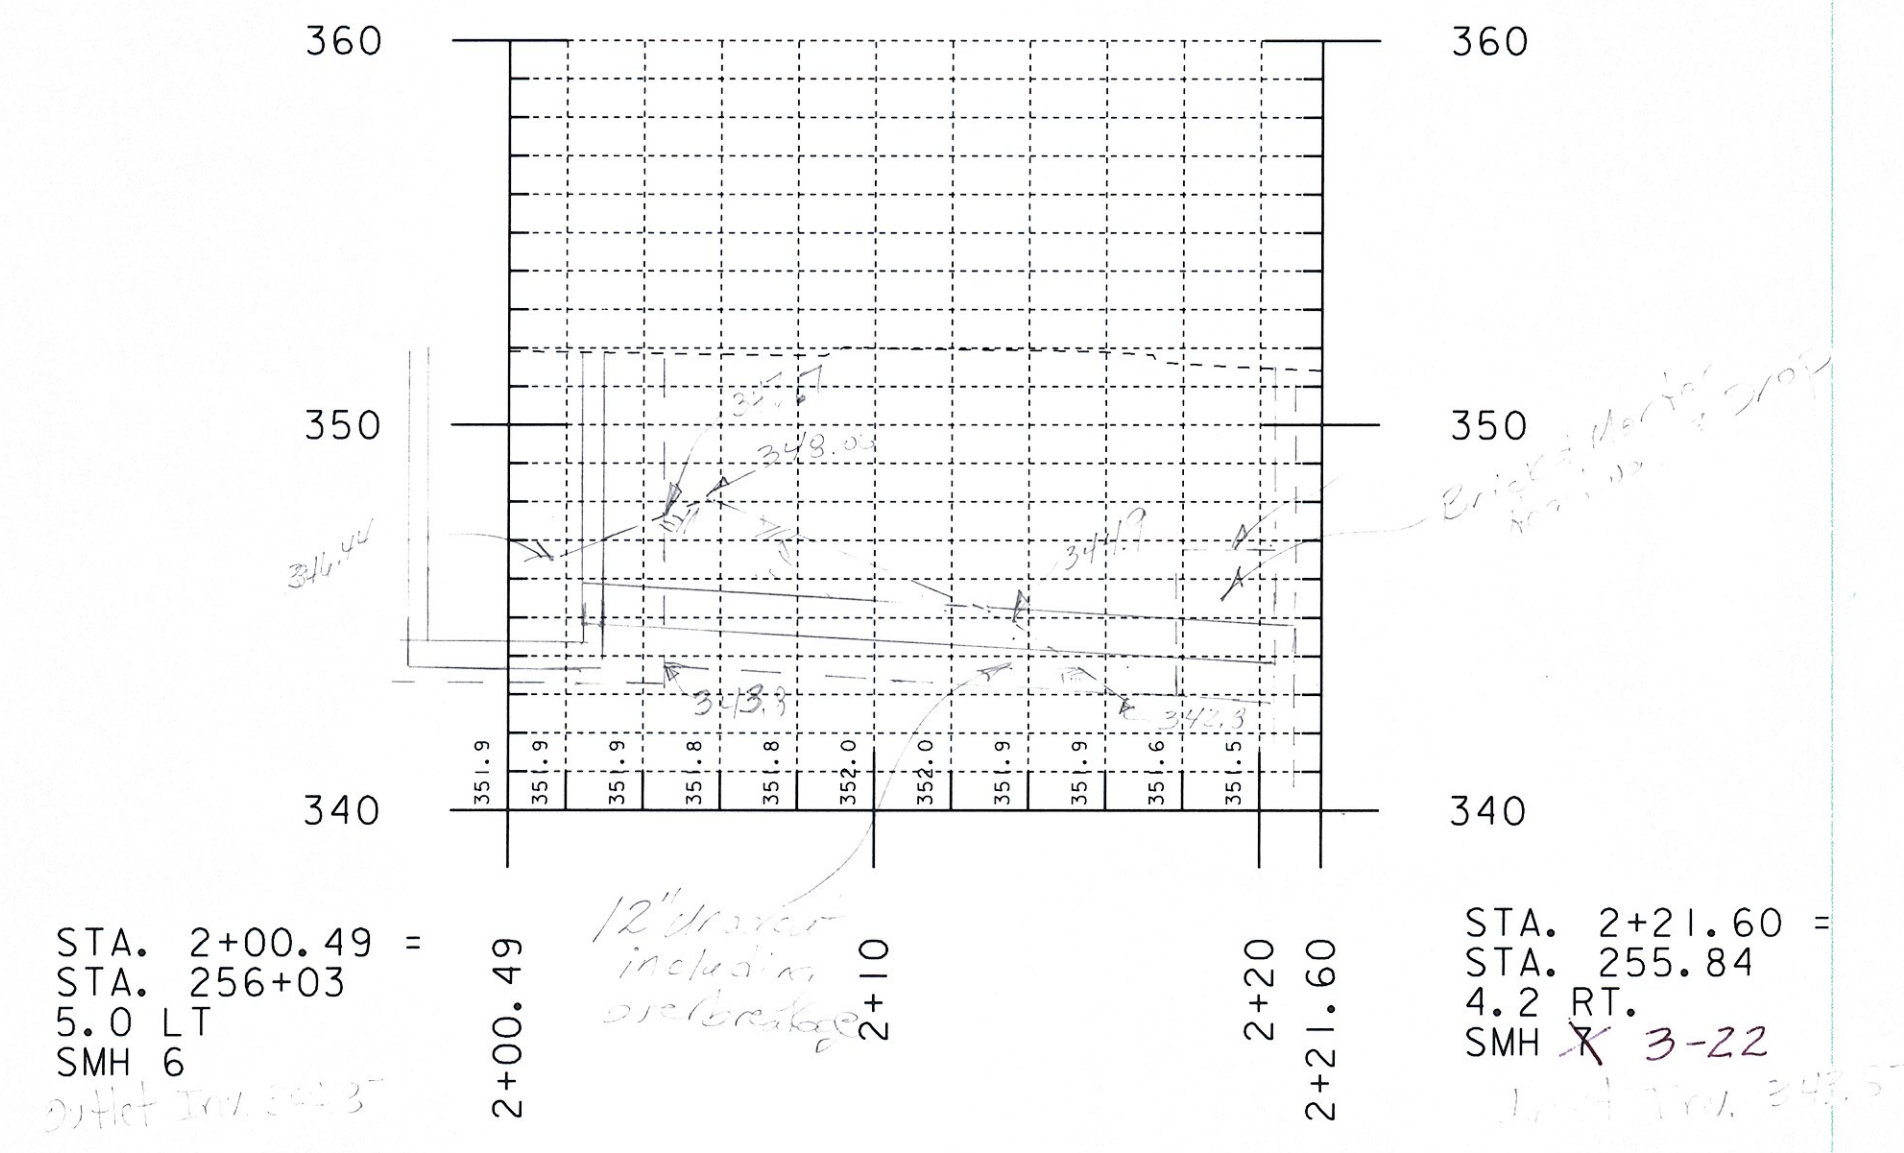


SMH6 - SMH ~~3-22~~ 3-22 (EXISTING)

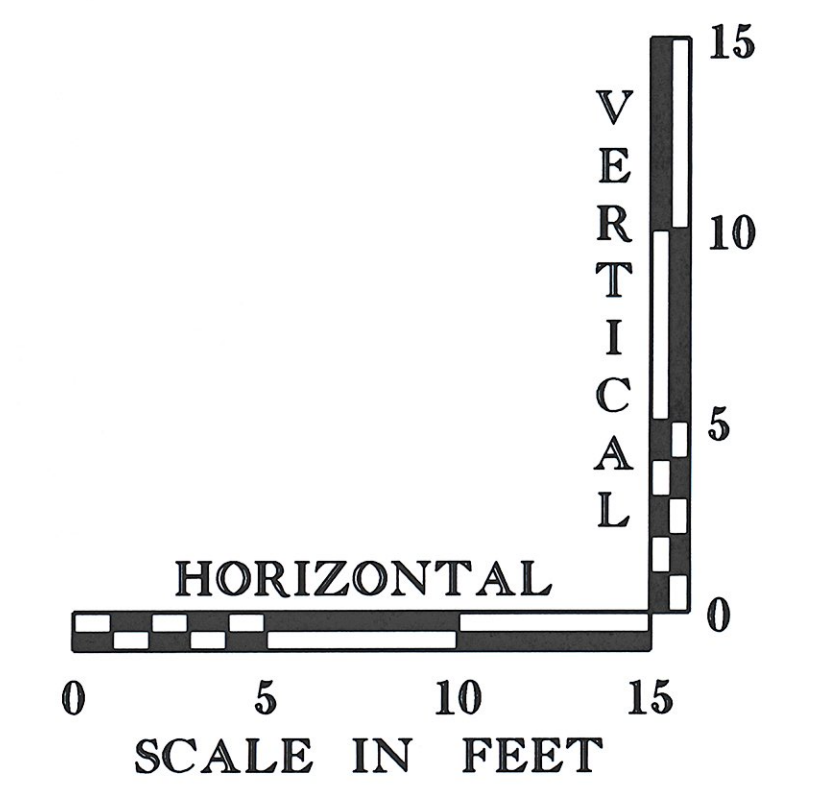

SMH5 - CLEANOUT

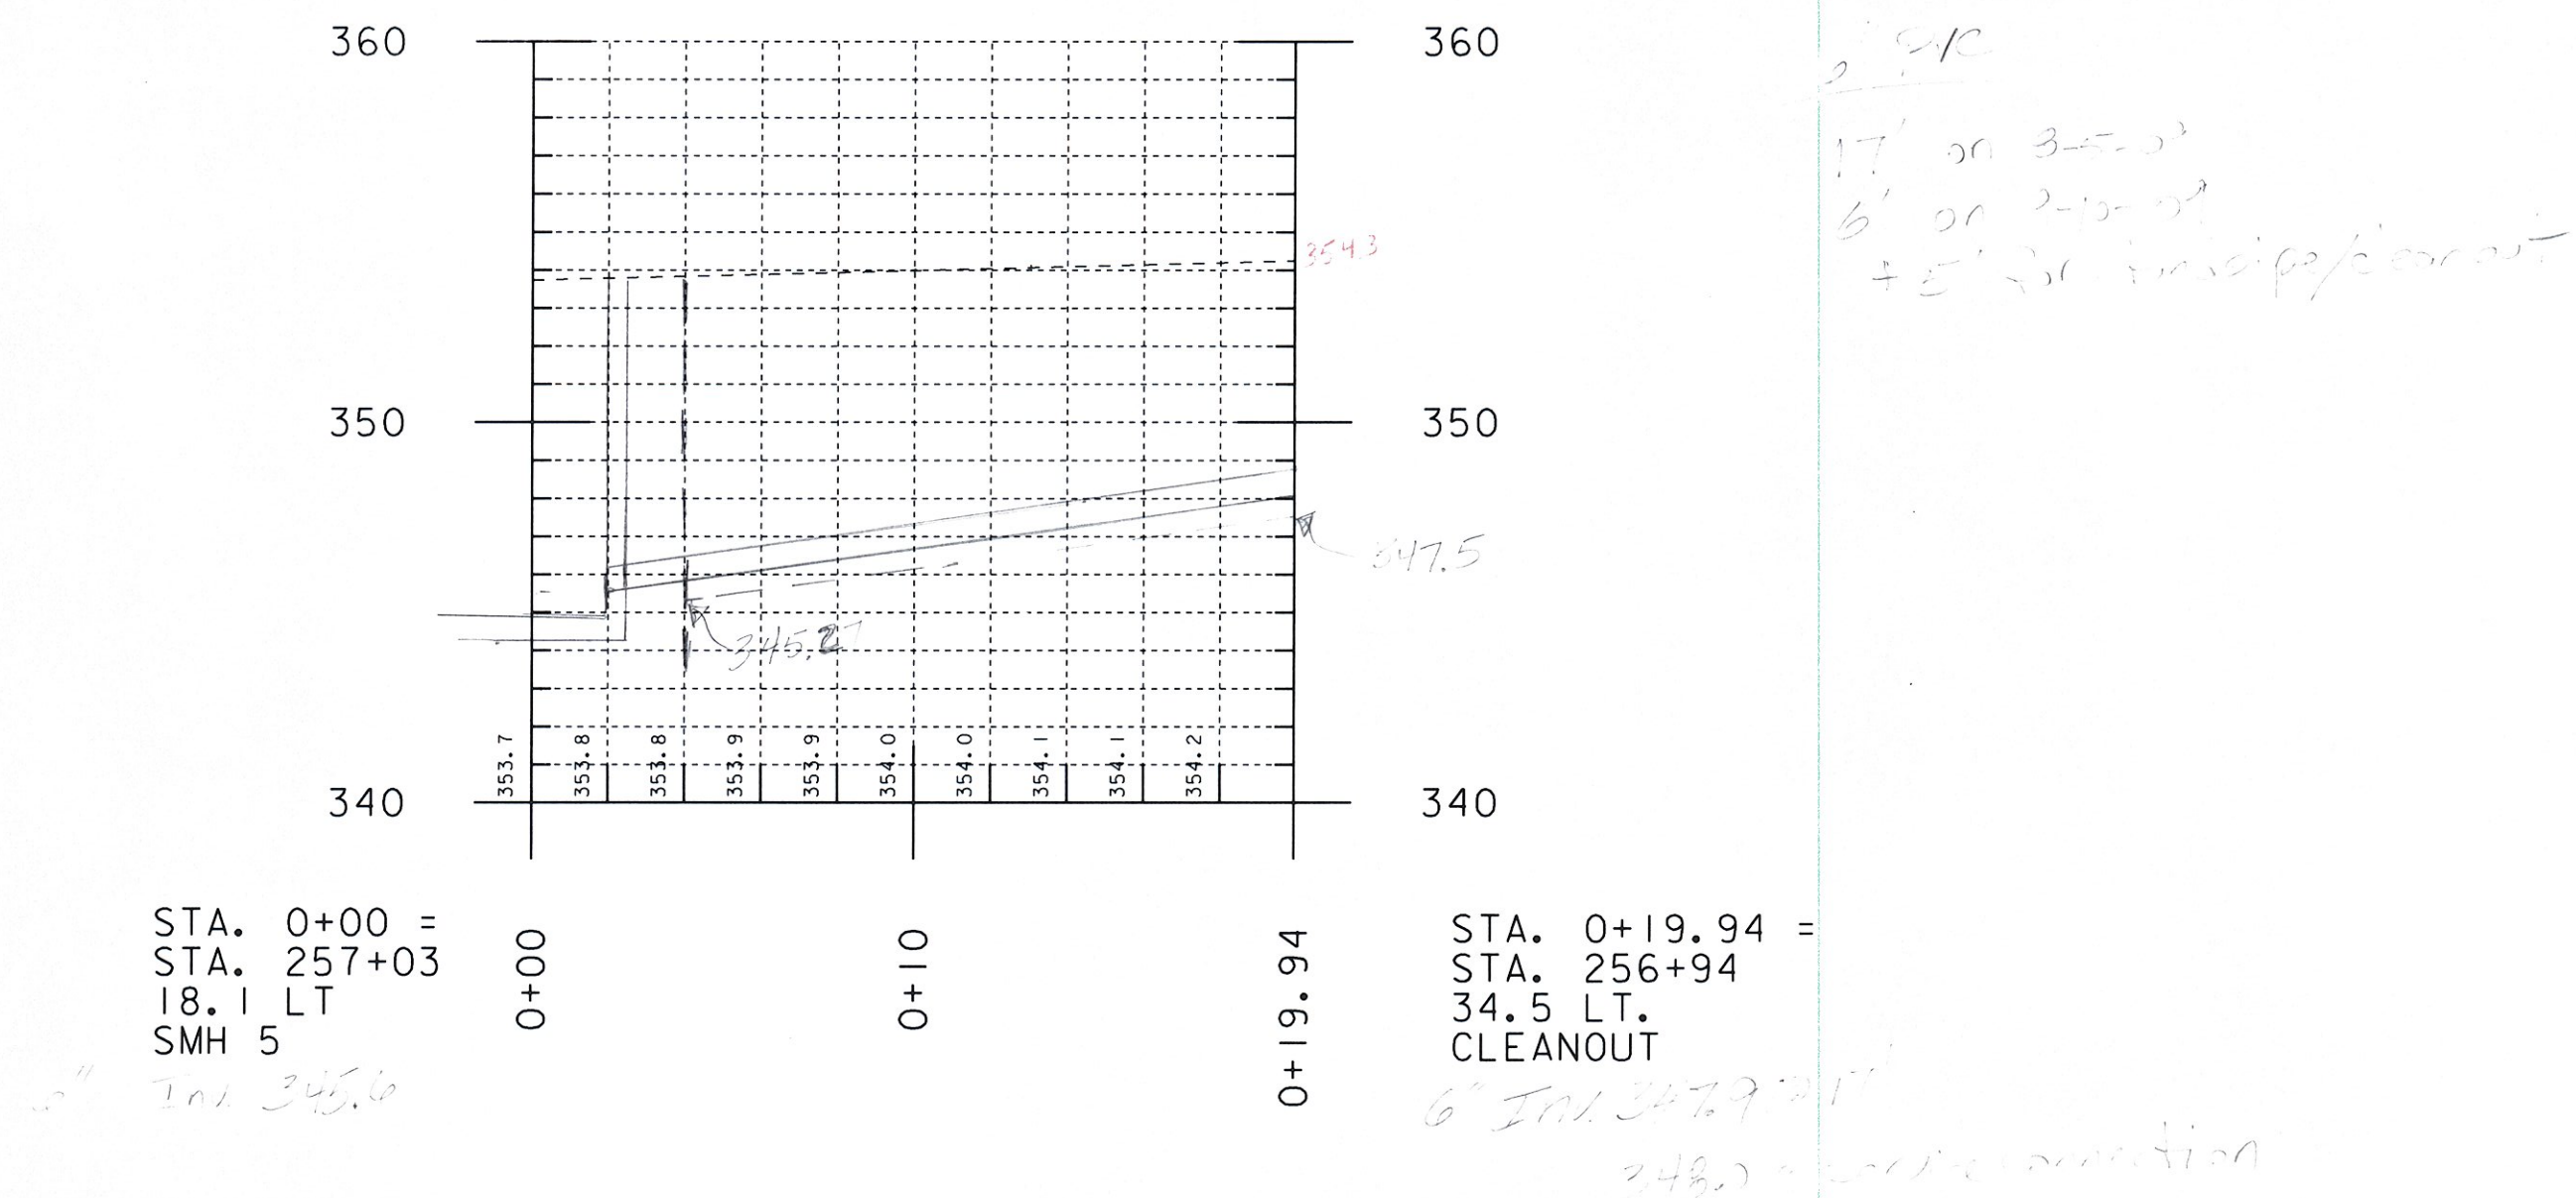

PROJECT NAME: SPRINGFIELD	PLOT DATE: 26-APR-2010
PROJECT NUMBER: BHF 016-2(14)	DRAWN BY: -----
FILE NAME: ppms#/Section/-----.dgn	CHECKED BY: -----
PROJECT LEADER: -----	SHEET 3 OF 3
DESIGNED BY: -----	