


10 The Top of 2009 02/25/14 File: casco/ghs/2875/X2.rvt

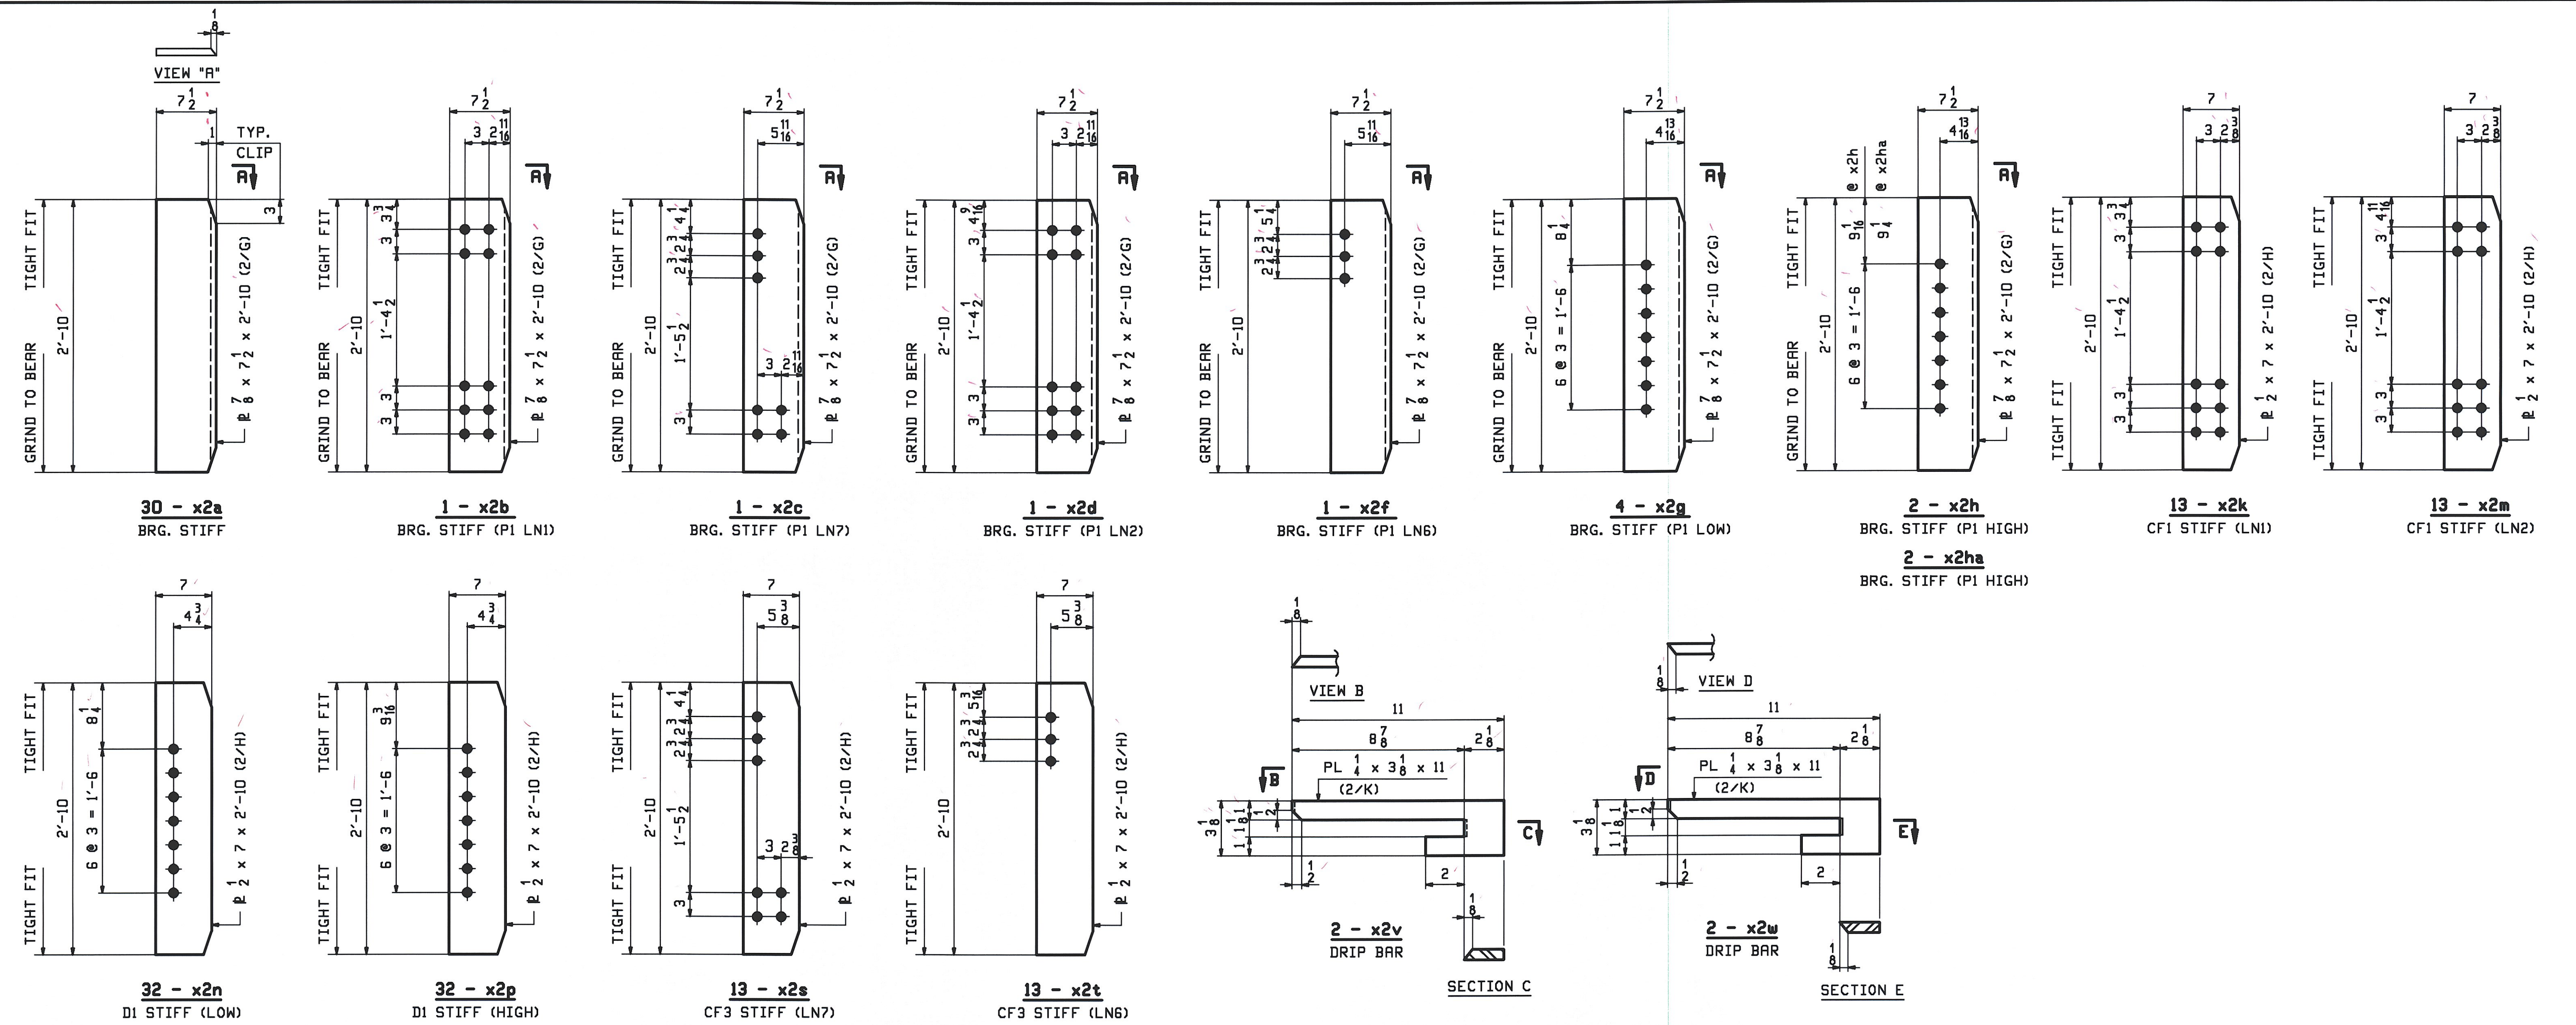

NOTES:  
FOR GENERAL NOTES SEE DRAWING GNI.

REV.	DATE	REMARKS	DWN	CHK	APVL	SHOP
0						
MATERIAL:		SURFACE PREP. & PAINT:		HOLES:		SHOP BOLTS:
M270-50M		SEE GNI		15/16" Ø		NONE
DESCRIPTION: GIRDER STANDARDS						
CASCO BAY STEEL STRUCTURES, INC.						
75 SPRING HILL ROAD			SACO, MAINE 04072			
PHONE (207) 282-7360			FAX. (207) 282-1179			
STRUCTURE: VT 11 OVER BLACK RIVER					DRAWN:	DATE:
BRIDGE NO. 64					WJF	06/10
SPRINGFIELD, VERMONT					CHKD:	DATE:
COUNTY OF WINDSOR					DO	06/22
LOCATION: TOWN OF SPRINGFIELD					JOB NO.	DWG NO.
PROJ NO. BHF 016-2(14)					406-1	X2
CUSTOMER: COLD RIVER BRIDGES, LLC					REV.	△

RECEIVED  
 JUN 26 2009  
 JUN 26 2009  
 BY [Signature] DATE 7-7-09