

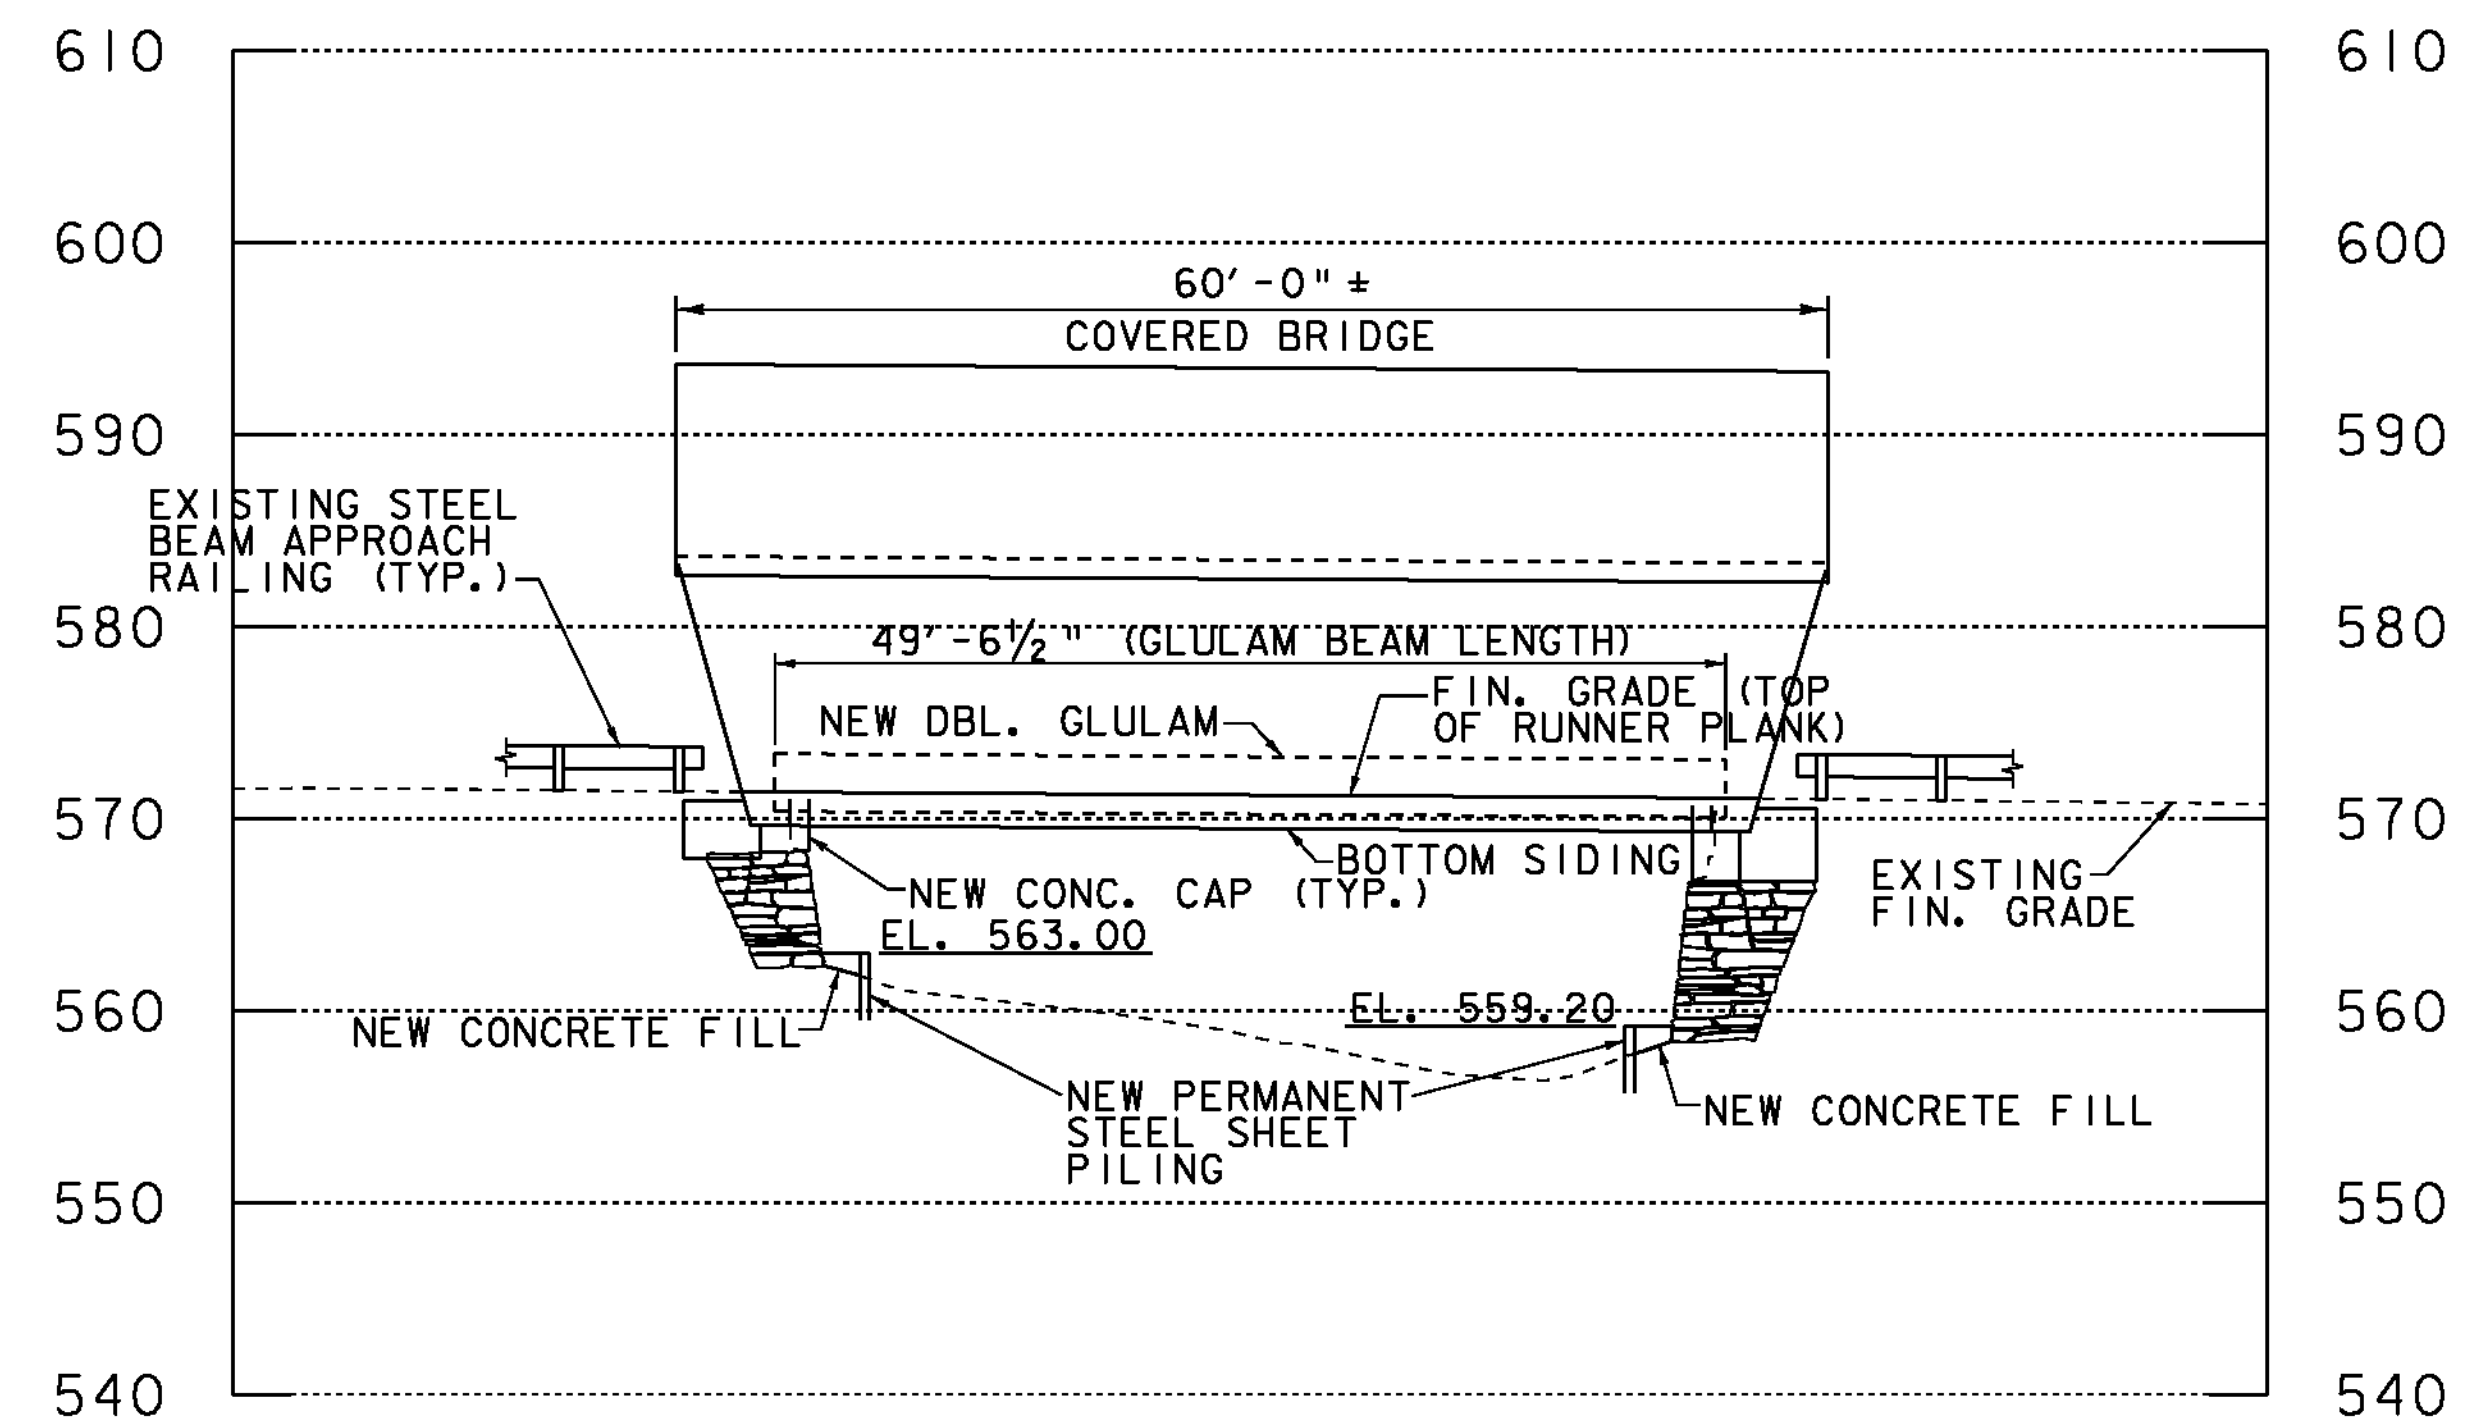


PROFILE @ C T.H. 66
(LOOKING NORTH)

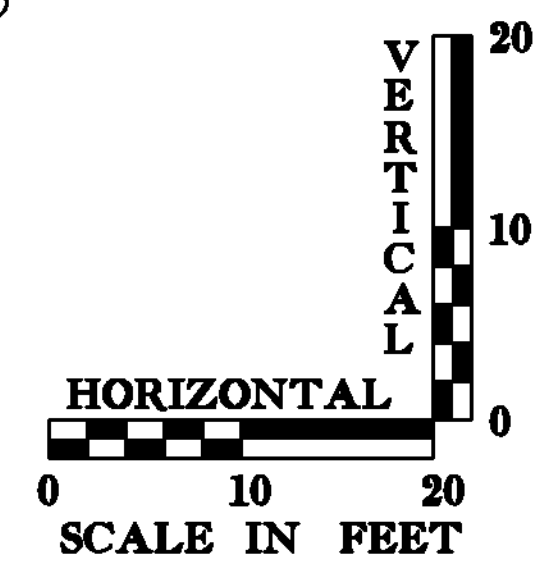

ELEVATION
(LOOKING NORTH)

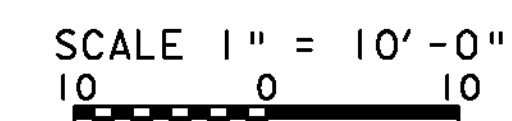

PROJECT NAME:	RANDOLPH
PROJECT NUMBER:	BHO 1444(53)
FILE NAME:	06J092\str\s06J092profile.dgn
PROJECT LEADER:	M. SARGENT
DESIGNED BY:	J. WEAVER
PROFILE & ELEVATION SHEET	
PLOT DATE:	09-NOV-2010
DRAWN BY:	C. WEEBER
CHECKED BY:	M. SARGENT
SHEET	8 OF 27