



**RUNNER BOARD PLAN VIEW**  
1" = 1'-0"

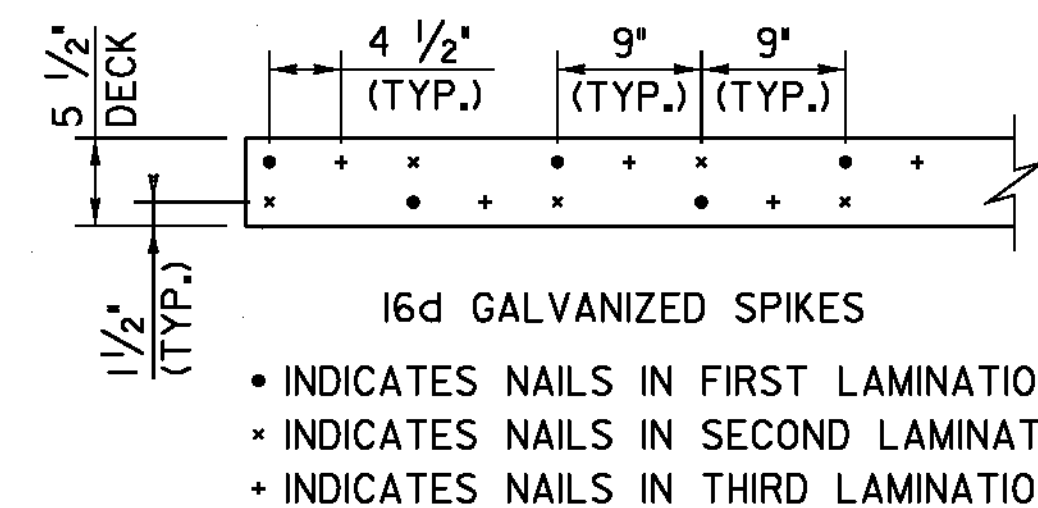

**DECK NAILING PATTERN**  
1" = 1'-0"

NOTE:

1. ALL MEMBERS AND COMPONENTS SHOWN ON THIS SHEET ARE NEW

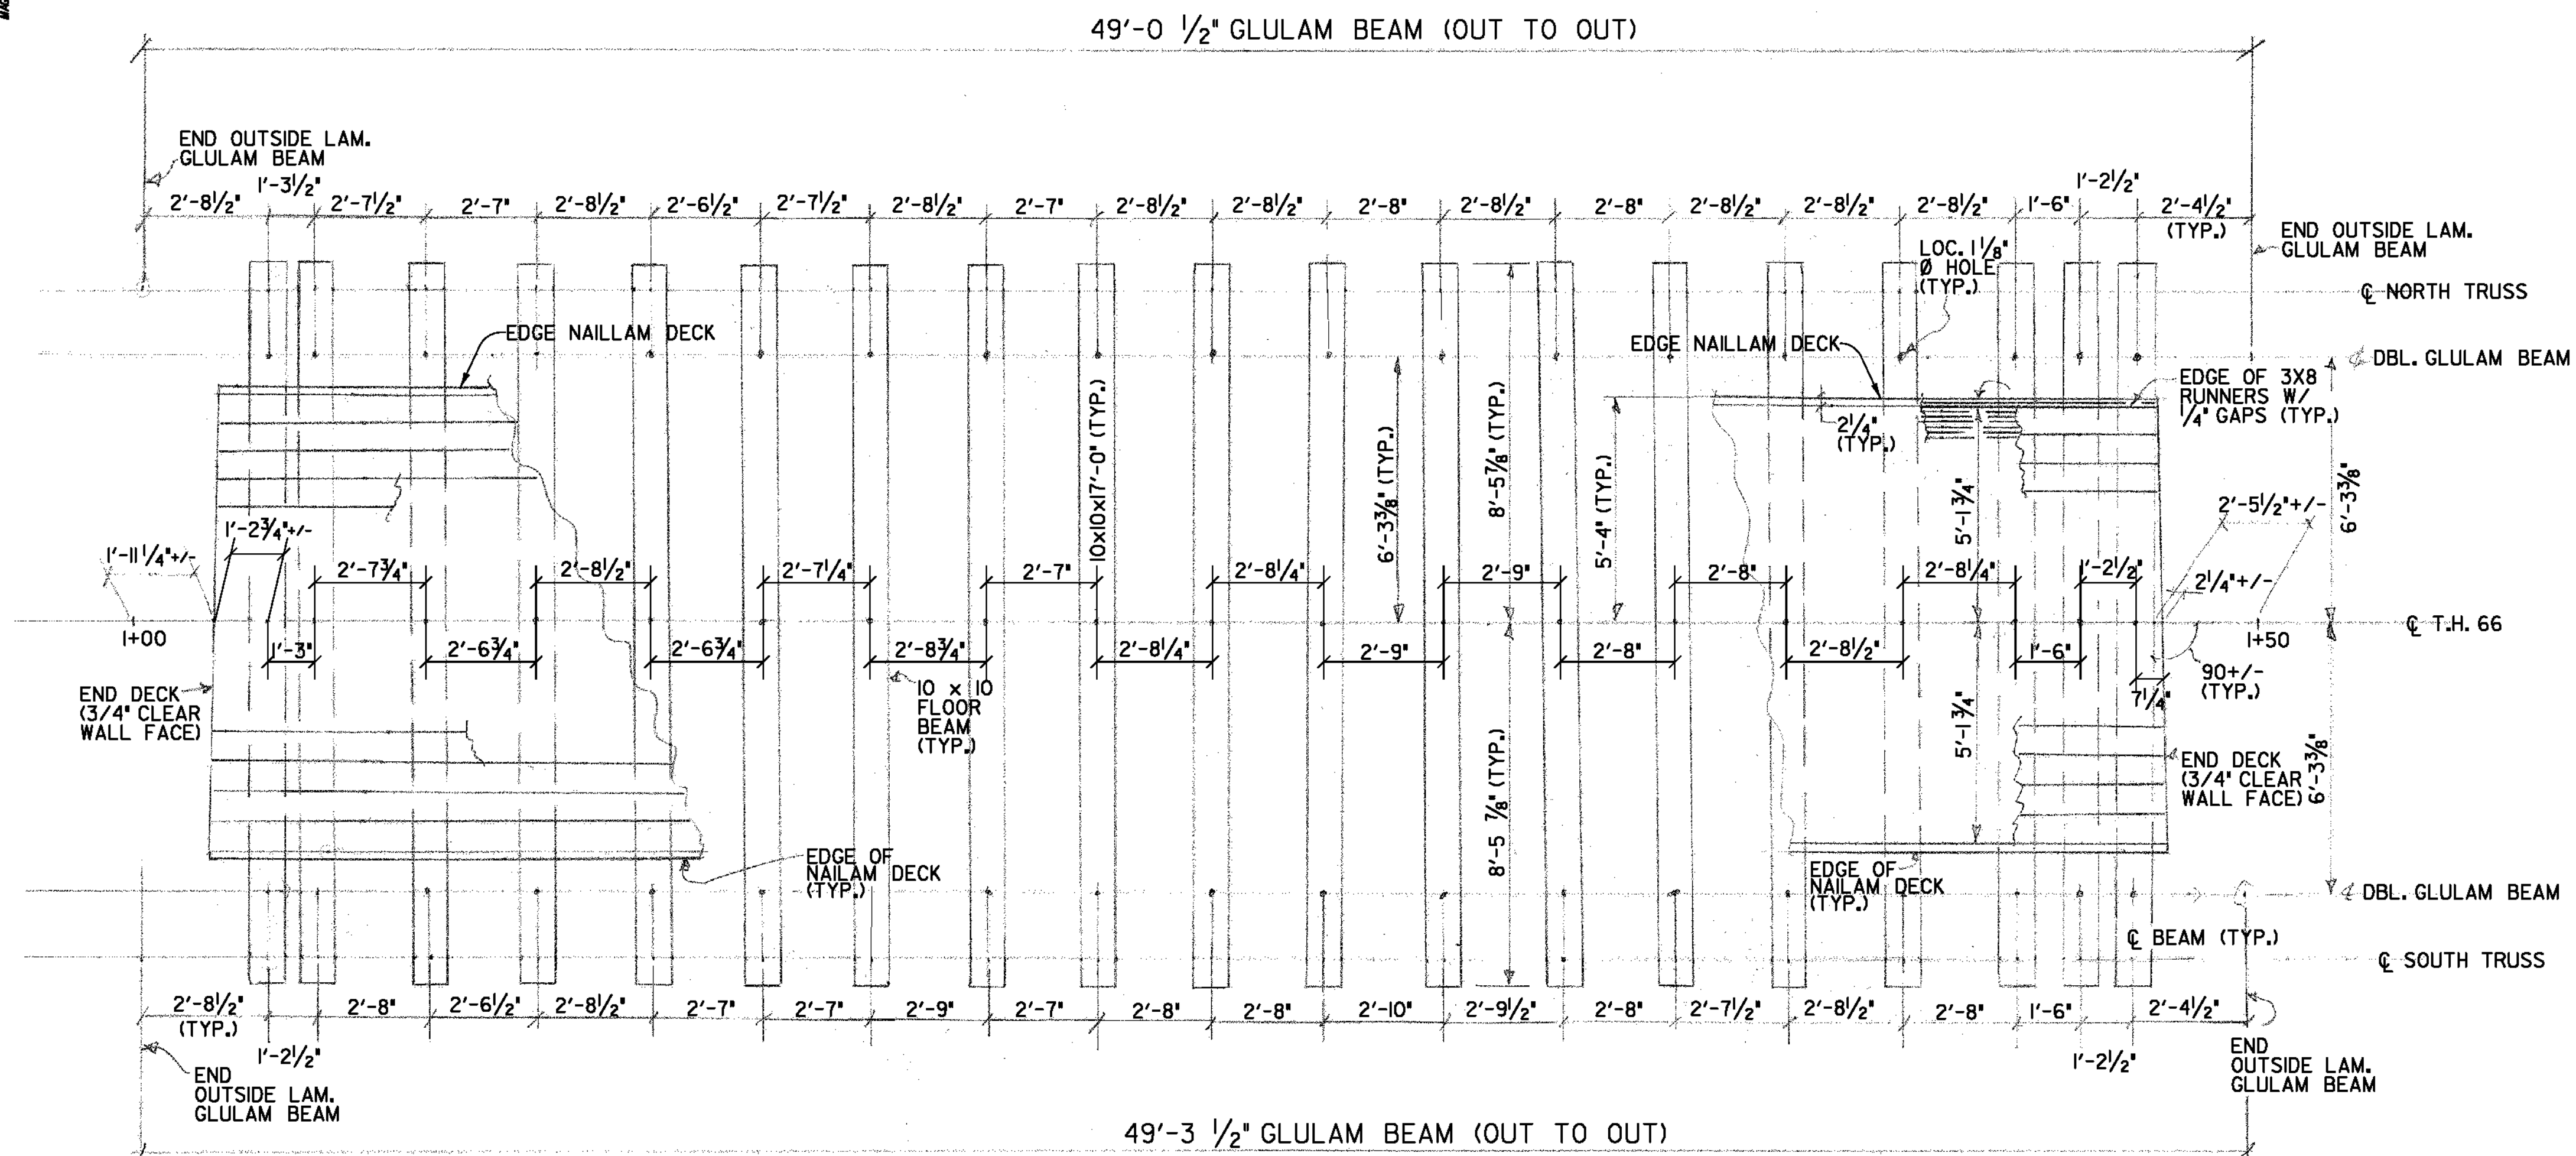

**DECK AND FLOOR FRAMING**  
3/8" = 1'-0"

PROJECT NAME: RANDOLPH	PLOT DATE: 09-NOV-2010
PROJECT NUMBER: BHO 1444(53)	DRAWN BY: C Weeber
FILE NAME: RandolphDetails.dgn	DESIGNED BY: J. Weaver
PROJECT LEADER: M. Sargent	CHECKED BY: M. Sargent
Deck & Floor Framing Details	SHEET 15 OF 27