
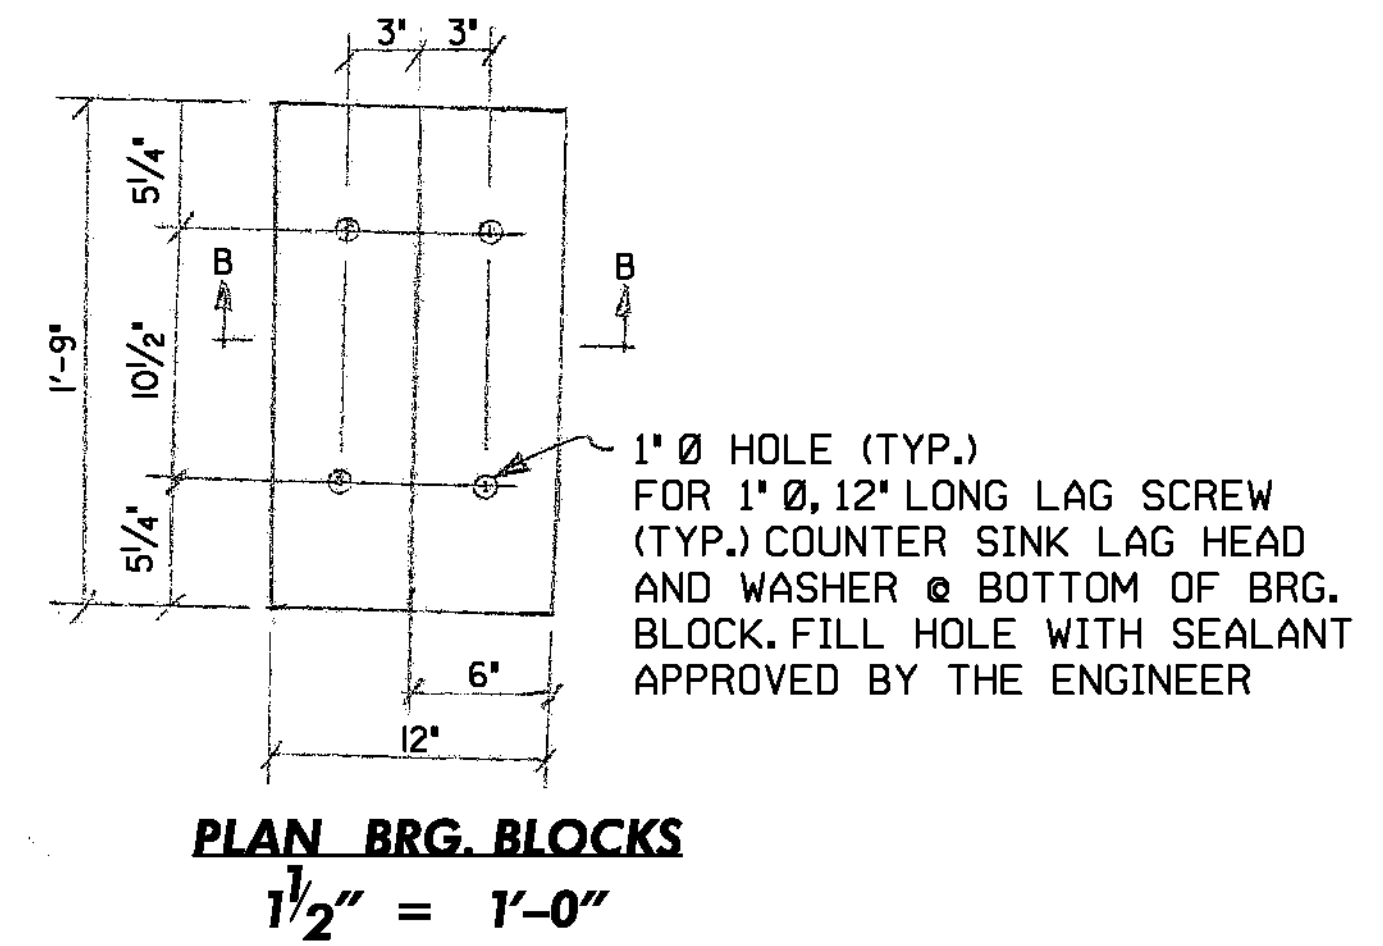
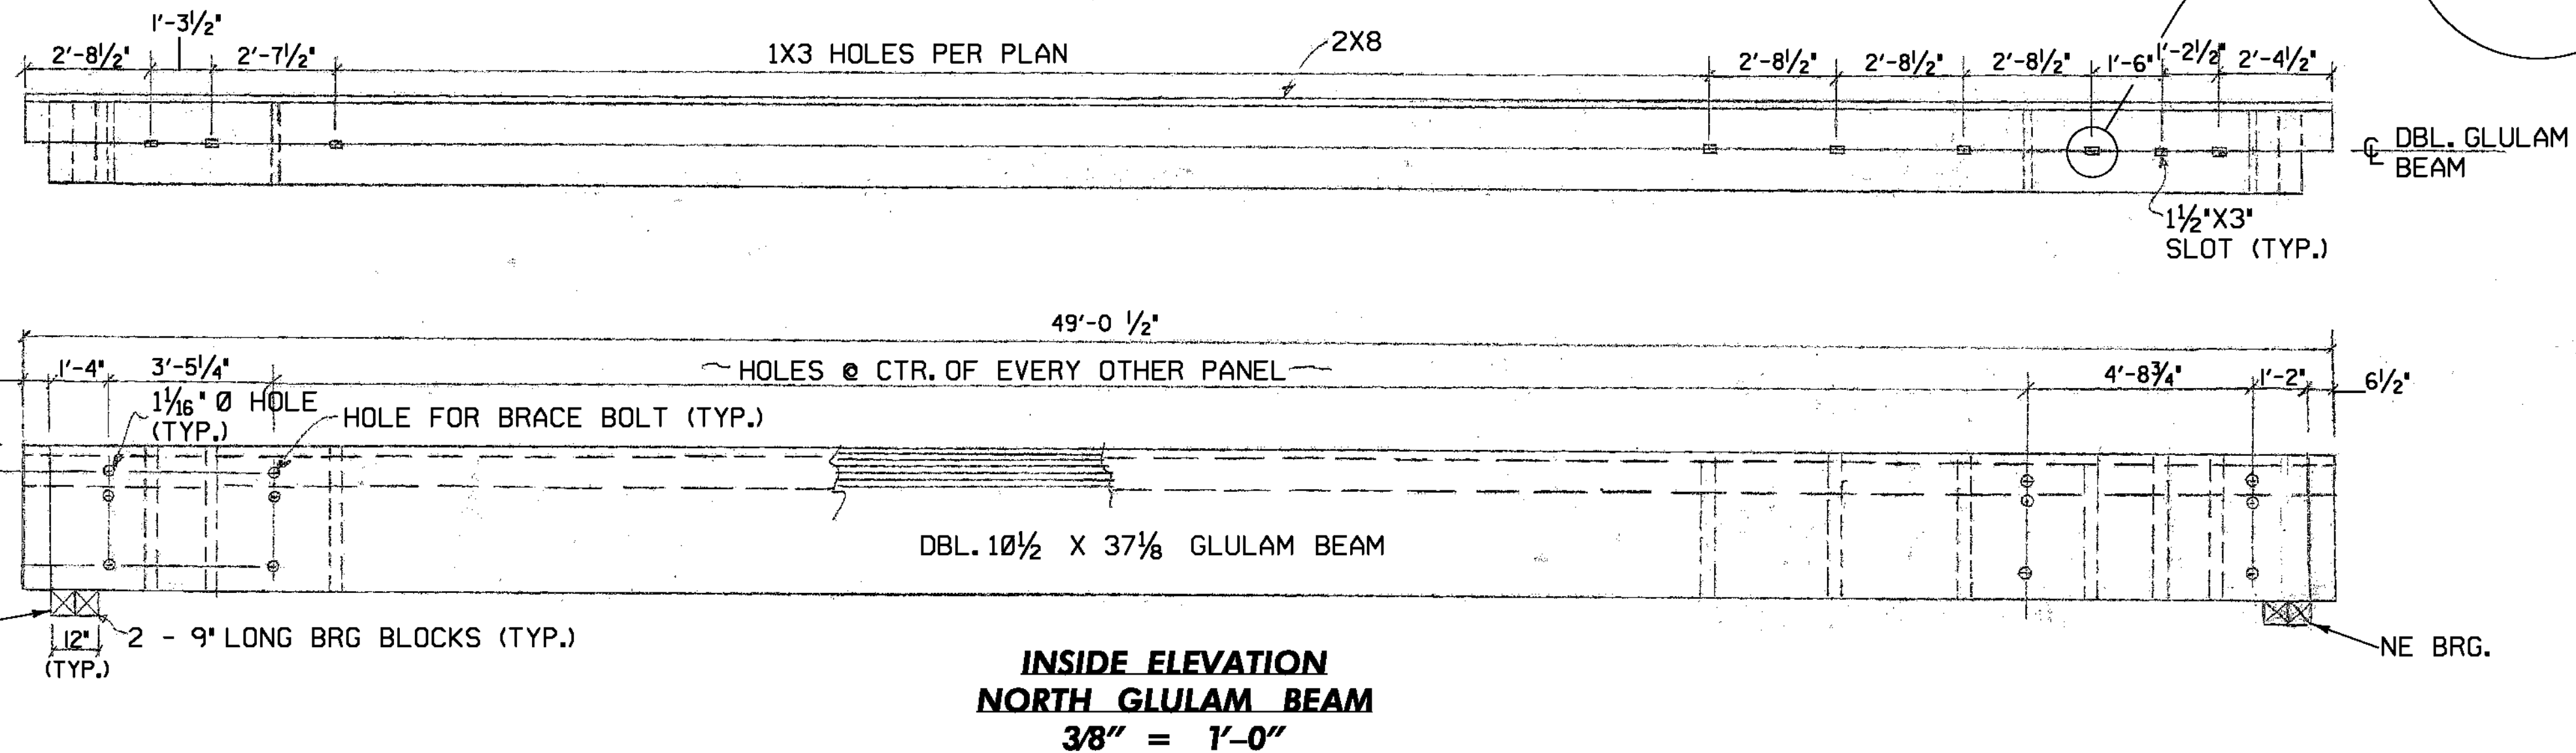


- NOTE:
1. FABRICATE GLULAM BEAMS WITH 2 1/2" POSITIVE CAMBER AT MIDPOINT OF SPAN.
 2. FOR OTHER BEARING DETAILS, SEE SHEET 18 OF 27.
 3. ALL MEMBERS AND COMPONENTS SHOWN ON THIS SHEET ARE NEW

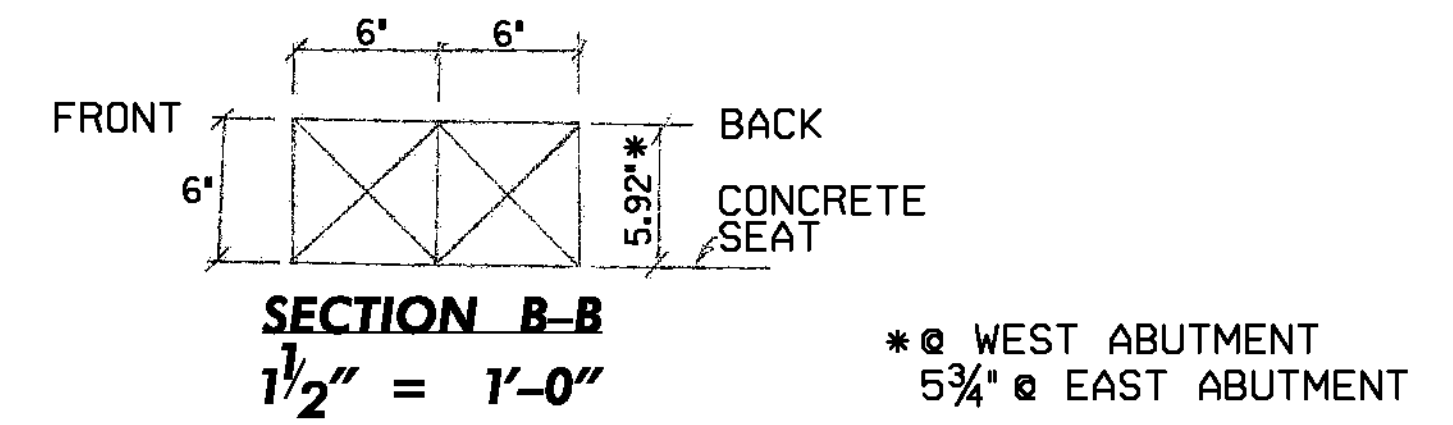

PROJECT NAME:	RANDOLPH
PROJECT NUMBER:	BHO 1444(53)
FILE NAME:	RandolphDetails.dgn
PROJECT LEADER:	M. Sargent
DESIGNED BY:	J. Weaver
Glulam Beam Details	
PLOT DATE:	09-NOV-2010
DRAWN BY:	C. Weeber
CHECKED BY:	M. Sargent
SHEET 17	OF 27