




PLAN EAST ABUTMENT
1/2" = 1'-0"

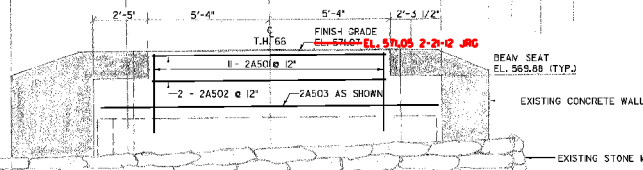

ELEVATION EAST ABUTMENT
1/2" = 1'-0"

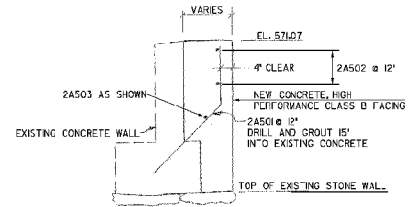

TYPICAL SECTION @ EAST ABUTMENT
3/4" = 1'-0"

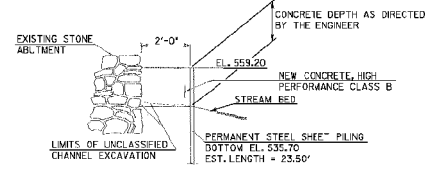

TYPICAL SECTION SHEET PILING SUPPORT (EAST ABUTMENT)
NTS

TOP OF SHEETING
EL. 660.00
EL. 561.23 2-21-12 JRG

PROJECT NAME	RANDOLPH	PLOT DATE	09-NOV-2010
PROJECT NUMBER	B1-0 (444)53	DRAWN BY	C. Heeber
FILE NAME	RandolphDetail.dgn	DESIGNED BY	J. Neever
		CHECKED BY	M. Sargent
		SHEET	21 OF 27