




1+25

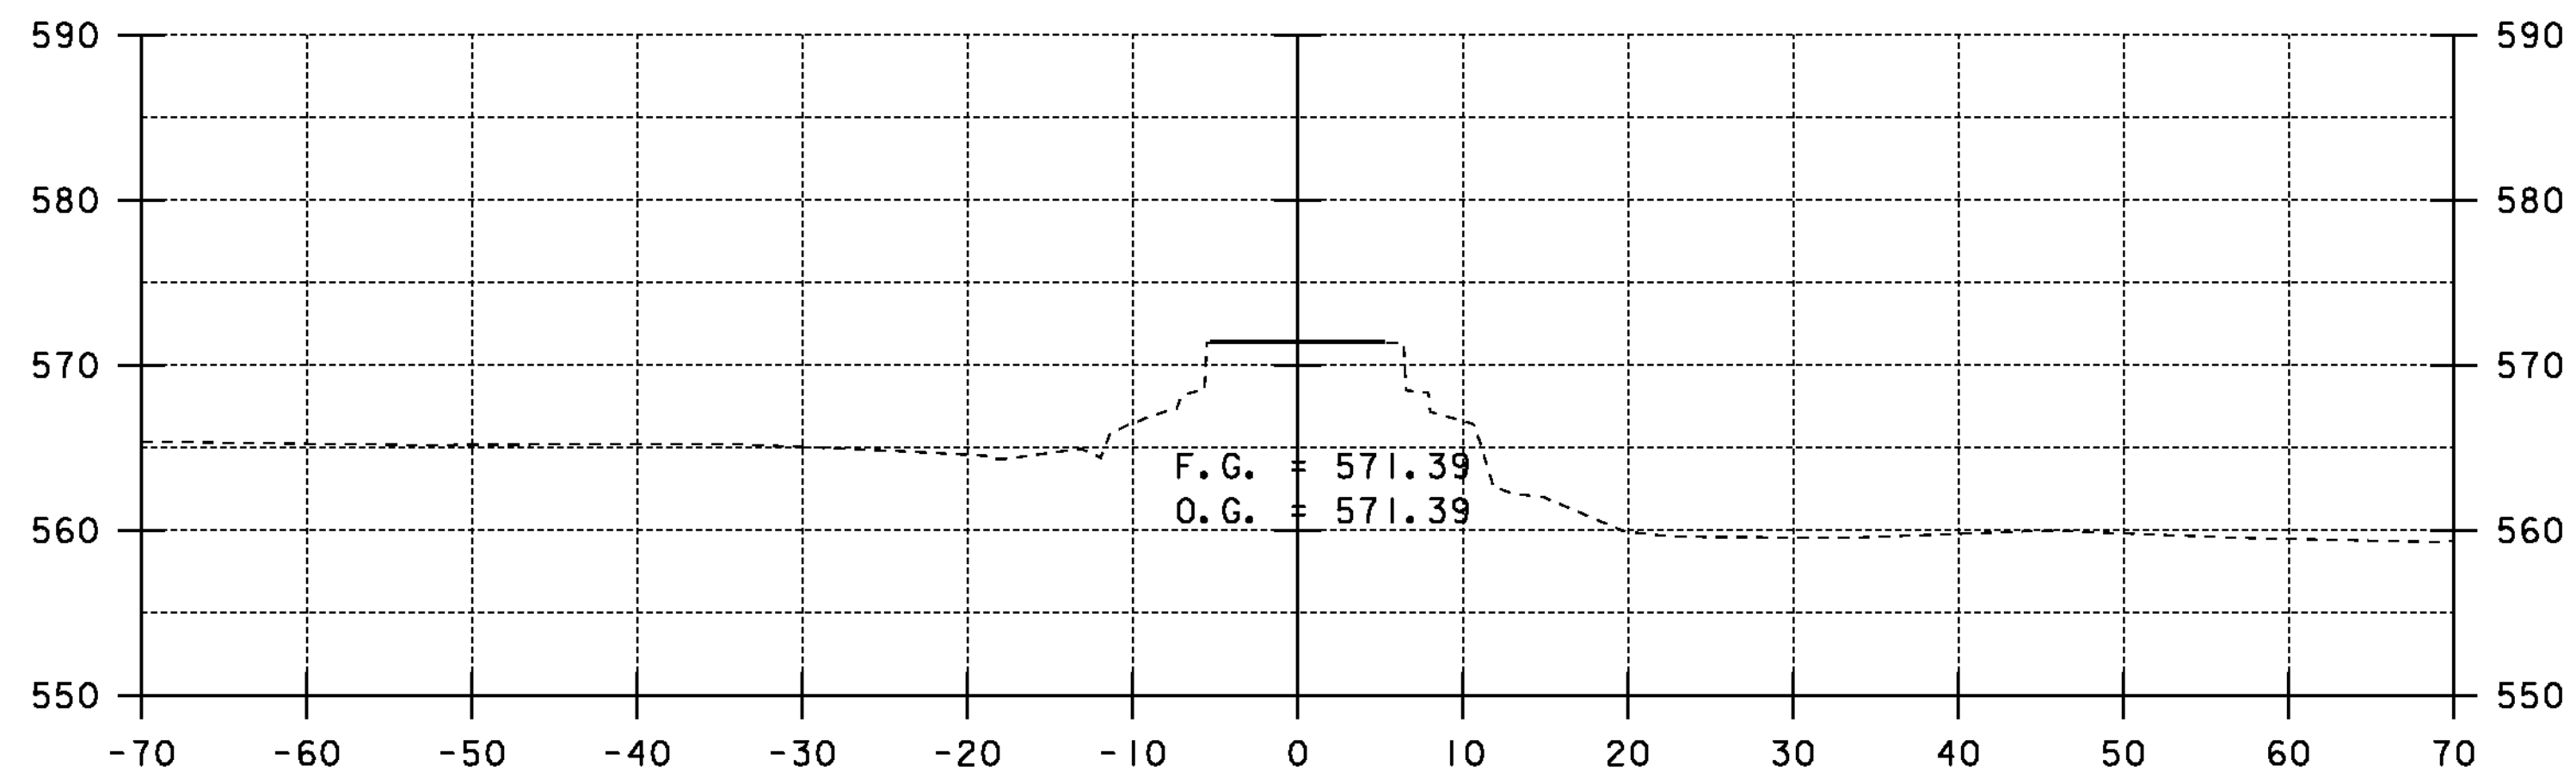


1+00  
BEGIN PROJECT  
BEGIN BRIDGE

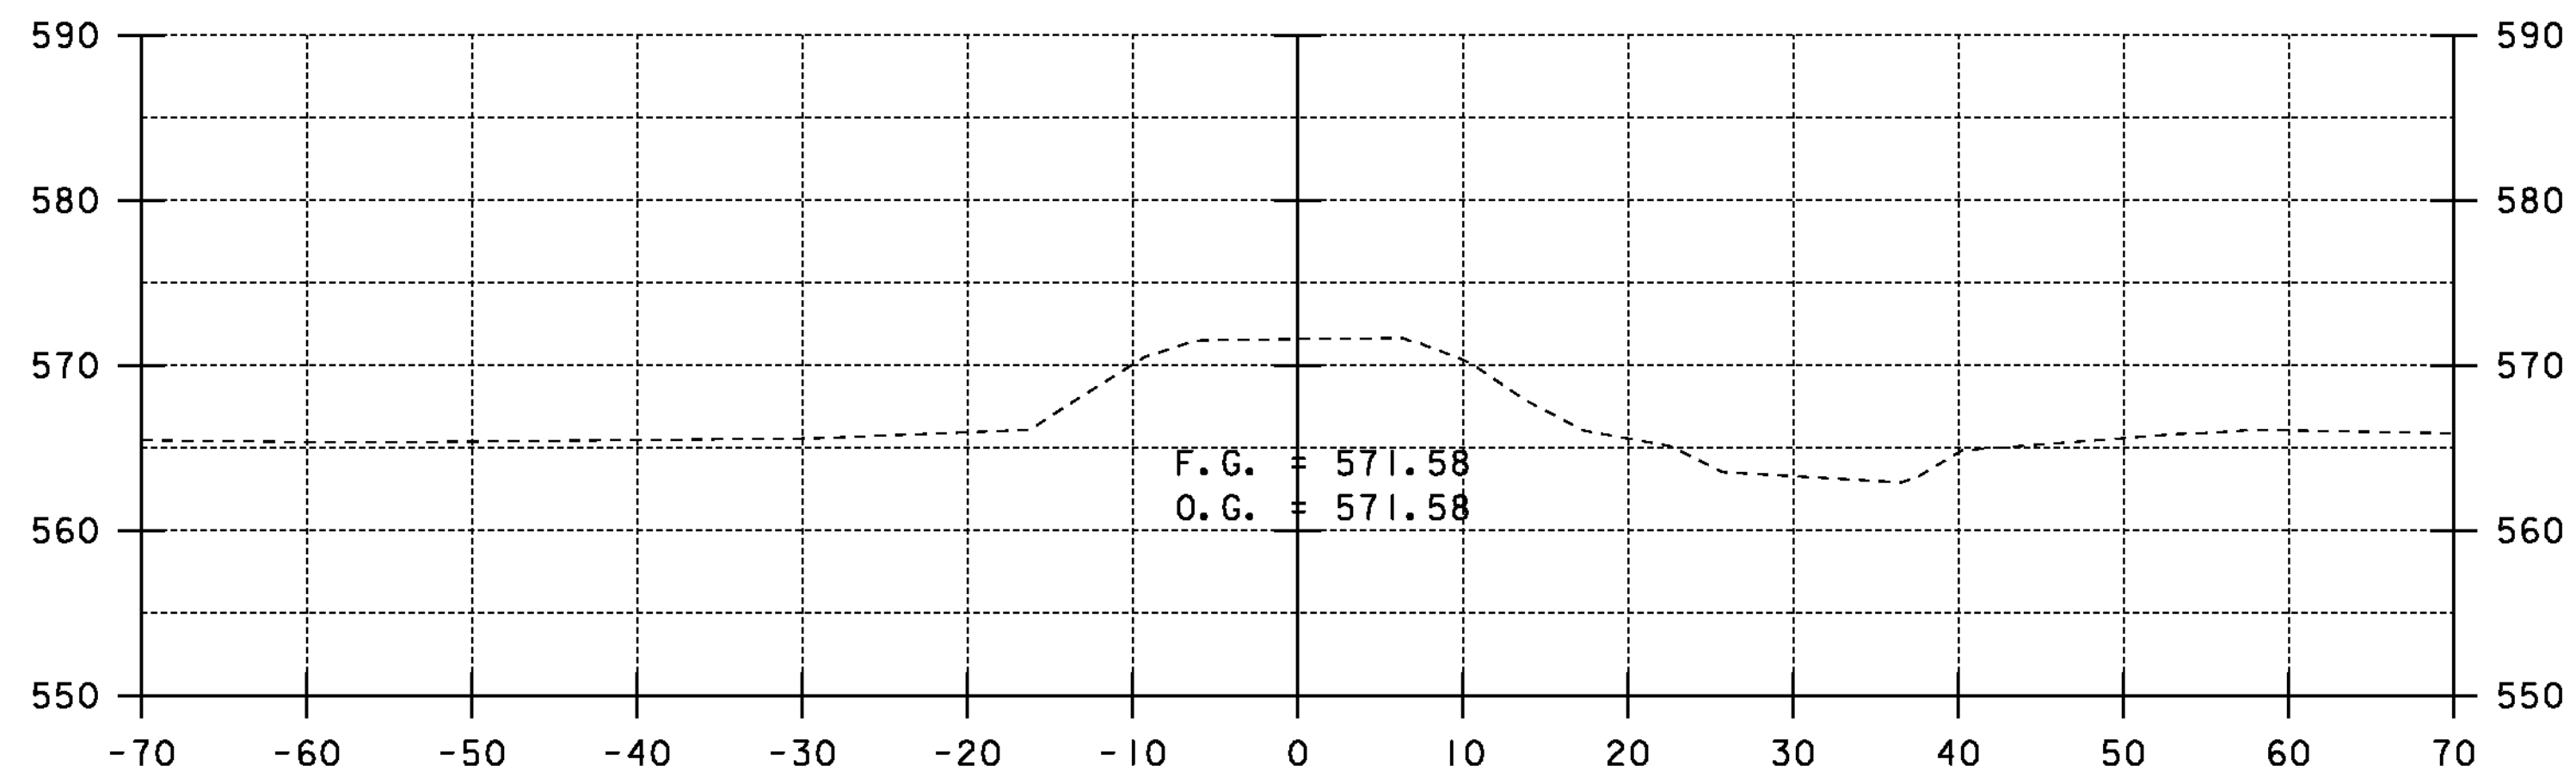

0+75

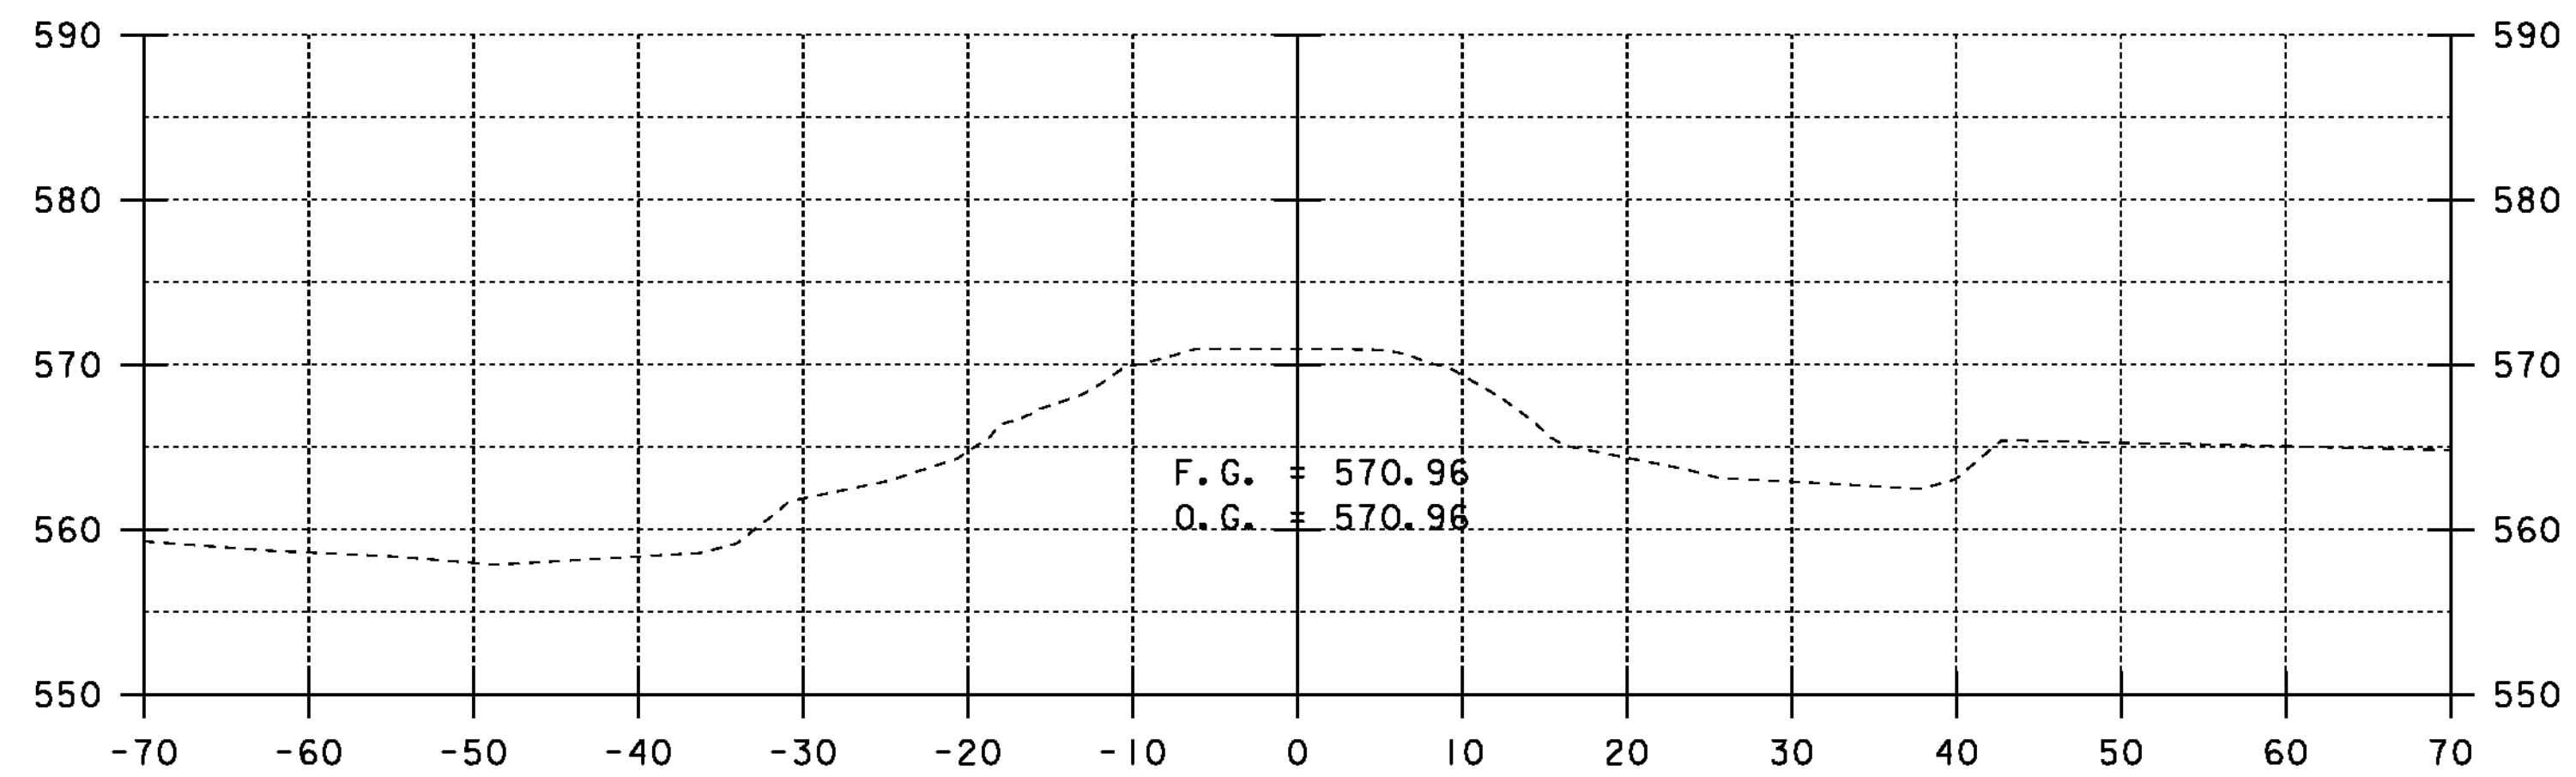

1+60

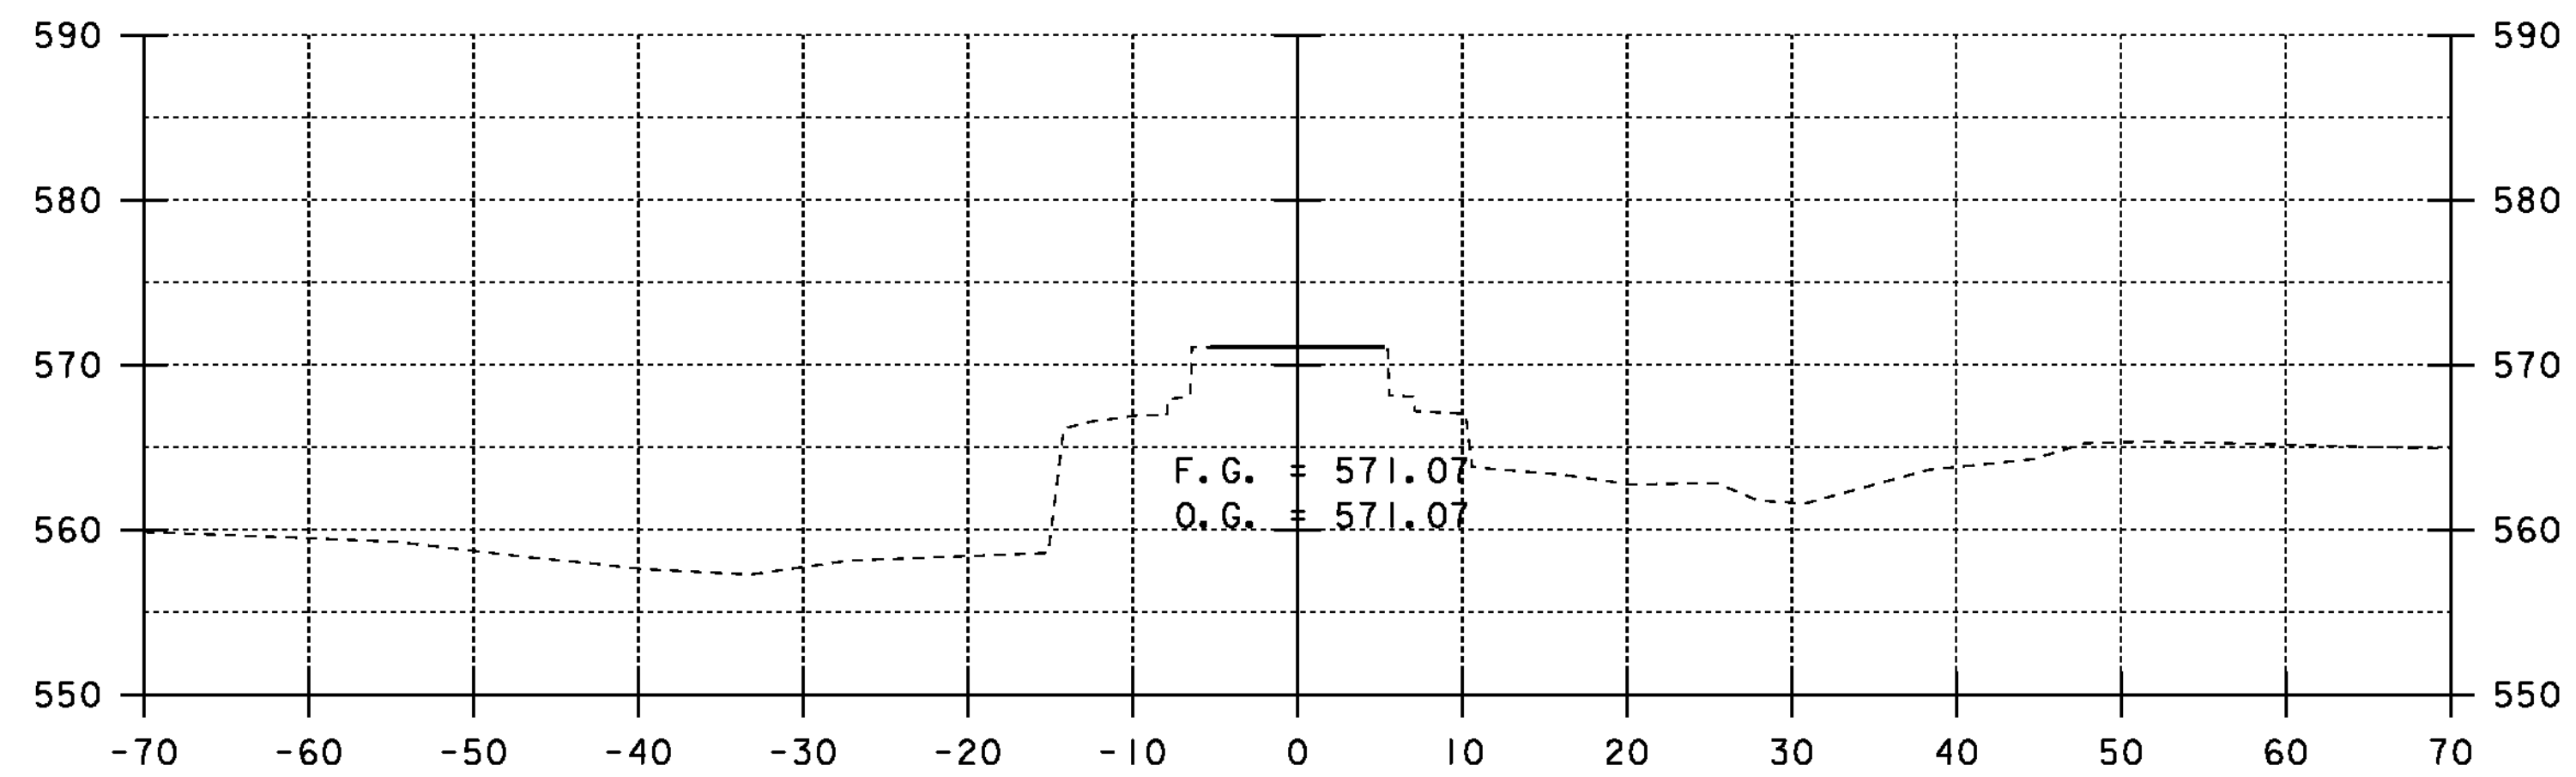

1+50  
END PROJECT / END BRIDGE

SCALE 1" = 10'-0"  
10 0 10

STA. 0+75 TO STA. 1+60

PROJECT NAME: RANDOLPH	PLOT DATE: 09-NOV-2010
PROJECT NUMBER: BHO 1444(53)	DRAWN BY: C. WEEBER
FILE NAME: s06J092xs.dgn	CHECKED BY: M. SARGENT
PROJECT LEADER: M. SARGENT	SHEET 27 OF 27
DESIGNED BY: J. WEAVER	
ROADWAY CROSS SECTIONS	