


REMOVE SIGNS
AS SHOWN -14
15

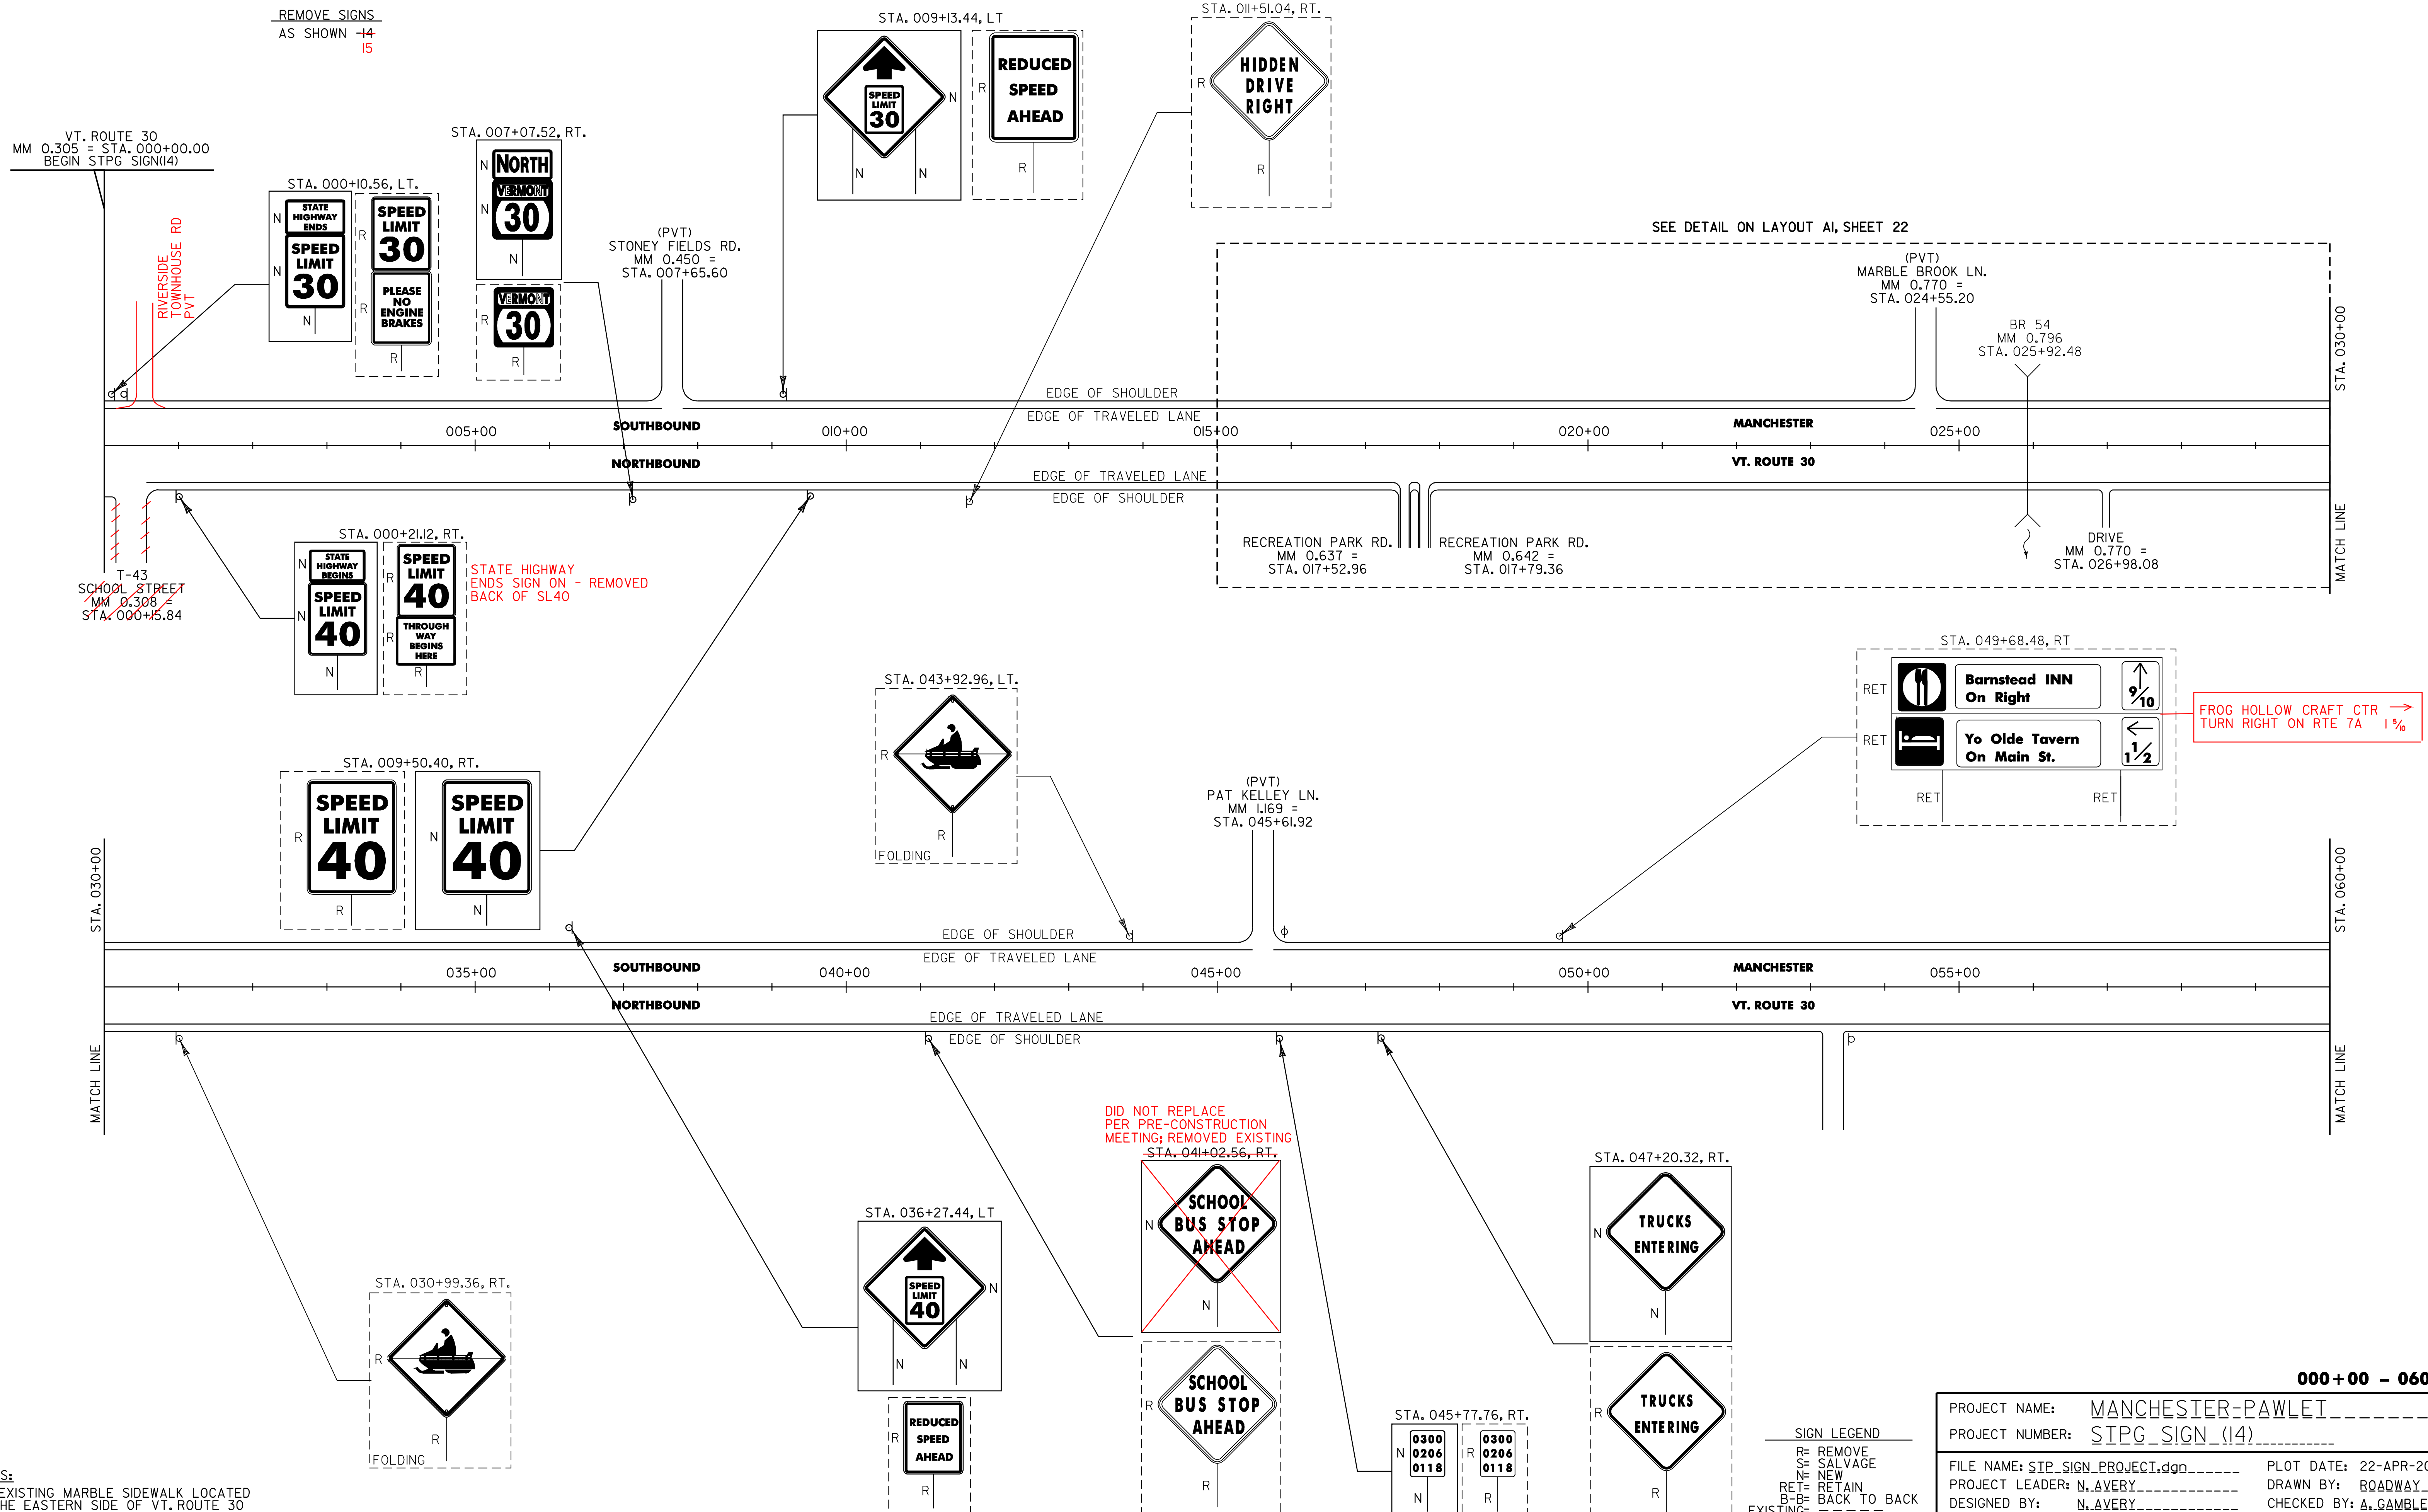

NOTES:
THE EXISTING MARBLE SIDEWALK LOCATED ON THE EASTERN SIDE OF VT. ROUTE 30 SHALL NOT BE DISTURBED.

SIGN LEGEND

- R= REMOVE
- S= SALVAGE
- N= NEW
- RET= RETAIN
- B-B= BACK TO BACK
- EXISTING=
- NEW=

000+00 - 060+00

PROJECT NAME: MANCHESTER-PAWLET	PLOT DATE: 22-APR-2009 16:48
PROJECT NUMBER: STPG_SIGN_(14)	DRAWN BY: ROADWAY
FILE NAME: STPG_SIGN_PROJECT.dwg	CHECKED BY: A. GAMBLE
PROJECT LEADER: N. AVERY	SHEET 4 OF 60
LAYOUT 1	