


REMOVE SIGNS
AS SHOWN ~~7~~
6

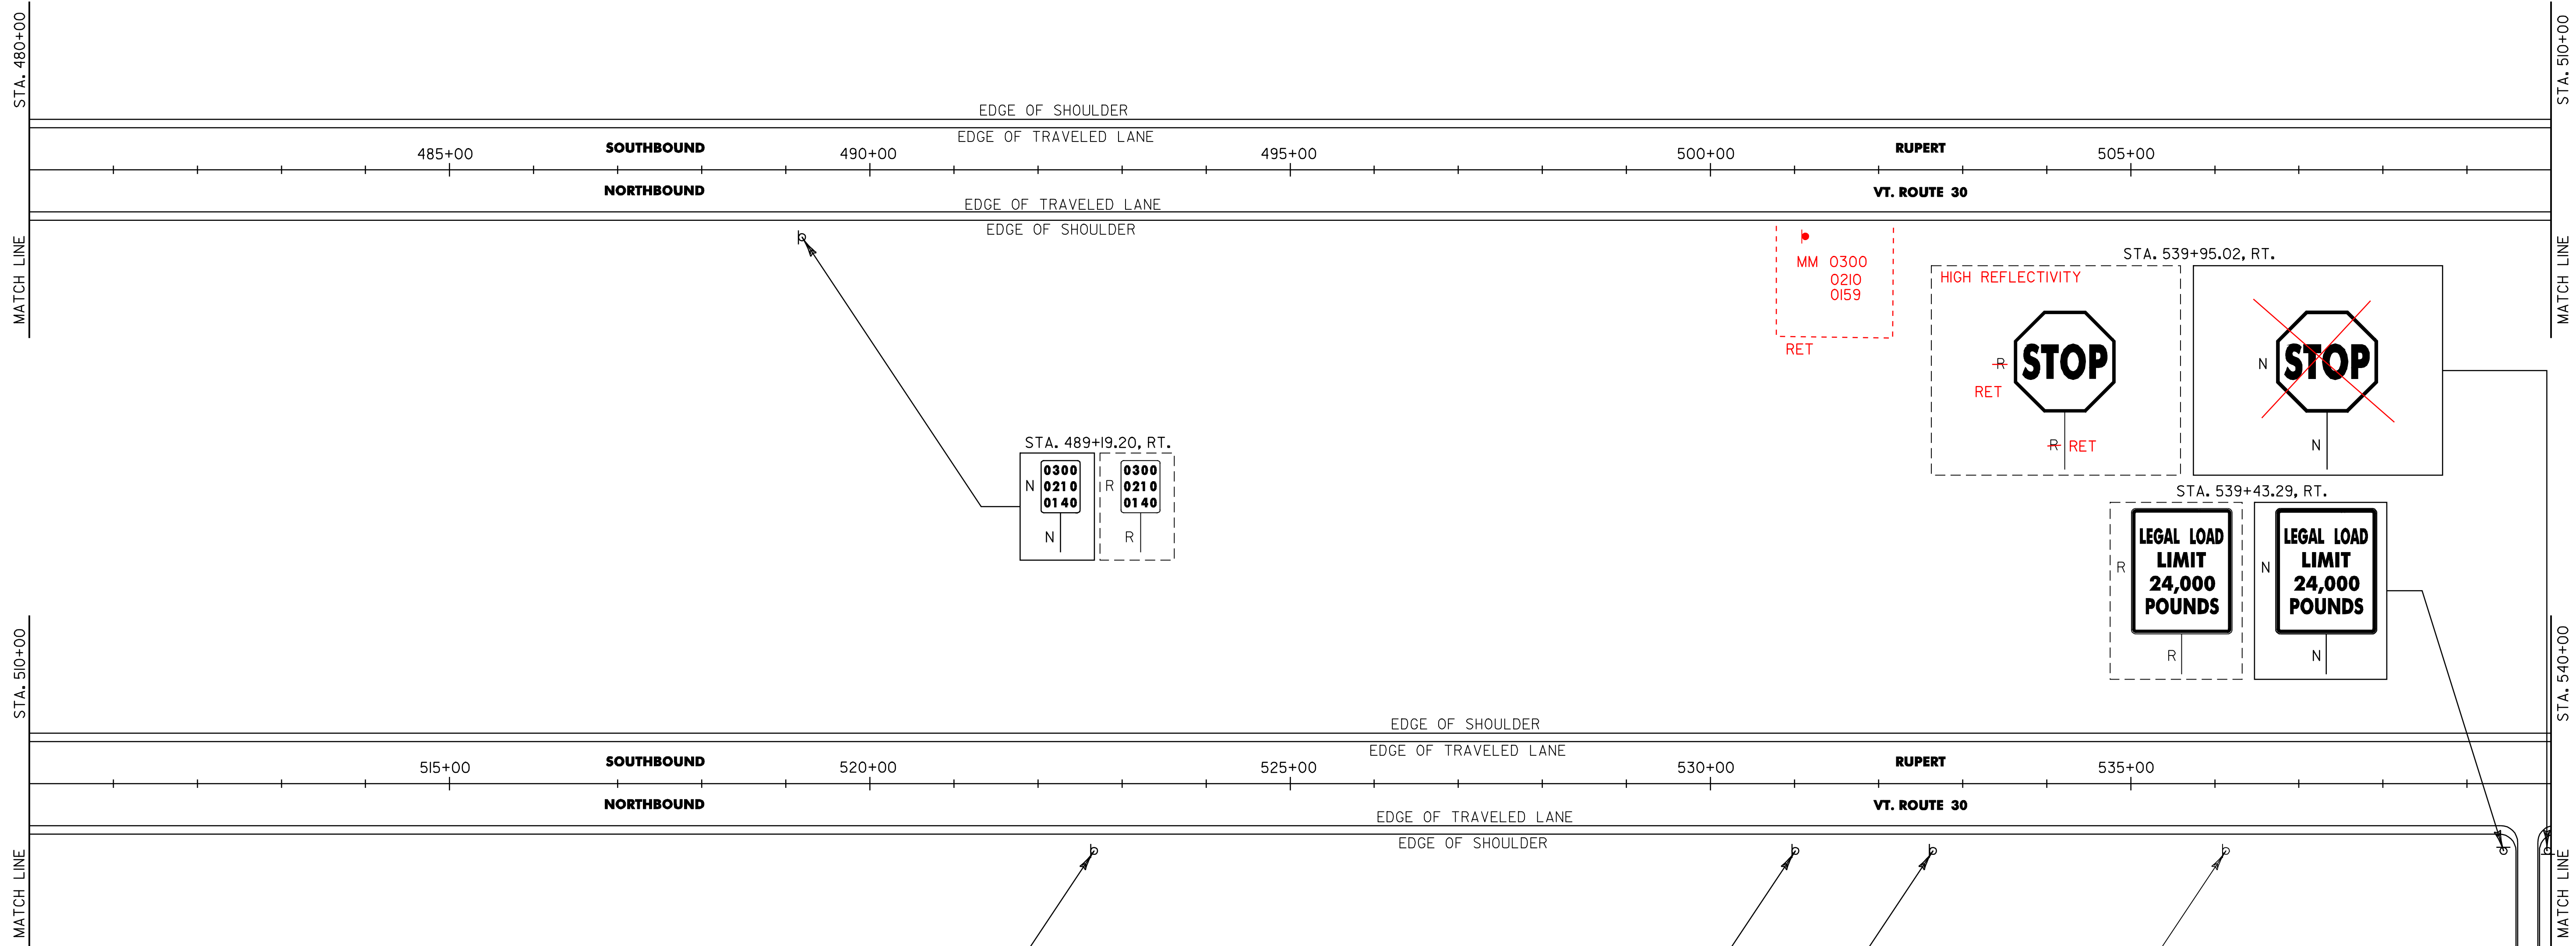

SIGN LEGEND
 R= REMOVE
 S= SALVAGE
 N= NEW
 RET= RETAIN
 B-B= BACK TO BACK
 EXISTING= _____
 NEW= _____

PROJECT NAME: MANCHESTER-PAWLET
 PROJECT NUMBER: STPG_SIGN (14)
 FILE NAME: STPG_SIGN_PROJECT.dgn
 PROJECT LEADER: N. AVERY
 DESIGNED BY: N. AVERY
 LAYOUT 9
 PLOT DATE: 22-APR-2009 16:54
 DRAWN BY: ROADWAY
 CHECKED BY: A. GAMBLE
 SHEET 12 OF 60

480+00 - 540+00