


REMOVE SIGNS
AS SHOWN -9-
II

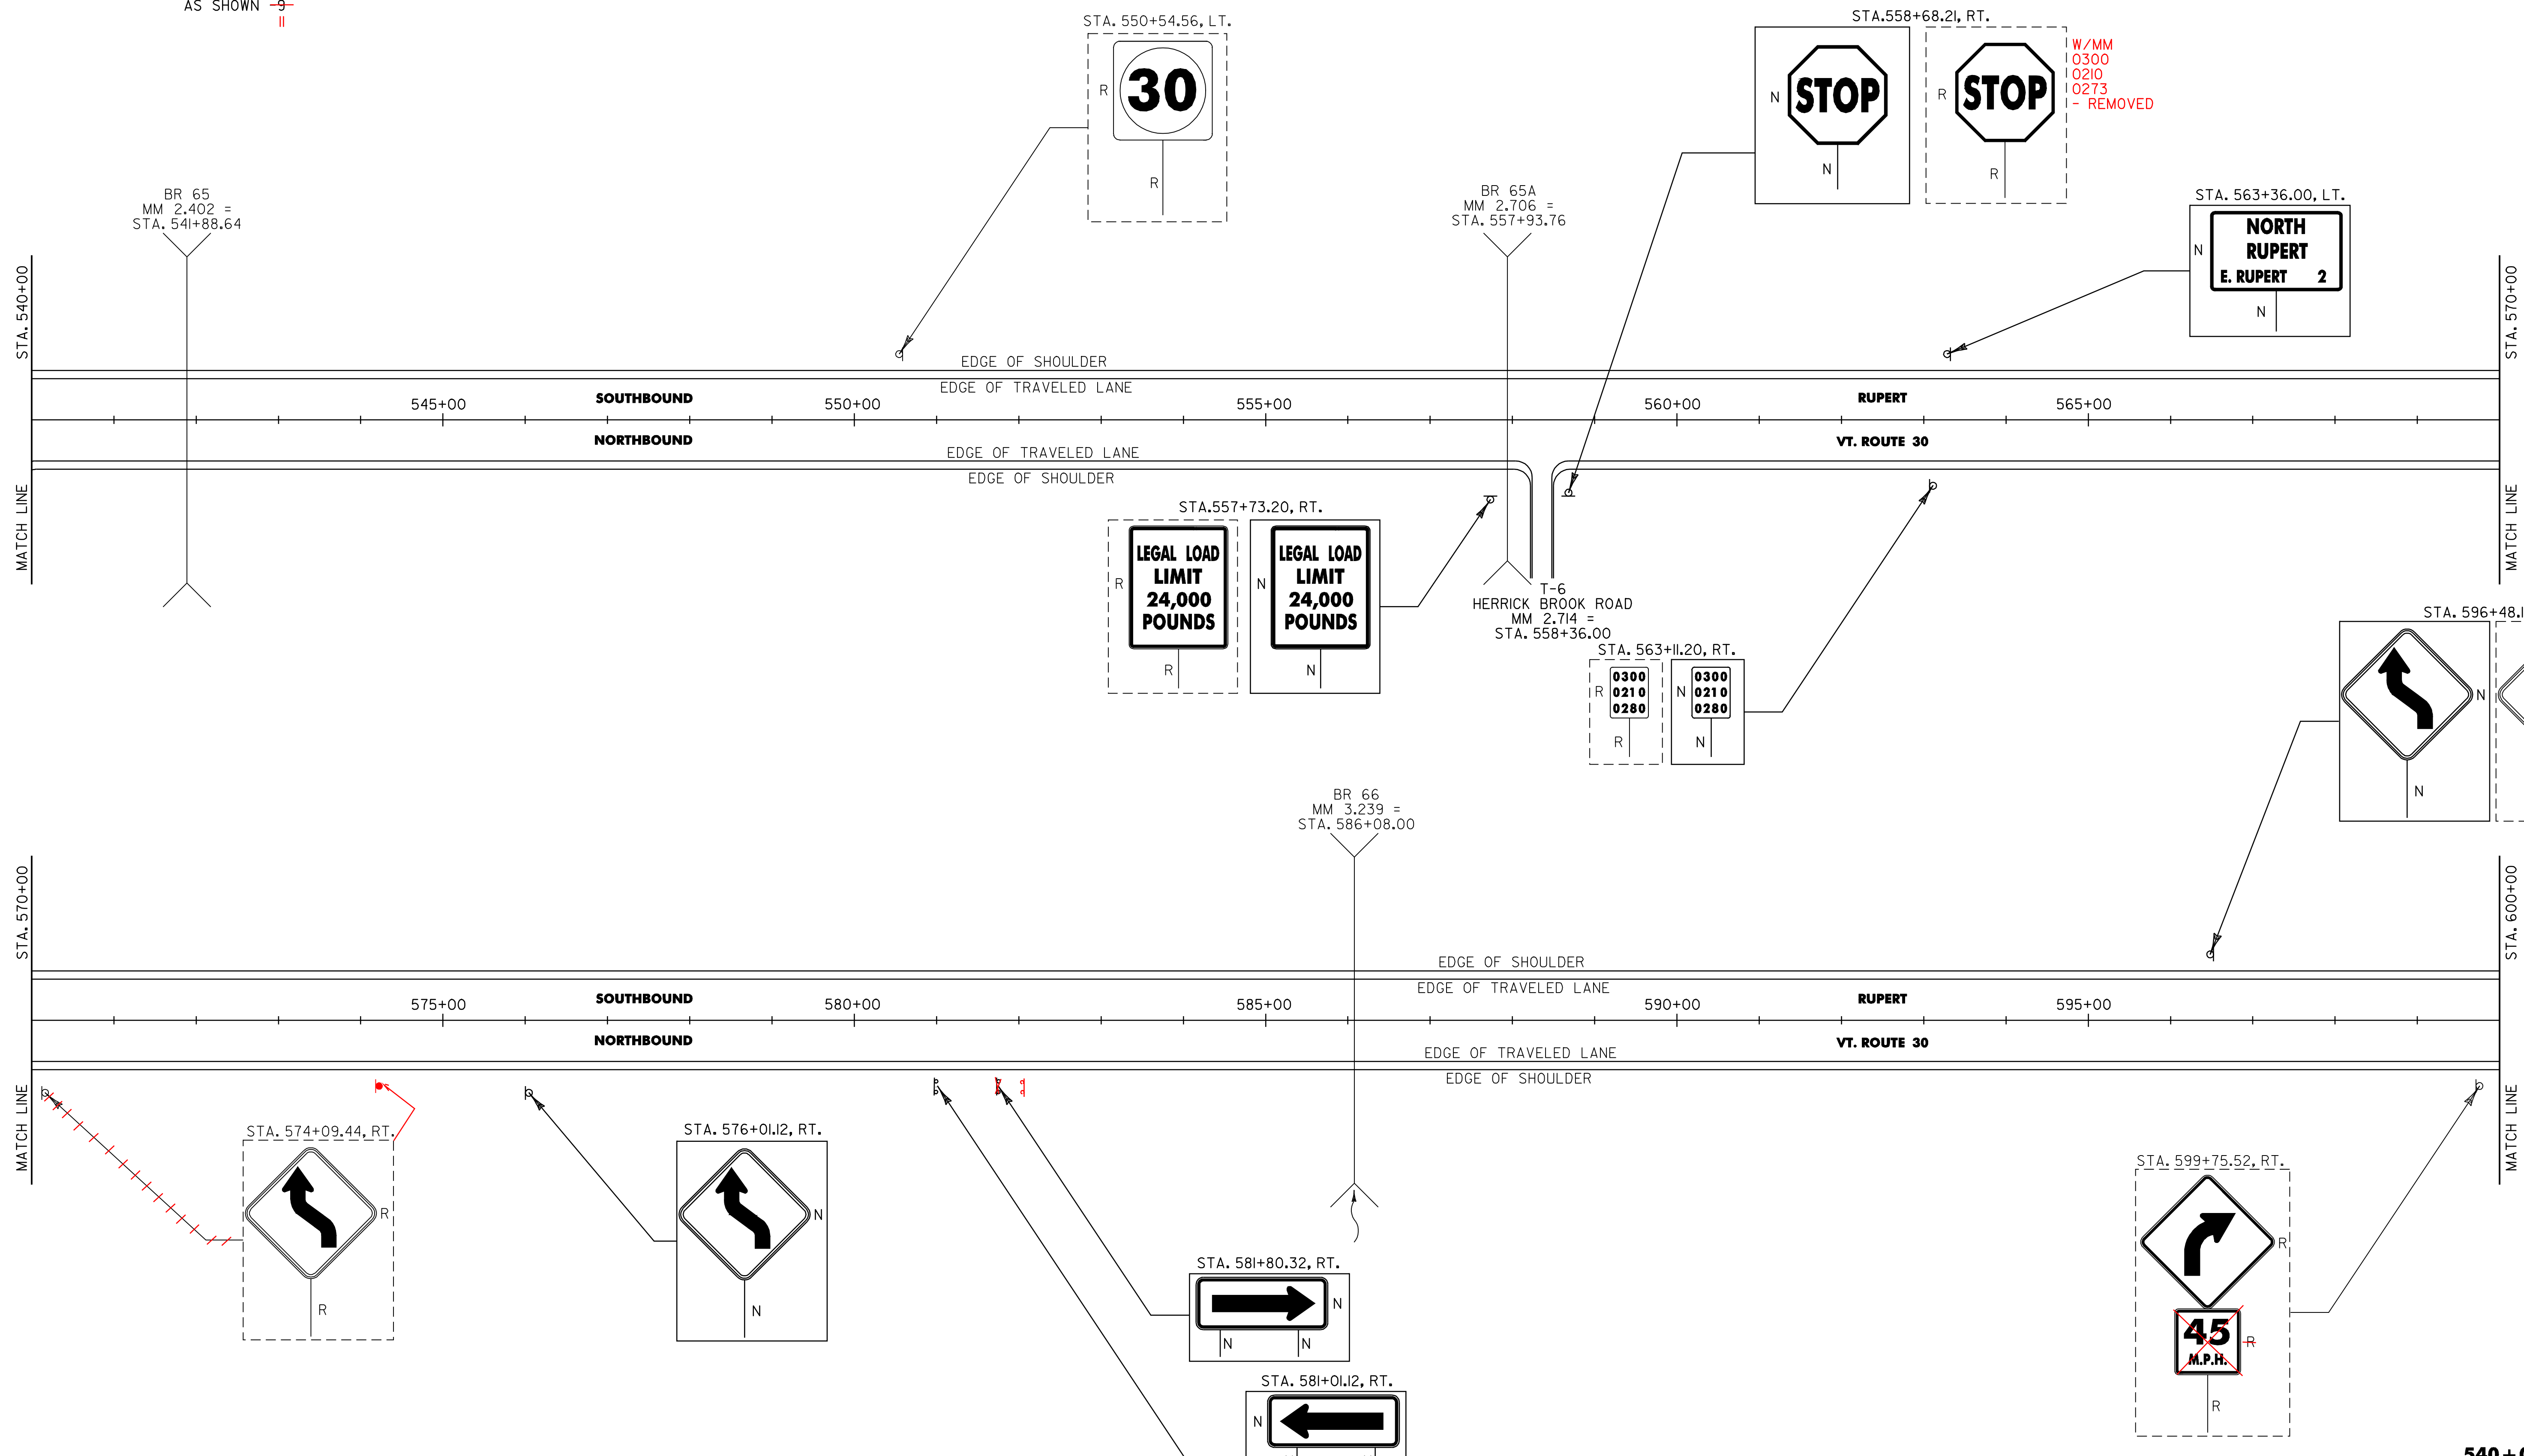

540+00 - 600+00

SIGN LEGEND
R= REMOVE
S= SALVAGE
N= NEW
RET= RETAIN
B-B= BACK TO BACK
EXISTING= _____
NEW= _____

PROJECT NAME: MANCHESTER-PAWLET
PROJECT NUMBER: STPG_SIGN (14)
FILE NAME: STPG_SIGN_PROJECT.dgn
PLOT DATE: 22-APR-2009 16:43
PROJECT LEADER: N. AVERY
DRAWN BY: ROADWAY
DESIGNED BY: N. AVERY
CHECKED BY: A. GAMBLE
LAYOUT_ID: _____
SHEET 13 OF 60