


REMOVE SIGNS
AS SHOWN -13
12

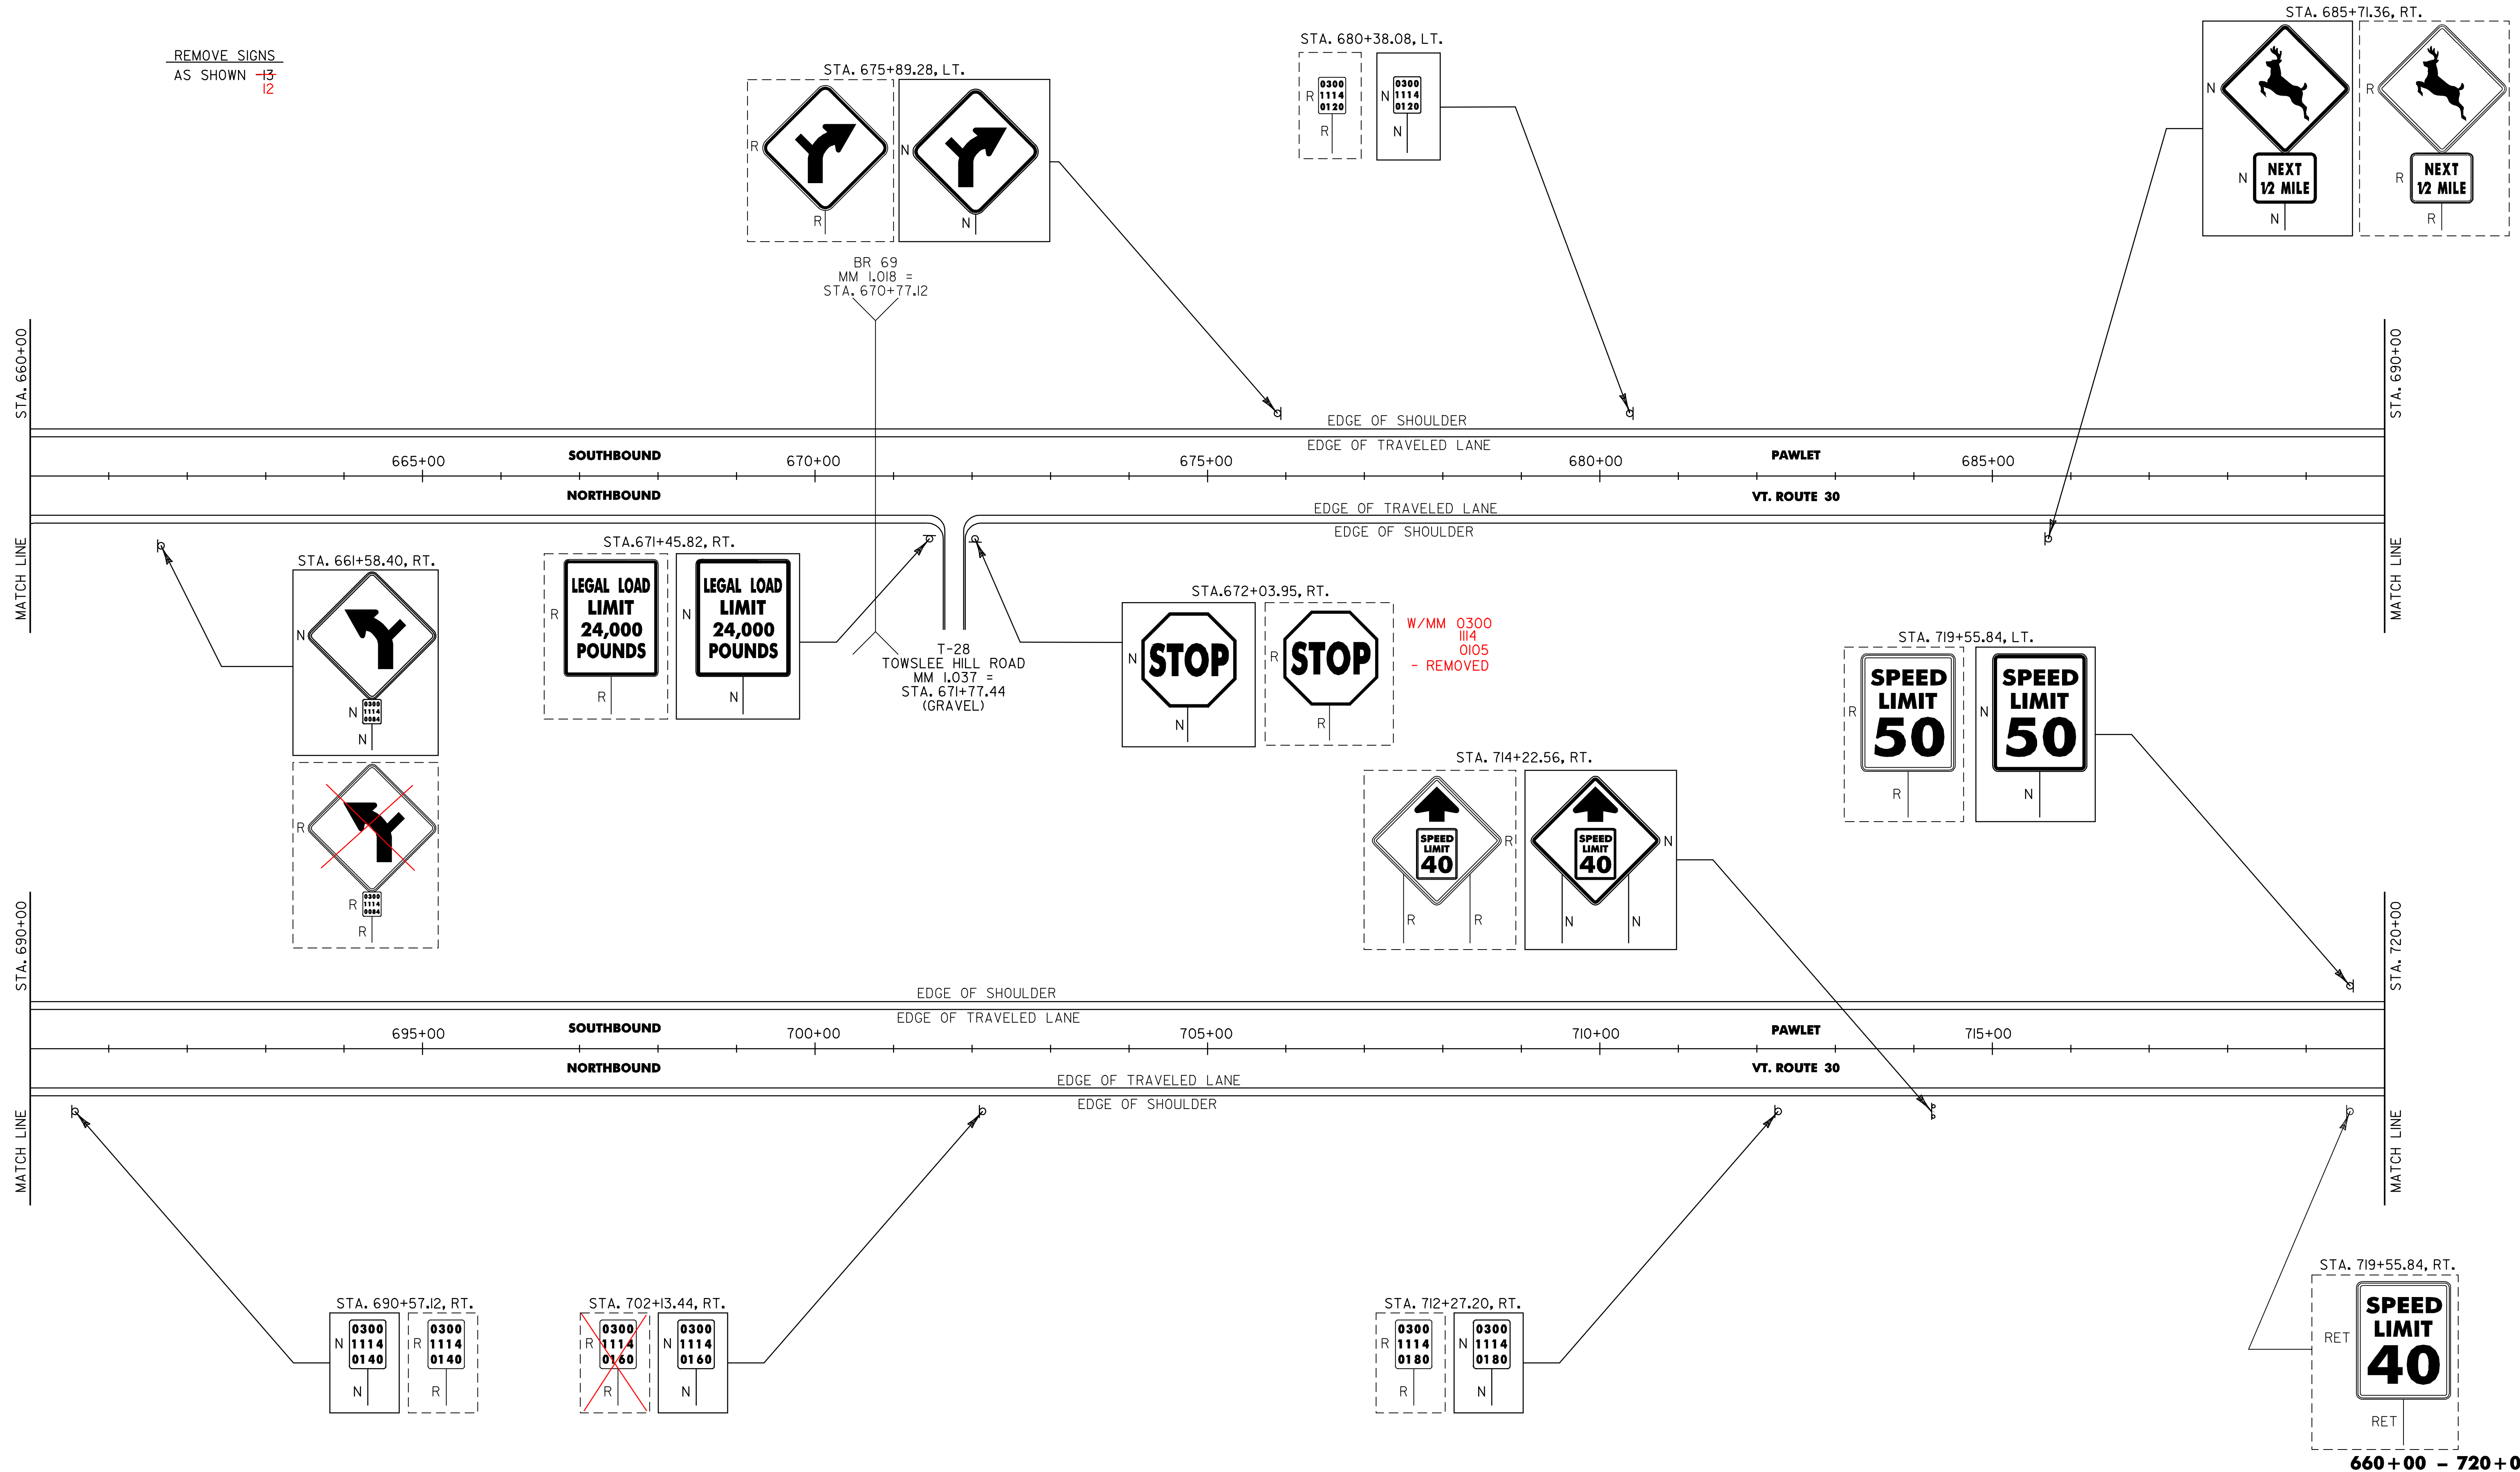

PROJECT NAME: MANCHESTER-PAWLET
PROJECT NUMBER: STPG_SIGN (14)
FILE NAME: STPG_SIGN_PROJECT.dgn
PLOT DATE: 22-APR-2009 16:44
PROJECT LEADER: N. AVERY
DRAWN BY: ROADWAY
DESIGNED BY: N. AVERY
CHECKED BY: A. GAMBLE
LAYOUT 12
SHEET 15 OF 60

660+00 - 720+00