
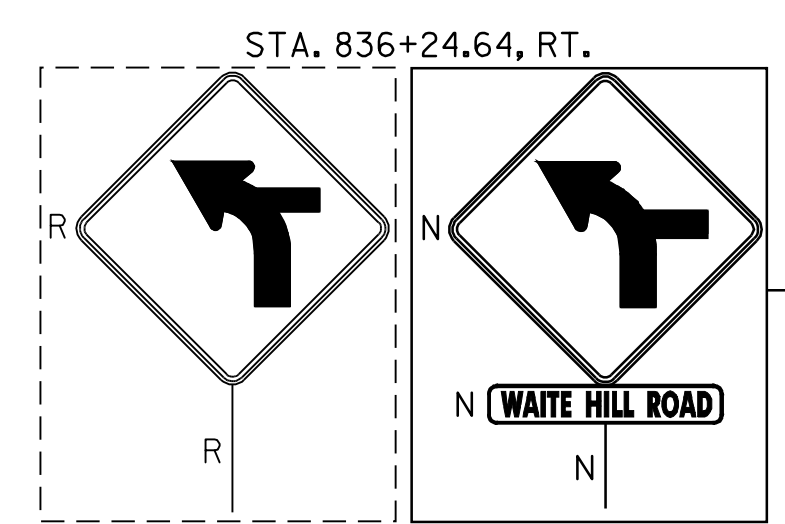
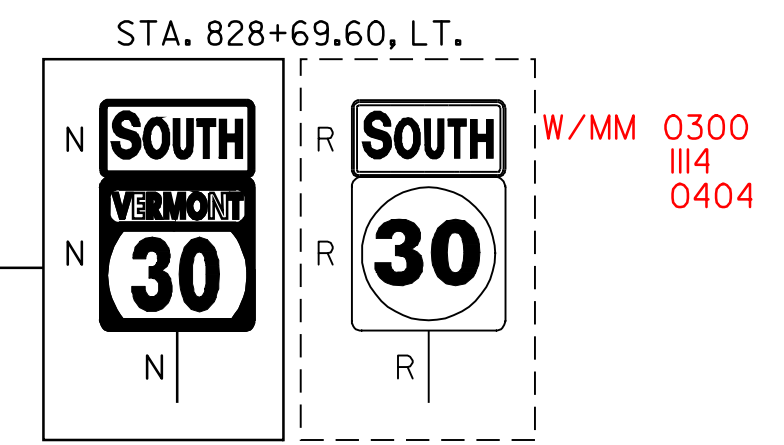
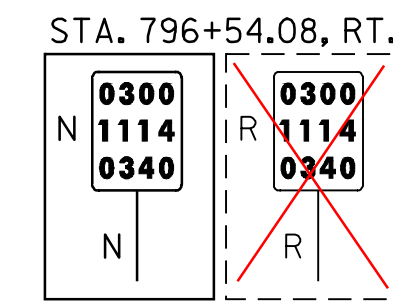


REMOVE SIGNS
AS SHOWN -4
5

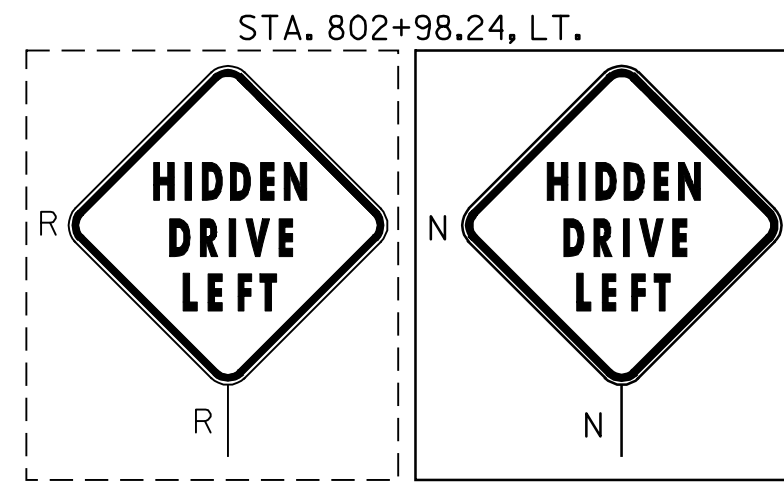


STA. 780+00
MATCH LINE

STA. 810+00
MATCH LINE

STA. 810+00
MATCH LINE

STA. 840+00
MATCH LINE

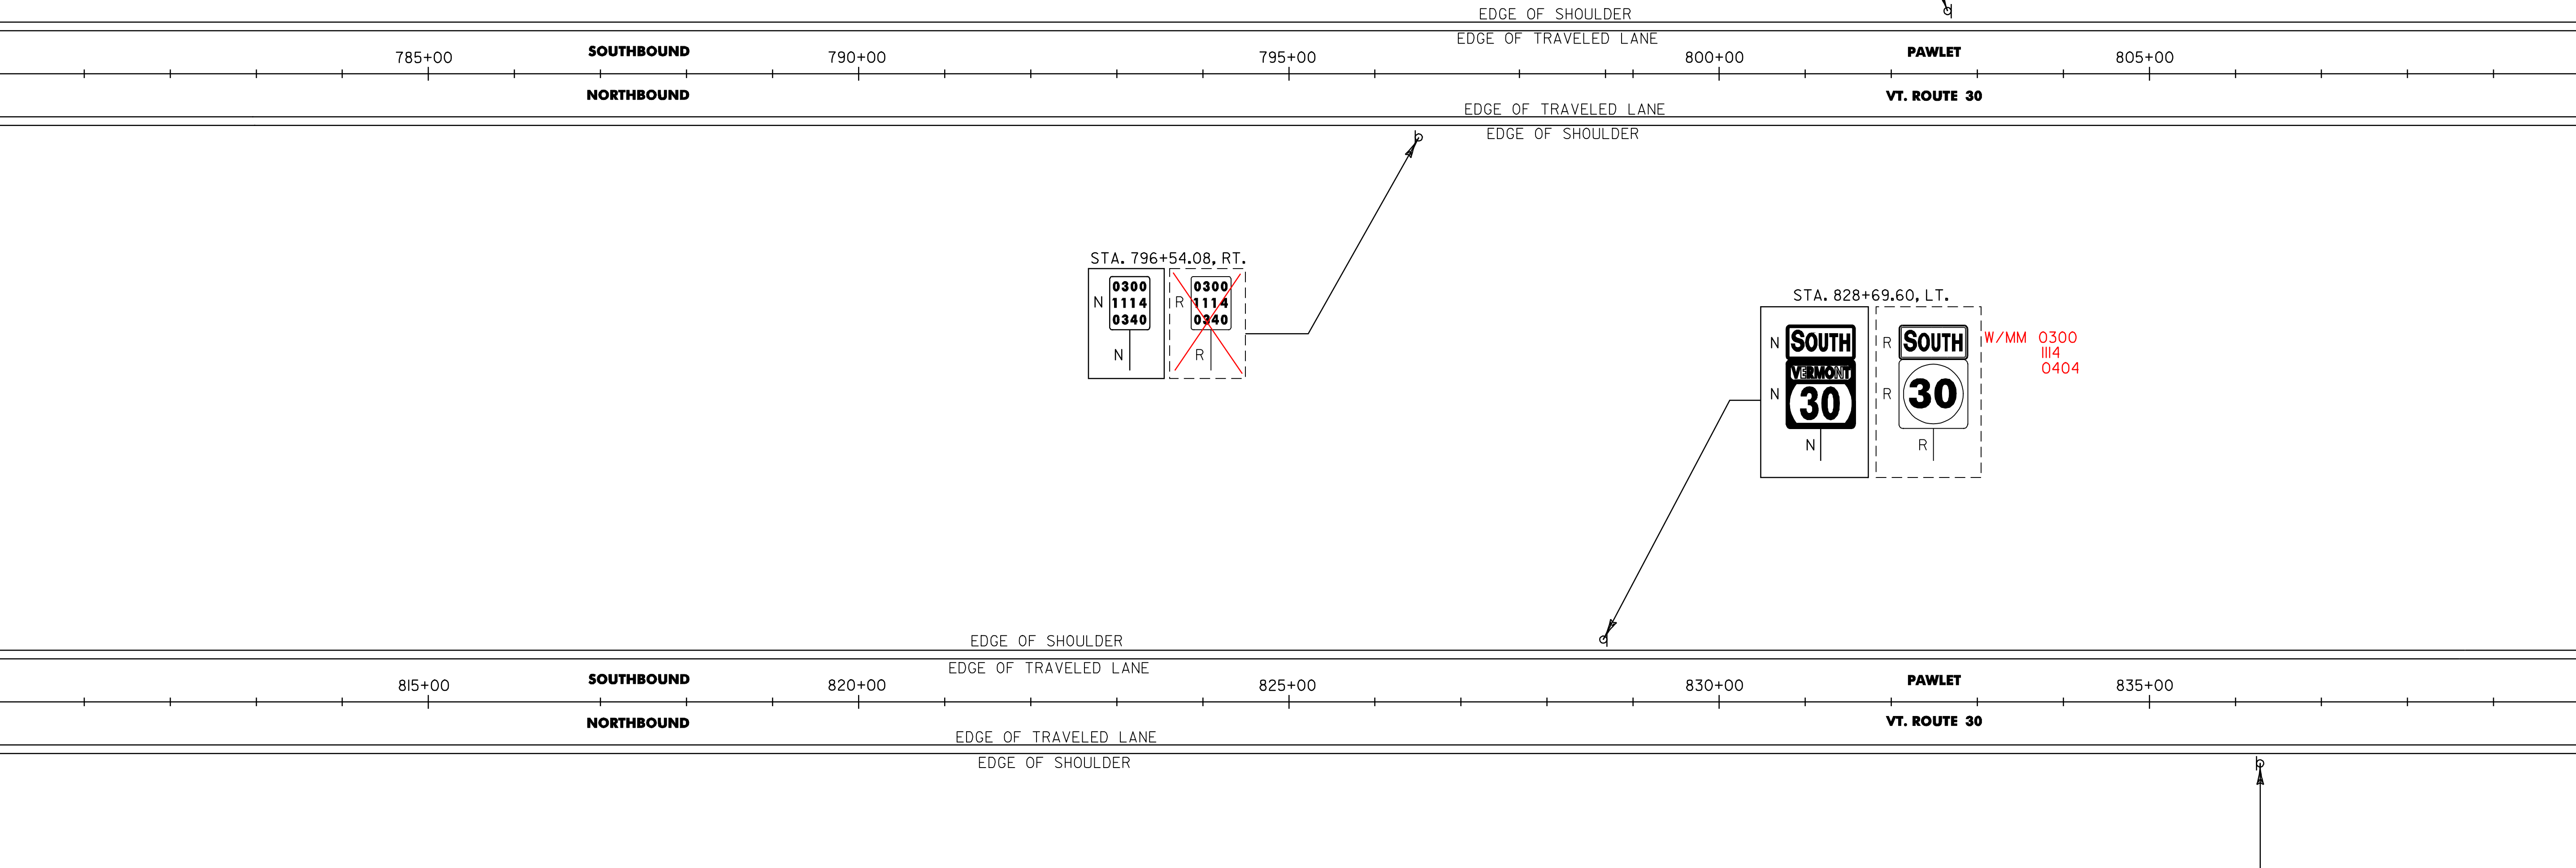

780+00 - 840+00

SIGN LEGEND
R= REMOVE
S= SALVAGE
N= NEW
RET= RETAIN
B-B= BACK TO BACK
EXISTING= _____
NEW= _____

PROJECT NAME: MANCHESTER-PAWLET
PROJECT NUMBER: STPG_SIGN_(14)
FILE NAME: STPG_SIGN_PROJECT.dgn PLOT DATE: 22-APR-2009 16:44
PROJECT LEADER: N.AVERY DRAWN BY: ROADWAY
DESIGNED BY: N.AVERY CHECKED BY: A.GAMBLE
LAYOUT 14 SHEET 17 OF 60