
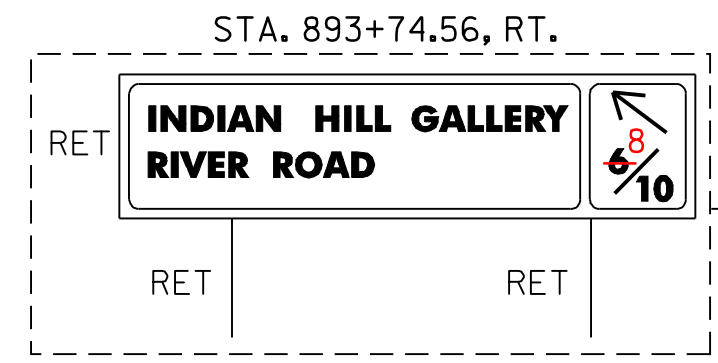
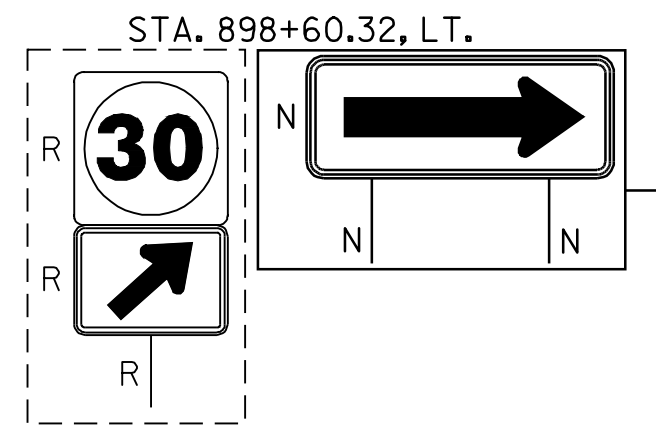
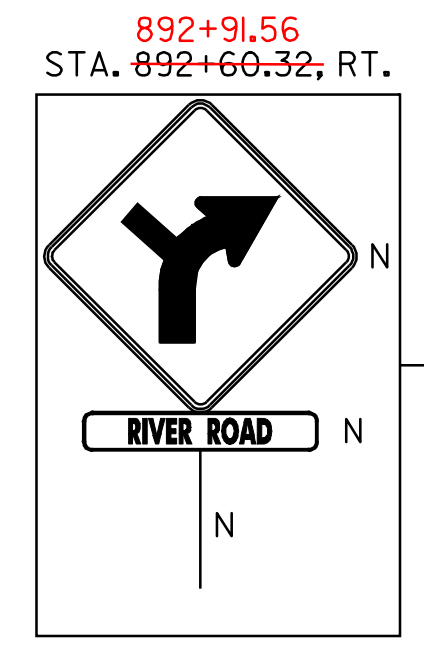
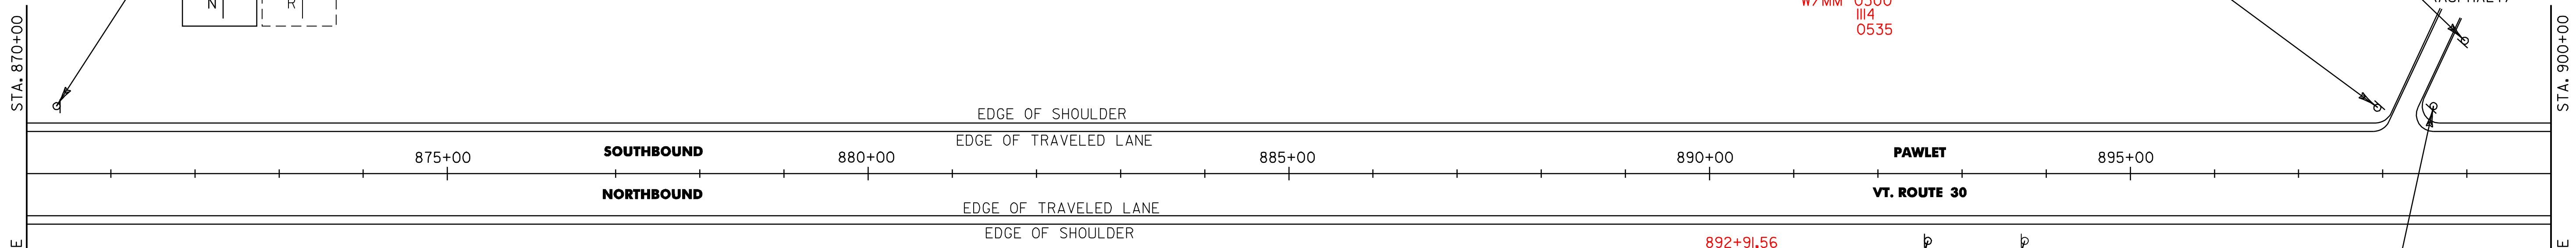
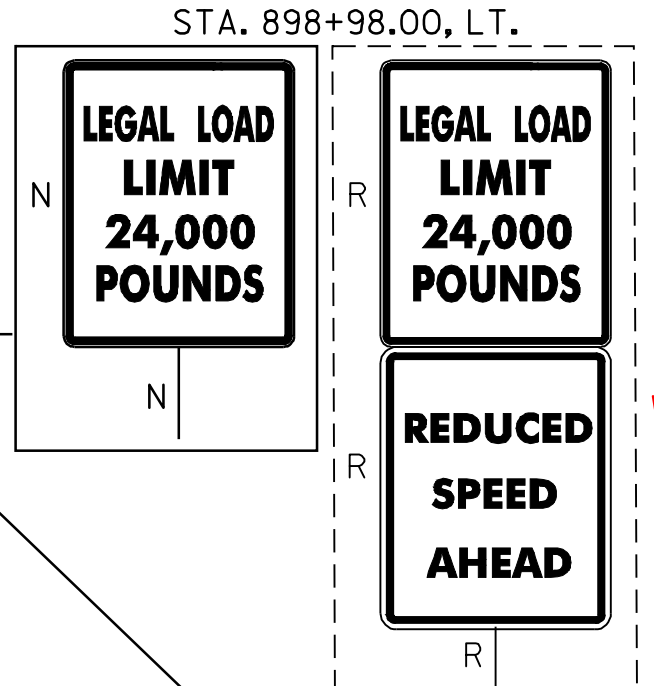
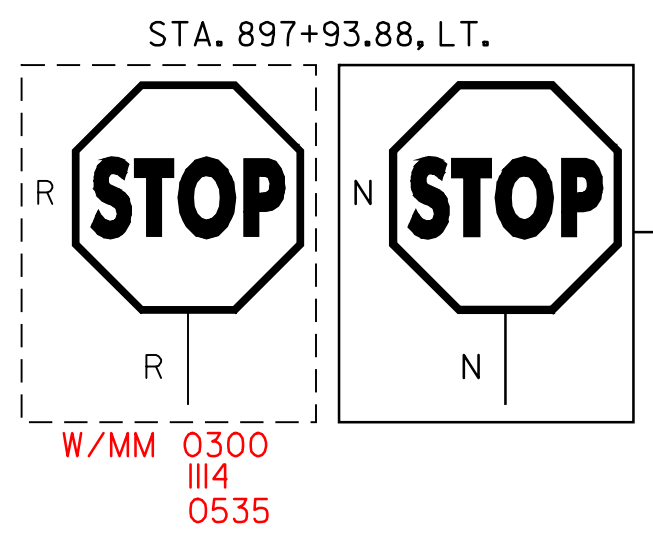
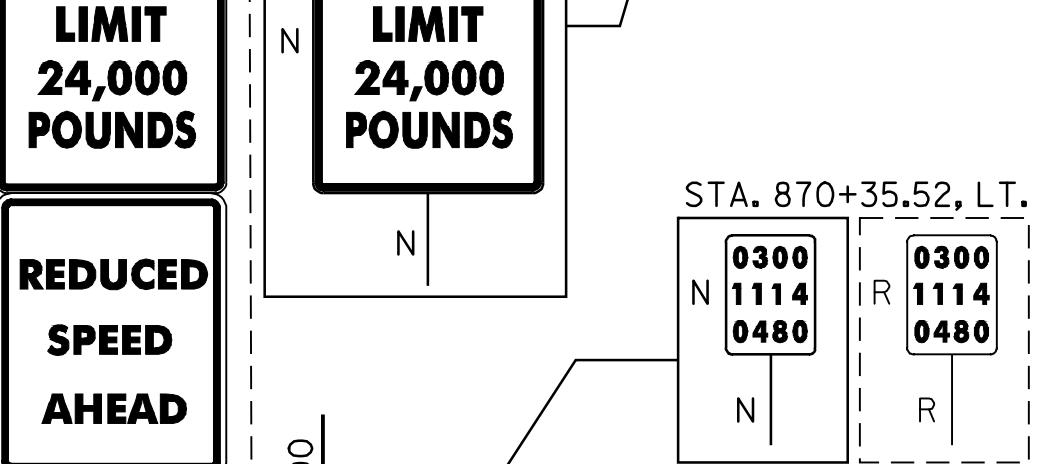
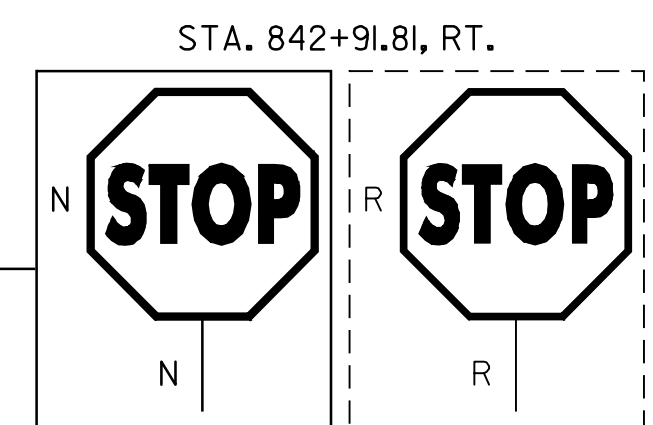
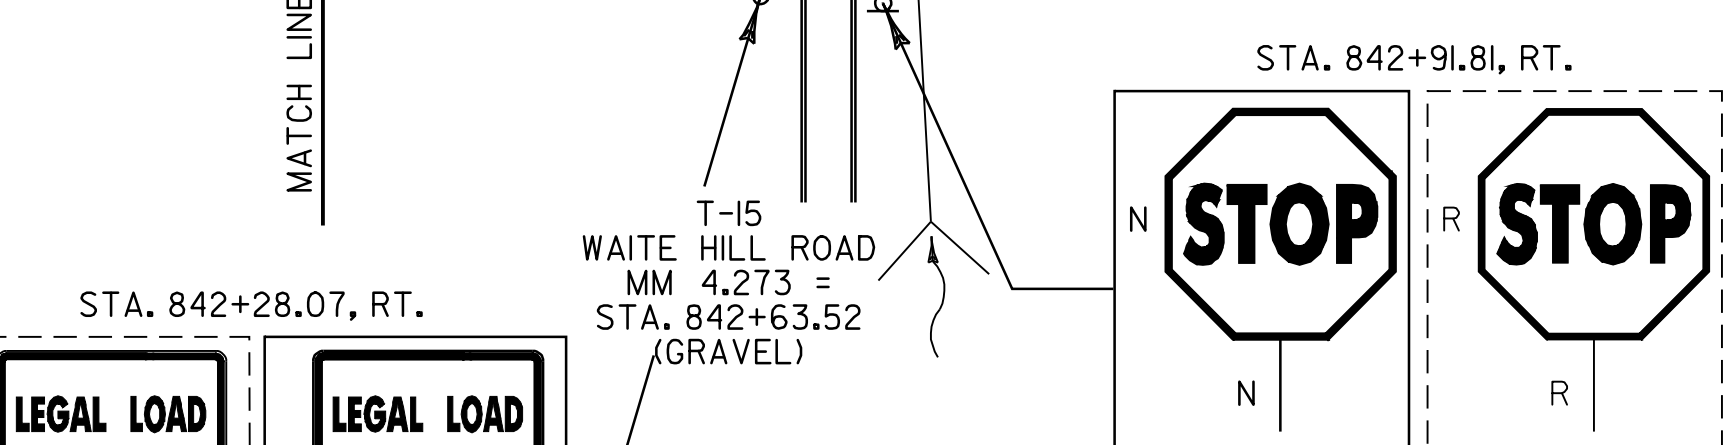
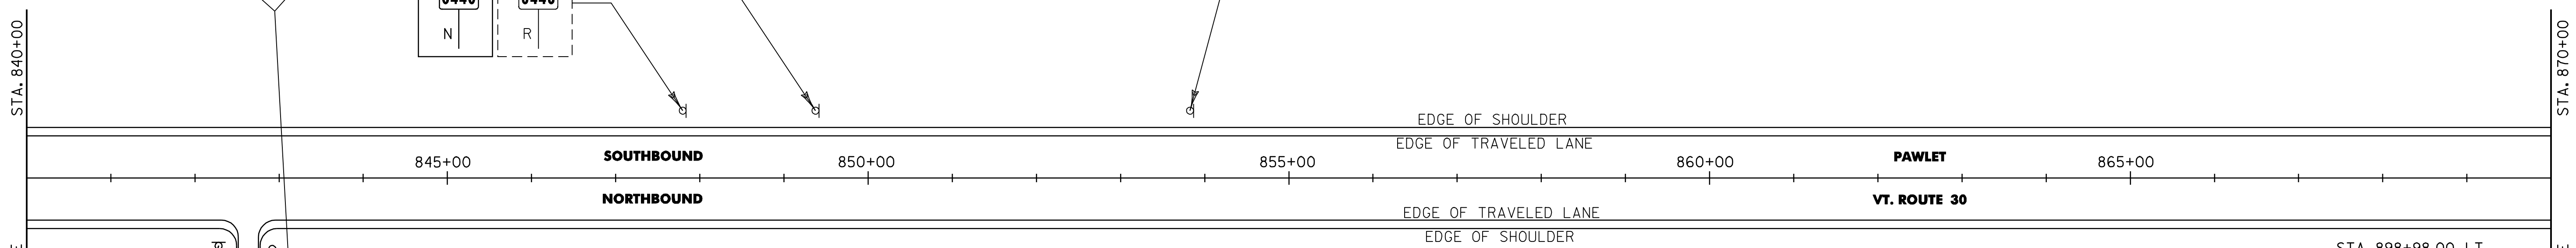


REMOVE SIGNS
AS SHOWN ⁻¹²/₁₄

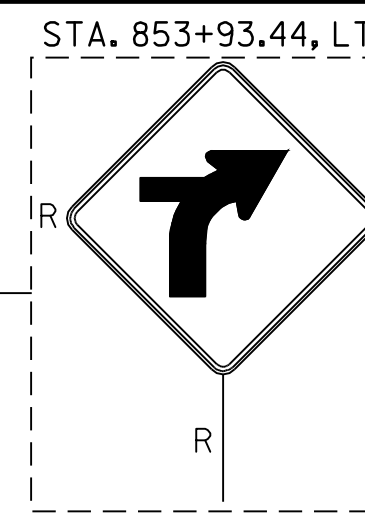

SIGN LEGEND
R= REMOVE
S= SALVAGE
N= NEW
RET= RETAIN
B-B= BACK TO BACK
EXISTING= _____
NEW= _____

PROJECT NAME: MANCHESTER-PAWLET	
PROJECT NUMBER: STPG_SIGN (14)	
FILE NAME: STPG_SIGN_PROJECT.dwg	PLOT DATE: 22-APR-2009 16:40
PROJECT LEADER: N. AVERY	DRAWN BY: ROADWAY
DESIGNED BY: N. AVERY	CHECKED BY: A. GAMBLE
LAYOUT 15	SHEET 18 OF 60

840+00 - 900+00