
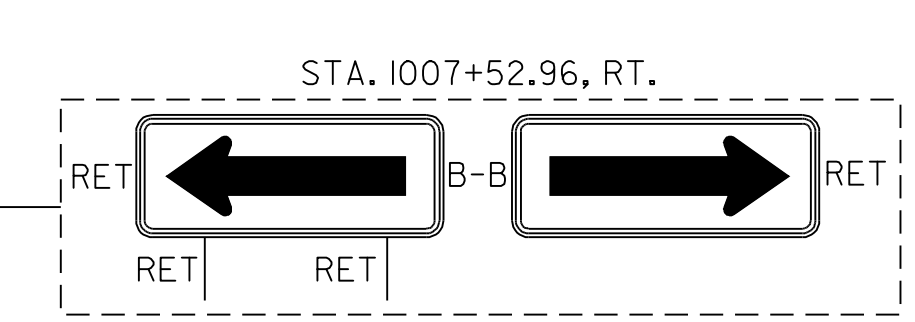
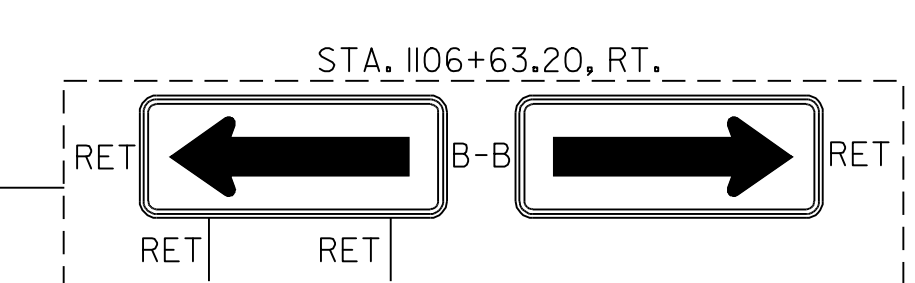
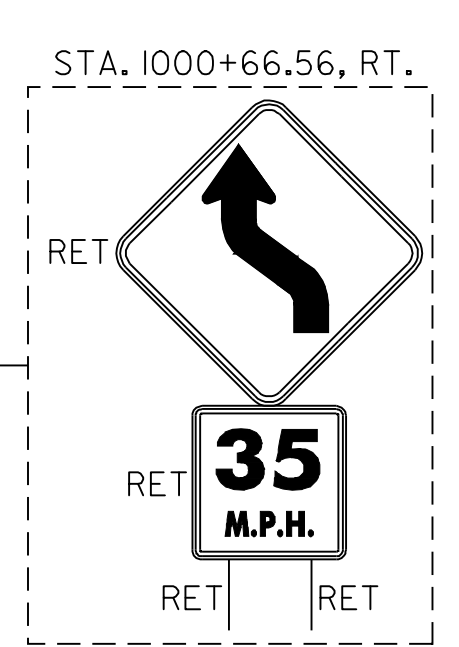
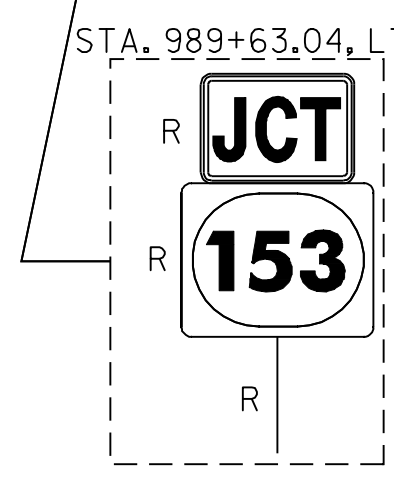
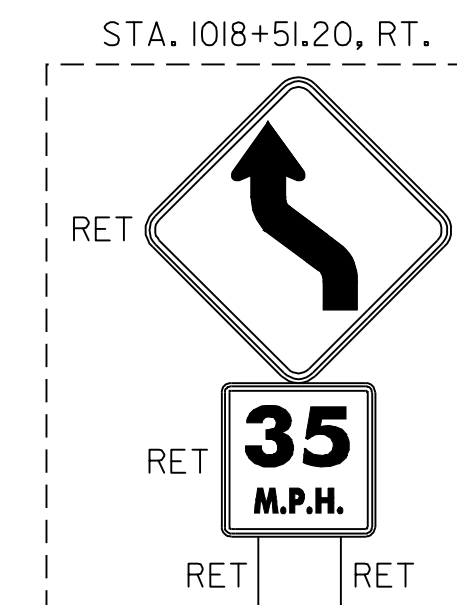
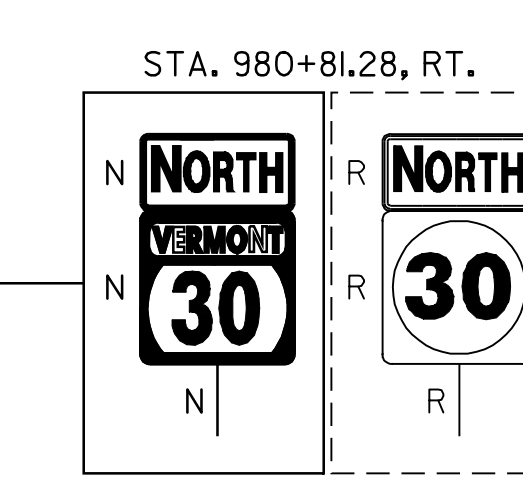
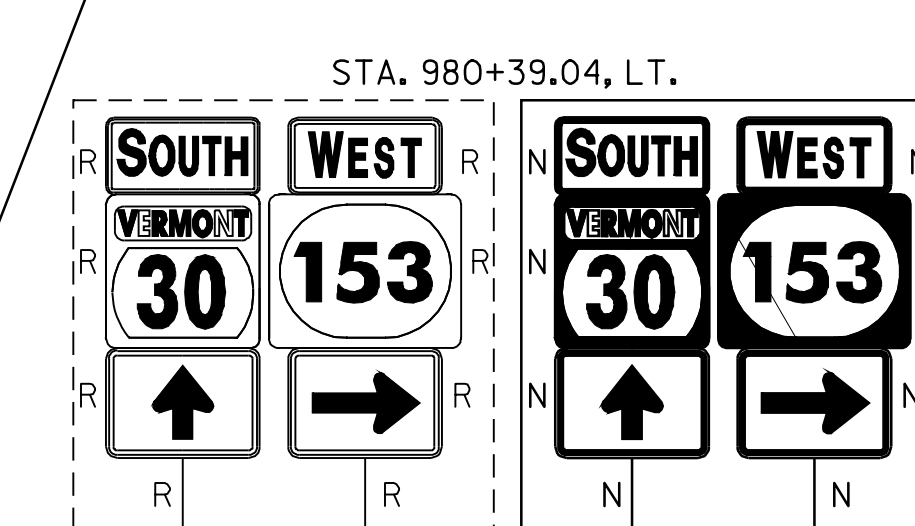
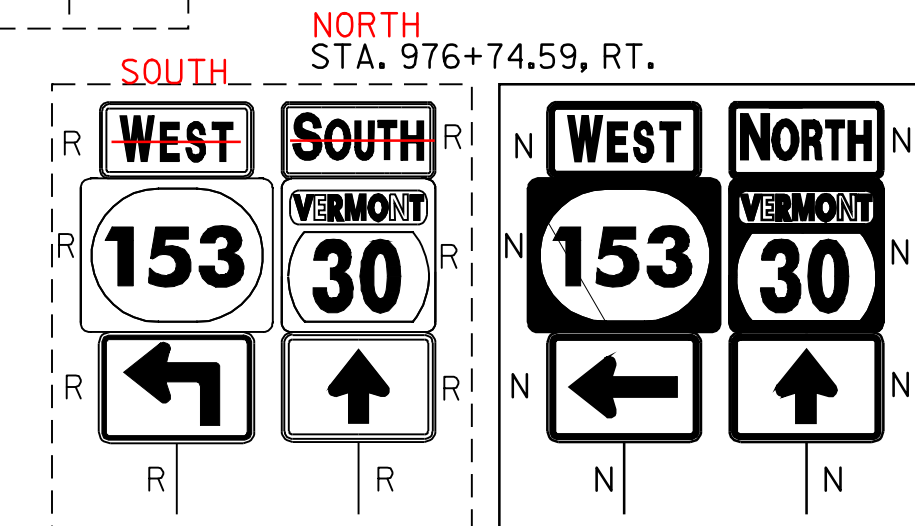
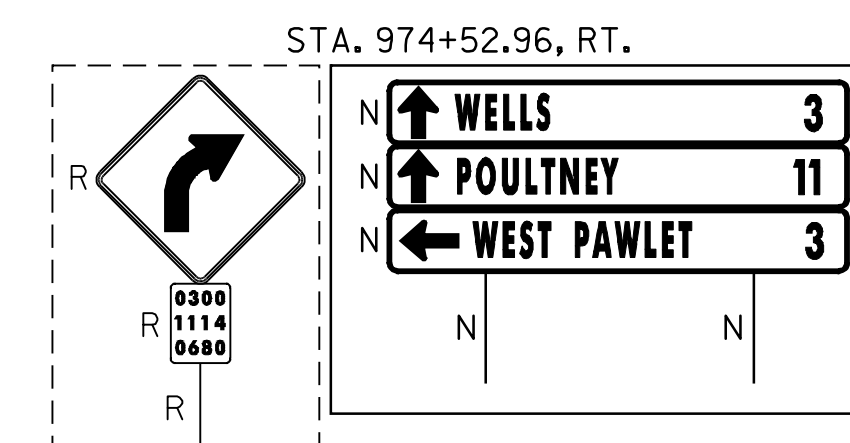
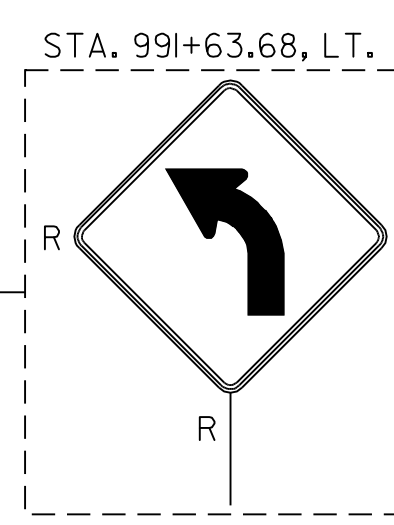
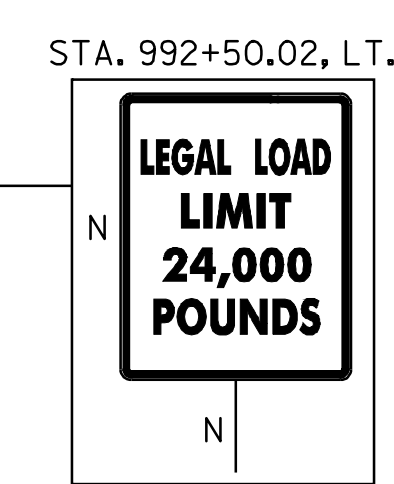
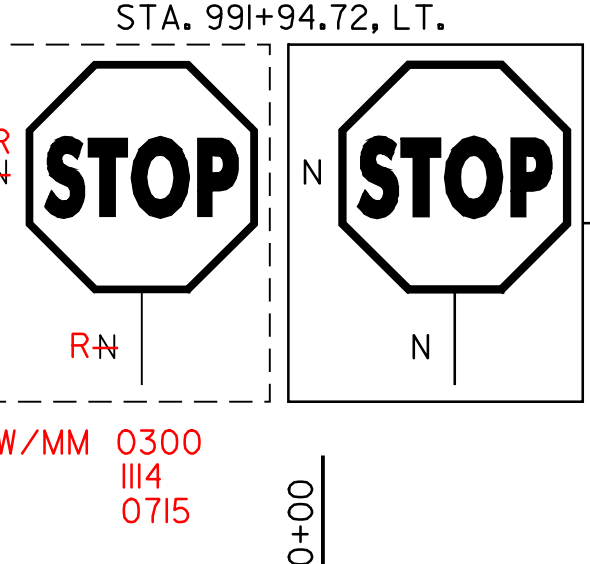


REMOVE SIGNS
AS SHOWN -40
41

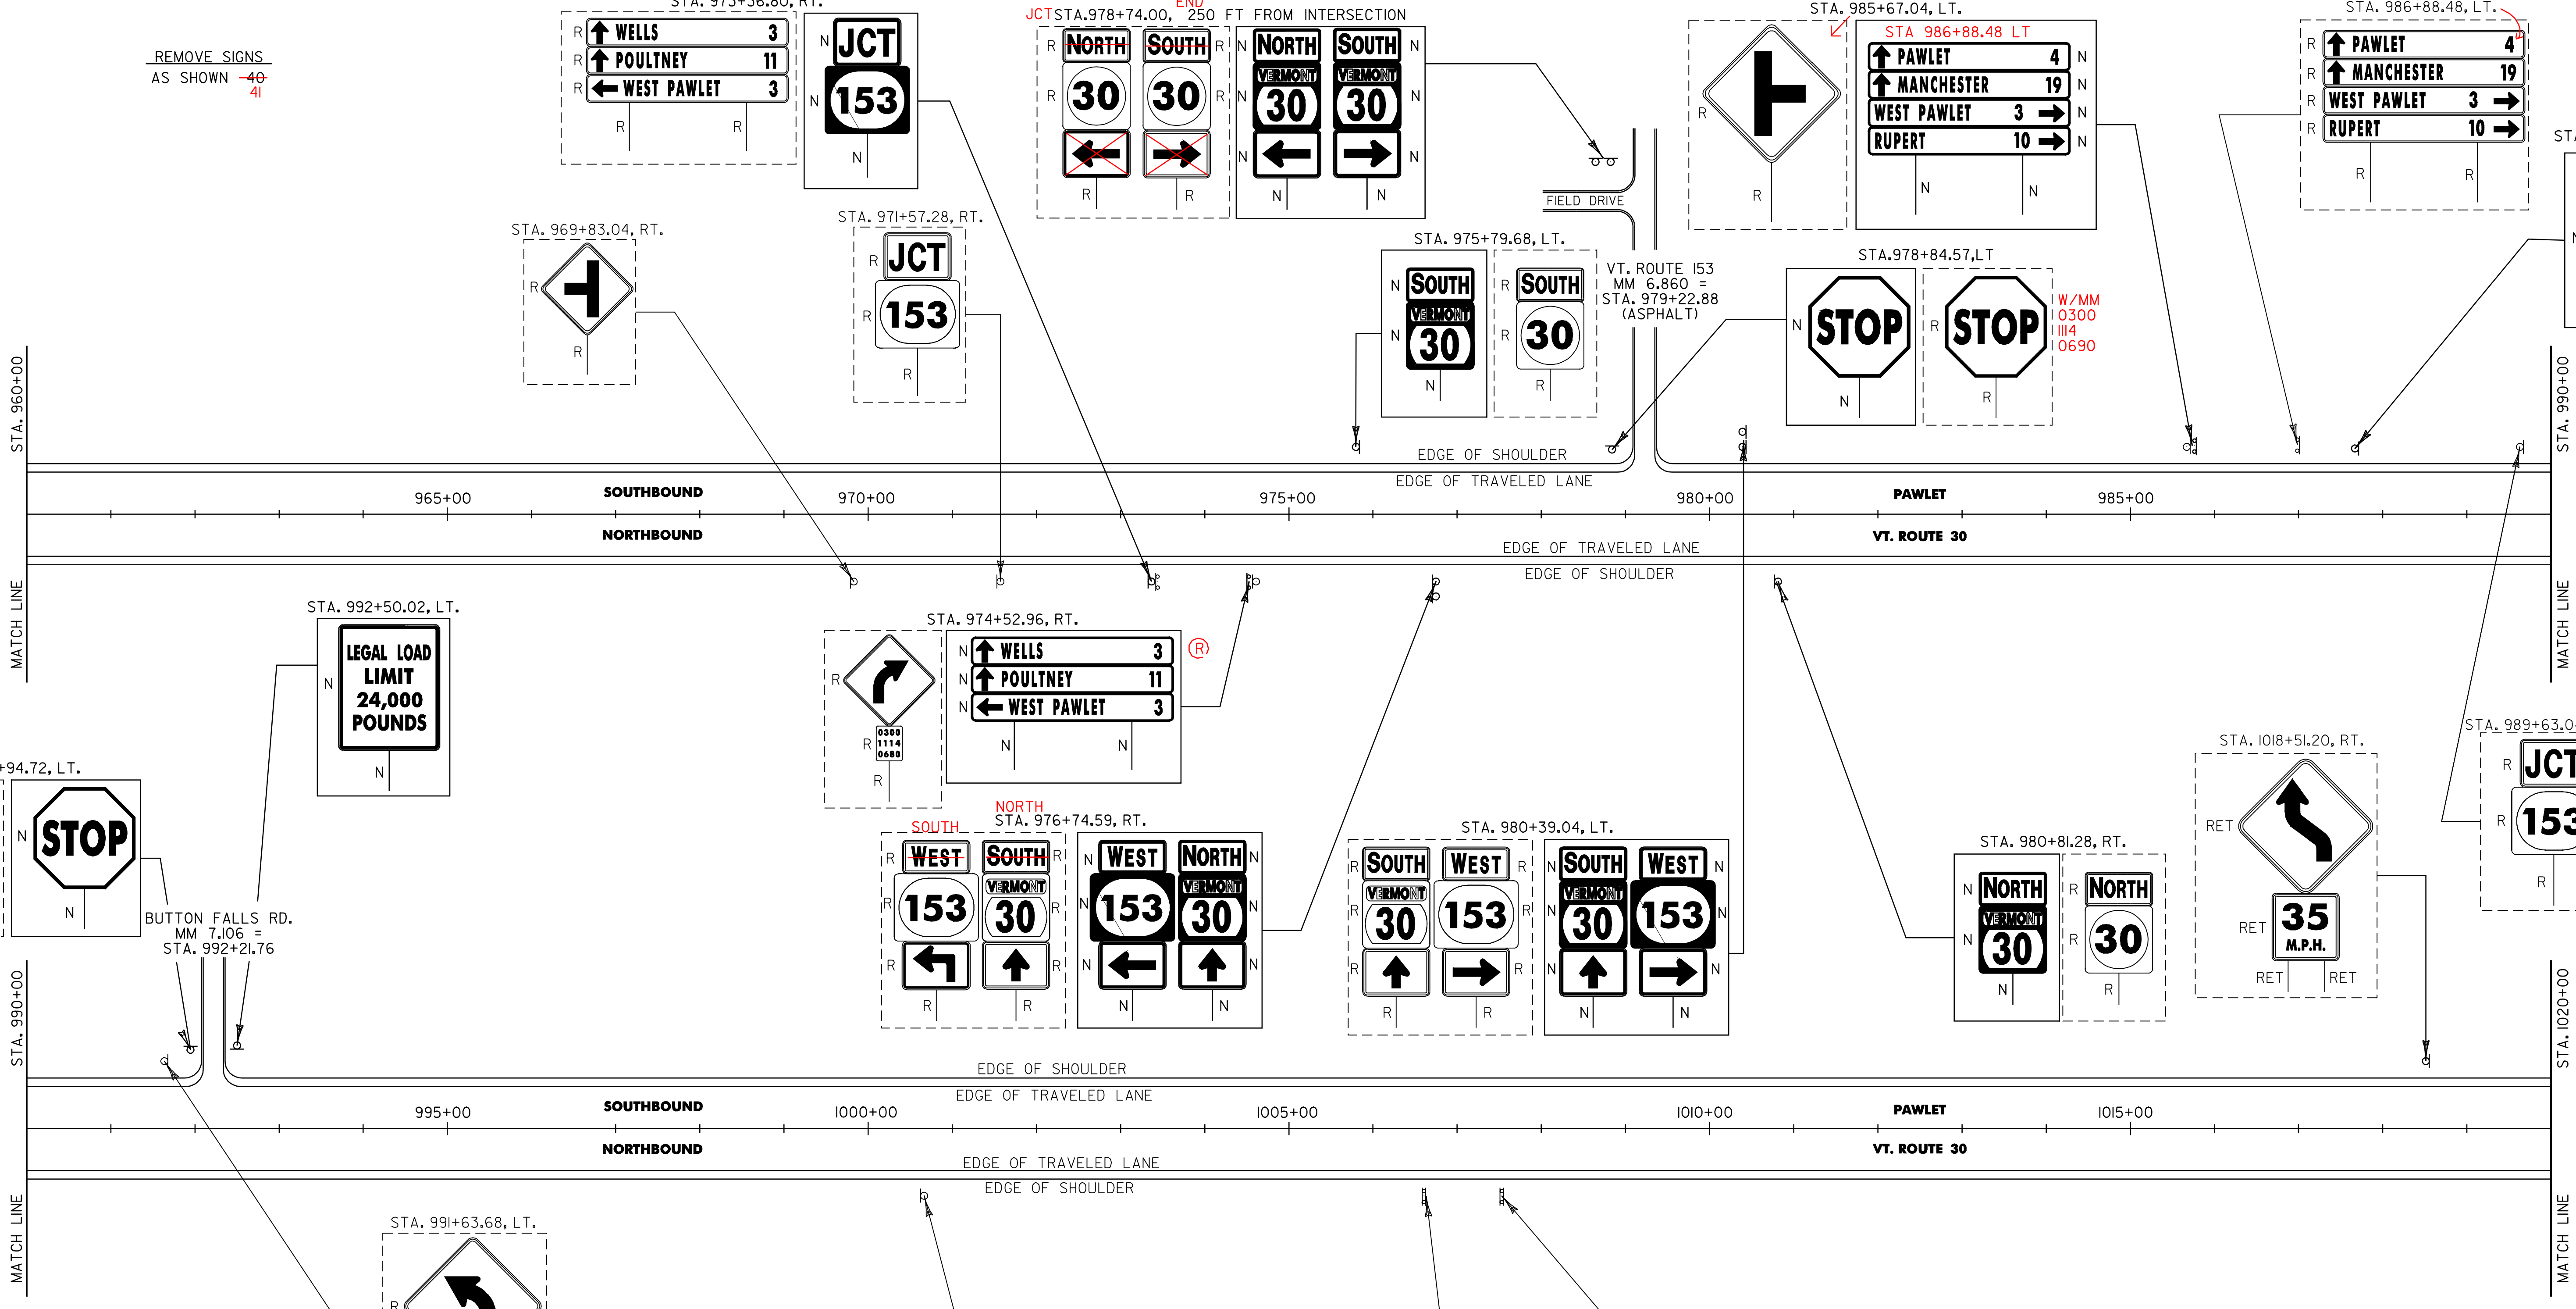

SIGN LEGEND
R= REMOVE
S= SALVAGE
N= NEW
RET= RETAIN
B-B= BACK TO BACK
EXISTING= _____
NEW= _____

960+00 - 1020+00

PROJECT NAME:	MANCHESTER-PAWLET		
PROJECT NUMBER:	STPG_SIGN (14)		
FILE NAME:	STPG_SIGN_PROJECT.dwg	PLOT DATE:	22-APR-2009 16:41
PROJECT LEADER:	N. AVERY	DRAWN BY:	ROADWAY
DESIGNED BY:	N. AVERY	CHECKED BY:	A. GAMBLE
LAYOUT:	17	SHEET	20 OF 60