


REMOVE SIGNS  
AS SHOWN 34  
35

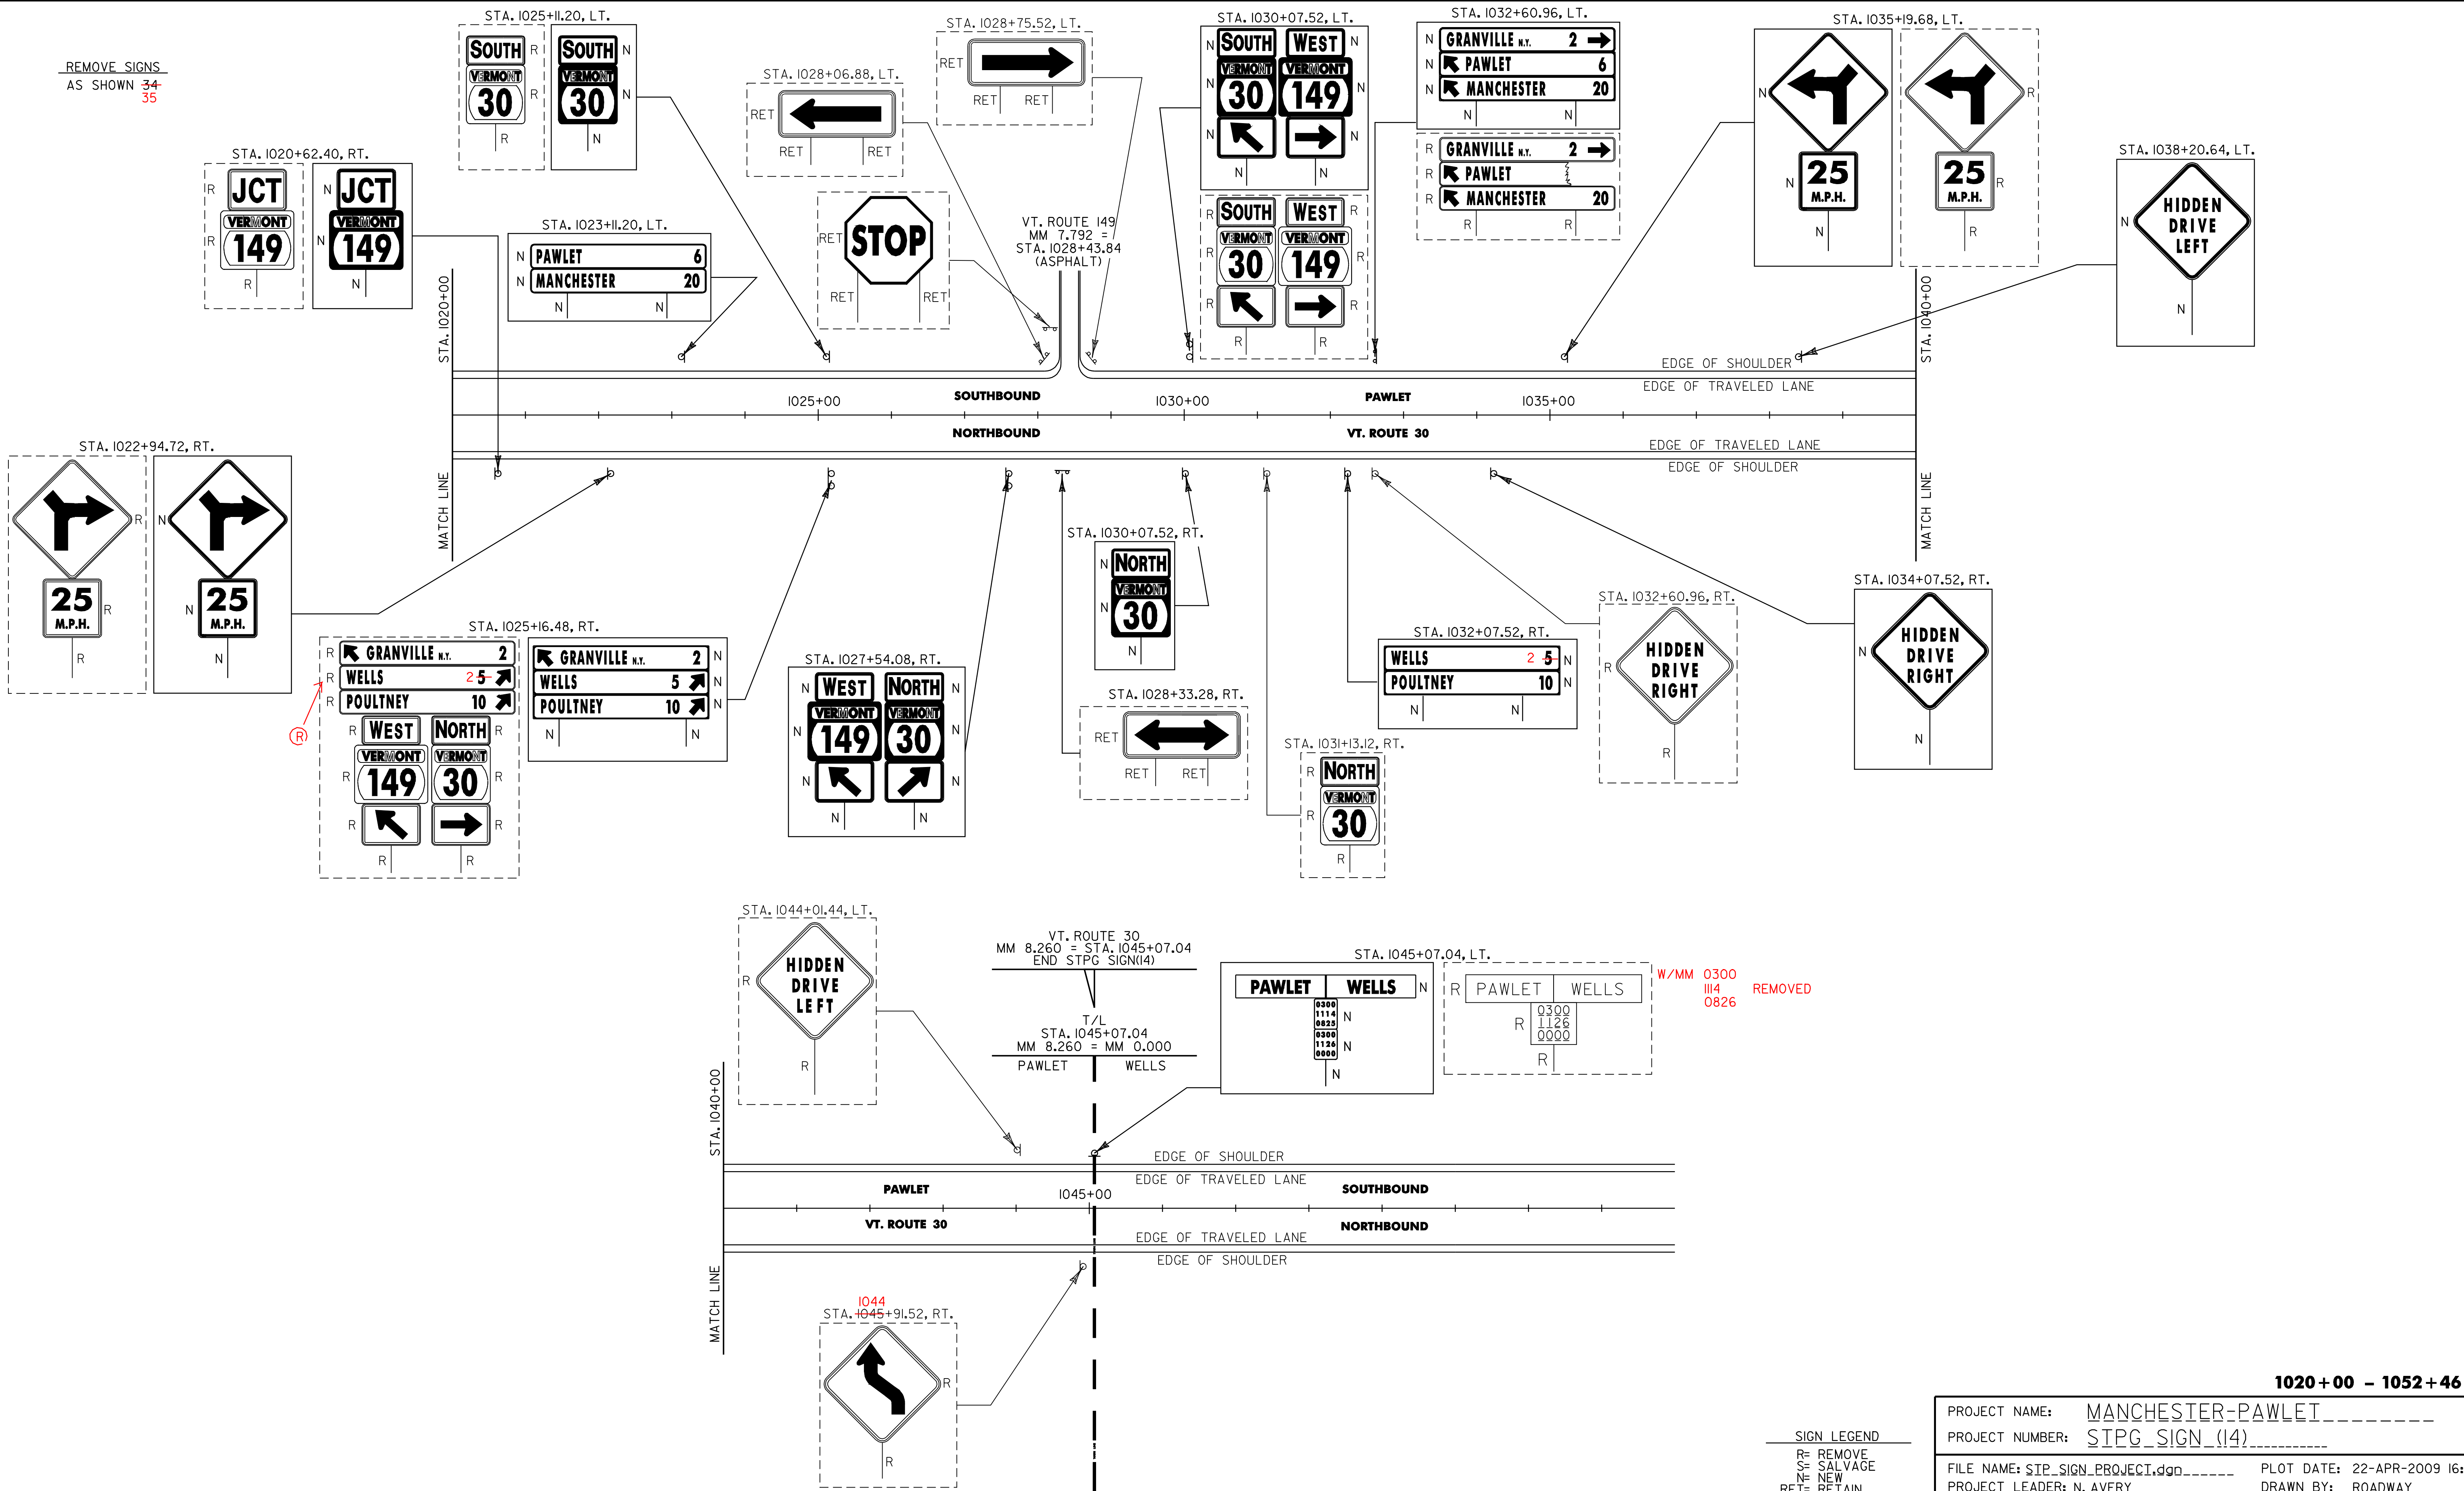

1020+00 - 1052+46

PROJECT NAME:	MANCHESTER-PAWLET	FILE NAME:	STP_SIGN_PROJECT.dwg	PLOT DATE:	22-APR-2009 16:44
PROJECT NUMBER:	STPG_SIGN (14)	PROJECT LEADER:	N. AVERY	DRAWN BY:	ROADWAY
		DESIGNED BY:	N. AVERY	CHECKED BY:	A. GAMBLE
		LAYOUT 18		SHEET 21	OF 60

W/MM 0300  
1114  
0826  
REMOVED

SIGN LEGEND  
R= REMOVE  
S= SALVAGE  
N= NEW  
RET= RETAIN  
B= B= BACK TO BACK  
EXISTING= EXISTING  
NEW= NEW