


REMOVE SIGNS
AS SHOWN -7
8

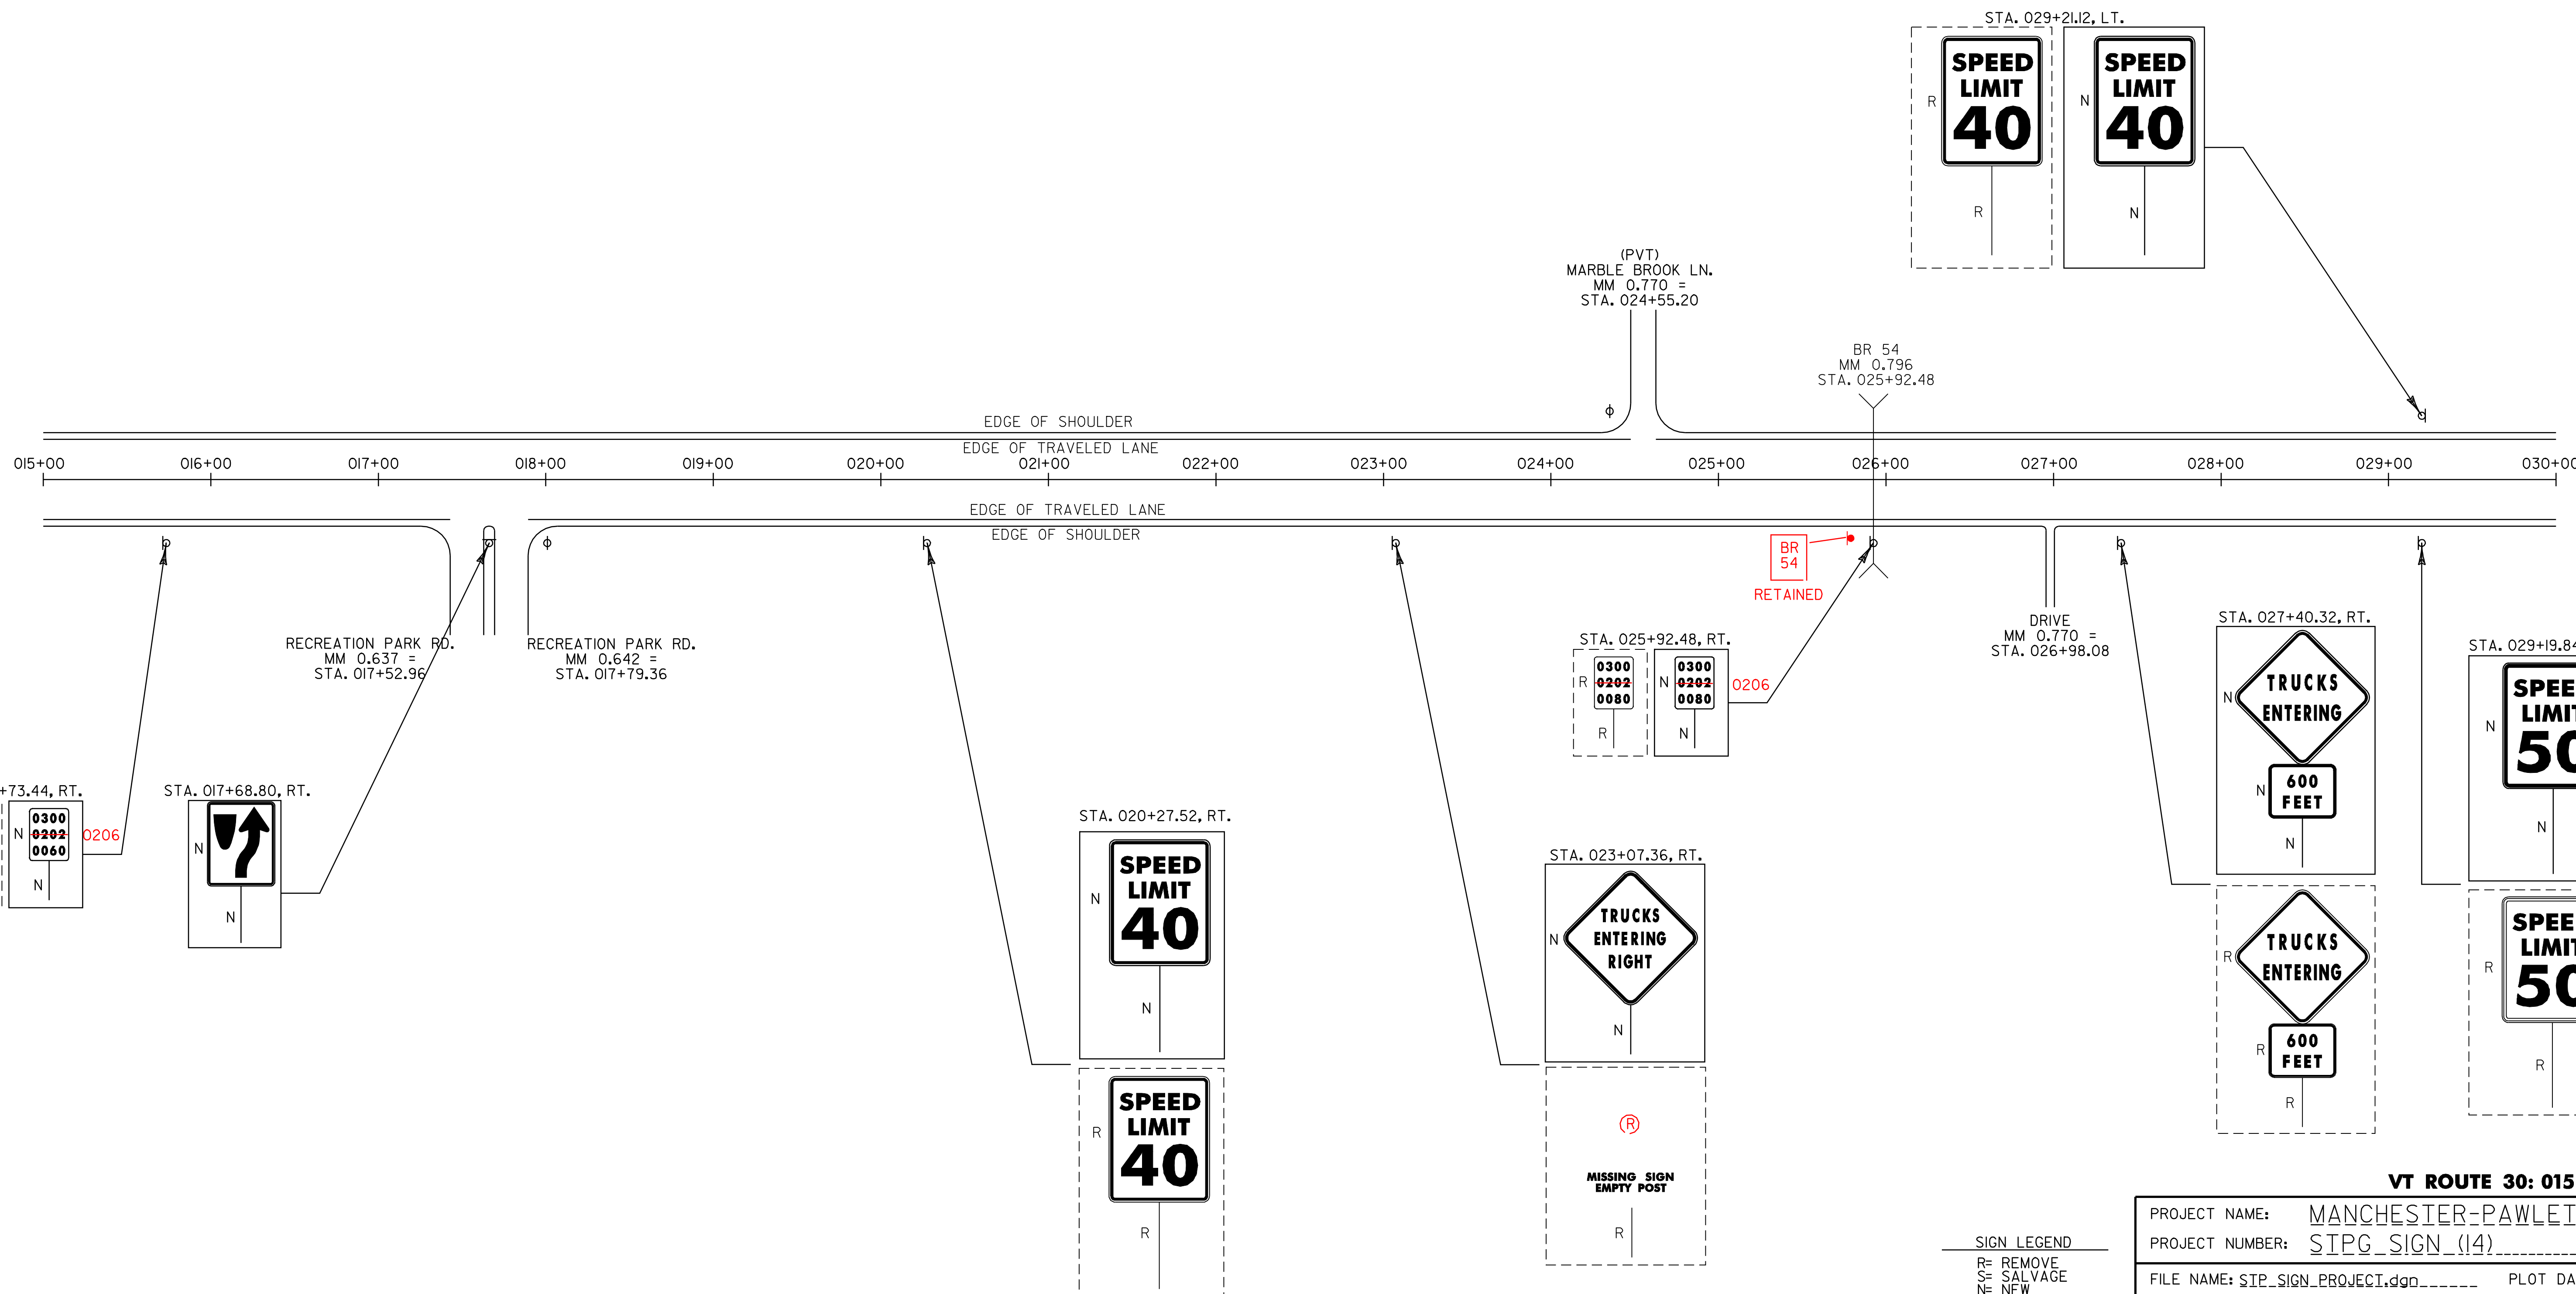

VT ROUTE 30: 015+00 - 030+00

PROJECT NAME:	MANCHESTER-PAWLET		
PROJECT NUMBER:	STPG_SIGN (14)		
FILE NAME:	STPG_SIGN_PROJECT.dgn	PLOT DATE:	22-APR-2009 16:42
PROJECT LEADER:	N. AVERY	DRAWN BY:	ROADWAY
DESIGNED BY:	N. AVERY	CHECKED BY:	A. GAMBLE
LAYOUT:	AI	SHEET	22 OF 60

SIGN LEGEND
 R= REMOVE
 S= SALVAGE
 N= NEW
 RET= RETAIN
 B-B= BACK TO BACK
 EXISTING= _____
 NEW= _____