
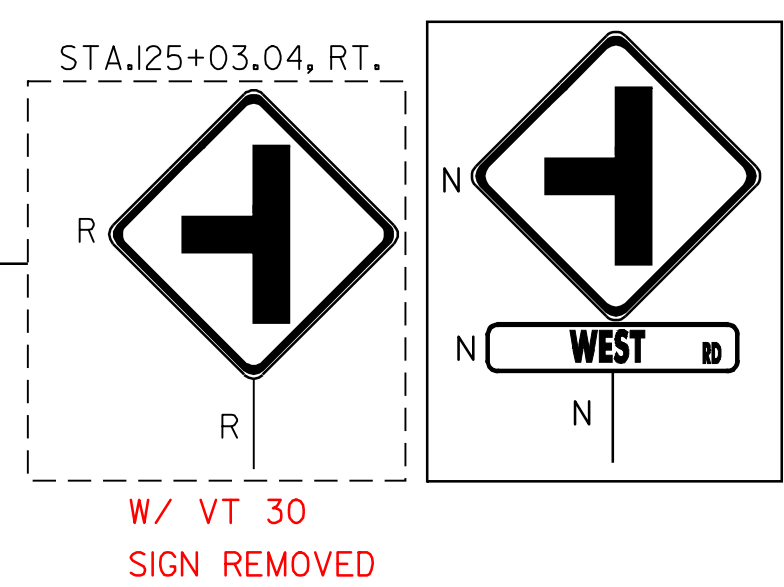
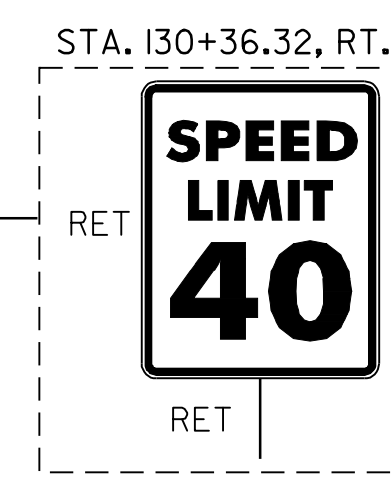
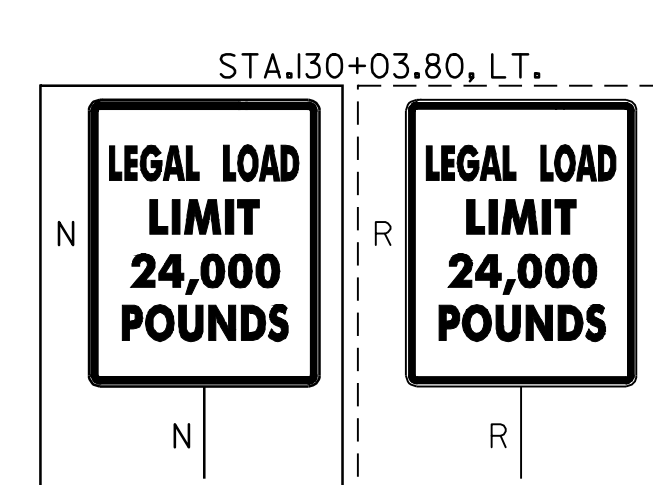
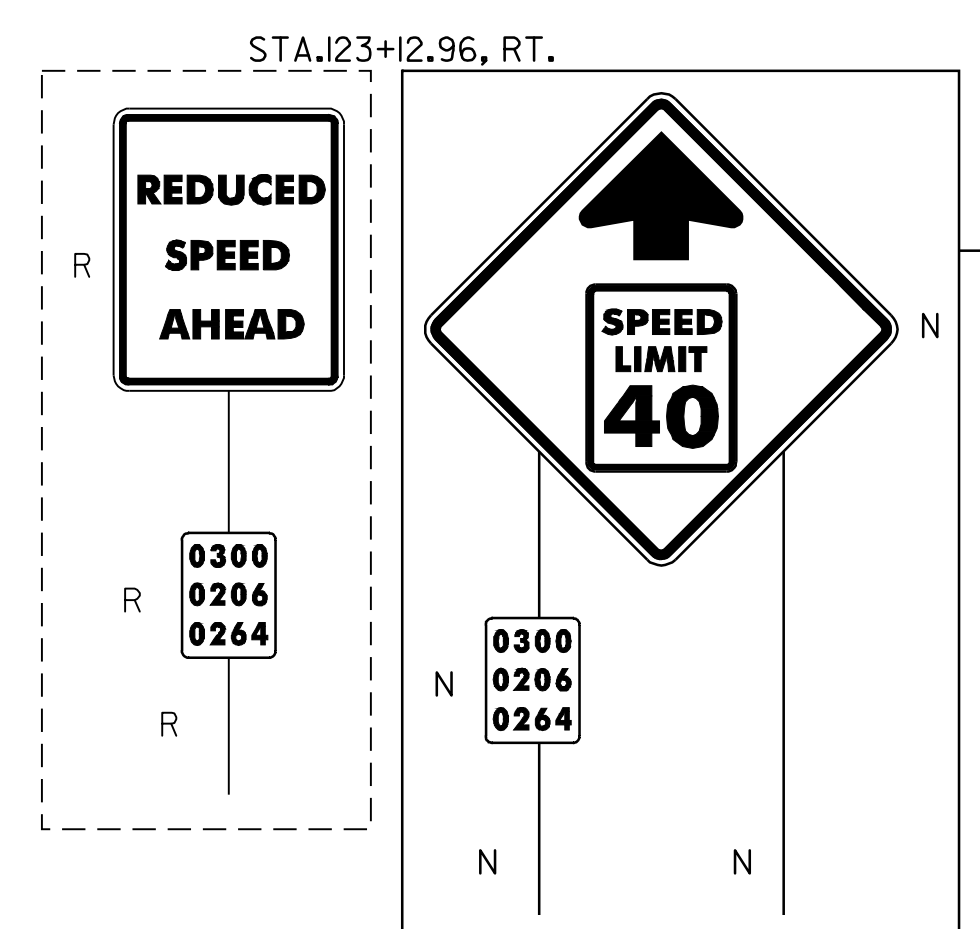
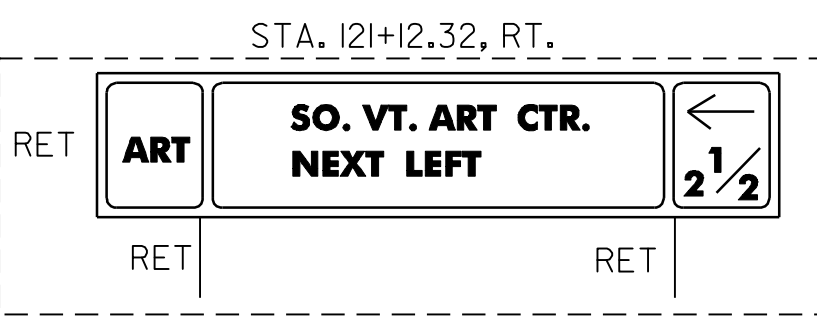
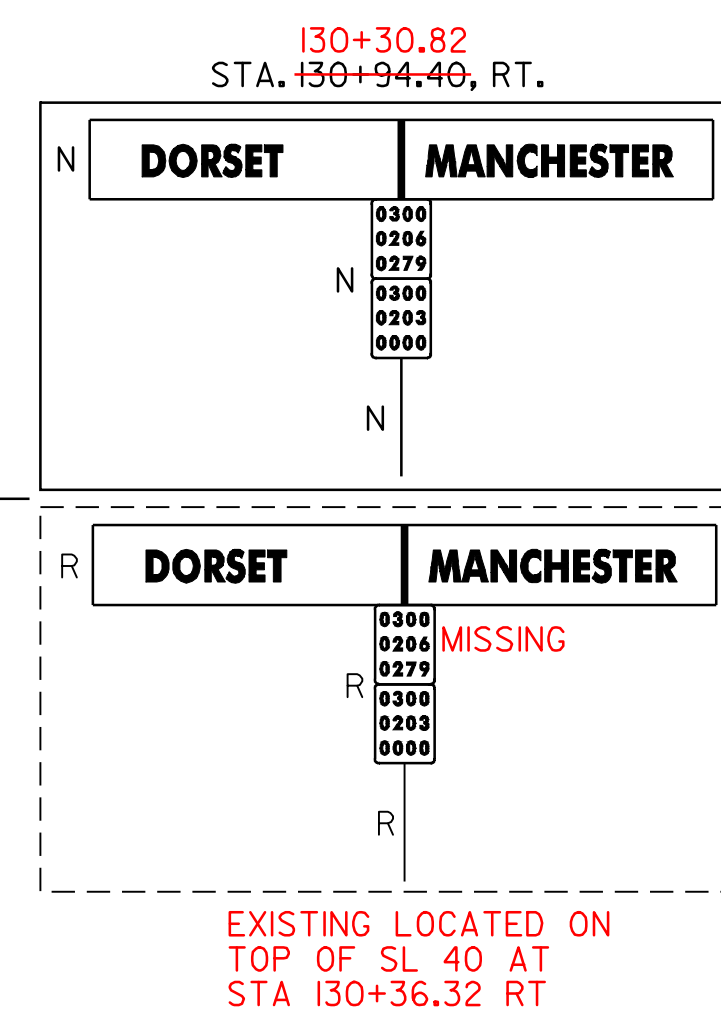


REMOVE SIGNS
AS SHOWN -H
10

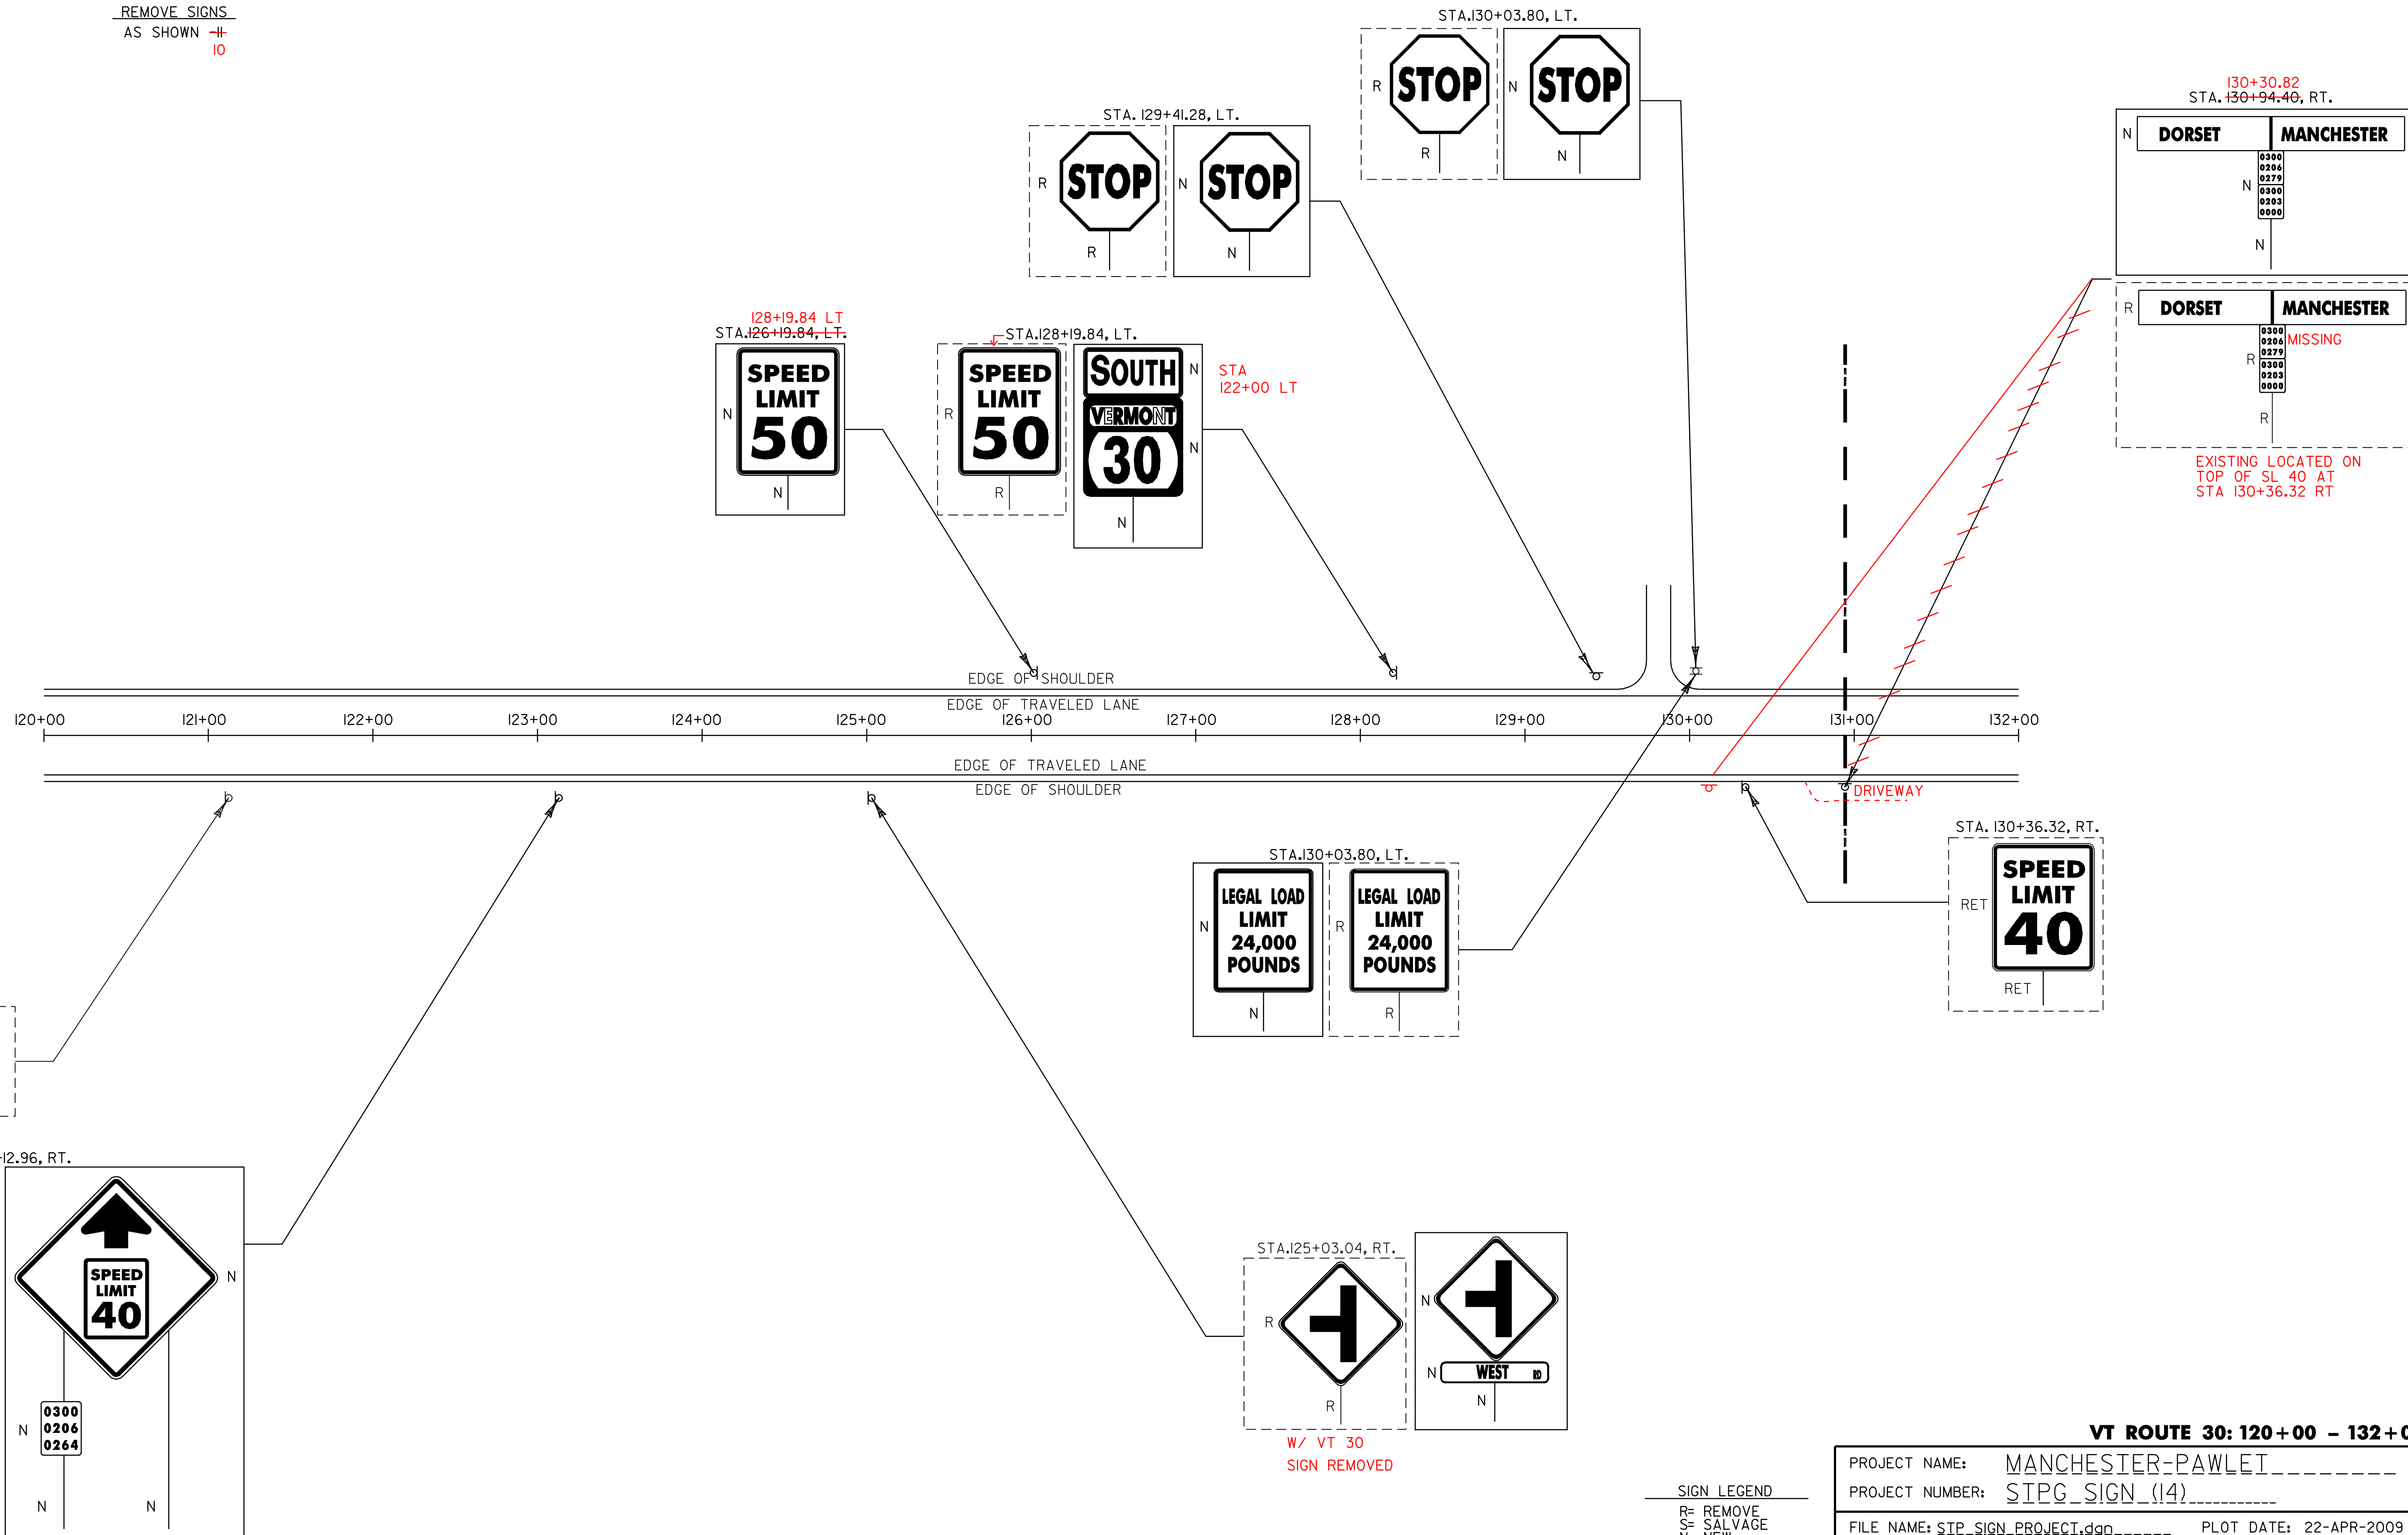

SIGN LEGEND
R= REMOVE
S= SALVAGE
N= NEW
RET= RETAIN
B-B= BACK TO BACK
EXISTING= _____
NEW= _____

VT ROUTE 30: 120+00 - 132+00	
PROJECT NAME: MANCHESTER-PAWLET	FILE NAME: STP_SIGN_PROJECT.dgn
PROJECT NUMBER: STPG_SIGN (14)	PLOT DATE: 22-APR-2009 16:40
DESIGNED BY: N. AVERY	DRAWN BY: ROADWAY
CHECKED BY: A. GAMBLE	SHEET 23 OF 60