


REMOVE SIGNS  
AS SHOWN -13  
17

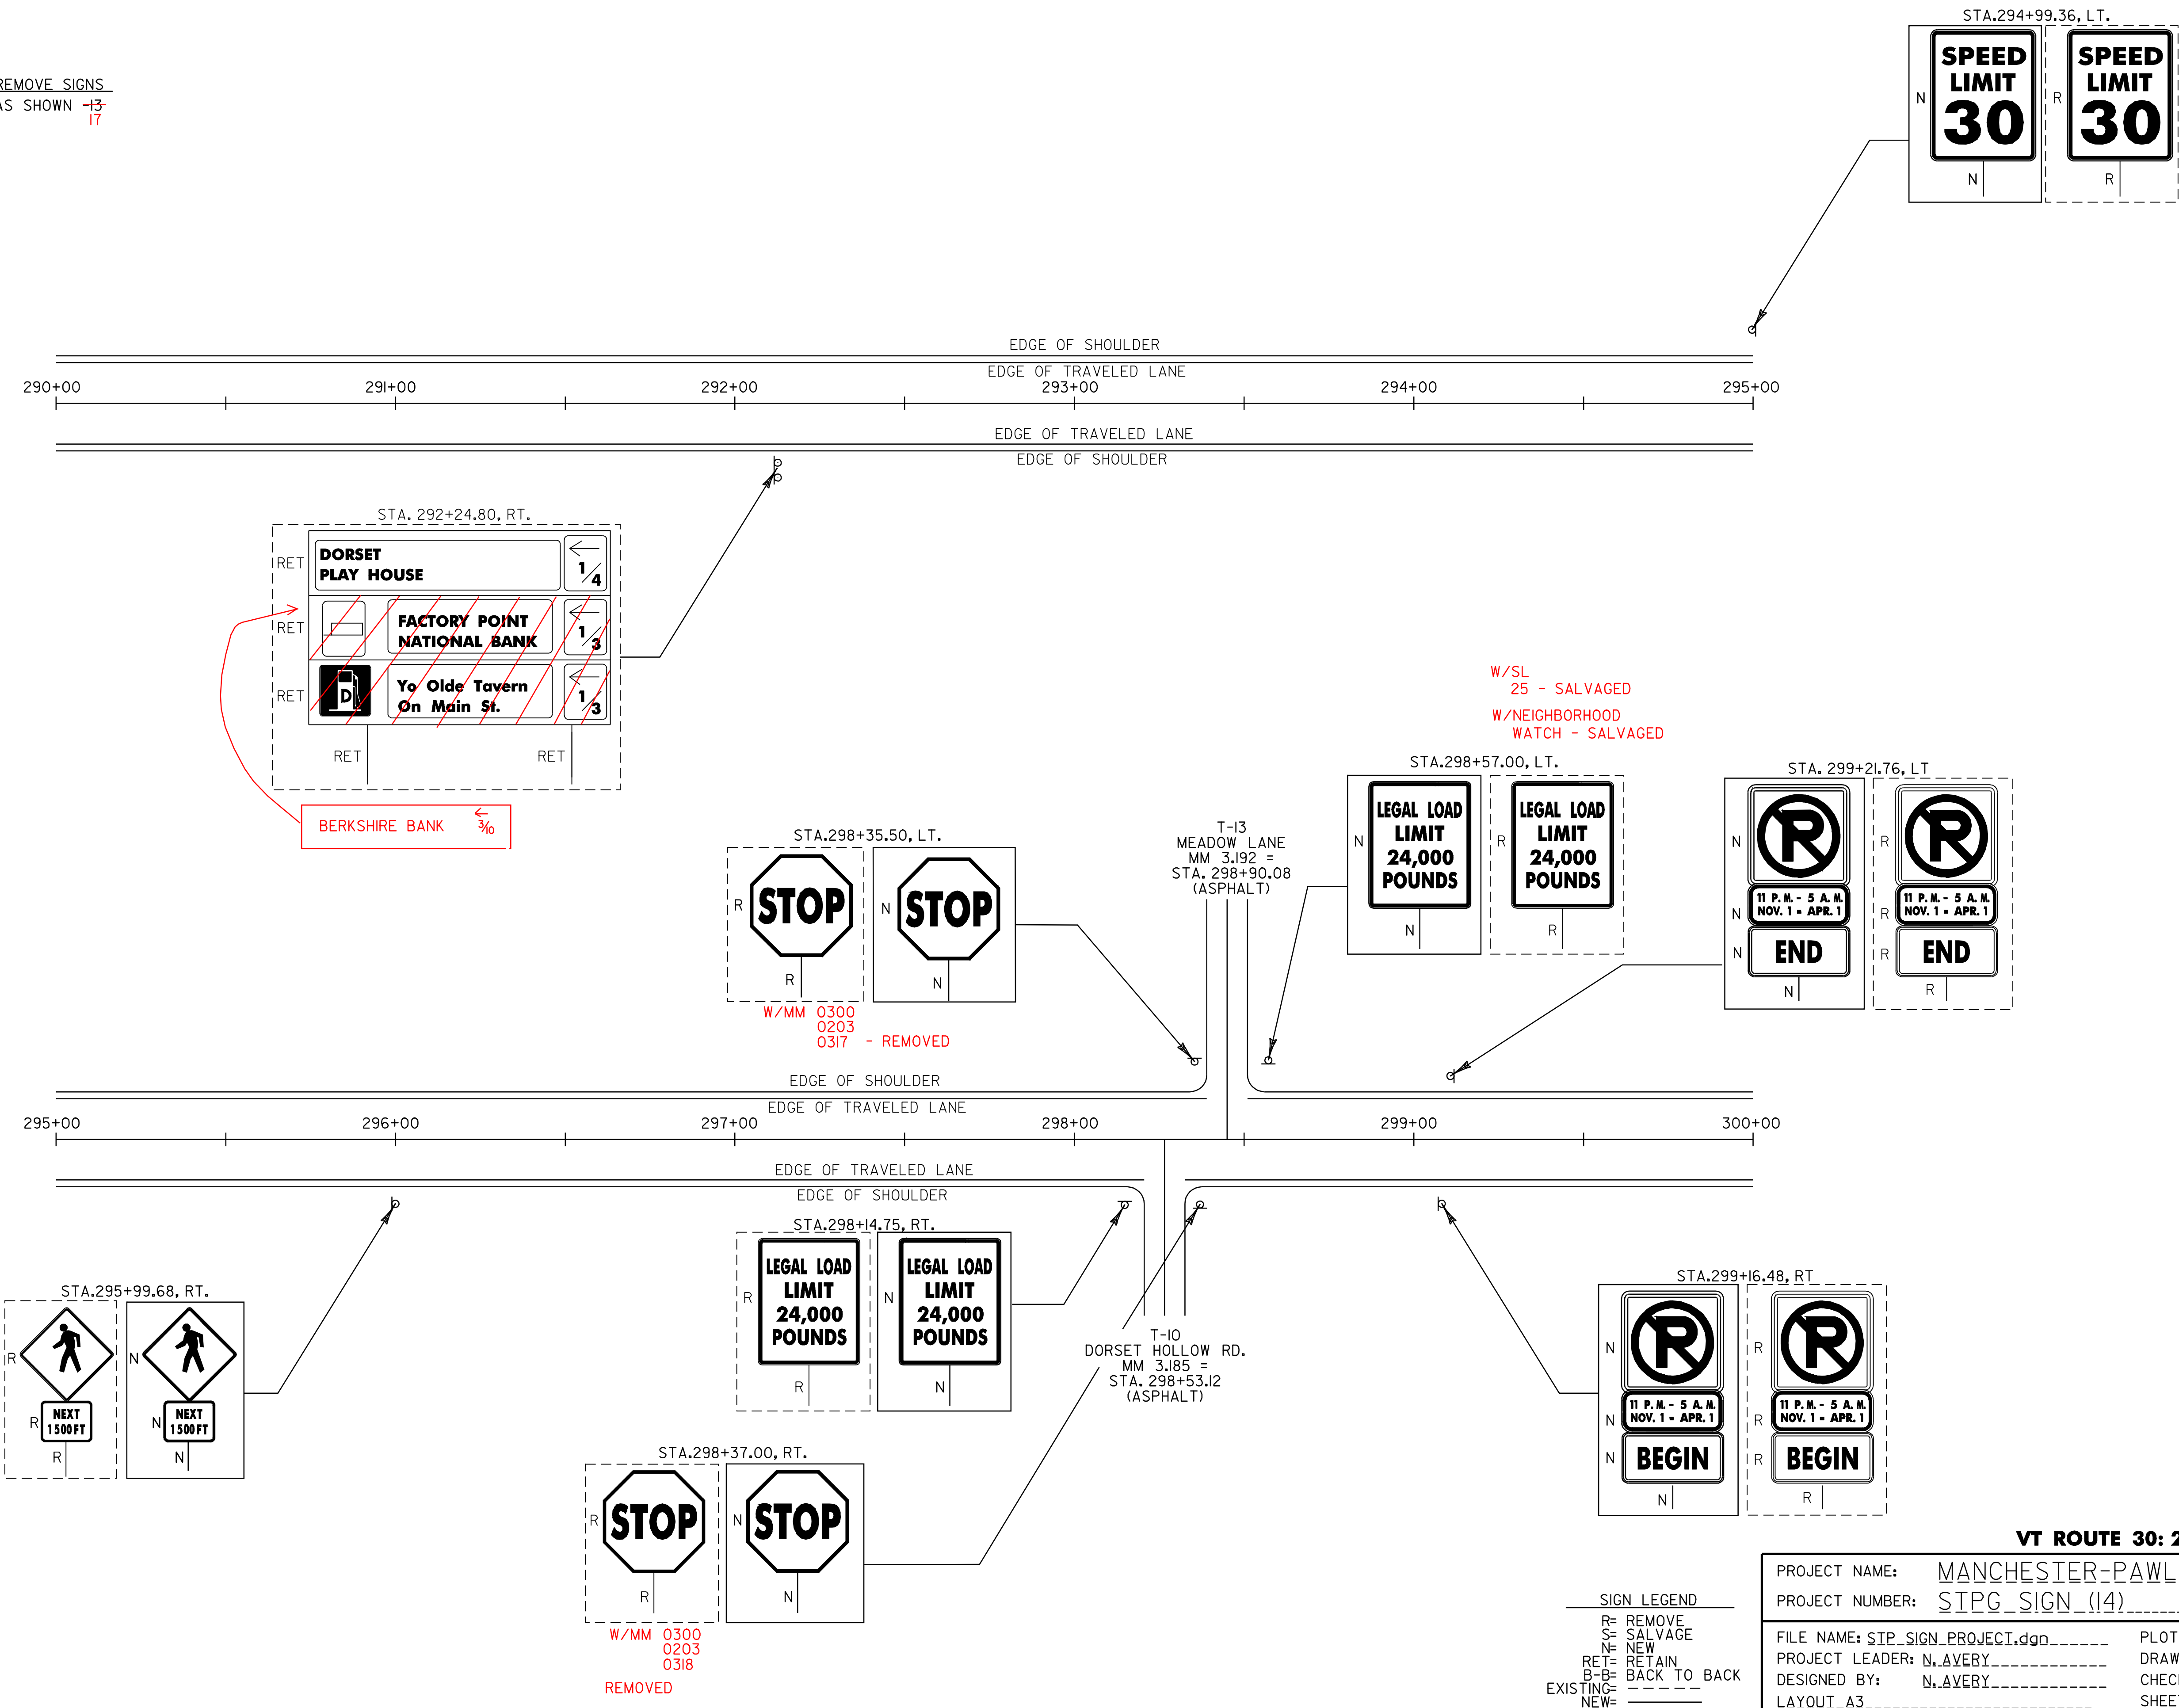

**VT ROUTE 30: 290+00 - 300+00**

PROJECT NAME:	MANCHESTER-PAWLET		
PROJECT NUMBER:	STPG_SIGN (14)		
FILE NAME:	STPG_SIGN_PROJECT.dgn	PLOT DATE:	22-APR-2009 16:48
PROJECT LEADER:	N. AVERY	DRAWN BY:	ROADWAY
DESIGNED BY:	N. AVERY	CHECKED BY:	A. GAMBLE
LAYOUT:	A3	SHEET:	24 OF 60

**SIGN LEGEND**

R=	REMOVE
S=	SALVAGE
N=	NEW
RET=	RETAIN
B-B=	BACK TO BACK
EXISTING=	EXISTING
NEW=	NEW