


REMOVE SIGNS  
AS SHOWN ~~25~~  
30

W/MM 0300  
0203  
0338 REMOVED

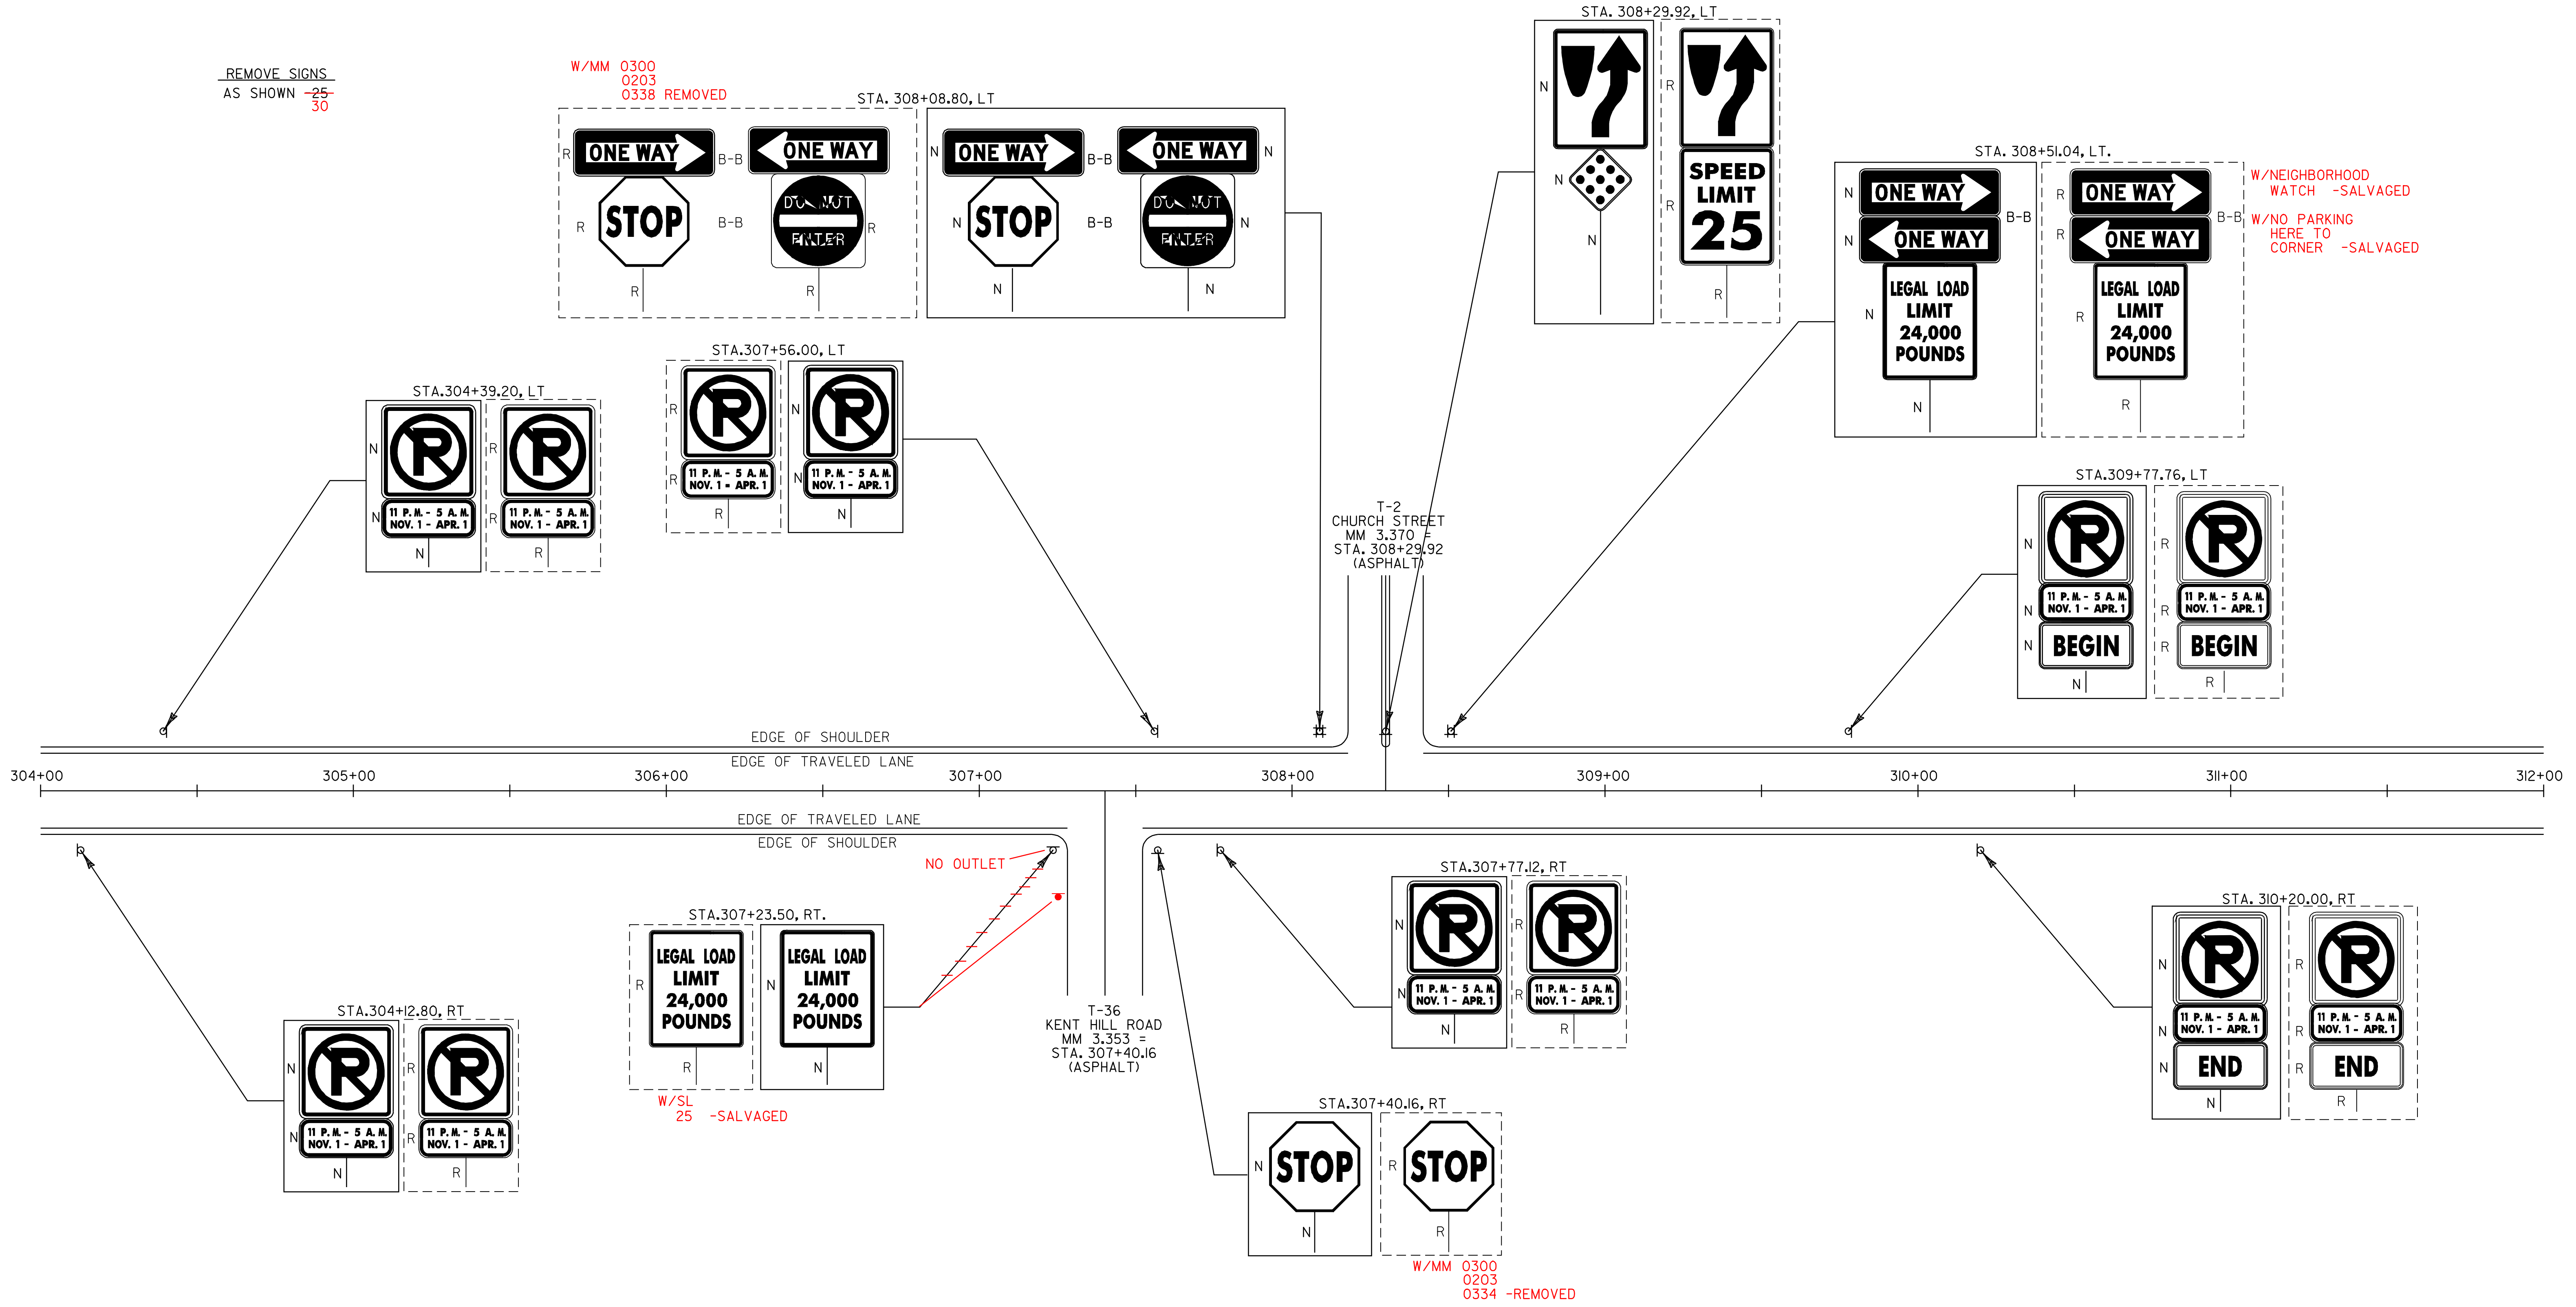

W/NEIGHBORHOOD  
WATCH -SALVAGED  
W/NO PARKING  
HERE TO  
CORNER -SALVAGED

W/SL  
25 -SALVAGED

W/MM 0300  
0203  
0334 -REMOVED

**VT ROUTE 30: 304+00 - 312+00**

PROJECT NAME:	MANCHESTER-PAWLET		
PROJECT NUMBER:	STPG_SIGN (14)		
FILE NAME:	STPG_SIGN_PROJECT.dwg	PLOT DATE:	22-APR-2009 16:...
PROJECT LEADER:	N. AVERY	DRAWN BY:	ROADWAY
DESIGNED BY:	N. AVERY	CHECKED BY:	A. GAMBLE
LAYOUT:	A4	SHEET:	25 OF 60

**SIGN LEGEND**

R=	REMOVE
S=	SALVAGE
N=	NEW
RET=	RETAIN
B-B=	BACK TO BACK
EXISTING=	EXISTING
NEW=	NEW