


REMOVE SIGNS
AS SHOWN ~~34~~
38

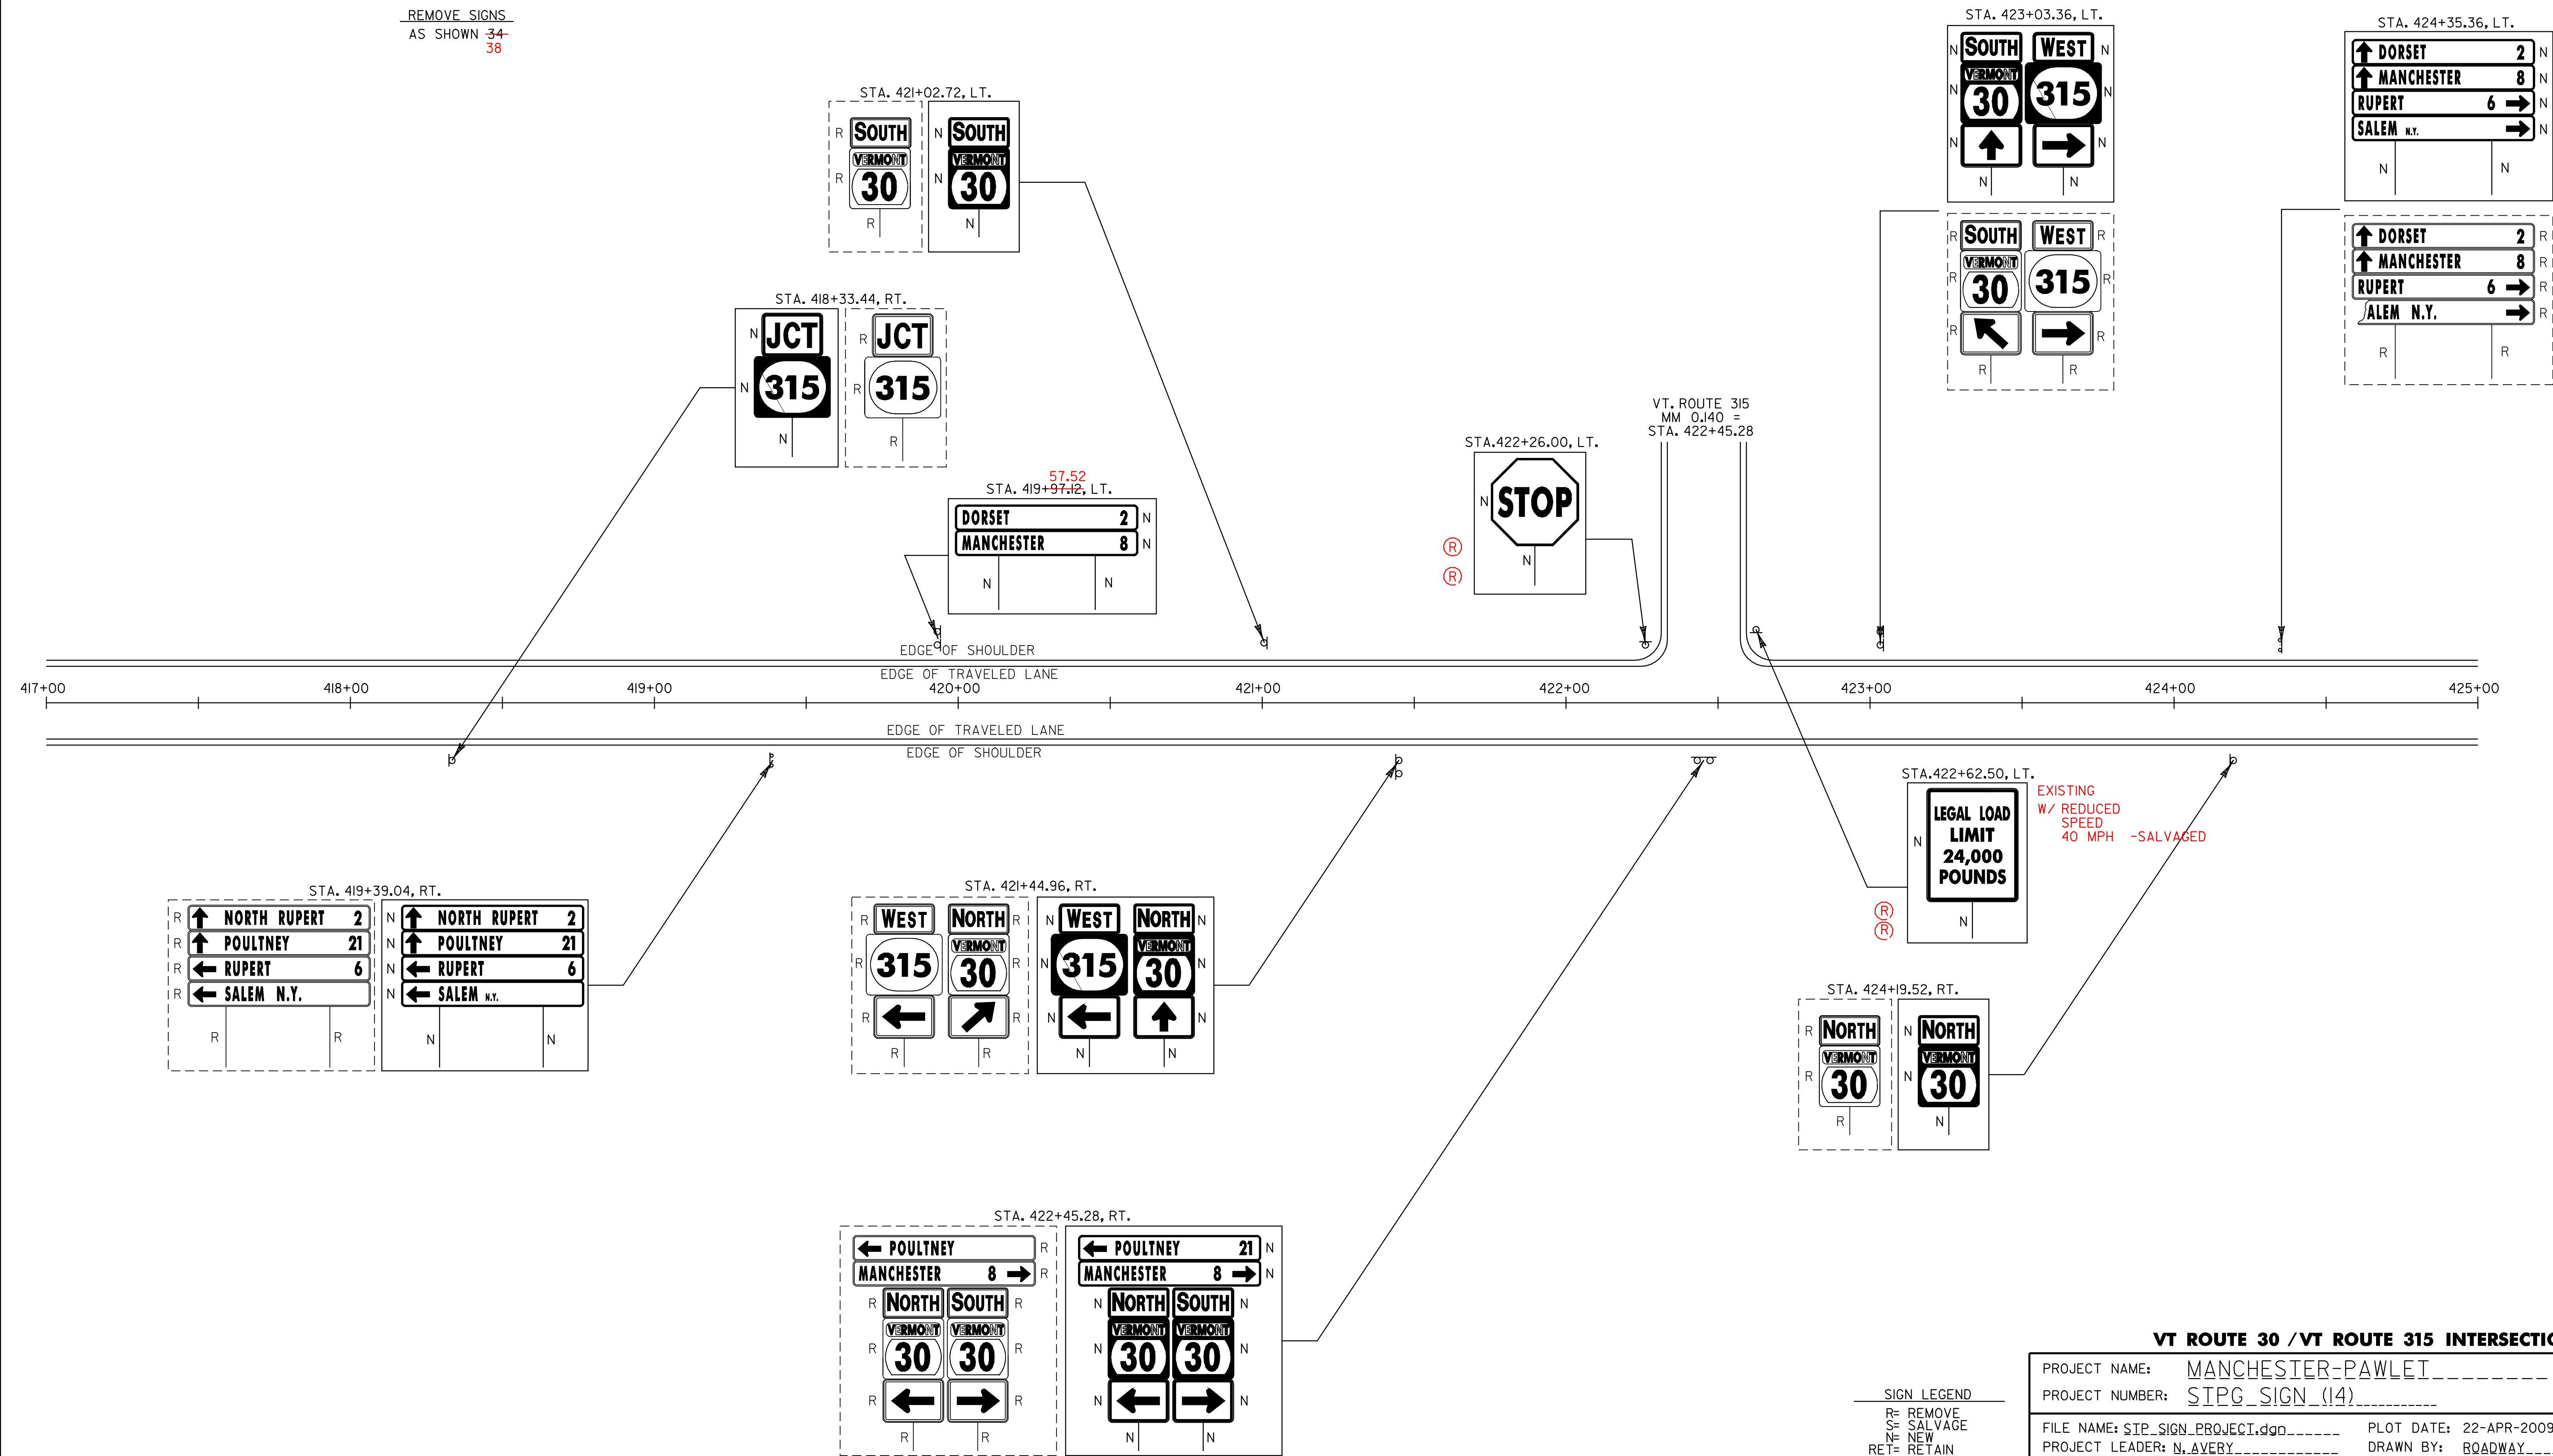

SIGN LEGEND
R= REMOVE
S= SALVAGE
N= NEW
RE= RETAIN
B-B= BACK TO BACK
EXISTING= _____
NEW= _____

VT ROUTE 30 / VT ROUTE 315 INTERSECTION

PROJECT NAME: MANCHESTER-PAWLET
PROJECT NUMBER: STPG_SIGN_(14)

FILE NAME: STPG_SIGN_PROJECT.dgn
PROJECT LEADER: N. AVERY
DESIGNED BY: N. AVERY
LAYOUT AS

PLOT DATE: 22-APR-2009 16:40
DRAWN BY: ROADWAY
CHECKED BY: A. GAMBLE
SHEET 26 OF 60