

604.412, 604.415 OR 604.418 REHAB.
Dis, CBS OR MHS, CLASS I, II OR III

MONTPELIER STATE HIGHWAY STA. 46+00, RT
MONTPELIER STATE HIGHWAY STA. 46+04, LT

616.28 CAST-IN-PLACE CONCRETE CURB, TYPE B

STA. 92+86 TO STA. 92+99, RT
STA. 92+87 TO STA. 93+01, LT

616.41 REMOVAL OF EXISTING CURB

STA. 92+86 TO STA. 92+99, RT
STA. 92+87 TO STA. 93+01, LT

618.10 PORTLAND CEMENT CONCRETE SIDEWALK, 5 INCH

STA. 92+86 TO STA. 92+99, RT
STA. 92+87 TO STA. 93+01, LT

618.30 DETECTABLE WARNING SURFACE

STA. 92+95, RT
STA. 92+95, LT

646.402 DURABLE 4 INCH WHITE LINE, THERMOPLASTIC

MONTPELIER STATE HIGHWAY STA. 45+09.12 TO 46+35, DASHED LT & RT
MONTPELIER STATE HIGHWAY STA. 45+09.12 TO 46+35, SOLID LT & RT
MONTPELIER STATE HIGHWAY STA. 46+35 TO 94+23, SOLID RT
STA. 92+00 TO 93+32, SOLID LT & RT
STA. 92+00 TO 92+84, SOLID LANE LINE RT
STA. 94+23 TO 95+00, SOLID LT & RT
STA. 94+38 TO 95+00, DASHED RT
STA. 94+38 TO 95+00, SOLID LT

646.412 DURABLE 4 INCH YELLOW LINE, THERMOPLASTIC

MONTPELIER STATE HIGHWAY STA. 45+09.12 TO 46+36, DOUBLE SOLID C
STA. 92+00 TO 92+85, DOUBLE SOLID C
STA. 94+38 TO 95+00, DOUBLE SOLID C

646.482 DURABLE 24 INCH STOP BAR, THERMOPLASTIC

MONTPELIER STATE HIGHWAY STA. 46+35, RT
STA. 92+84, RT
STA. 94+39, LT

646.492 DURABLE LETTER OR SYMBOL, THERMOPLASTIC

STA. 92+34, RT - ONLY (2)
STA. 92+74, RT - ARROW (2)
STA. 94+47, LT - ARROW

646.502 DURABLE CROSSWALK MARKING, THERMOPLASTIC

STA. 92+95, LT - RT

646.602 TEMPORARY 4 INCH WHITE LINE, PAINT

MONTPELIER STATE HIGHWAY STA. 45+09.12 TO 46+35, DASHED LT & RT
MONTPELIER STATE HIGHWAY STA. 45+09.12 TO 46+35, SOLID LT & RT
MONTPELIER STATE HIGHWAY STA. 46+35 TO 94+23, SOLID RT
STA. 92+00 TO 93+32, SOLID LT & RT
STA. 92+00 TO 92+84, SOLID LANE LINE RT
STA. 94+23 TO 95+00, SOLID LT & RT
STA. 94+38 TO 95+00, DASHED RT
STA. 94+38 TO 95+00, SOLID LT

646.612 TEMPORARY 4 INCH YELLOW LINE, PAINT



MONTPELIER STATE HIGHWAY STA. 45+09.12 TO 46+36, DOUBLE SOLID C
STA. 92+00 TO 92+85, DOUBLE SOLID C
STA. 94+38 TO 95+00, DOUBLE SOLID C

646.682 TEMPORARY 24 INCH STOP BAR, PAINT

MONTPELIER STATE HIGHWAY STA. 46+35, RT
STA. 92+84, RT
STA. 94+39, LT

LIMIT OF WORK
MONTPELIER STATE HIGHWAY
STA. 45+09.12 = MM 0.854

MONTPELIER STATE HIGHWAY

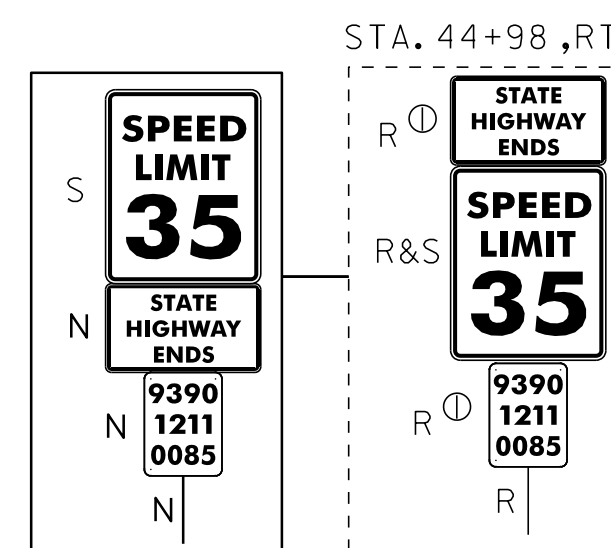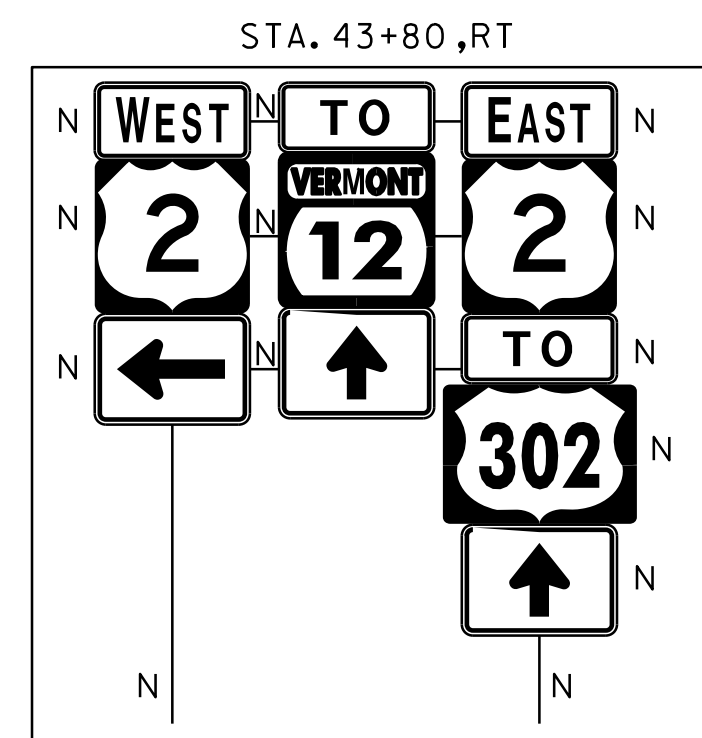

646.692 TEMPORARY LETTER OR SYMBOL, PAINT

STA. 92+74, RT - ARROW (2)
STA. 94+47, LT - ARROW

646.702 TEMPORARY CROSSWALK MARKING, PAINT

STA. 92+95, LT - RT

675.50 REMOVING SIGNS (TYPE A)

AS SHOWN - 20

675.50 REMOVING SIGNS (TYPE B)

AS SHOWN - 3

675.60 ERECTING SALVAGED SIGNS

AS SHOWN - 4

900.620 SPECIAL PROVISION (REMOVE EXISTING OVERHEAD SIGN ASSEMBLY - CANTILEVER)

MONTPELIER STATE HIGHWAY STA. 45+54, RT
STA. 92+49, RT

REMOVAL OF OVERHEAD SIGN ASSEMBLY TO BE PAID AS ITEM 900.620 SPECIAL PROVISION (REMOVE EXISTING OVERHEAD SIGN ASSEMBLY - CANTILEVER)

MOUNT ON EXISTING STRAIN POLE

STA. 92+95, RT
CONSTRUCT SIDEWALK RAMP, TYPE 6

STA. 92+97, RT
MEMORIAL DRIVE
BAILEY AVE EXT

SEE SHEET 64 FOR RAILROAD CROSSING DETAIL

* MATCH EXISTING PAVEMENT MARKINGS

REMOVAL OF OVERHEAD SIGN ASSEMBLY TO BE PAID AS ITEM 900.620 SPECIAL PROVISION (REMOVE EXISTING OVERHEAD SIGN ASSEMBLY - CANTILEVER)

NOTE:
1. FOR LEGENDS, SEE LAYOUT SHEET #1.
2. ALL EXISTING SIGNS NOT SHOWN SHALL BE RETAINED AS DIRECTED BY THE RESIDENT ENGINEER.



NOT TO SCALE

PROJECT LAYOUT SHEET #3

PROJECT NAME: MONTPELIER
PROJECT NUMBER: NH 2604(I)

FILE NAME: p06b034.dgn
PROJECT LEADER: JLL
DESIGNED BY: MCF
IPARM FILE: p06b034i03.i

PLOT DATE: 03-AUG-2011 4:07
DRAWN BY: STANTEC
CHECKED BY: JLL
SHEET 20 OF 84