
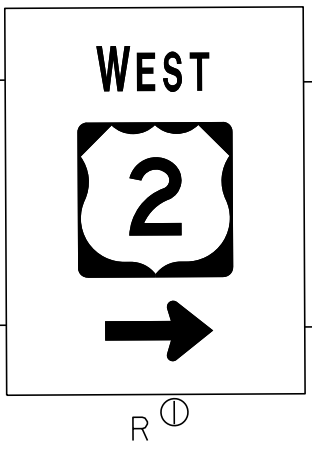


604.412, 604.415 OR 604.418 REHAB.
Dis, CBS OR MHS, CLASS I, II OR III


STA. 95+21, LT
STA. 95+21, RT
STA. 97+23, LT
STA. 97+25, RT
STA. 99+41, LT
STA. 99+41, RT

STA. 95+23, LT
OVERHEAD

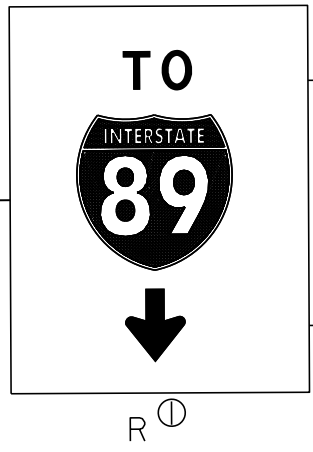


REMOVAL OF OVERHEAD SIGN ASSEMBLY
TO BE PAID AS ITEM 900.620 SPECIAL
PROVISION (REMOVE EXISTING OVERHEAD
SIGN ASSEMBLY - CANTILEVER)


STA. 95+40, LT

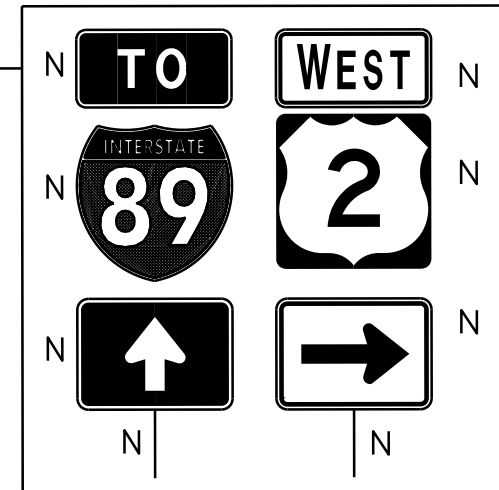


STA. 96+43, LT

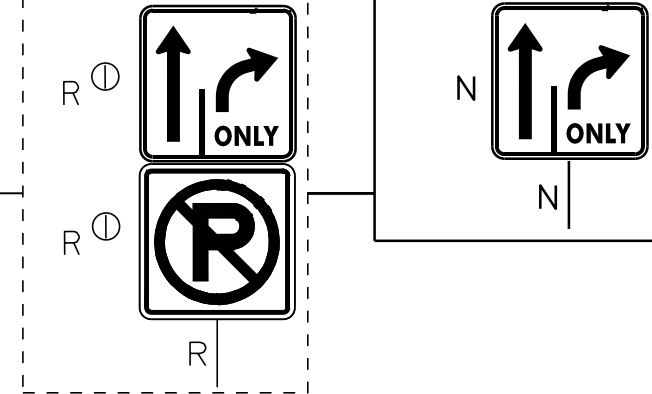


STA. 97+55, LT

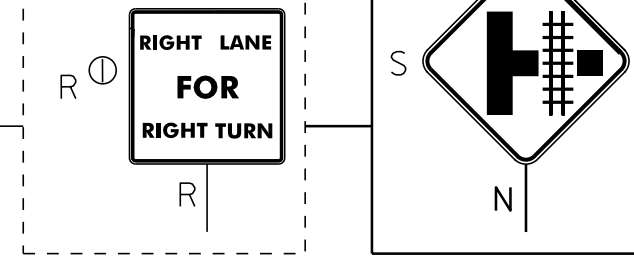

STA. 99+19, LT

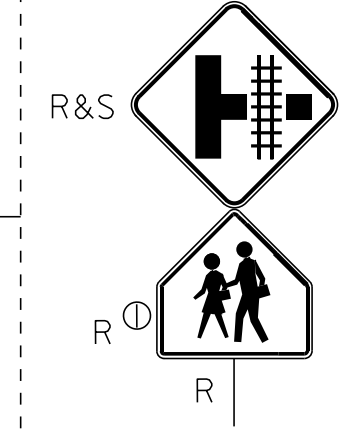

STA. 100+50, LT

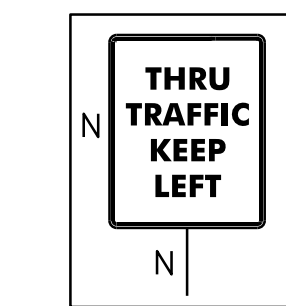

646.402 DURABLE 4 INCH WHITE LINE, THERMOPLASTIC

STA. 95+00 TO 101+00, SOLID LT & RT
STA. 95+00 TO 96+43, SOLID LANE LINE LT
STA. 95+00 TO 101+00, DASHED RT
STA. 96+43 TO 101+00, DASHED LT

646.412 DURABLE 4 INCH YELLOW LINE, THERMOPLASTIC

STA. 95+00 TO 101+00, SOLID LT & RT

646.492 DURABLE LETTER OR SYMBOL, THERMOPLASTIC

STA. 95+10, LT - ONLY
STA. 95+75, LT - ARROW
STA. 96+46, LT - ONLY

646.602 TEMPORARY 4 INCH WHITE LINE, PAINT

STA. 95+00 TO 101+00, SOLID LT & RT
STA. 95+00 TO 96+43, SOLID LANE LINE LT
STA. 95+00 TO 101+00, DASHED RT
STA. 96+43 TO 101+00, DASHED LT

646.612 TEMPORARY 4 INCH YELLOW LINE, PAINT

STA. 95+00 TO 101+00, SOLID LT & RT

646.692 TEMPORARY LETTER OR SYMBOL, PAINT

STA. 95+75, LT - ARROW

675.50 REMOVING SIGNS (TYPE A)

AS SHOWN - 9

675.50 REMOVING SIGNS (TYPE B)


AS SHOWN - 2

675.60 ERECTING SALVAGED SIGNS


AS SHOWN - 1

900.620 SPECIAL PROVISION (REMOVE EXISTING OVERHEAD
SIGN ASSEMBLY-CANTILEVER)


STA. 95+23, LT

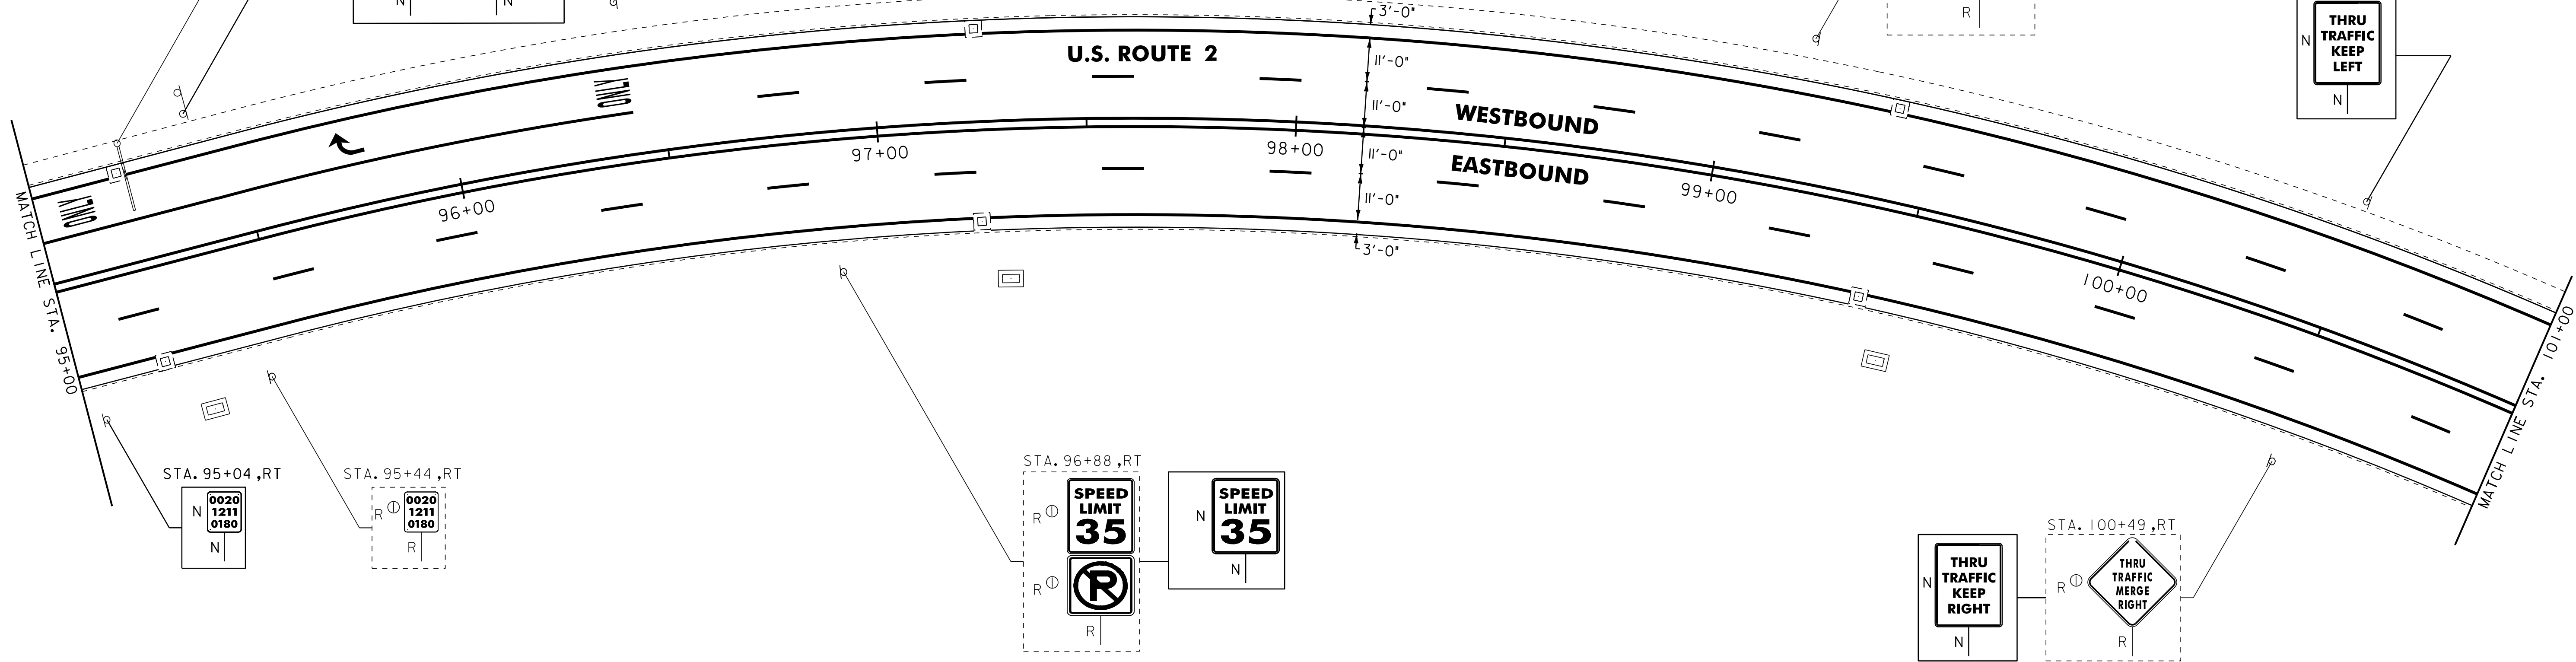


STA. 95+04, RT

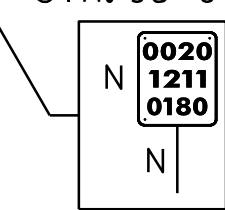


STA. 95+44, RT

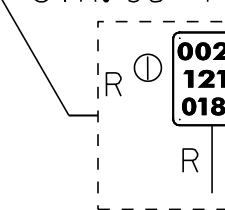

STA. 96+88, RT

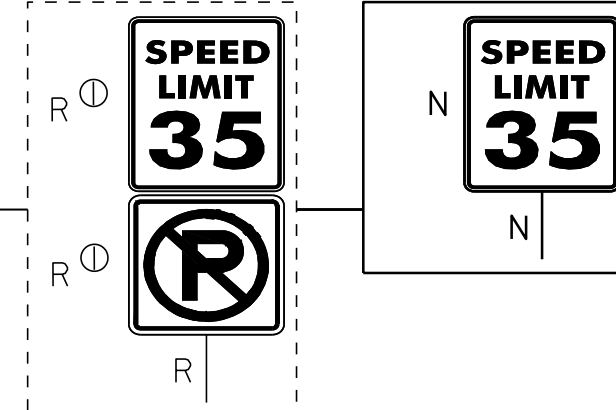

STA. 100+49, RT

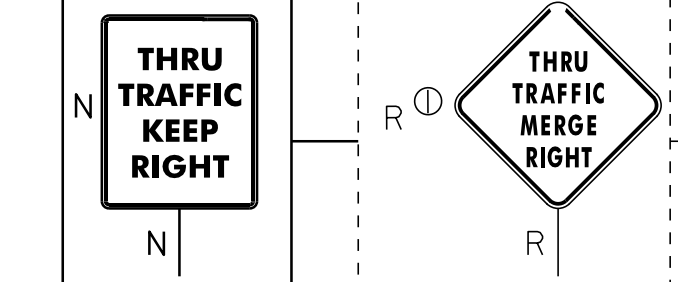

NOTE:

- FOR LEGENDS, SEE LAYOUT SHEET #1.
- ALL EXISTING SIGNS NOT SHOWN SHALL BE RETAINED AS DIRECTED BY THE RESIDENT ENGINEER.

NOT TO SCALE



**PROJECT
LAYOUT
SHEET #4**

PROJECT NAME: MONTPELIER
PROJECT NUMBER: NH 2604(I)

FILE NAME: p06b034.dgn
PROJECT LEADER: JLL
DESIGNED BY: MCF
IPARM FILE: p06b034i04.i

PLOT DATE: 03-AUG-2011 4:07
DRAWN BY: STANTEC
CHECKED BY: JLL
SHEET 21 OF 84