

604.412, 604.415 OR 604.418 REHAB,
DIS, CBS OR MHS, CLASS I, II OR III

STA. 119+36, RT
STA. 119+87, RT
STA. 121+00, RT
STA. 121+67, RT
STA. 122+03, RT
STA. 123+00, RT

604.42 CHANGING ELEVATION OF SEWER MANHOLES

STA. 119+55, RT
STA. 122+65, LT
STA. 122+70, C

629.20 ADJUST ELEVATION OF VALVE BOX

STA. 119+56, RT
STA. 122+58, RT
STA. 124+05, RT
STA. 124+18, RT

618.10 5" PCC SIDEWALK
STA. 119+47, RT

618.30 DETECTABLE WARNING SURFACE
STA. 119+47, RT

646.402 DURABLE 4 INCH WHITE LINE, THERMOPLASTIC

(ALL LINES WILL INCLUDE EDGE LINE AND LANE LINE BREAKS AND RADIUS FOR SIDE ROADS)
STA. 119+00 TO 125+00, SOLID LT & RT
STA. 119+00 TO 122+71, DASHED LT
STA. 119+00 TO 120+67, DOTTED RT
STA. 119+58, DOUBLE SOLID RT (SCHOOL AVENUE)

646.412 DURABLE 4 INCH YELLOW LINE, THERMOPLASTIC

(ALL LINES WILL INCLUDE C BREAKS FOR SIDE ROADS)
STA. 119+00 TO 125+00, DOUBLE SOLID RT
STA. 119+58, DOUBLE SOLID RT (SCHOOL AVENUE)

646.482 DURABLE 24 INCH STOP BAR, THERMOPLASTIC
STA. 119+66, RT (SCHOOL AVENUE)

646.492 DURABLE LETTER OR SYMBOL, THERMOPLASTIC
STA. 119+66, RT - "STOP"

646.502 DURABLE CROSSWALK MARKING, THERMOPLASTIC
STA. 119+58, RT

646.492 DURABLE LETTER OR SYMBOL

STA. 119+60, LT - ARROW - "ONLY"
STA. 120+60, LT - ARROW - "ONLY"
STA. 121+60, LT - ARROW - "ONLY"

646.602 TEMPORARY 4 INCH WHITE LINE, PAINT

(ALL LINES WILL INCLUDE EDGE LINE AND LANE LINE BREAKS AND RADIUS FOR SIDE ROADS)
STA. 119+00 TO 125+00, SOLID LT & RT
STA. 119+00 TO 122+71, DASHED LT
STA. 119+00 TO 120+67, DOTTED RT
STA. 119+58, DOUBLE SOLID RT (SCHOOL AVENUE)









646.612 TEMPORARY 4 INCH YELLOW LINE, PAINT
(ALL LINES WILL INCLUDE C BREAKS FOR SIDE ROADS)
STA. 119+00 TO 125+00, DOUBLE SOLID RT
STA. 119+58, DOUBLE SOLID RT (SCHOOL AVENUE)

646.682 TEMPORARY 24 INCH STOP BAR, PAINT
STA. 119+66, RT (SCHOOL AVENUE)

646.702 TEMPORARY CROSSWALK MARKING, PAINT
STA. 119+58, RT

675.50 REMOVING SIGNS (TYPE A)
AS SHOWN - 10

675.60 ERECTING SALVAGED SIGNS
AS SHOWN - 2

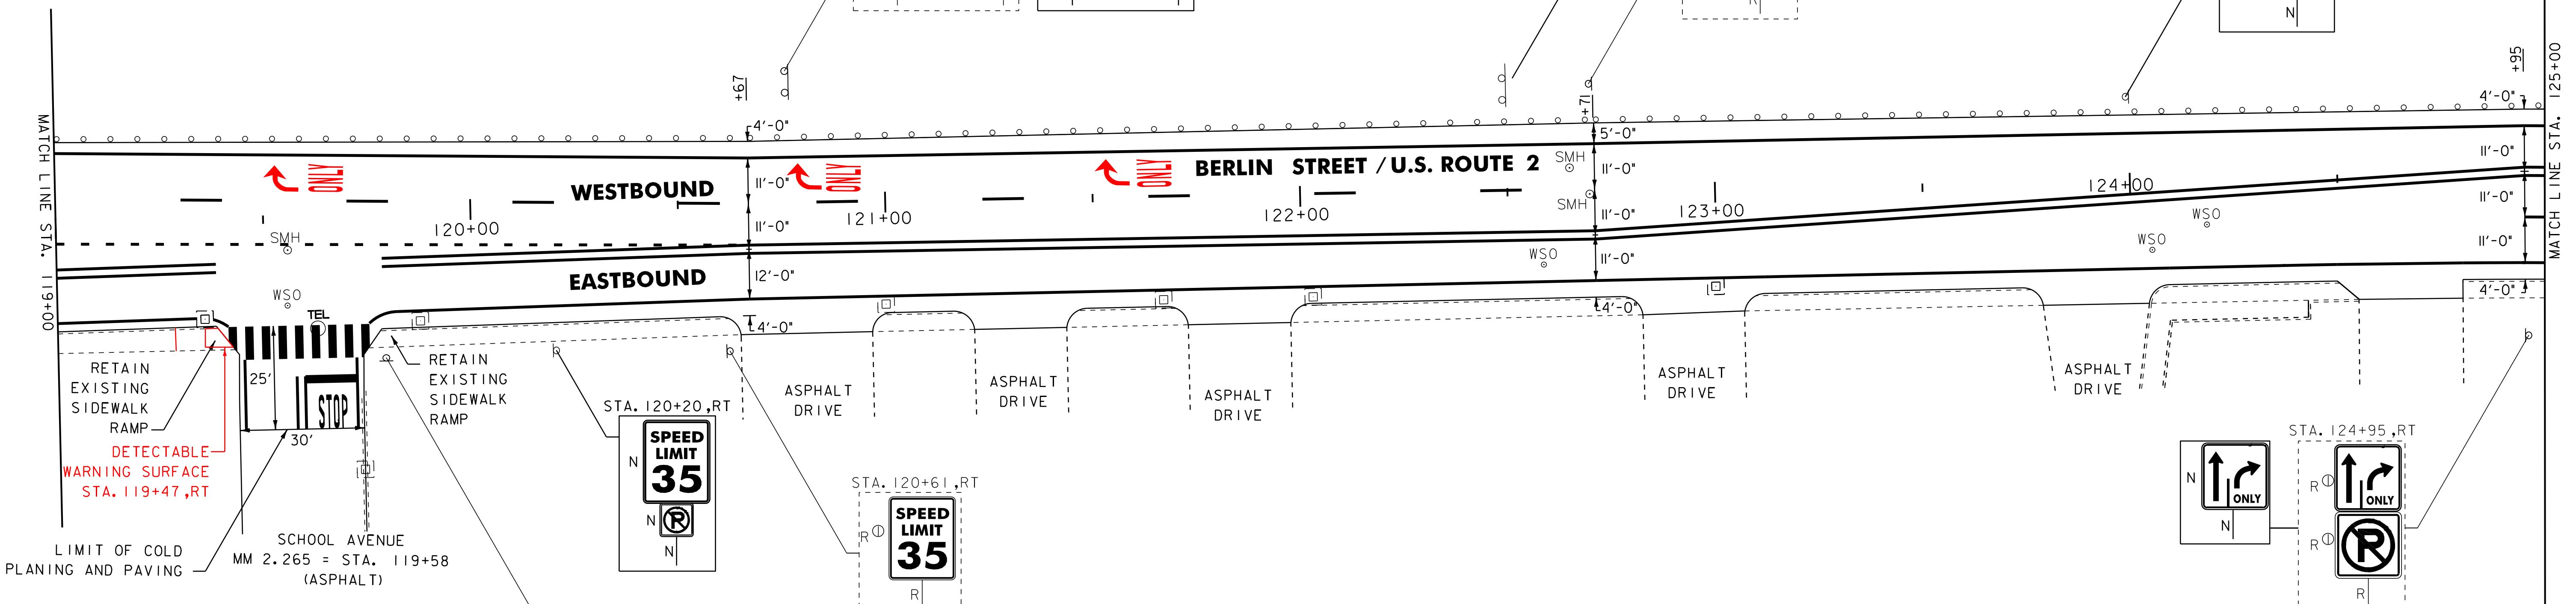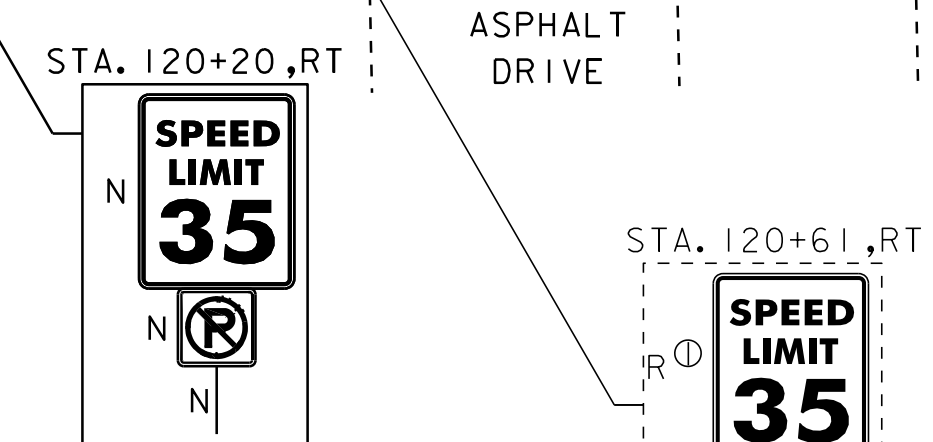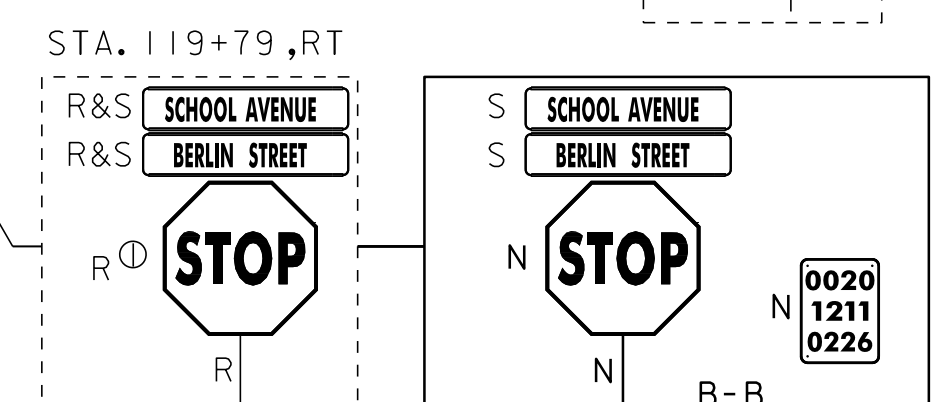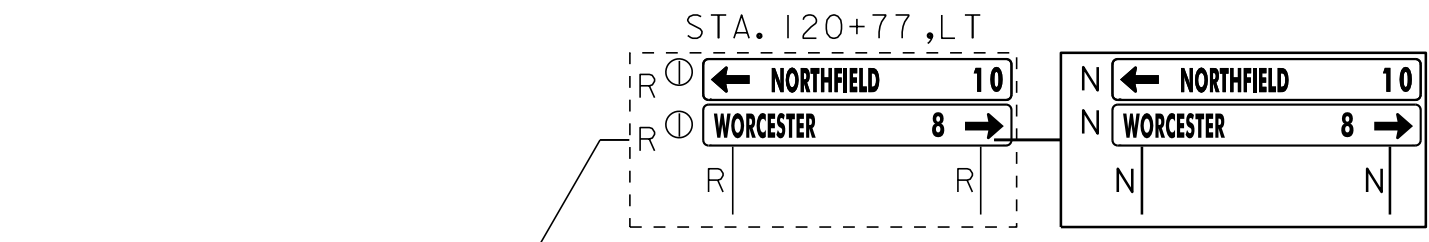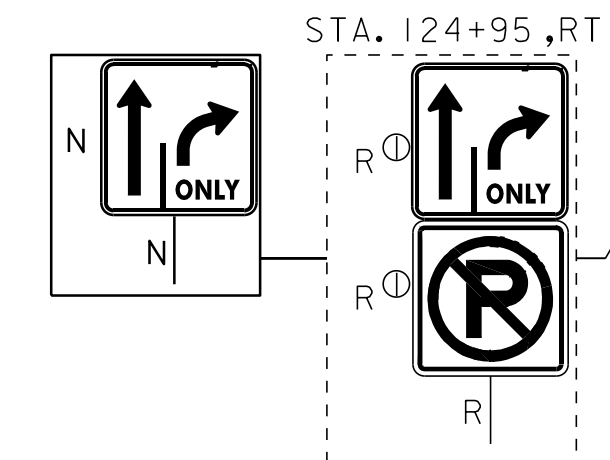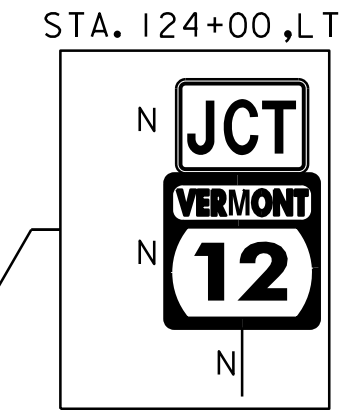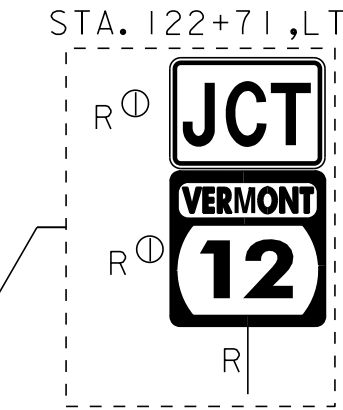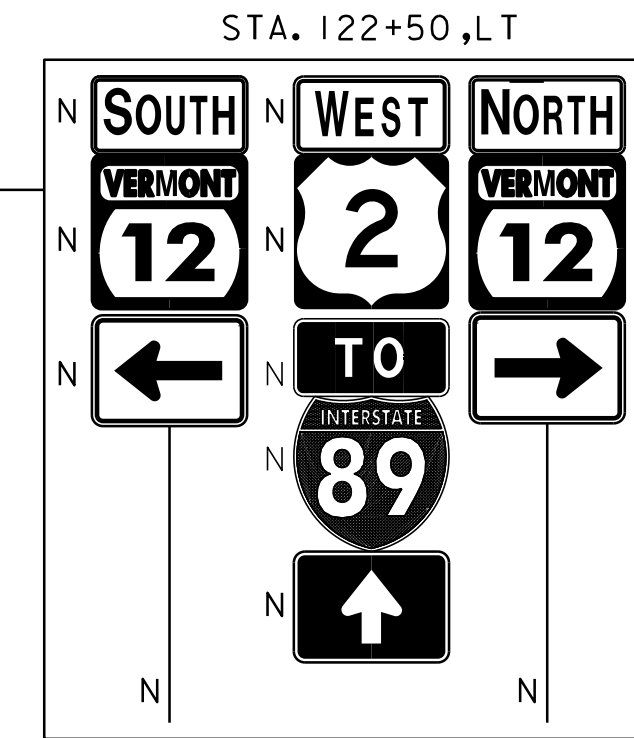

NOTE:
1. FOR LEGENDS, SEE LAYOUT SHEET #1.
2. ALL EXISTING SIGNS NOT SHOWN SHALL BE RETAINED AS DIRECTED BY THE RESIDENT ENGINEER.

NOT TO SCALE



PROJECT LAYOUT SHEET #8

PROJECT NAME: MONTPELIER	PLOT DATE: 03-AUG-2011 4:08
PROJECT NUMBER: NH 2604(1)	DRAWN BY: STANTEC
FILE NAME: p06b034.dgn	CHECKED BY: JLL
PROJECT LEADER: JLL	SHEET 25 OF 84
DESIGNED BY: MCF	
IPARM FILE: p06b034108.i	