

604.412, 604.415 OR 604.418 REHAB,  
Dis, CBs OR MHS, CLASS I, II OR III

STA. 125+03, RT  
STA. 126+35, RT  
STA. 127+87, RT  
STA. 129+85, RT

604.42 CHANGING ELEVATION OF SEWER MANHOLES  
STA. 129+79, LT

629.20 ADJUST ELEVATION OF VALVE BOX

STA. 126+25, RT  
STA. 128+51, RT  
STA. 128+56, RT  
STA. 129+16, RT

646.402 DURABLE 4 INCH WHITE LINE, THERMOPLASTIC

STA. 125+00 TO 131+00, SOLID LT & RT  
STA. 125+00 TO 131+00, DASHED RT

646.412 DURABLE 4 INCH YELLOW LINE, THERMOPLASTIC

STA. 125+00 TO 131+00, SOLID LT & RT

646.602 TEMPORARY 4 INCH WHITE LINE, PAINT


STA. 125+00 TO 131+00, SOLID LT & RT  
STA. 125+00 TO 131+00, DASHED RT

646.612 TEMPORARY 4 INCH YELLOW LINE, PAINT

STA. 125+00 TO 131+00, SOLID LT & RT

675.50 REMOVING SIGNS (TYPE A)

AS SHOWN - 2

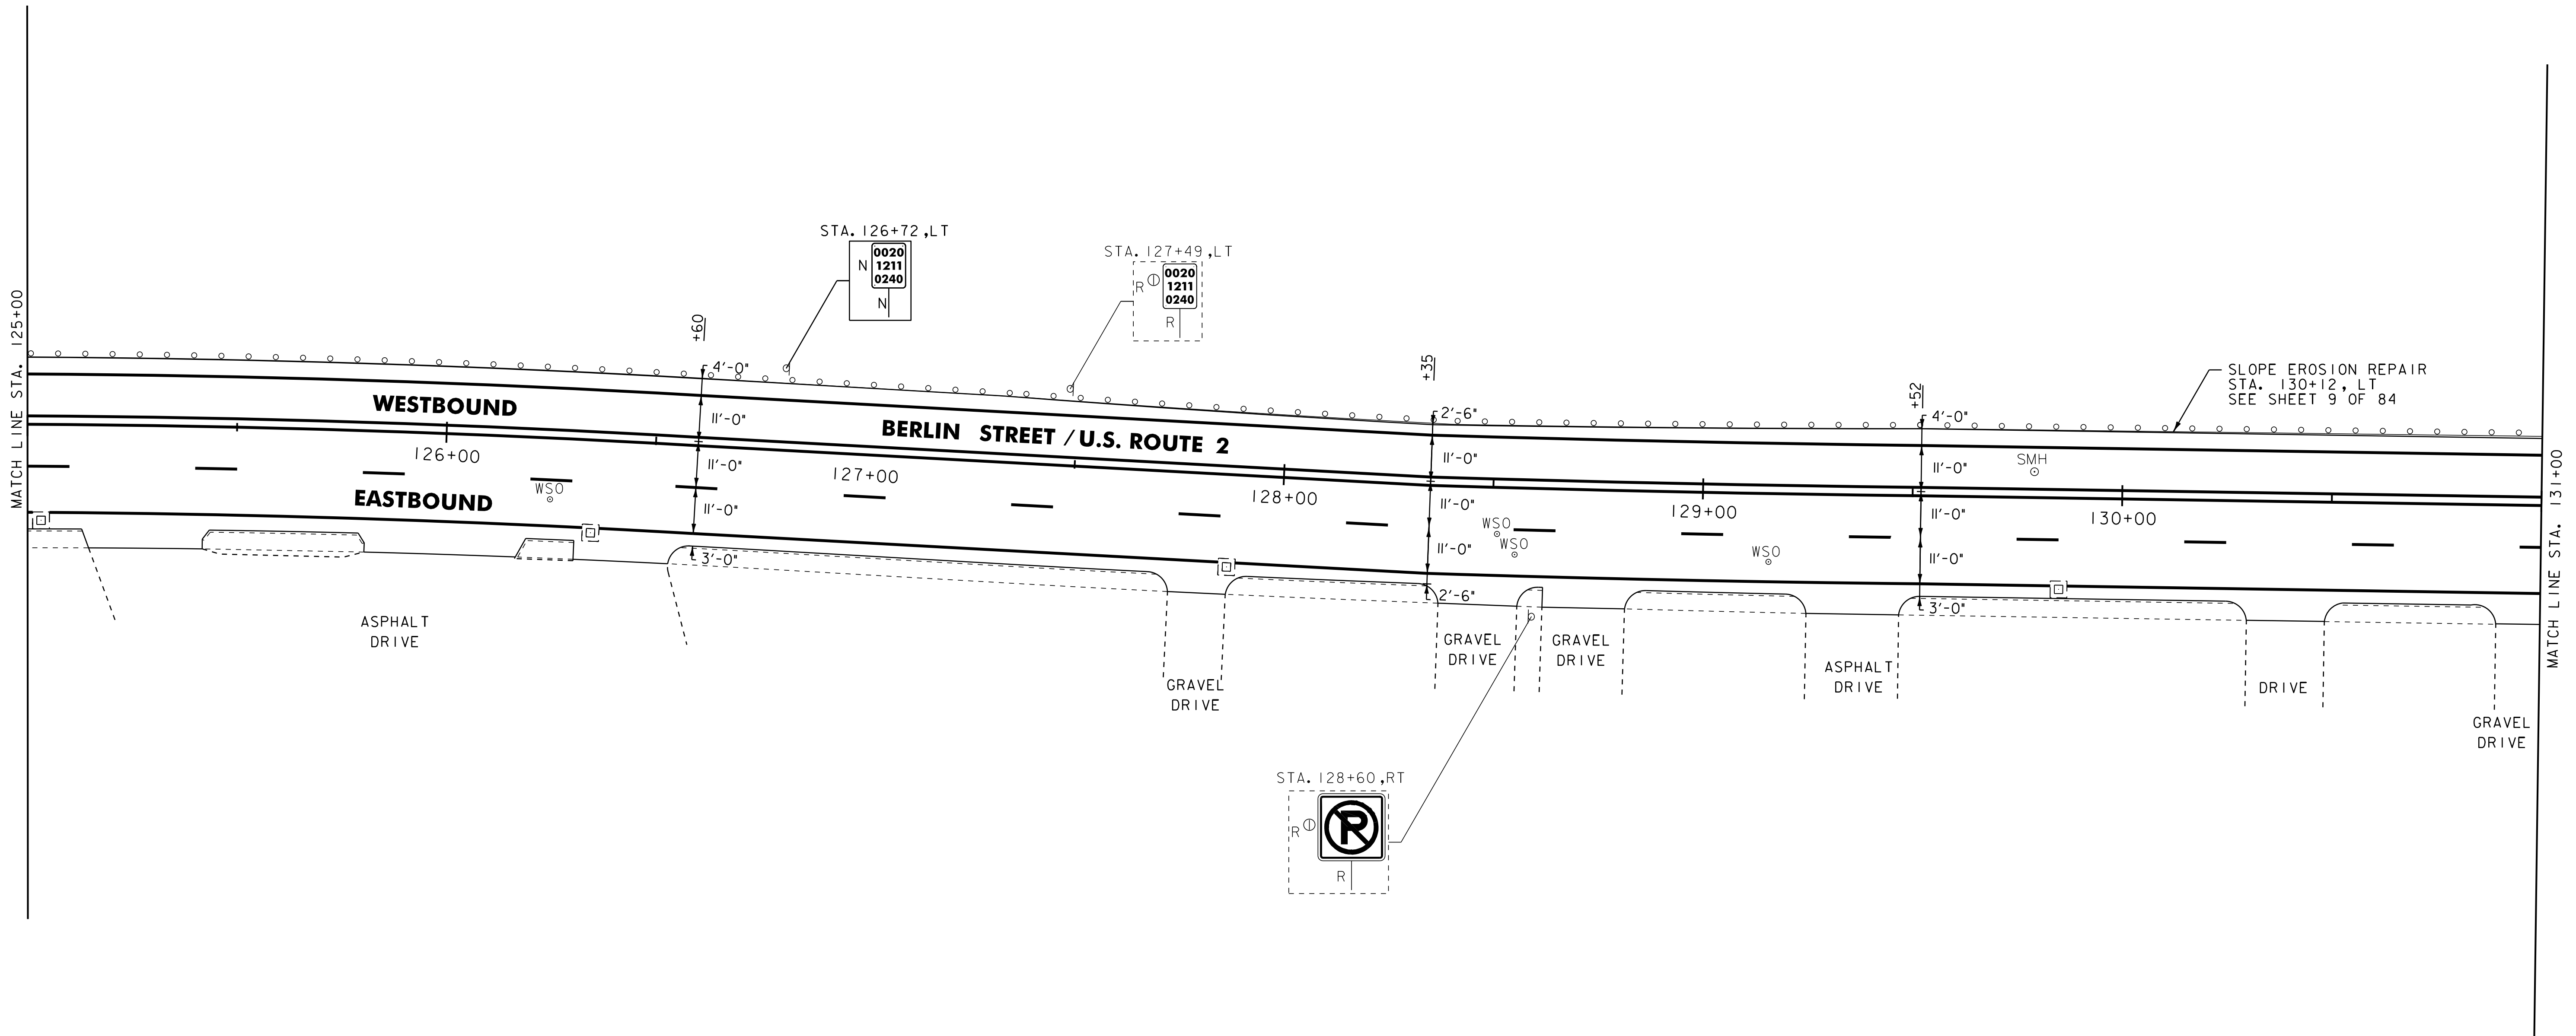

- NOTE:
1. FOR LEGENDS, SEE LAYOUT SHEET #1.
  2. ALL EXISTING SIGNS NOT SHOWN SHALL BE RETAINED AS DIRECTED BY THE RESIDENT ENGINEER.

NOT TO SCALE



**PROJECT LAYOUT SHEET #9**

PROJECT NAME: MONTPELIER  
PROJECT NUMBER: NH 2604(I)

FILE NAME: p06b034.dgn  
PROJECT LEADER: JLL  
DESIGNED BY: MCF  
IPARM FILE: p06b034i09.i

PLOT DATE: 03-AUG-2011 14:08  
DRAWN BY: STANTEC  
CHECKED BY: JLL  
SHEET 26 OF 84