

604.412, 604.415 OR 604.418 REHAB.
DIS, CBS OR MHS, CLASS I, II OR III
STA. 155+74, RT
STA. 157+14, RT
STA. 158+49, RT

604.42 CHANGING ELEVATION OF SEWER MANHOLES
STA. 158+36, RT

616.28 CAST-IN-PLACE CONCRETE CURB, TYPE B
STA. 157+85 TO STA. 158+10, RT
STA. 158+53 TO STA. 158+66, RT

616.41 REMOVAL OF EXISTING CURB
STA. 157+85 TO STA. 158+10, RT
STA. 158+53 TO STA. 158+66, RT

618.30 DETECTABLE WARNING SURFACE
STA. 158+02, RT
STA. 158+60, RT

618.10 PORTLAND CEMENT CONCRETE SIDEWALK, 5 INCH
STA. 157+85 TO STA. 158+10, RT
STA. 158+53 TO STA. 158+66, RT

621.20 STEEL BEAM GUARDRAIL, GALVANIZED
STA. 158+61.5 TO STA. 158+74.0, LT

621.60 ANCHOR FOR STEEL BEAM RAIL
STA. 158+74, LT

621.80 REMOVAL AND DISPOSAL OF GUARDRAIL
STA. 158+61.5 TO STA. 158+74.0, LT

629.20 ADJUST ELEVATION OF VALVE BOX
STA. 158+67, LT

646.402 DURABLE 4 INCH WHITE LINE, THERMOPLASTIC
(ALL LINES WILL INCLUDE EDGE LINE AND LANE LINE
BREAKS AND RADIUS FOR SIDE ROADS)
STA. 153+00 TO 159+00, SOLID LT & RT
STA. 158+51, DOUBLE SOLID RT (PHELPS STREET)

646.412 DURABLE 4 INCH YELLOW LINE, THERMOPLASTIC
(ALL LINES WILL INCLUDE C BREAKS FOR SIDE ROADS)
STA. 153+00 TO 159+00, SOLID LT & RT
STA. 158+51, DOUBLE SOLID RT (PHELPS STREET)

646.482 DURABLE 24 INCH STOP BAR, THERMOPLASTIC
STA. 158+45, RT (PHELPS STREET)

646.492 DURABLE LETTER OR SYMBOL, THERMOPLASTIC
STA. 158+45, RT - "STOP" (PHELPS STREET)

646.502 DURABLE CROSSWALK MARKING, THERMOPLASTIC
STA. 158+39, RT

646.602 TEMPORARY 4 INCH WHITE LINE, PAINT
(ALL LINES WILL INCLUDE C BREAKS FOR SIDE ROADS)
STA. 153+00 TO 159+00, SOLID LT & RT
STA. 158+51, DOUBLE SOLID RT (PHELPS STREET)



646.612 TEMPORARY 4 INCH YELLOW LINE, PAINT
(ALL LINES WILL INCLUDE C BREAKS FOR SIDE ROADS)
STA. 153+00 TO 159+00, SOLID LT & RT
STA. 158+51, DOUBLE SOLID RT (PHELPS STREET)

646.682 TEMPORARY 24 INCH STOP BAR, PAINT
STA. 158+45, RT (PHELPS STREET)

646.702 TEMPORARY CROSSWALK MARKING, PAINT
STA. 158+39, RT

675.50 REMOVING SIGNS (TYPE A)
AS SHOWN - 7

675.60 ERECTING SALVAGED SIGNS
AS SHOWN - 3

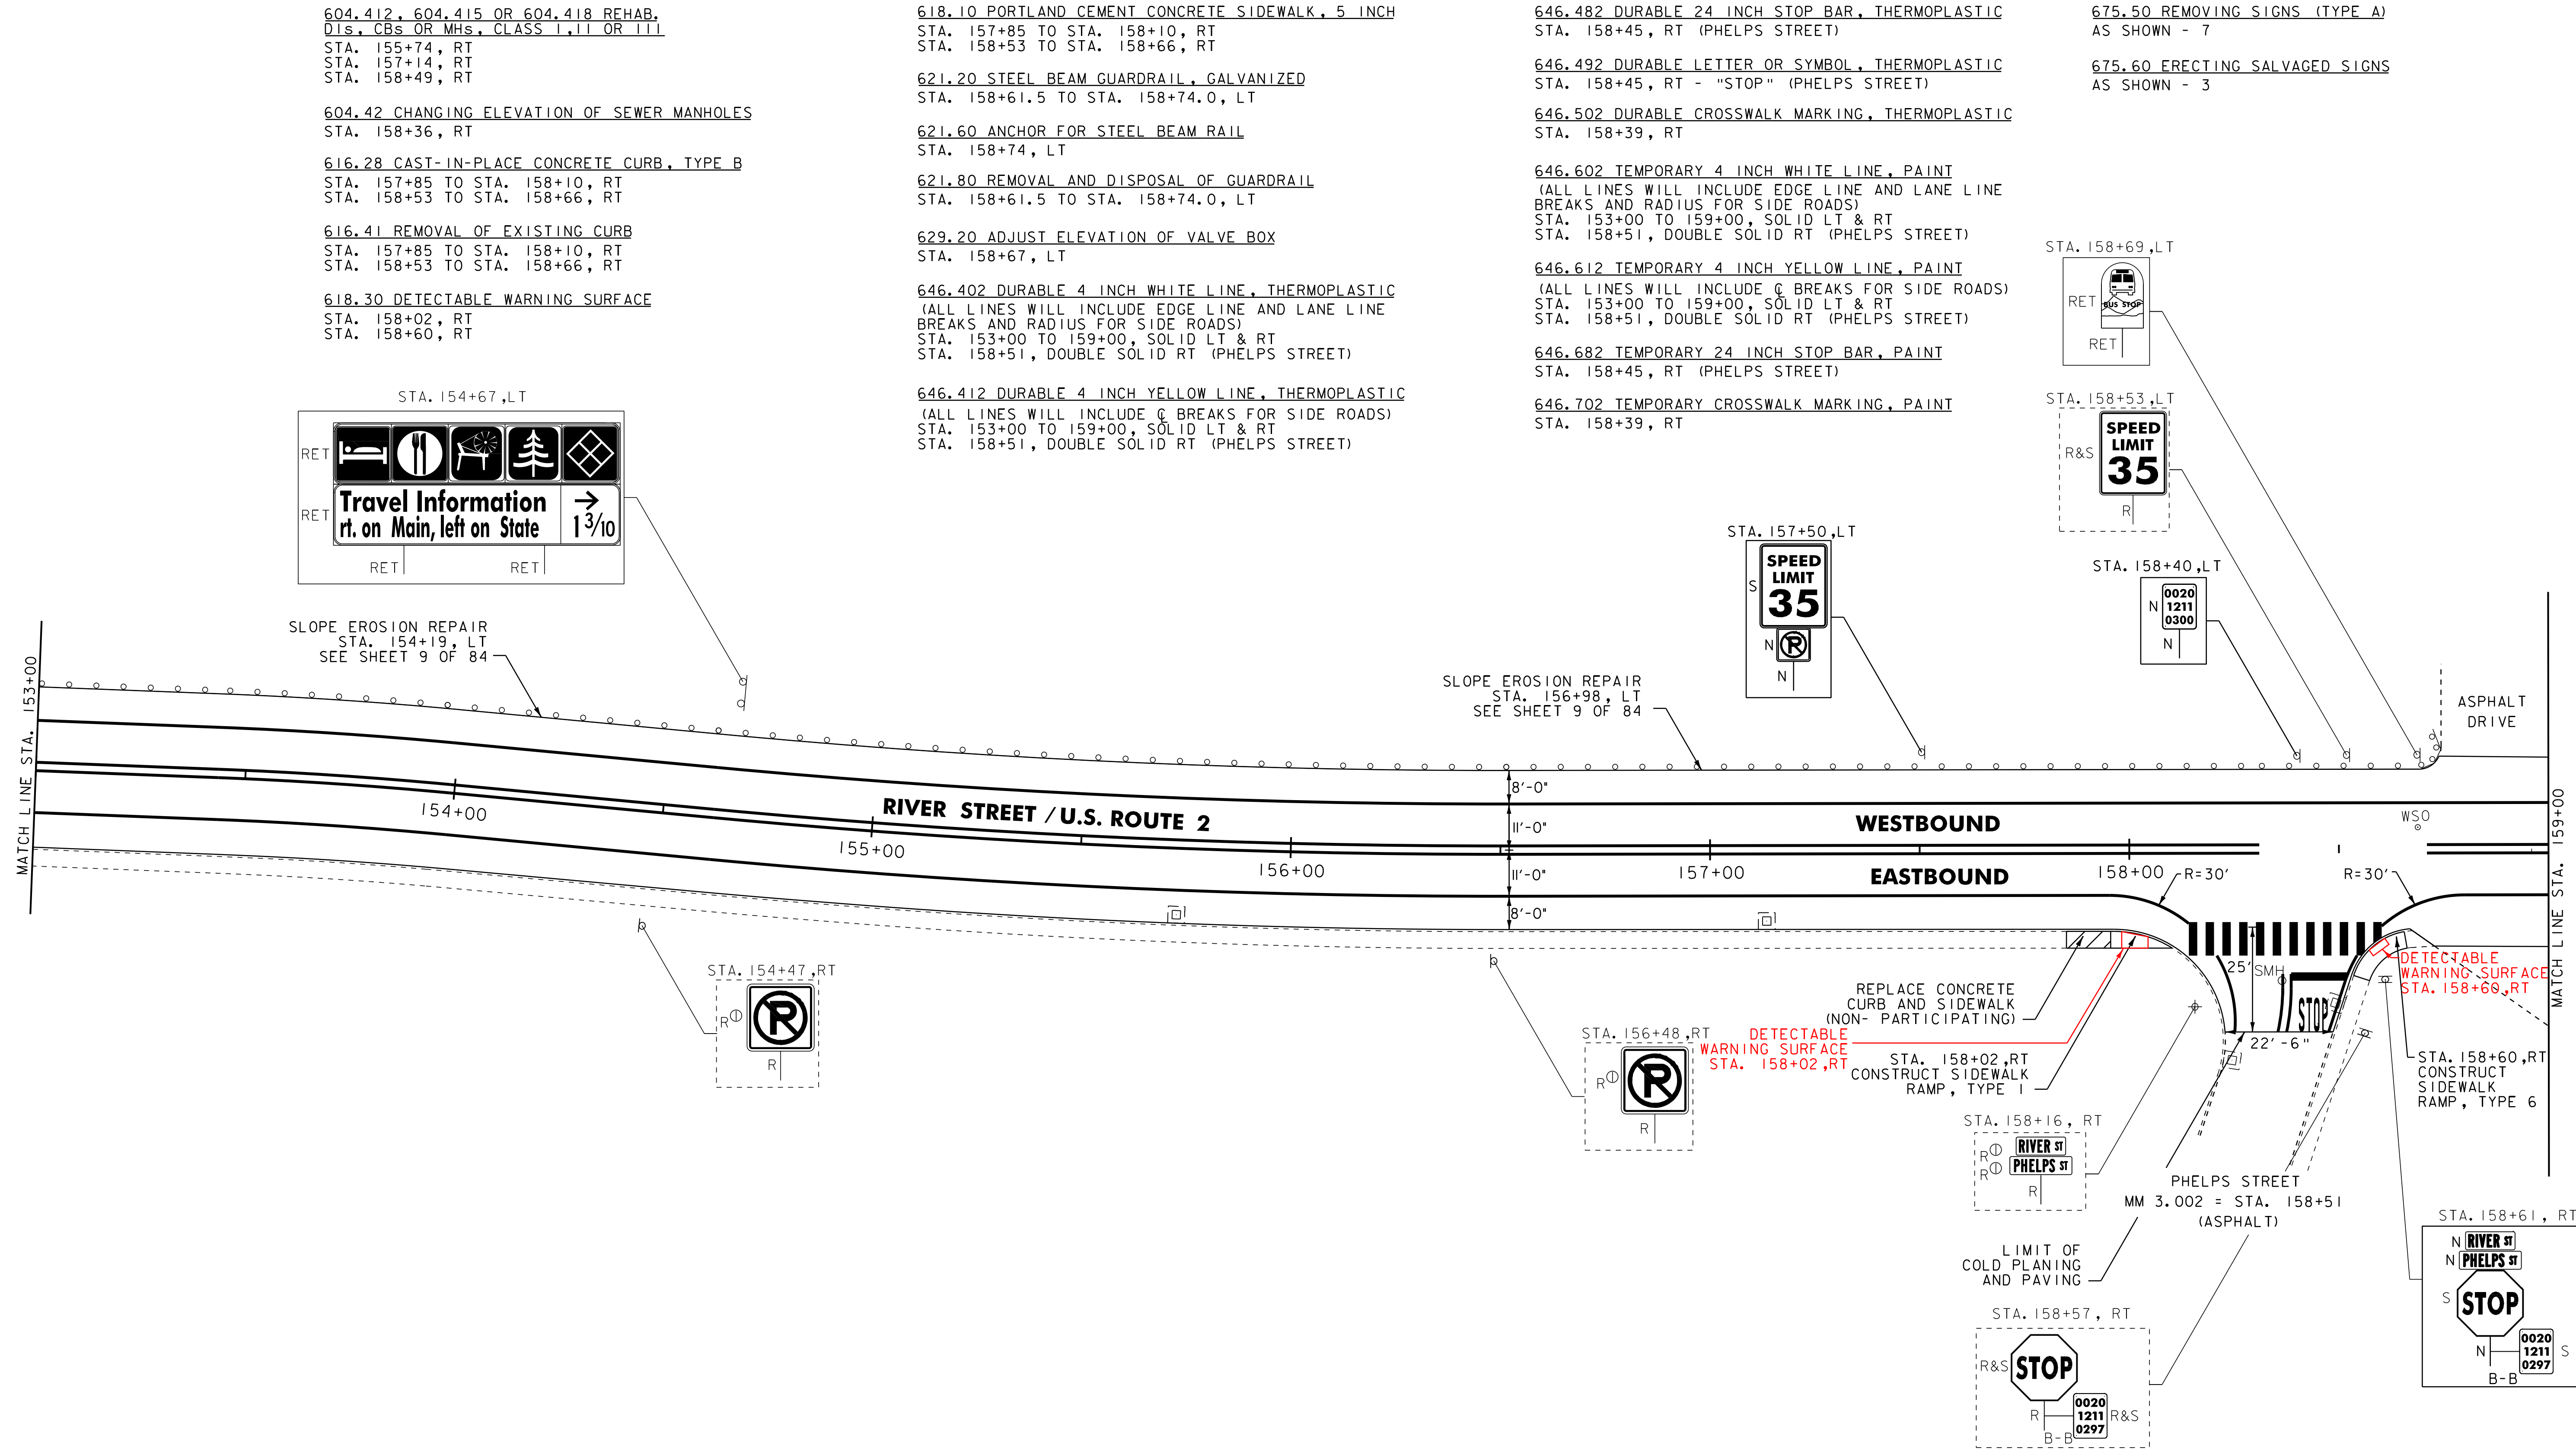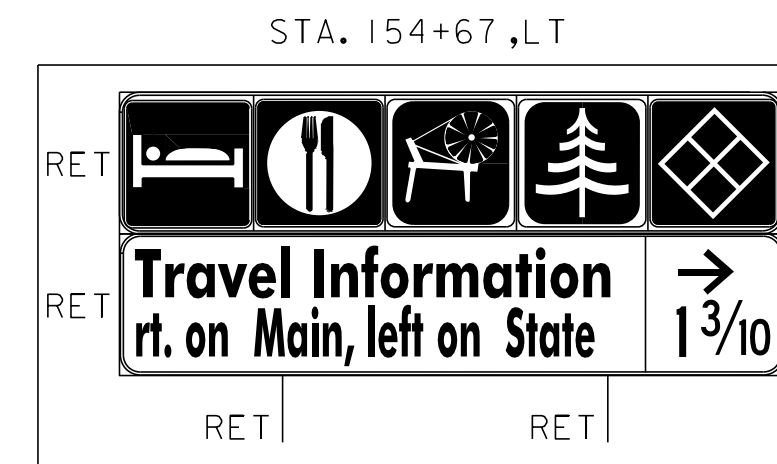

- NOTE:
- FOR LEGENDS, SEE LAYOUT SHEET #1.
 - ALL EXISTING SIGNS NOT SHOWN SHALL BE RETAINED AS DIRECTED BY THE RESIDENT ENGINEER.



<p>PROJECT LAYOUT SHEET #14</p>	<p>PROJECT NAME: MONTPELIER</p>	
	<p>PROJECT NUMBER: NH 2604(1)</p>	
	<p>FILE NAME: p06b034.dgn</p>	<p>PLOT DATE: 03-AUG-2011 14:08</p>
	<p>PROJECT LEADER: JLL</p> <p>DESIGNED BY: MCF</p> <p>IPARM FILE: p06b034114.i</p>	<p>DRAWN BY: STANTEC</p> <p>CHECKED BY: JLL</p> <p>SHEET 31 OF 84</p>