

646.402 DURABLE 4 INCH WHITE LINE, THERMOPLASTIC  
 (ALL LINES WILL INCLUDE EDGE LINE AND LANE LINE BREAKS AND RADIUS FOR SIDE ROADS)  
 STA. 221+2.64 TO STA. 224+00, SOLID LT & RT  
 STA. 221+72, DOUBLE SOLID LT (COUNTRY CLUB ROAD)

646.412 DURABLE 4 INCH YELLOW LINE, THERMOPLASTIC  
 (ALL LINES WILL INCLUDE EDGE LINE AND LANE LINE BREAKS AND RADIUS FOR SIDE ROADS)  
 STA. 221+2.64 TO STA. 224+00, SOLID LT & RT (LANE LINE)  
 STA. 221+2.64 TO STA. 224+00, DASHED LT & RT (LANE LINE)  
 STA. 221+72, DOUBLE SOLID LT (COUNTRY CLUB ROAD)

646.482 DURABLE 24 INCH STOP BAR, THERMOPLASTIC  
 STA. 221+72, LT (COUNTRY CLUB ROAD)

646.492 DURABLE LETTER OR SYMBOL, THERMOPLASTIC  
 STA. 221+72, LT - 'STOP' (COUNTRY CLUB ROAD)  
 STA. 222+43, C - ARROW  
 STA. 222+67, C - ARROW  
 STA. 223+93, C - ARROW

646.602 TEMPORARY 4 INCH WHITE LINE, PAINT  
 (ALL LINES WILL INCLUDE EDGE LINE AND LANE LINE BREAKS AND RADIUS FOR SIDE ROADS)  
 STA. 221+2.64 TO STA. 224+00, SOLID LT & RT  
 STA. 221+72, DOUBLE SOLID LT (COUNTRY CLUB ROAD)


646.612 TEMPORARY 4 INCH YELLOW LINE, PAINT  
 (ALL LINES WILL INCLUDE EDGE LINE AND LANE LINE BREAKS AND RADIUS FOR SIDE ROADS)  
 STA. 221+2.64 TO STA. 224+00, SOLID LT & RT (LANE LINE)  
 STA. 221+2.64 TO STA. 224+00, DASHED LT & RT (LANE LINE)  
 STA. 221+72, DOUBLE SOLID LT (COUNTRY CLUB ROAD)

646.682 TEMPORARY 24 INCH STOP BAR, PAINT  
 STA. 221+72, LT (COUNTRY CLUB ROAD)

646.692 TEMPORARY LETTER OR SYMBOL, PAINT  
 STA. 222+43, C - ARROW  
 STA. 222+67, C - ARROW  
 STA. 223+93, C - ARROW

675.50 REMOVING SIGNS (TYPE A)  
 AS SHOWN - 1

**RESUME NH 2604(1)S U.S. ROUTE 2  
 MONTPELIER CITY STA. 221+12.64 = MM 4.188**

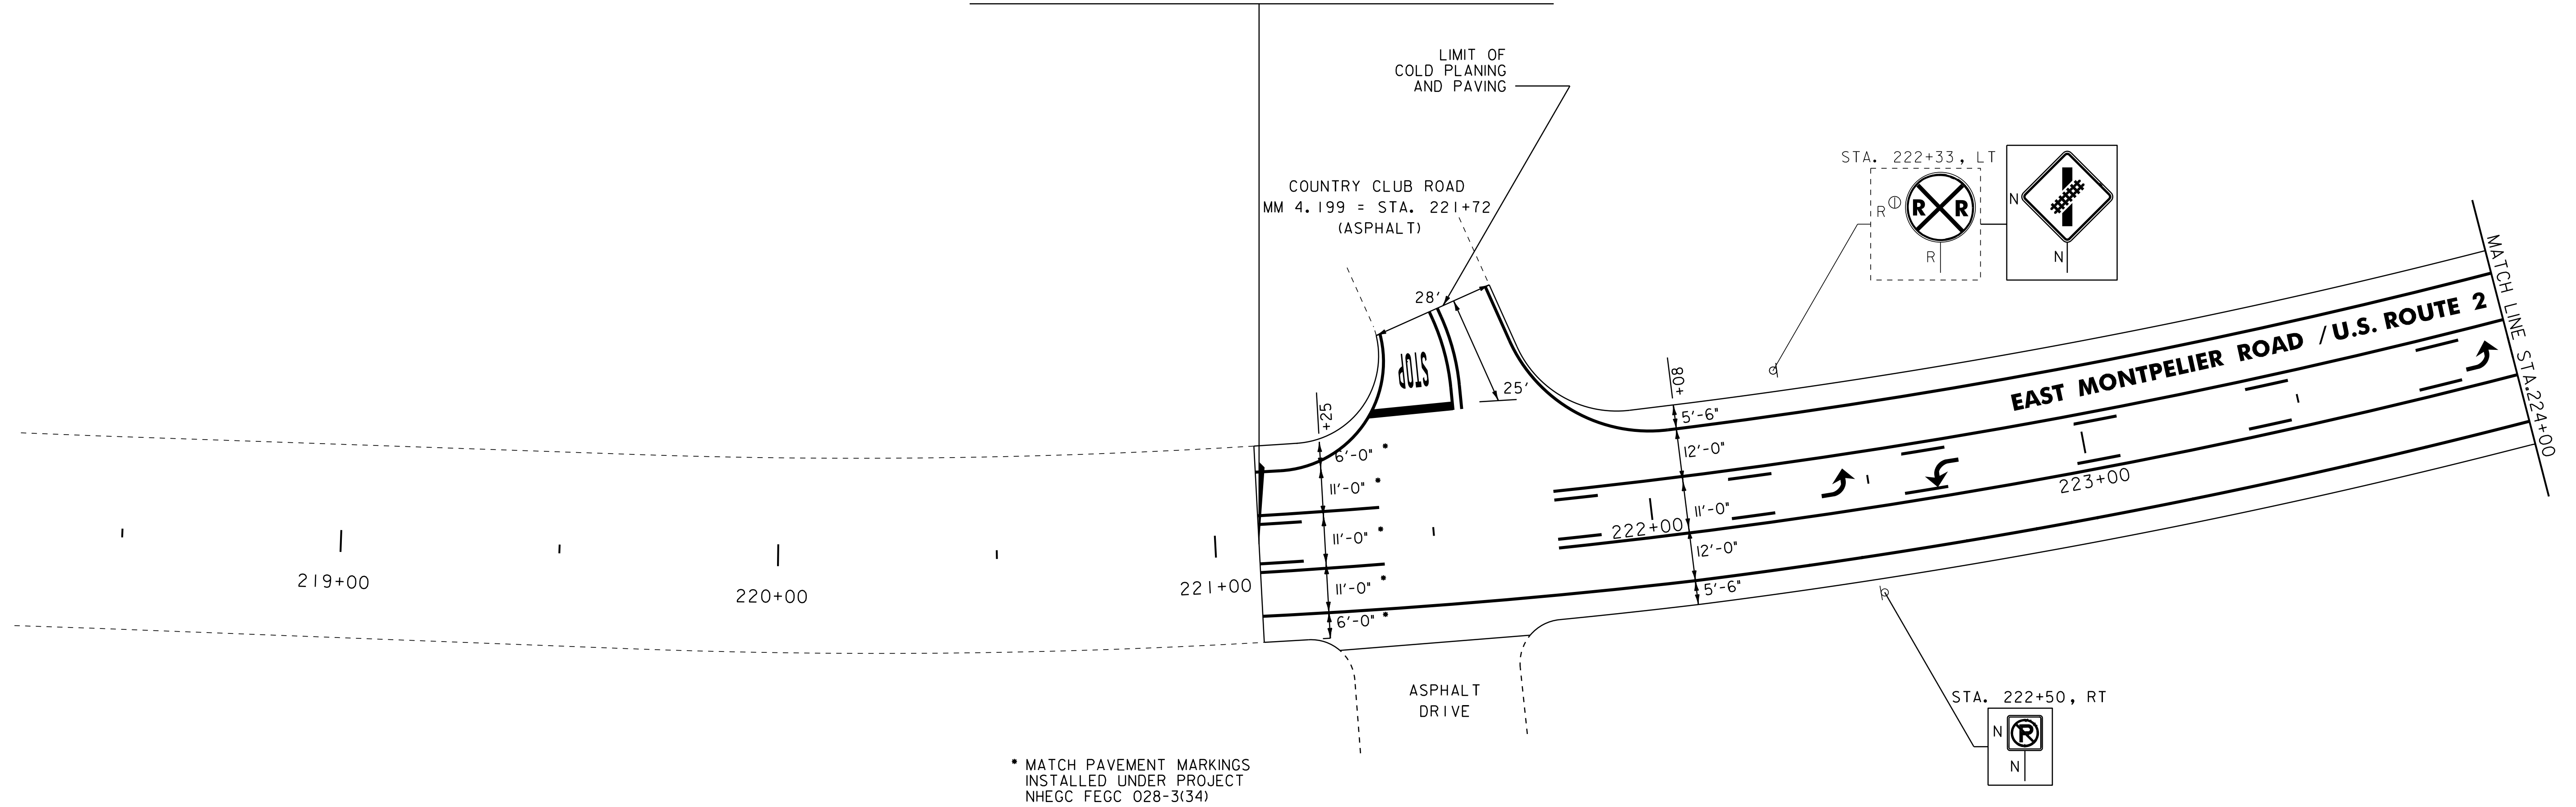

• MATCH PAVEMENT MARKINGS  
 INSTALLED UNDER PROJECT  
 NHEGC FEFC 028-3(34)

NOTE:  
 1. FOR LEGENDS, SEE LAYOUT SHEET #1.  
 2. ALL EXISTING SIGNS NOT SHOWN SHALL BE  
 RETAINED AS DIRECTED BY THE RESIDENT ENGINEER.

NOT TO SCALE



**PROJECT  
 LAYOUT  
 SHEET #19**

PROJECT NAME: MONTPELIER  
 PROJECT NUMBER: NH 2604(1)

FILE NAME: p06b034.dgn  
 PROJECT LEADER: JLL  
 DESIGNED BY: MCF  
 IPARM FILE: p06b034i19.i

PLOT DATE: 03-AUG-2011 4:09  
 DRAWN BY: STANTEC  
 CHECKED BY: JLL  
 SHEET 36 OF 84