

604.412, 604.415 OR 604.418 REHAB.
Dis. CBs OR MHS, CLASS I, II OR III
STA. 23+09, RT

629.20 ADJUST ELEVATION OF VALVE BOX
STA. 23+32, C/L


646.402 DURABLE 4 INCH WHITE LINE, THERMOPLASTIC
STA. 23+00 TO 29+00, SOLID LT & RT

646.602 TEMPORARY 4 INCH WHITE LINE, PAINT
STA. 23+00 TO 29+00, SOLID LT & RT

604.42 CHANGING ELEVATION OF SEWER MANHOLES
STA. 23+77, LT
STA. 24+11, LT
STA. 28+86, LT

646.412 DURABLE 4 INCH YELLOW LINE, THERMOPLASTIC
STA. 23+00 TO 29+00, SOLID LT & RT

646.612 TEMPORARY 4 INCH YELLOW LINE, PAINT
STA. 23+00 TO 29+00, SOLID LT & RT

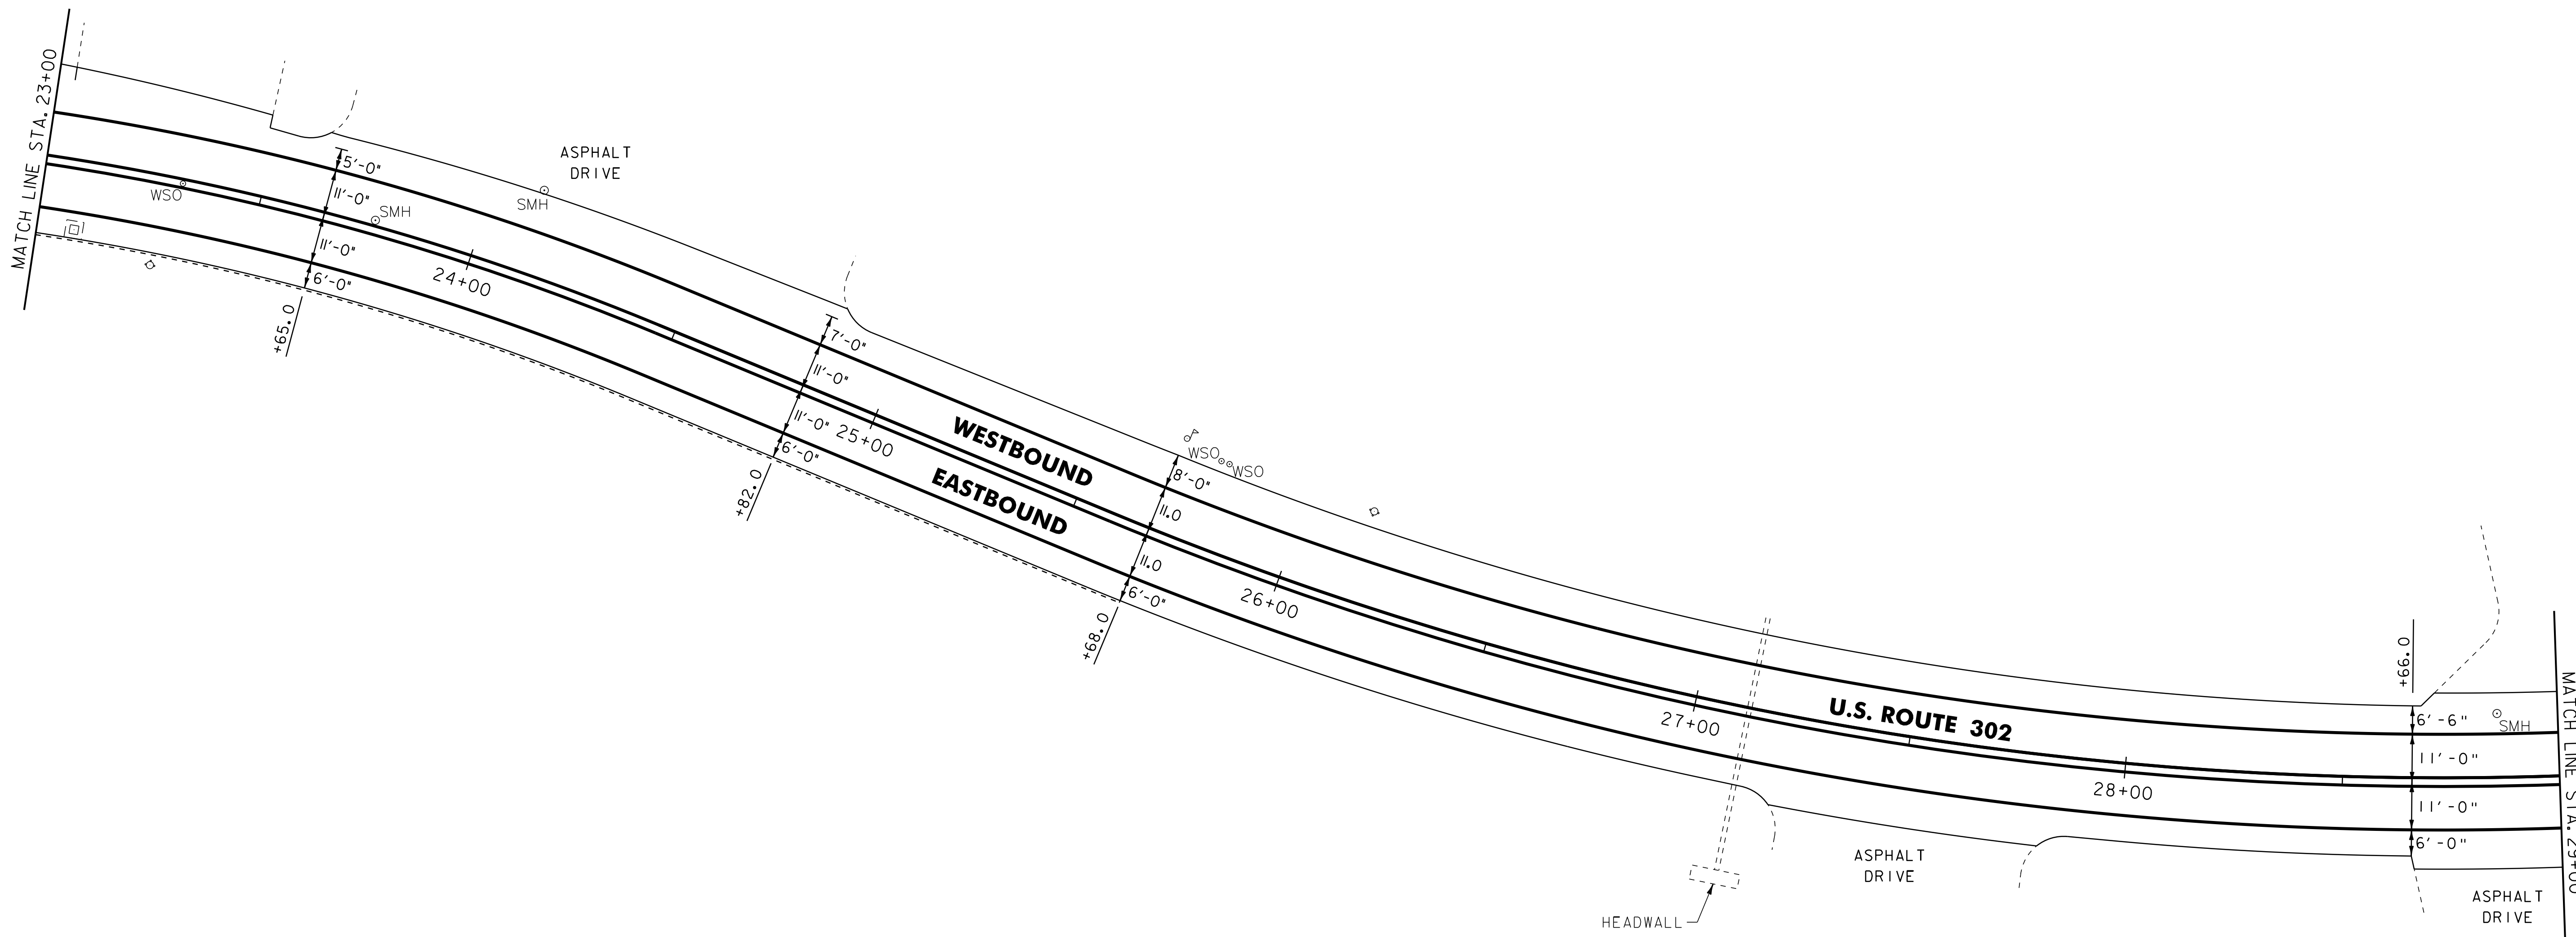

- NOTES:
1. ALL EXISTING SIGNS NOT SHOWN SHALL BE RETAINED AS DIRECTED BY THE RESIDENT ENGINEER.
 2. FOR LEGEND, SEE LAYOUT #1.

NOT TO SCALE



PROJECT LAYOUT SHEET #4

PROJECT NAME: MONTPELIER
PROJECT NUMBER: STP 2618(I)

FILE NAME: p06d114.dgn
PROJECT LEADER: JLL
DESIGNED BY: MCF
IPARM FILE: p06d114104.i

PLOT DATE: 03-AUG-2011 14:11
DRAWN BY: STANTEC
CHECKED BY: JLL
SHEET 77 OF 84