

TEMPORARY 100mm WHITE LINE, PAINT
 DURABLE 100mm WHITE LINE, THERMOPLASTIC
 STA 1+004 TO 1+092 SOLID LT EDGE LINE
 STA 1+004 TO 1+140 SOLID RT EDGE LINE
 STA 1+117 TO 1+140 SOLID LT EDGE LINE

TEMPORARY 100mm YELLOW LINE, PAINT
 DURABLE 100mm YELLOW LINE, THERMOPLASTIC
 STA 1+004 TO 1+096 SOLID LT & RT
 STA 1+099 DOUBLE SOLID LT (TH 31)
 STA 1+108 TO 1+140 SOLID LT & RT

TEMPORARY 600mm STOP BAR, PAINT
 DURABLE 600mm STOP BAR, TYPE 1 TAPE
 STA 1+096 LT (ROSE HILL)

TEMPORARY LETTER OR SYMBOL, PAINT
 DURABLE LETTER OR SYMBOL, TYPE 1 TAPE
 STA 1+096 LT - "STOP" (TH 31)

REHAB. DROP INLETS, CATCH BASINS,
 OR MANHOLES, CLASS I
 STA 1+003 LT (OTDI)

CHANGING ELEVATION
 OF SEWER MANHOLES
 STA 1+021 LT
 STA 1+095 LT **RETAINED**
 STA 1+099 LT
 STA 1+120 LT

ADJUST ELEVATION
 OF VALVE BOX **DONE BY TOWN**
 STA 1+082 RT
 STA 1+115 RT

BITUMINOUS CONCRETE
 GUTTERS AND TRAFFIC ISLANDS
 STA 1+003 TO 1+070 LT - (0.6M WIDE)



~~THINNING AND TRIMMING FOR SIGNS~~
 STA 1+003 RT

REMOVING SIGNS
 AS SHOWN - 16

ERECTING SALVAGED SIGNS
 AS SHOWN - 1



**US ROUTE 4
 STA 9+084.7
 (MM 5.645) BK =
 STA 1+003.67 AHD
 BEGIN PROJECT
 NH 2606(I)S**

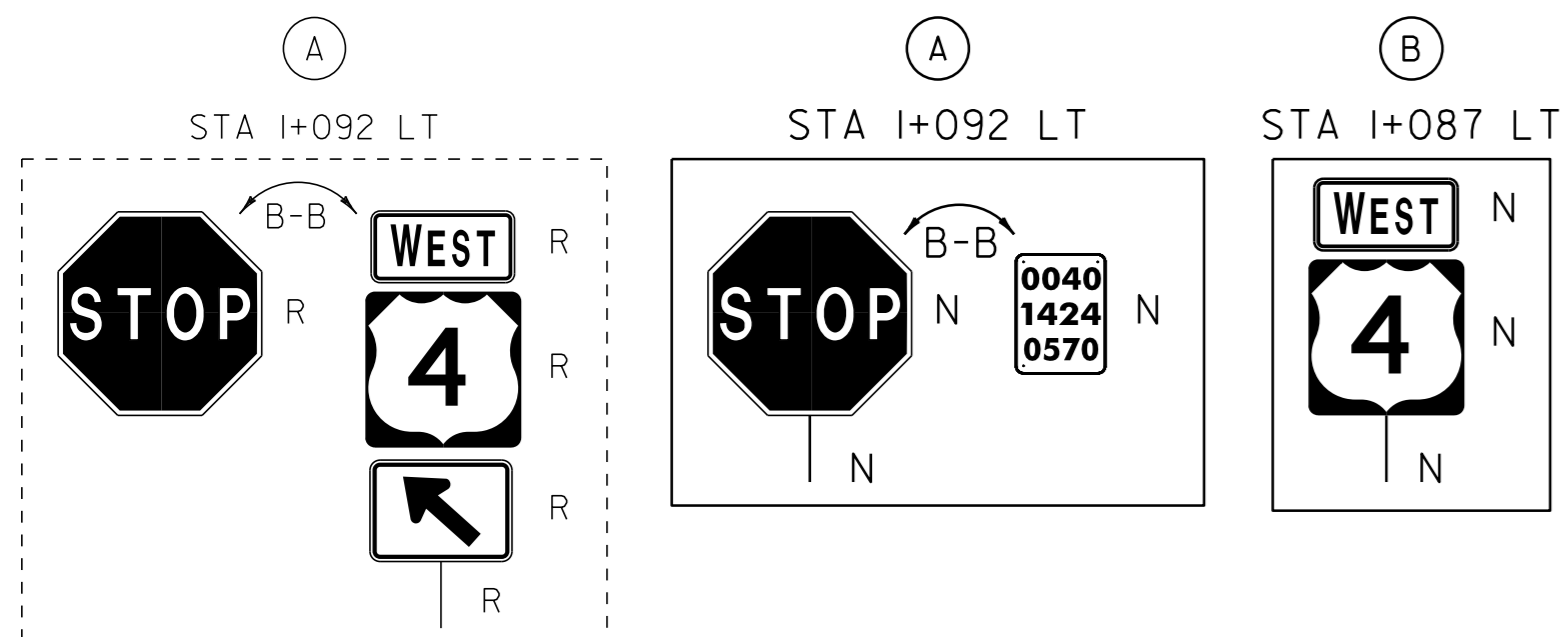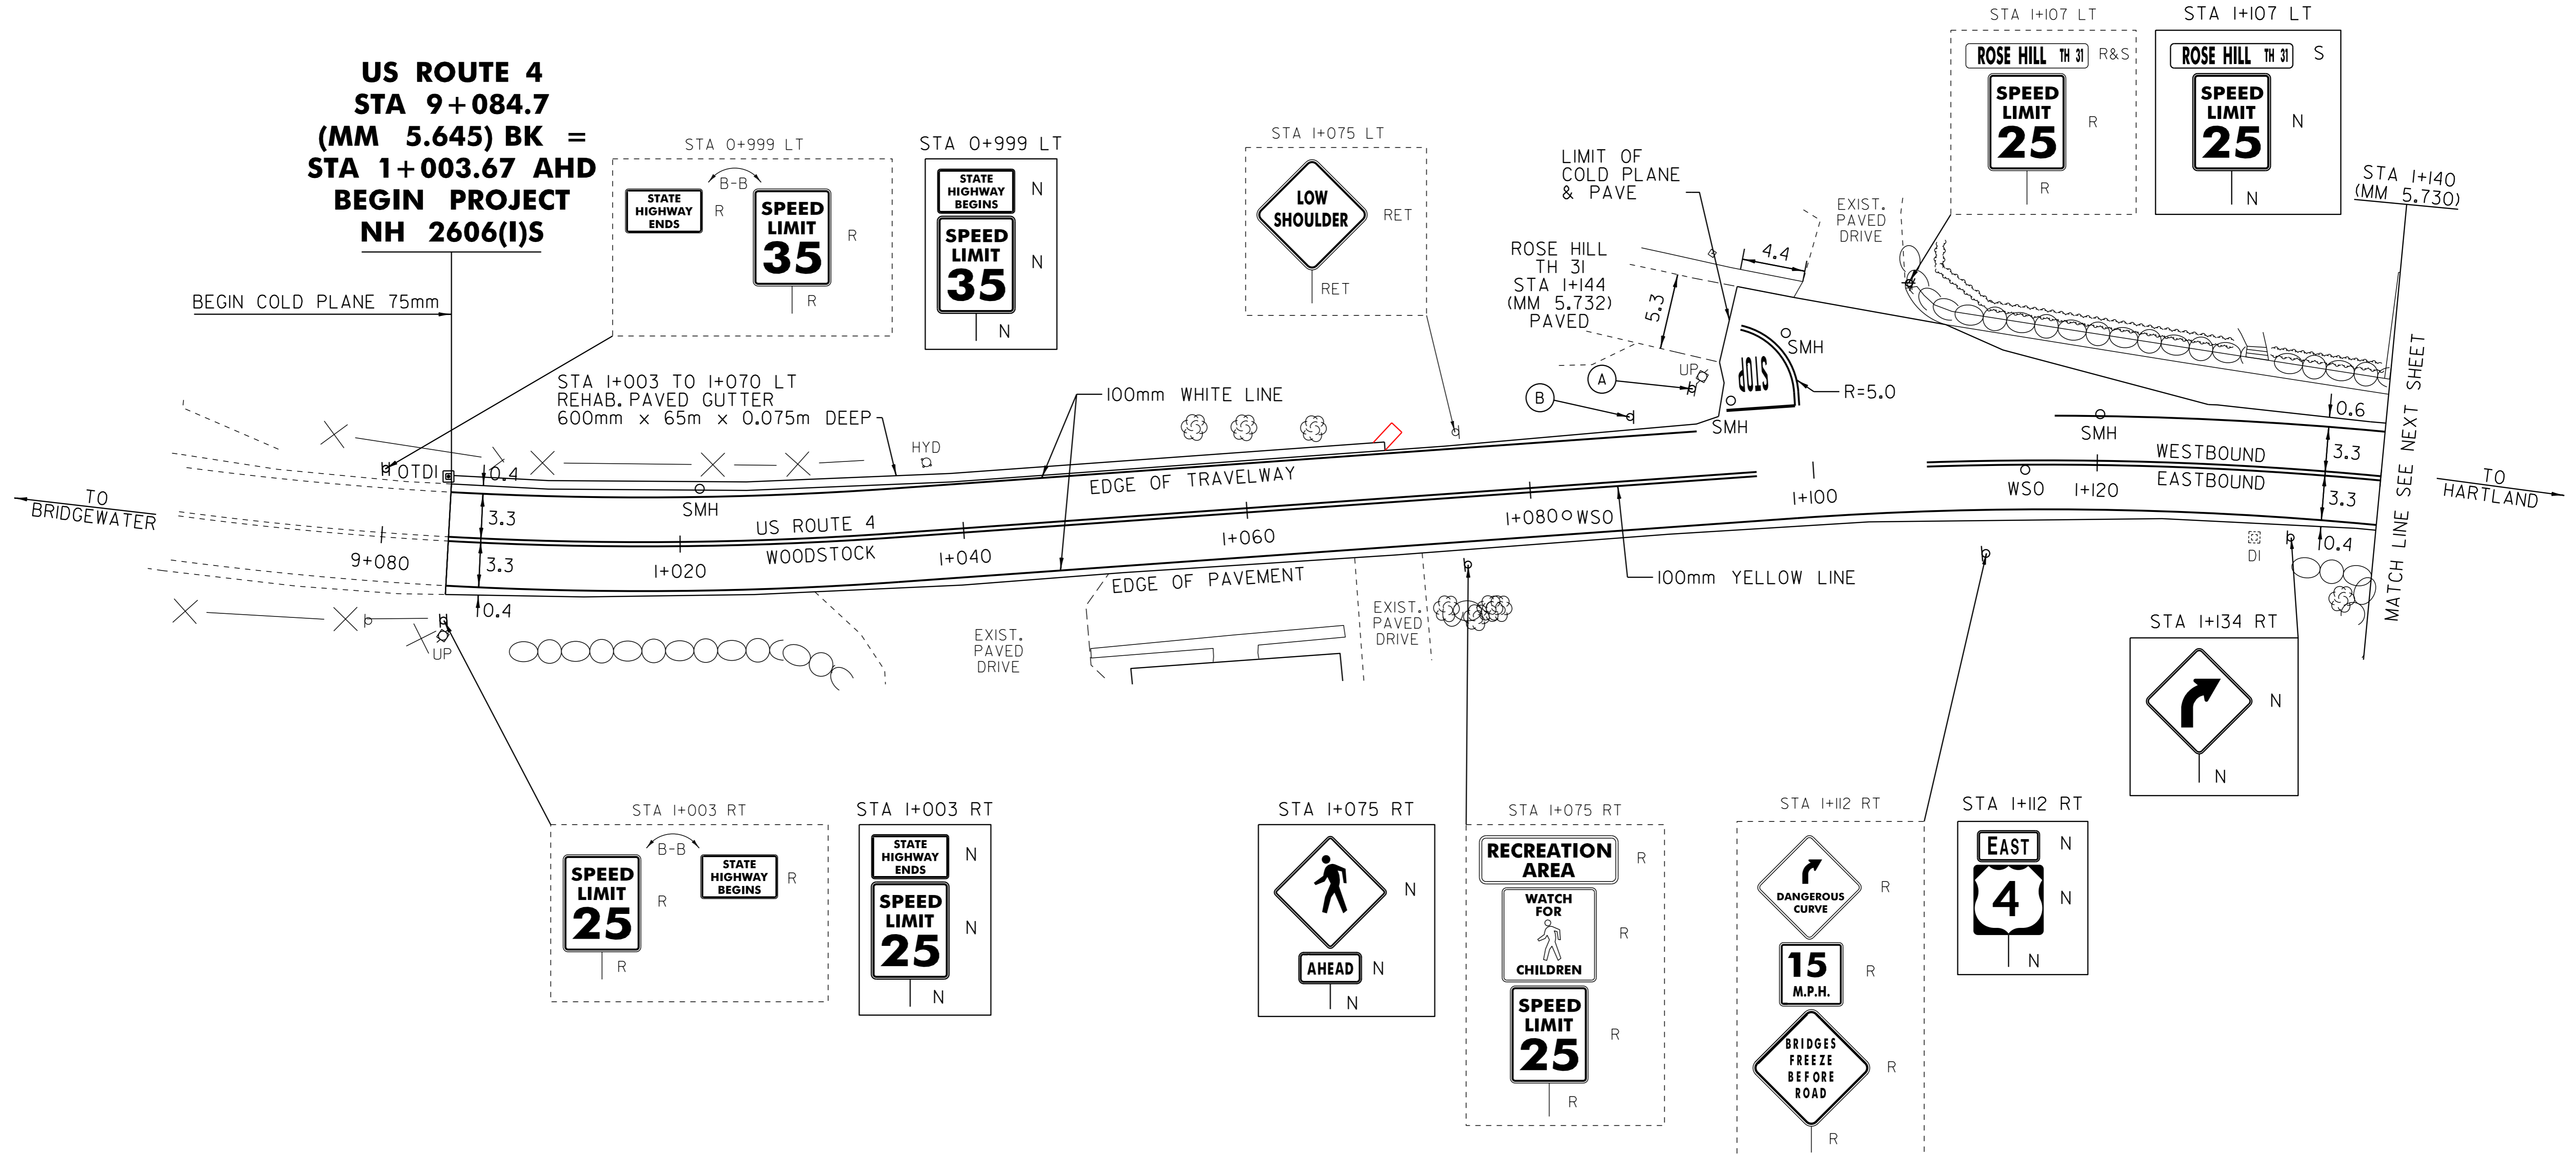

NOT TO SCALE

- LEGEND**
- R = REMOVE EXISTING
 - S = SALVAGE
 - R&S = REMOVE AND SALVAGE
 - N = NEW
 - RET = RETAIN
 - B-B = BACK TO BACK
 - (PM) = REMOVE PARKING METER

PAVING LAYOUT 1

NOTE: ALL DIMENSIONS IN METERS EXCEPT AS INDICATED

| | |
|--|------------------------------|
| PROJECT NAME: WOODSTOCK | PLOT DATE: 11-JUN-2012 16:15 |
| PROJECT NUMBER: NH 2606(I)S | DRAWN BY: MRS |
| DESIGN FILE NAME: /pave/06b036/pb036.dgn | CHECKED BY: NLL |
| IPARM FILE NAME: pb0361a01.i | SHEET 19 OF 73 |
| PROJECT LEADER: PTS | |
| DESIGNED BY: NLL | |