

TEMPORARY 100mm WHITE LINE, PAINT
 DURABLE 100mm WHITE LINE, THERMOPLASTIC
 STA 1+407 TO 1+460 SOLID LT EDGE LINE
 STA 1+407 TO 1+460 SOLID RT EDGE LINE

TEMPORARY 100mm YELLOW LINE, PAINT
 DURABLE 100mm YELLOW LINE, THERMOPLASTIC
 STA 1+395 DOUBLE SOLID RT (CHURCH ST EXT.)
 STA 1+407 TO 1+460 SOLID LT & RT

TEMPORARY 600mm STOP BAR, PAINT
 DURABLE 600mm STOP BAR, TYPE I TAPE
 STA 1+395 RT (CHURCH ST EXT.)

TEMPORARY LETTER OR SYMBOL, PAINT
 DURABLE LETTER OR SYMBOL, TYPE I TAPE
 STA 1+394 RT - "STOP" (CHURCH ST EXT.)


EXCAVATION OF SURFACES
 AND PAVEMENTS
 STA 1+391 TO 1+419 RT

REMOVING SIGNS
 AS SHOWN -17

ERECTING SALVAGED SIGNS
 AS SHOWN -1



CHANGING ELEVATION
 OF SEWER MANHOLES
 I+443 LT

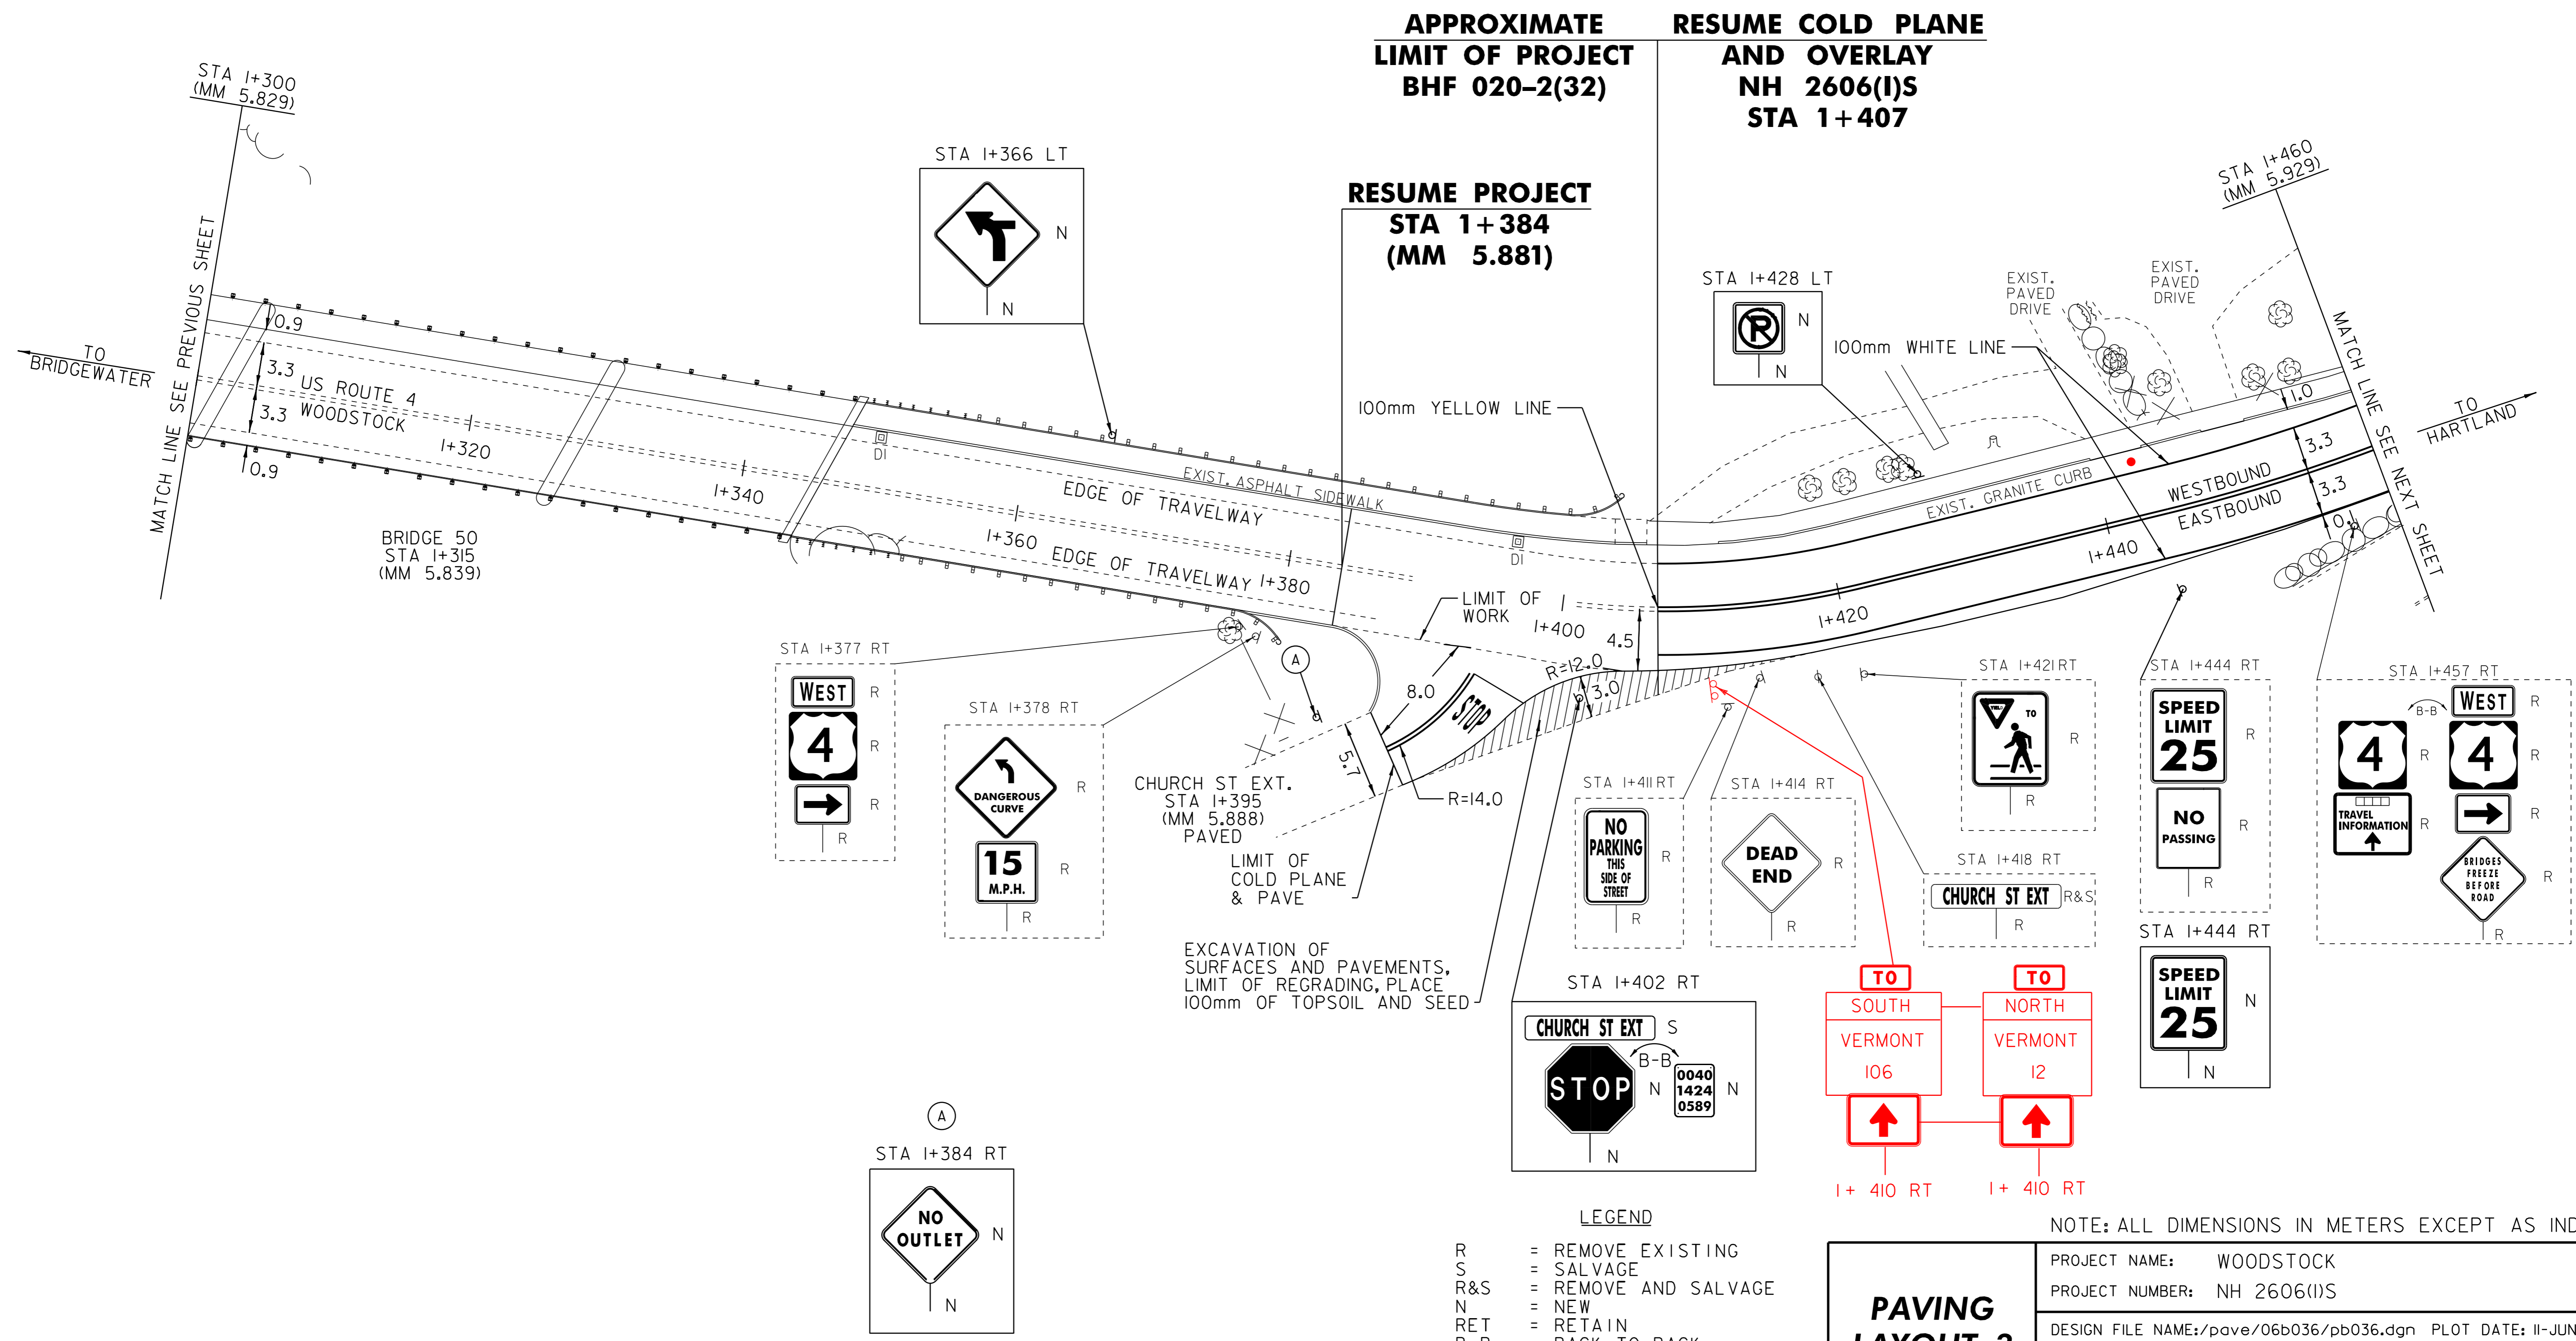

NOT TO SCALE

- LEGEND**
- R = REMOVE EXISTING
 - S = SALVAGE
 - R&S = REMOVE AND SALVAGE
 - N = NEW
 - RET = RETAIN
 - B-B = BACK TO BACK
 - (PM) = REMOVE PARKING METER

PAVING LAYOUT 3

NOTE: ALL DIMENSIONS IN METERS EXCEPT AS INDICATED

PROJECT NAME:	WOODSTOCK
PROJECT NUMBER:	NH 2606(I)S
DESIGN FILE NAME:	pave/06b036/pb036.dgn
IPARM FILE NAME:	pb036ia03.i
PROJECT LEADER:	PTS
DESIGNED BY:	NLL
PLOT DATE:	11-JUN-2012 16:15
DRAWN BY:	MRS
CHECKED BY:	NLL
SHEET	21 OF 73