

TEMPORARY 100mm WHITE LINE, PAINT
 DURABLE 100mm WHITE LINE, THERMOPLASTIC
 STA 1+460 TO 1+466 SOLID RT EDGE LINE
 STA 1+460 TO 1+477 SOLID LT EDGE LINE
 STA 1+479 TO 1+620 SOLID LT EDGE LINE
 STA 1+609 TO 1+613 SOLID RT NO PARKING
 STA 1+613 TO 1+620 SOLID RT PARKING

TEMPORARY 100mm YELLOW LINE, PAINT
 DURABLE 100mm YELLOW LINE, THERMOPLASTIC
 STA 1+460 TO 1+468 SOLID LT & RT
 STA 1+480 TO 1+620 SOLID LT & RT

TEMPORARY LETTER OR SYMBOL, PAINT
 DURABLE LETTER OR SYMBOL, TYPE I TAPE
 STA 1+616 RT - DISABLED MARKING

TEMPORARY CROSSWALK MARKING, PAINT
 STA 1+477 TO 1+480 LT TO RT

SPECIAL PROVISION (DURABLE
 CROSSWALK MARKING, IMPRINTED/COLORIZED)
 STA 1+477 TO 1+480 LT TO RT

CONSTRUCT SIDEWALK RAMP
 W/DETECTABLE WARNING SURFACE (RED)
 STA 1+477 LT (TYPE 6)
 STA 1+480 RT (CONCRETE LANDING)

CHANGING ELEVATION OF DROP INLETS,
 CATCH BASINS, OR MANHOLES
 STA 1+535 RT (CB)
 STA 1+541 LT (DI)
 STA 1+571 LT (DI)
 STA 1+574 RT (DI)
 STA 1+611 LT (DI) REHAB

REHAB. DROP INLETS,
 CATCH BASINS, OR MANHOLES, CLASS 1
 STA 1+480 LT (DI)
 STA 1+506 RT (DI)
 STA 1+512 LT (DI)

CHANGING ELEVATION
 OF SEWER MANHOLES
 STA 1+485 RT
 STA 1+579 RT

ADJUST ELEVATION
 OF VALVE BOX **DONE BY TOWN**
 STA 1+463 RT
 STA 1+486 RT
 STA 1+579 RT

~~THINNING AND TRIMMING FOR SIGNS
 STA 1+460 RT~~



REMOVAL OF
 OF EXISTING CURB
 STA 1+463 TO 1+469 LT

VERTICAL GRANITE CURB
 STA 1+463 TO 1+469 LT

BITUMINOUS CONCRETE SIDEWALK
 STA 1+466 LT

REMOVING SIGNS
 AS SHOWN - 8

ERECTING SALVAGED SIGNS
 AS SHOWN - 1

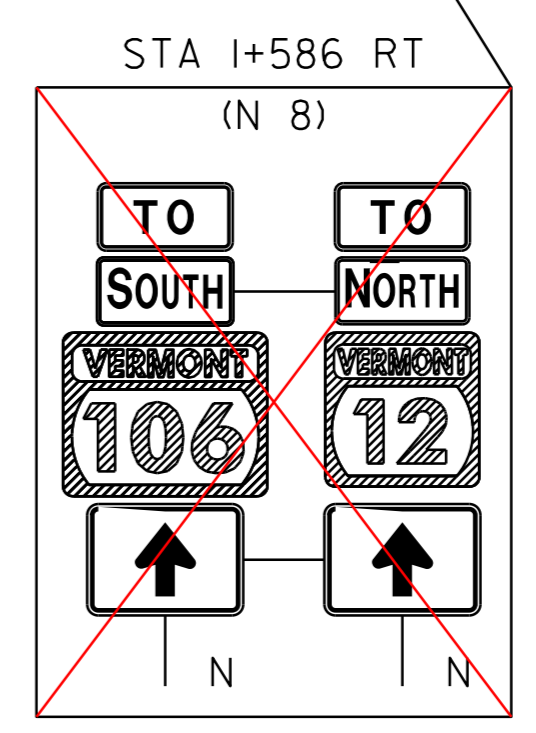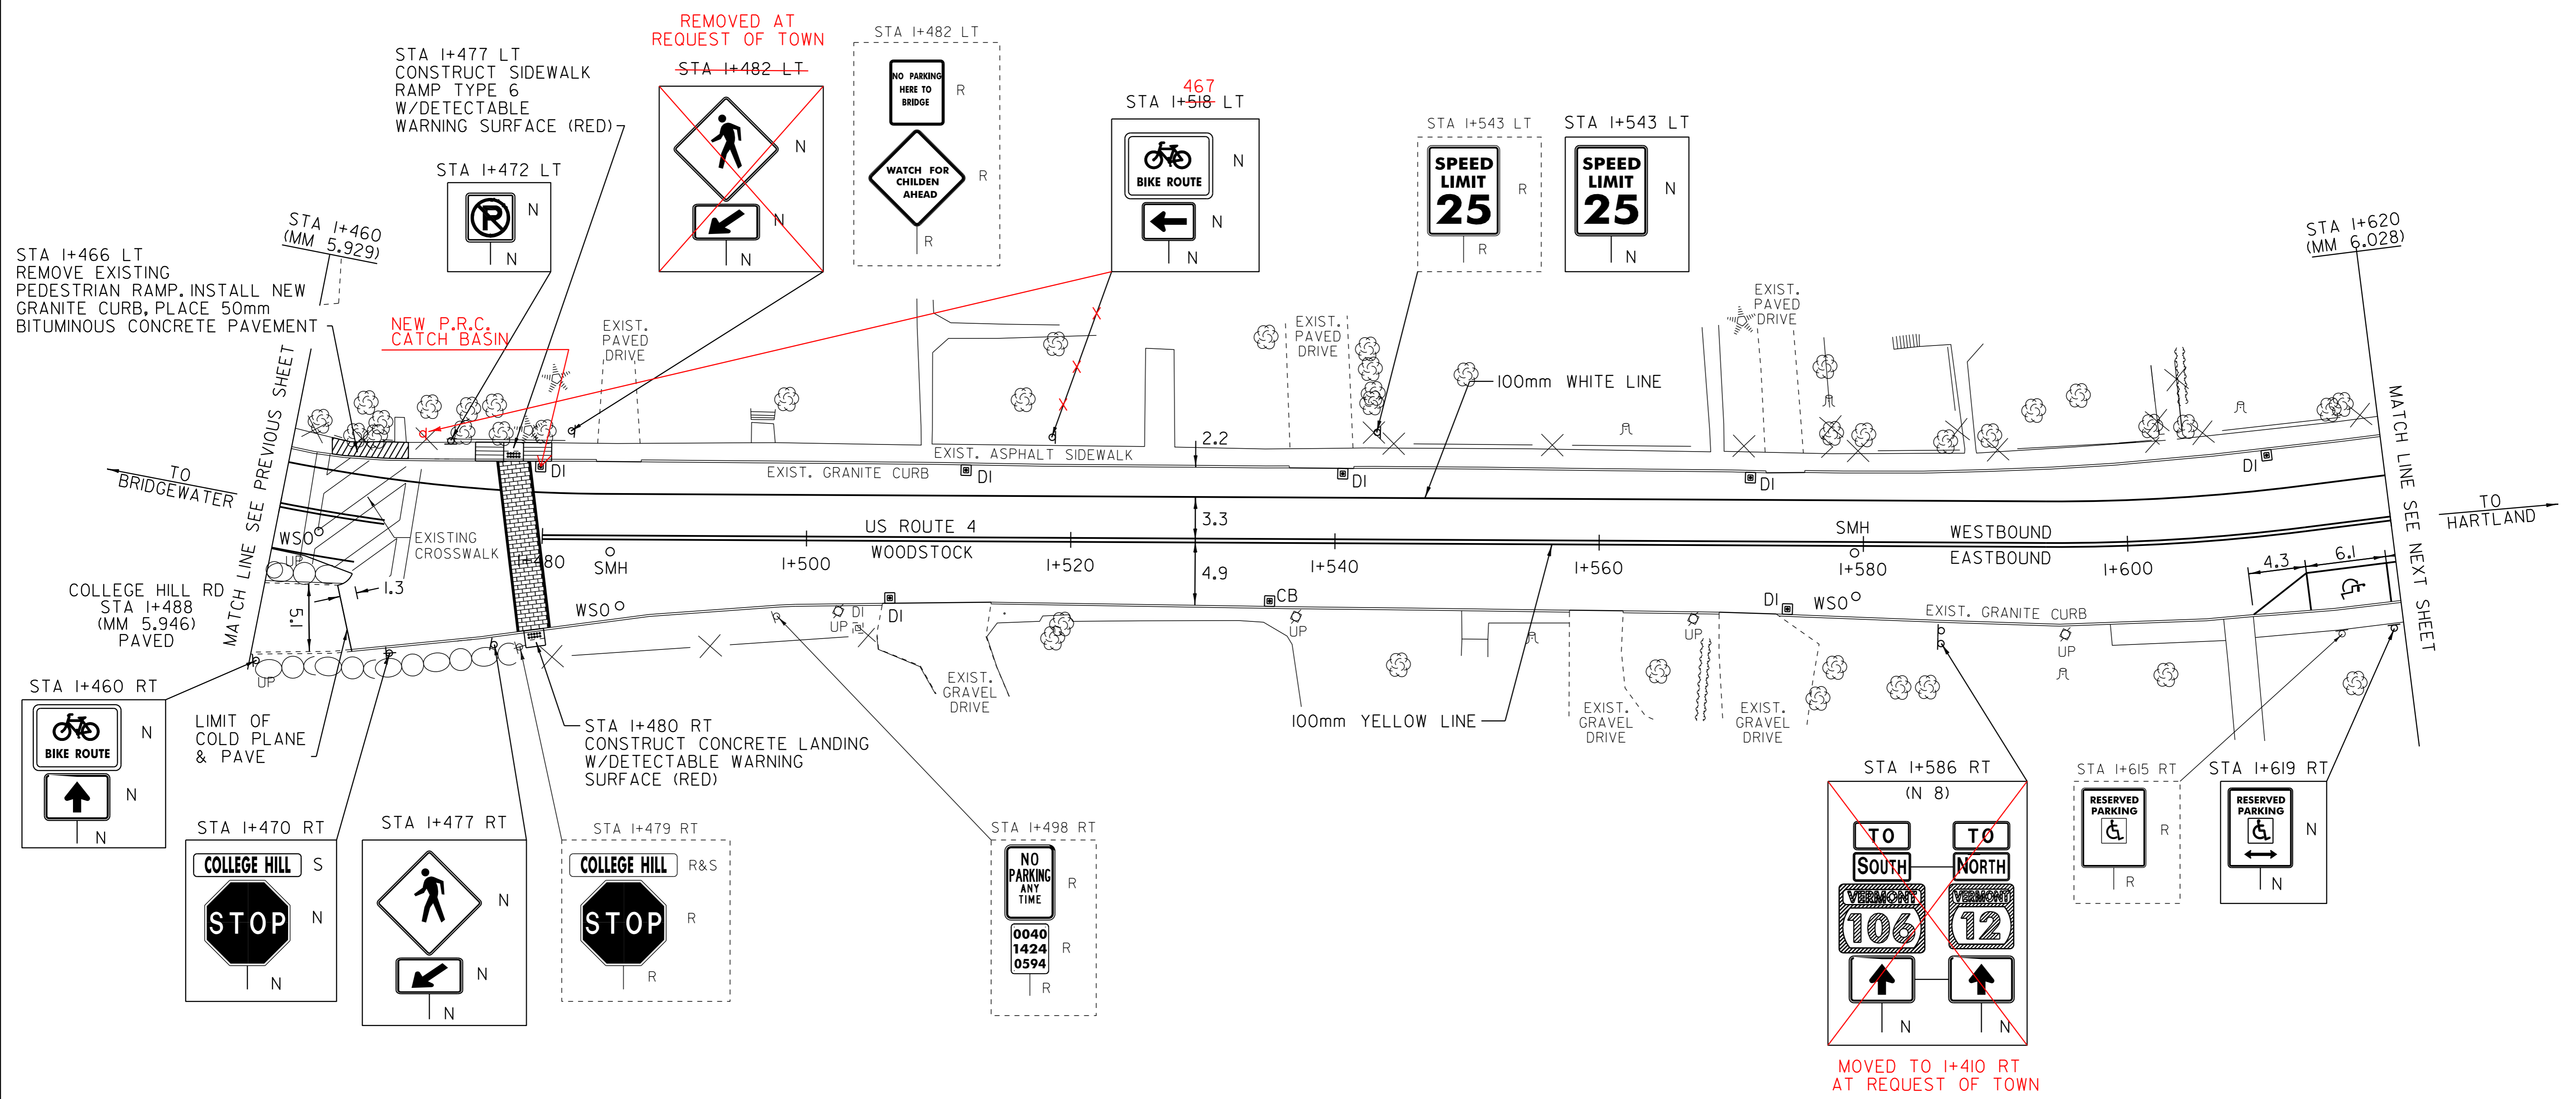

LEGEND

- R = REMOVE EXISTING
- S = SALVAGE
- R&S = REMOVE AND SALVAGE
- N = NEW
- RET = RETAIN
- B-B = BACK TO BACK
- (PM) = REMOVE PARKING METER

NOTE: ALL DIMENSIONS IN METERS EXCEPT AS INDICATED

PAVING LAYOUT 4

PROJECT NAME: WOODSTOCK
 PROJECT NUMBER: NH 2606(1)S
 DESIGN FILE NAME: /pave/06b036/pb036.dgn PLOT DATE: 11-JUN-2012 16:15
 IPARM FILE NAME: pb0361a04.i DRAWN BY: MRS
 PROJECT LEADER: PTS CHECKED BY: NLL
 DESIGNED BY: NLL SHEET 22 OF 73

NOT TO SCALE