


**VT ROUTE 12
STA 12+040.0
(MM 0.025)
STOP NH 2606(I)S
BEGIN STP 2509(I)S**

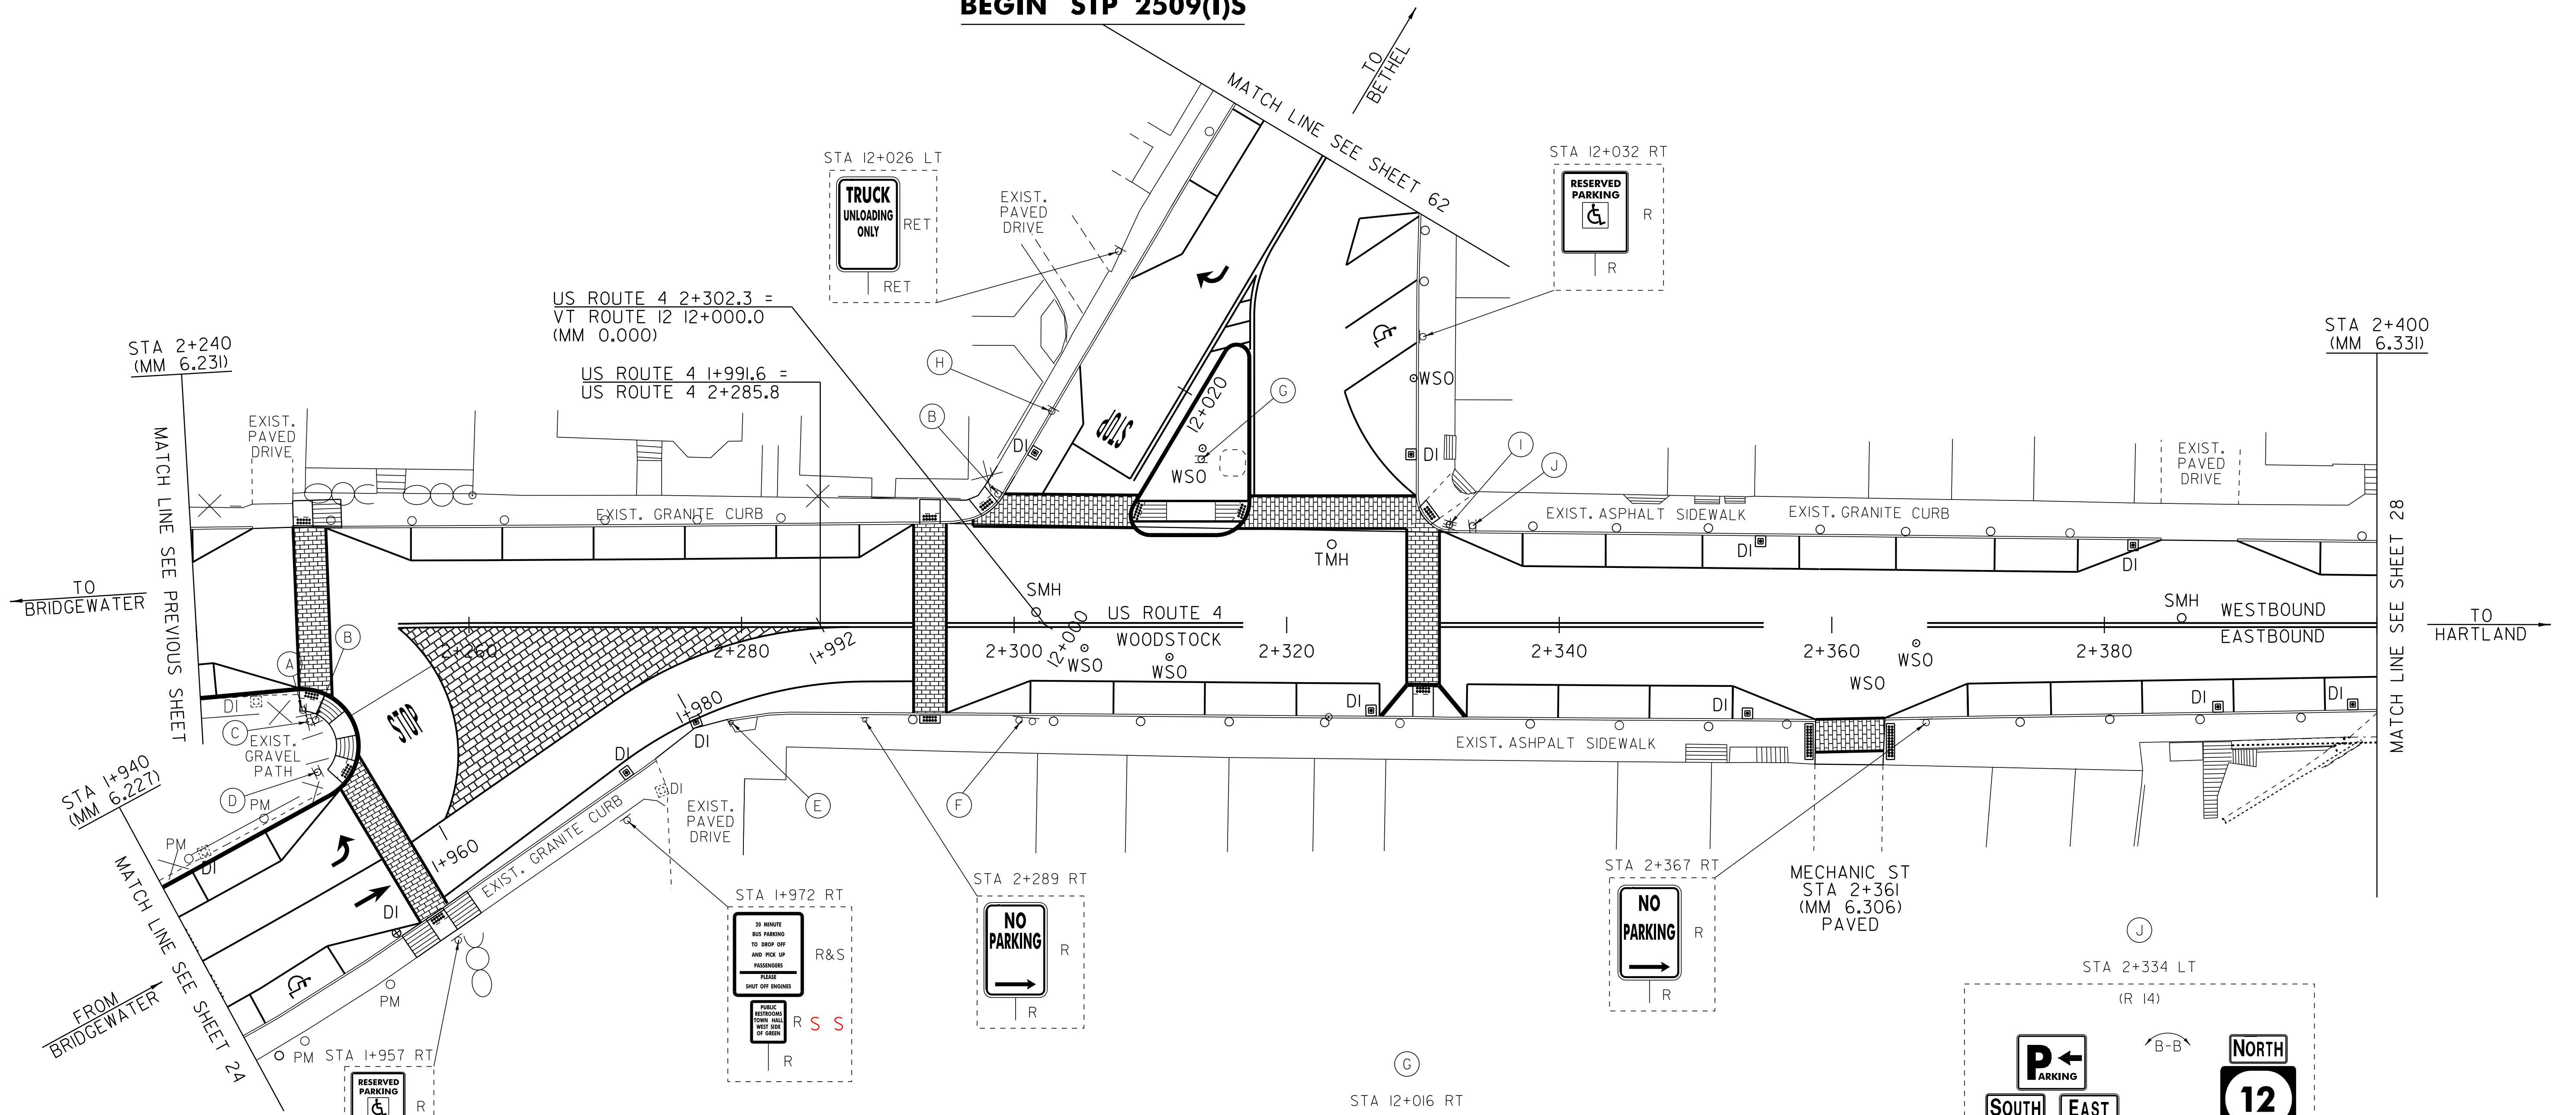

LEGEND

- R = REMOVE EXISTING
- S = SALVAGE
- R&S = REMOVE AND SALVAGE
- N = NEW
- RET = RETAIN
- B-B = BACK TO BACK
- (PM) = REMOVE PARKING METER

NOT TO SCALE

PAVING LAYOUT 8A EXISTING

NOTE: ALL DIMENSIONS IN METERS EXCEPT AS INDICATED

PROJECT NAME: WOODSTOCK
PROJECT NUMBER: NH 2606(I)S
DESIGN FILE NAME: /pave/06b036/pb036.dgn
IPARM FILE NAME: pb036ia08a.i
PROJECT LEADER: PTS
DESIGNED BY: NULL

PLOT DATE: 11-JUN-2012 16:15
DRAWN BY: MRS
CHECKED BY: NULL
SHEET 26 OF 73